



- NOTES:**
1. MATERIAL AND WORKMANSHIP SHALL CONFORM WITH THE REQUIREMENTS OF NCCCOG STANDARD SPECIFICATIONS FOR STANDARD CONCRETE MANHOLES. MINIMUM CLASS "A" CONCRETE.
 2. LAYERS OF REINFORCING STEEL NEAREST THE INTERIOR AND EXTERIOR SURFACES SHALL HAVE A COVER OF 2" TO THE CENTER OF BARS, UNLESS OTHERWISE NOTED.
 3. FOR DETAILS OF REINFORCING OF LOWER PORTIONS OF INLET SEE APPROPRIATE SQUARE MANHOLE DETAILS.
 4. DEPTH OF DROP INLET FROM FINISHED GRADE TO FLOW LINE OF INLET IS VARIABLE. APPROXIMATE DEPTH WILL BE SHOWN ON PLANS AT LOCATION OF INLET.
 5. ALL STANDARD DROP INLETS SHALL HAVE ONE OPENING ON EACH SIDE UNLESS OTHERWISE SHOWN ON PLANS.
 6. DECK MAY BE REINFORCED SAME AS 4' SQUARE MANHOLE.

DROP INLET	North Detail from Detail of Openings	STANDARD SPECIFICATION REFERENCE 702
2', 4', 5' OR 6' SQUARE	DATE OCT. '04	STANDARD DRAWING NO. 6040

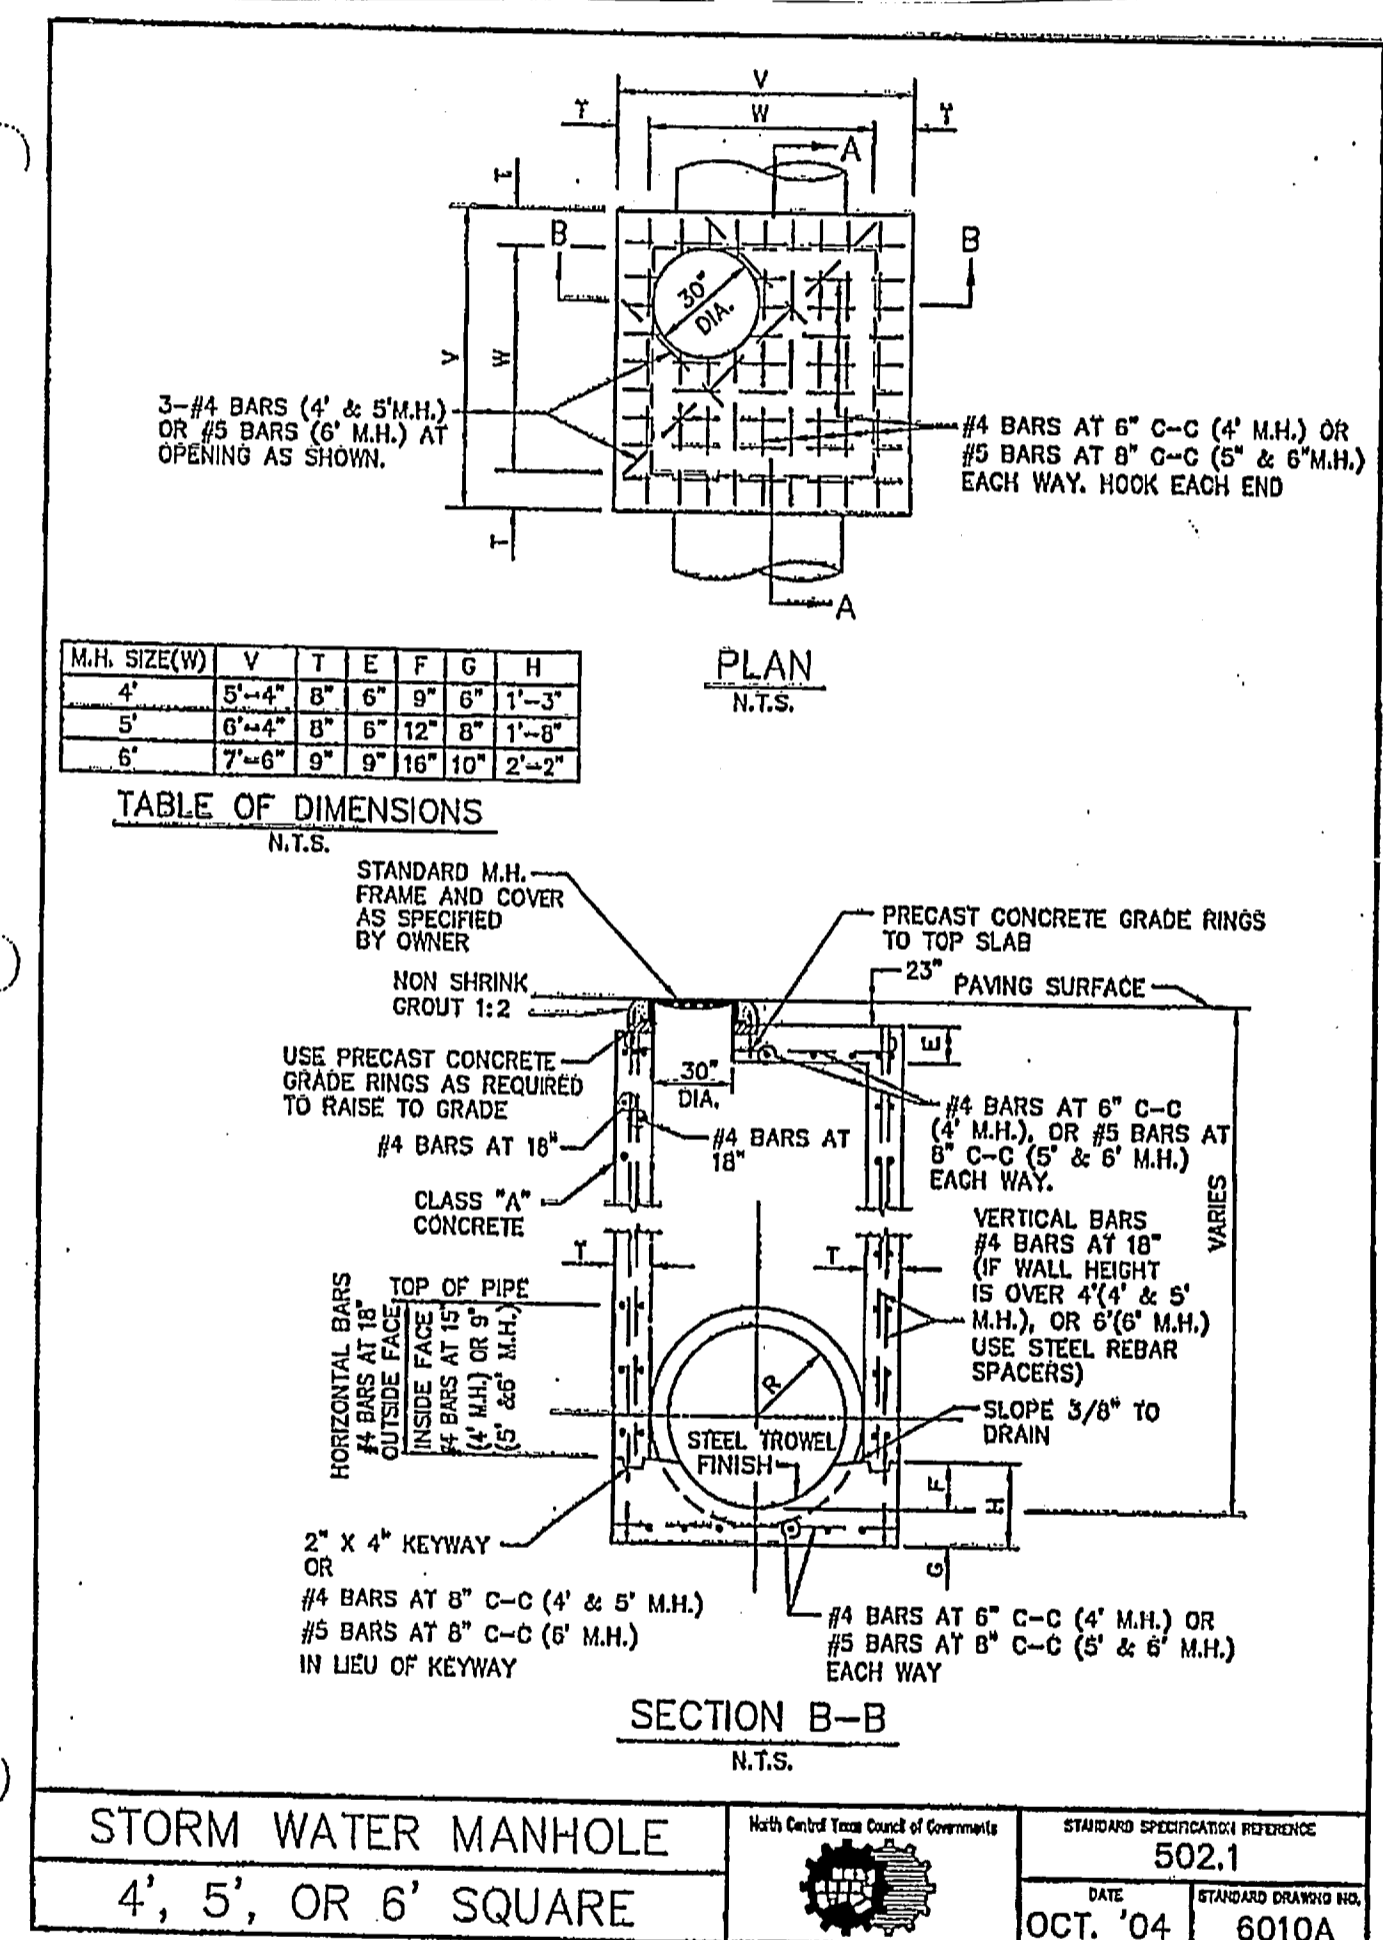

STORM WATER MANHOLE	North Detail from Detail of Openings	STANDARD SPECIFICATION REFERENCE 502.1
4', 5', OR 6' SQUARE	DATE OCT. '04	STANDARD DRAWING NO. 6010A

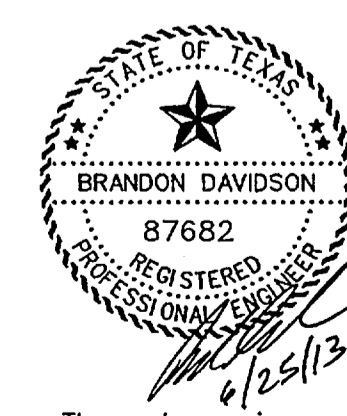

The seal appearing on this document was authorized by Brandon Davidson P.E. 87682, on June 25, 2013

AS-BUILT APRIL 2014
INFORMATION PROVIDED BY CONTRACTORS
(NOT FIELD VERIFIED)

<p>CORWIN ENGINEERING, INC. 200 W. BELMONT, SUITE E ALLEN, TEXAS 75013 (972)396-1200 TBE FIRM #5951</p>			
<p>DEVELOPMENT PLANS FOR BREEZY HILL PHASE I ROCKWALL, TEXAS</p>			
<p>DETENTION POND DETAILS</p>			
DRAWN BY	DESIGNED BY	CHECKED BY	SHEET NO.
JOB NUMBER	DATE	SCALE	16B of 18
12003	APRIL 2013		