


**CHAIN LINK FENCE DETAIL**  
NOT TO SCALE

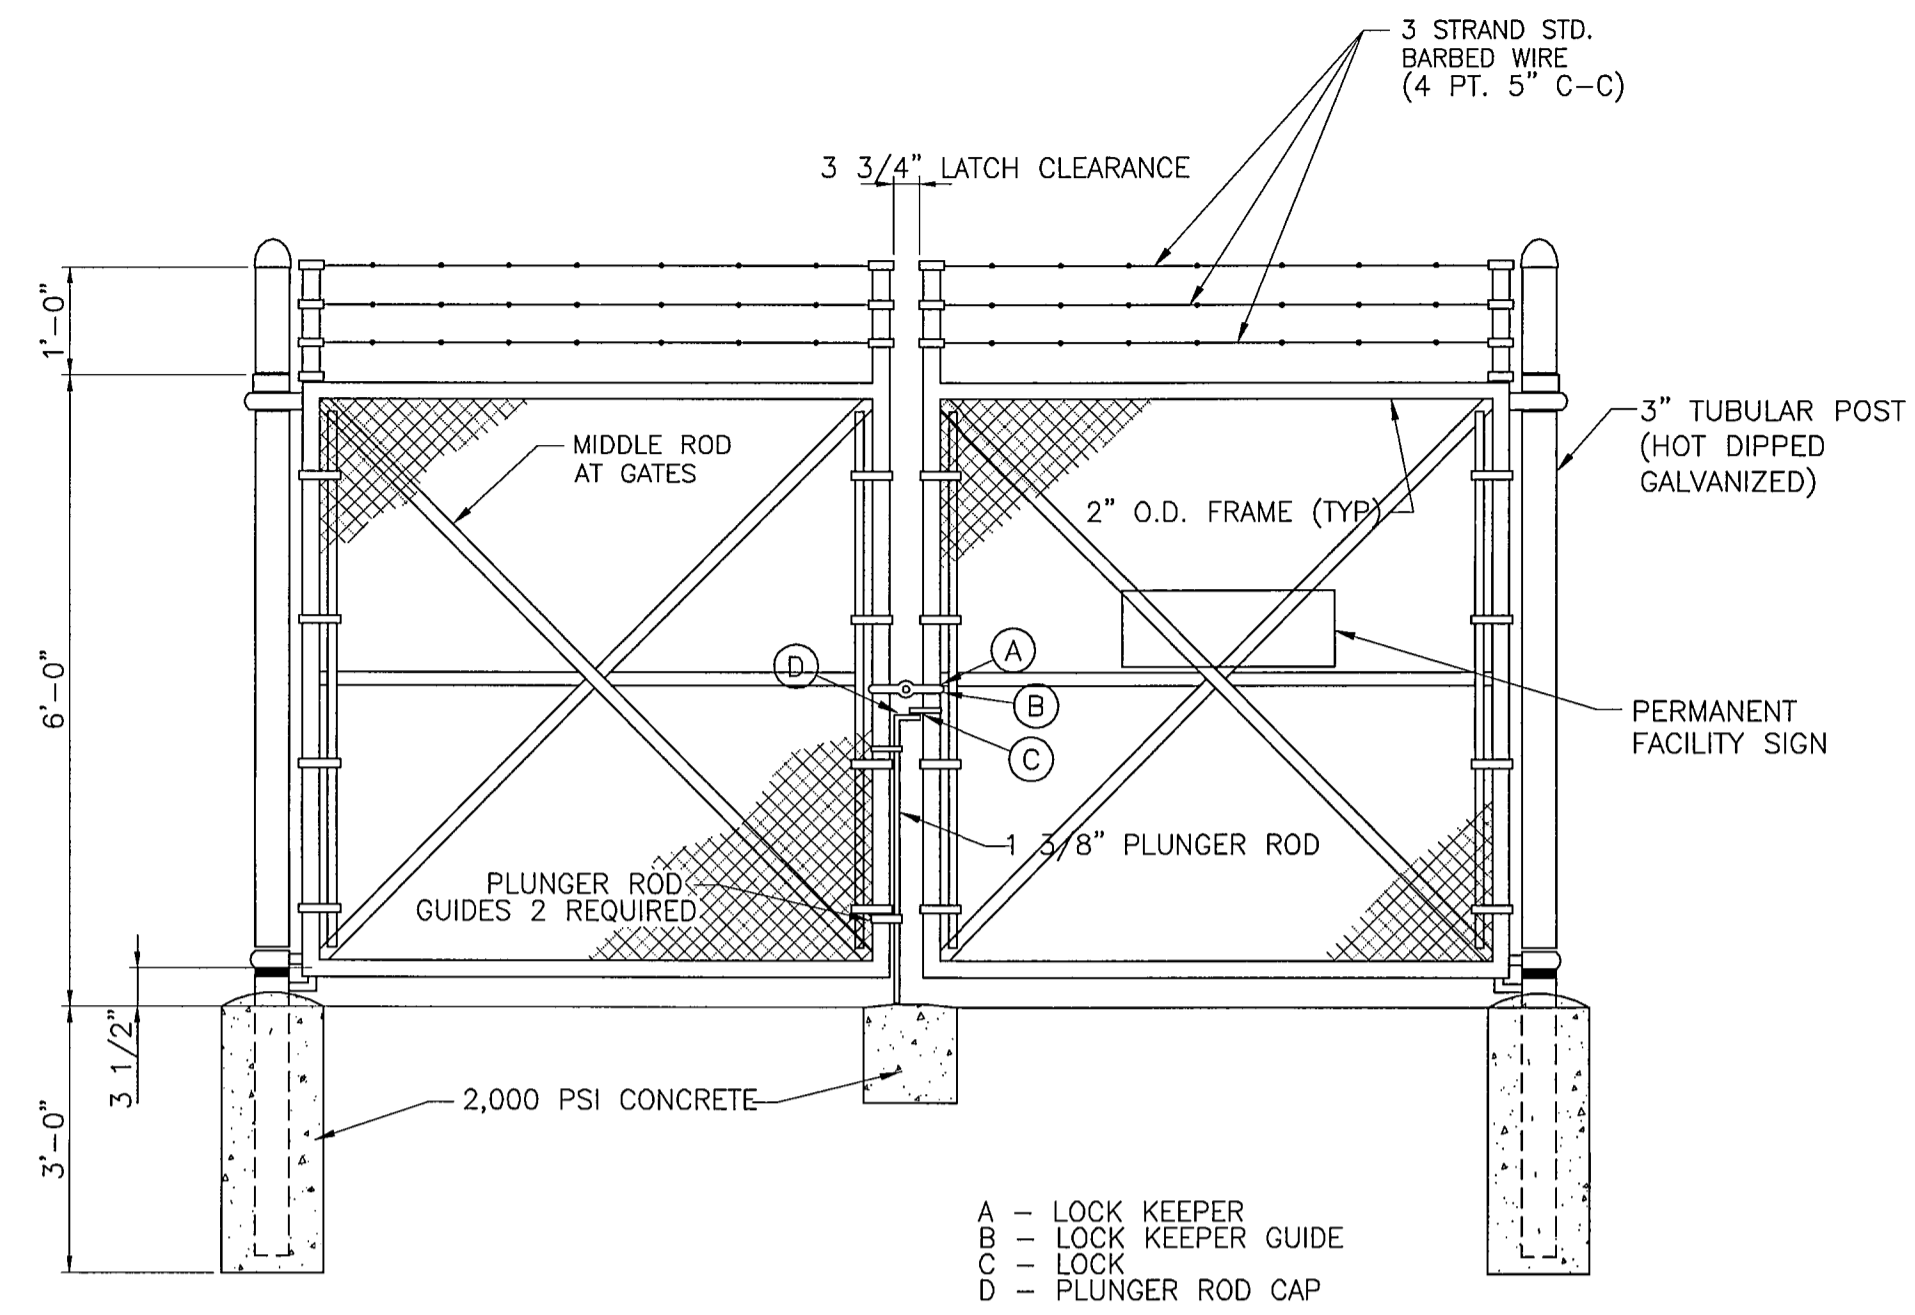

**NOTE:**  
PROVIDE BALCK VINYL COATING ON CHAIN LINK FENCE.

**CHAIN LINK FENCE GATE DETAIL**  
NOT TO SCALE

**NOTES:**


REQUIREMENTS FOR COATING OF INTERIOR SURFACES OF WETWELL IF CON SHIELD ADDITIVE IS NOT USED:


1. SURFACE PREPARATION: AS REQUIRED BY THE MANUFACTURER FOR CAST-IN-PLACE CONCRETE SURFACES.
2. PRODUCT AND MANUFACTURER: PROVIDE ONE OF THE FOLLOWING:
  - a. CHESTERTON
    - 1) PRIMER/FINISH: PF&L 2300 - TROWEL-APPLIED @ 1/16 TO 1/8"
  - b. RAVEN LINING SYSTEMS INC.
    - 1) PRIMER: AQUATAPOXY A-10 - 4 TO 8 MILS DFT
    - 2) FINISH: RAVEN 405 - 125 TO 200 MILS DFT; 2 COATS REQUIRED TO ACHIEVE TOTAL DFT OF 125 MILS
  - c. SPECTRASHIELD
    - 1) PRIMER: MOISTURE-DISPLACEMENT BARRIER PRIMER, MODIFIED POLYMER MOISTURE BARRIER, POLYURETHANE/POLYMERIC BLEND FOAM "SURFACER"
    - 2) FINISH: MODIFIED POLYMER FINAL CORROSION BARRIER
  - d. SAUREISEN
    - 1)PRIMER: SAUREISEN 210S - TO 80 MILS DFT
    - 2)FINISH: SAUREISEN 210 GLAZE - @ 20 MILS DFT
  - e. TNEMEC
    - 1)PRIMER: TNEMEC 218 MORTAR CLAD @ 1/16"
    - 2)FINISH: SERIES 436 PERMA-GLAZE FR @ 60-75 MILS DFT (TOTAL APPROX. 125 MILS DFT)
  - f. ENDURA-FLEX
    - 1) PRIMER: ENDURA-FLEX EF1988; EXPANDED FILM @ 200 MILS; SOLID FILM @ 50 MILS

BAR IS ONE INCH IN LENGTH ON ORIGINAL DRAWING. CHECK SCALE AND ADJUST ACCORDINGLY.

ONE INCH

**AS-BUILT APRIL 2014**  
INFORMATION PROVIDED BY CONTRACTORS  
(NOT FIELD VERIFIED)

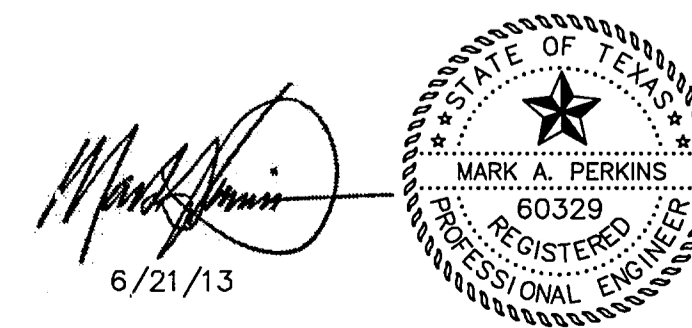

 <b>PERKINS ENGINEERING CONSULTANTS, INC.</b> <small>TBPE REGISTRATION NO. F-8699</small>			
DEVELOPMENT PLANS FOR <b>BREEZY HILL PHASE I</b> <small>ROCKWALL, TEXAS</small>			
<b>LIFT STATION DETAILS</b>			
DRAWN BY	DESIGNED BY	CHECKED BY	SHEET NO.
SRG	MAP	MAP	<b>LS-3</b>
JOB NUMBER	DATE	SCALE	
COR 12-001	JUNE 2013	NOTED	