


DEVELOPMENT PLANS FOR BREEZY HILL FORCE MAIN CITY OF ROCKWALL, TEXAS

INDEX

1	FORCE MAIN PLAN
2	FORCE MAIN PLAN
3	FORCE MAIN PLAN
4	FORCE MAIN PLAN
5	FORCE MAIN PLAN
6	FORCE MAIN PROFILE
7	FORCE MAIN PROFILE
8	FORCE MAIN PROFILE
9	FORCE MAIN PROFILE
1 OF 1	LIFT STATION DRAINAGE BASIN MAP
LS-1	LIFT STATION SITE PLAN
LS-2	LIFT STATION PLAN AND SECTIONS
LS-3	LIFT STATION DETAILS
LS-4	LIFT STATION DETAILS
LSE-1	DETAILS & TECHNICAL DATA
LSE-2	ELECTRICAL ON-LINE & DETAILS
LSE-3	GENERAL NOTES & SERVICE ENTRANCE ONE-LINE

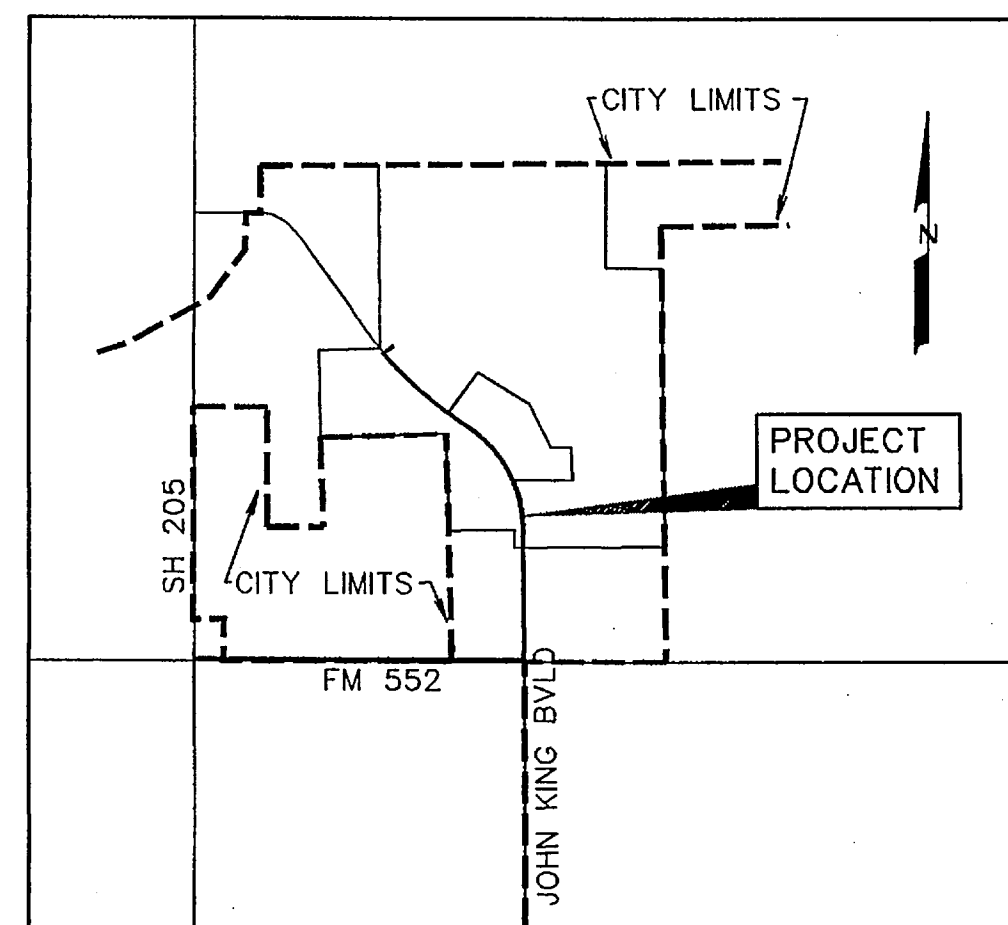

VICINITY MAP
NOT TO SCALE

PREPARED FOR
BH PHASE 1 SF, LTD.
8214 WESTCHESTER DRIVE, SUITE 710 DALLAS, TEXAS 75225

CORWIN ENGINEERING, INC. — CONSULTING ENGINEERS

200 W. BELMONT, SUITE E

TBPE FIRM #5951

ALLEN, TEXAS 75013

NOTE:

CITY OF ROCKWALL STANDARDS
AND NCTCOG 3rd ADDITION STANDARDS
SHALL BE USED FOR REFERENCE.

AS-BUILT APRIL 2014
INFORMATION PROVIDED BY CONTRACTORS
(NOT FIELD VERIFIED)

NO.	PER CITY COMMENTS	REVISIONS	BY	DATE
2	PER CITY COMMENTS			5/31/13
1	PER CITY COMMENTS			5/22/13

The seal appearing on this document was authorized by Warren L. Corwin, P.E. 57875, on June 21, 2013.

Warren L. Corwin
6/21/2013