


NOTE:
 THE CONTRACTOR SHALL CONTACT NTMWD ENGINEERING AT (972) 442-5405 AT LEAST 48 HOURS PRIOR TO PERFORMING ANY WORK IN THE VICINITY OF THE NTMWD FACILITIES.

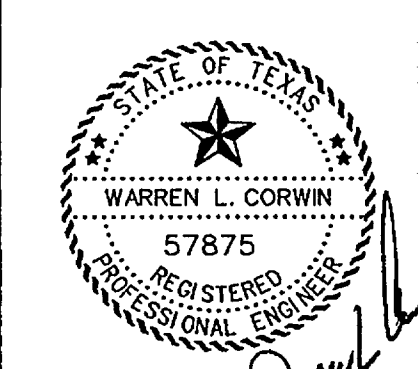

The seal appearing on this document was authorized by Warren L. Corwin, P.E. 57875, on June 21, 2013.

CORWIN ENGINEERING, INC.
 200 W. BELMONT, SUITE E
 ALLEN, TEXAS 75013 (972) 396-1200
 TBP FIRM #5951

DEVELOPMENT PLANS FOR
BREEZY HILL
FORCE MAIN
 ROCKWALL, TEXAS

FORCE MAIN PROFILE

AS-BUILT APRIL 2014
 INFORMATION PROVIDED BY CONTRACTORS
 (NOT FIELD VERIFIED)

DRAWN BY	DESIGNED BY	CHECKED BY	SHEET NO.
JOB NUMBER	DATE	SCALE: HOR: 1"=40'	7 OF 9
12003	OCTOBER 2012	VER: 1"=4'	