


AS-BUILT JULY 2014
 INFORMATION PROVIDED
 BY CONTRACTORS
 (NOT FIELD VERIFIED)

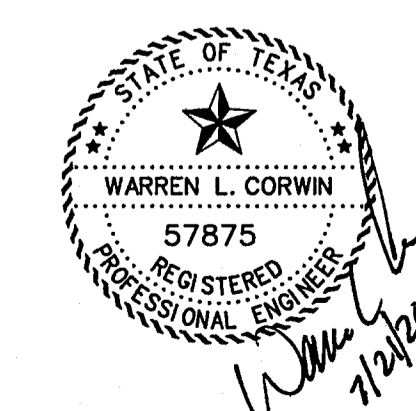

The seal appearing on this document was authorized by Warren L. Corwin, P.E. 57875, on July 21, 2014

CORWIN ENGINEERING, INC.
 200 W. BELMONT, SUITE E
 ALLEN, TEXAS 75013 (972)396-1200
 TBPE FIRM #5951

DEVELOPMENT PLANS FOR
**BREEZY HILL
 PHASE 2
 ROCKWALL, TEXAS**

AMBER KNOLL DRIVE

DRAWN BY	DESIGNED BY	CHECKED BY	SHEET NO.
J3022	MAY 2013	SCALE: HOR: 1"=40' VER: 1"=4'	8 OF 25