



◇ - STREET NAME CHANGE

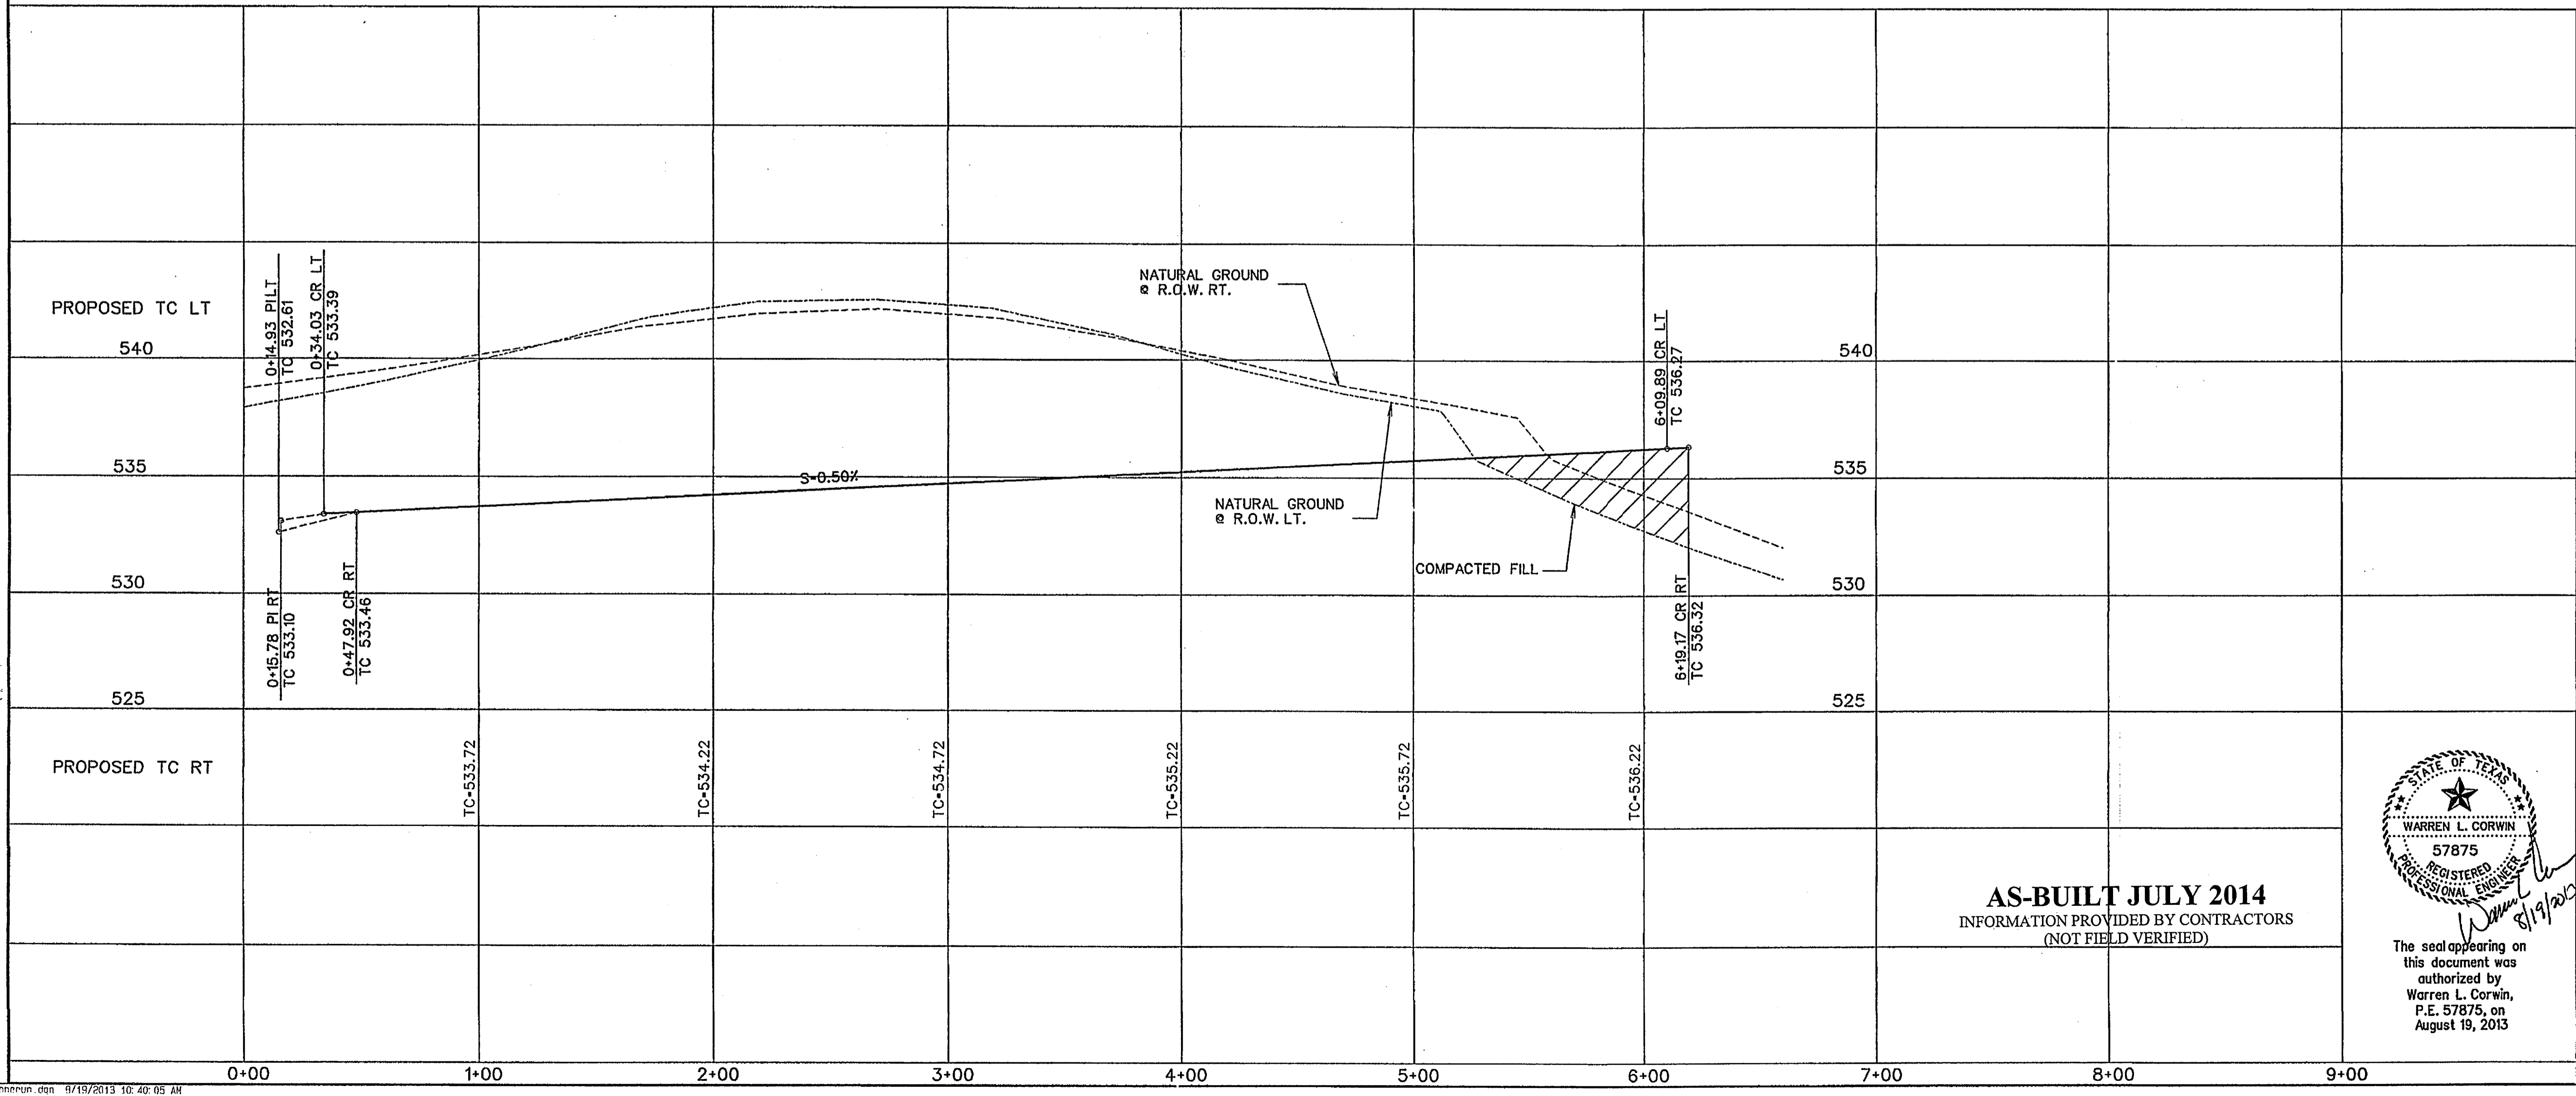

RELEASED FOR CONSTRUCTION
 ALL RESPONSIBILITY FOR ADEQUACY OF DESIGN
 REMAINS WITH THE DESIGN ENGINEER. THE CITY
 OF ROCKWALL, IN REVIEWING AND RELEASING
 THESE PLANS FOR CONSTRUCTION, ASSUMES NO
 RESPONSIBILITY FOR ADEQUACY OR ACCURACY
 OF DESIGN.
 CITY _____ DATE _____

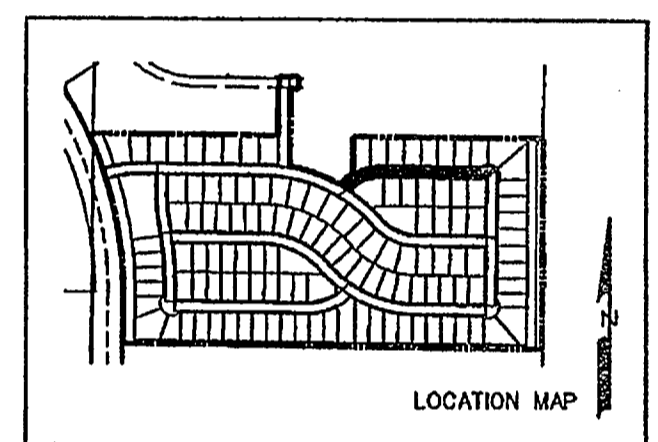

The seal appearing on this document was authorized by Warren L. Corwin, P.E. 57875, on August 19, 2013

AS-BUILT JULY 2014
 INFORMATION PROVIDED BY CONTRACTORS
 (NOT FIELD VERIFIED)

CORWIN ENGINEERING, INC.
 200 W. BELMONT, SUITE E
 ALLEN, TEXAS 75013 (972) 596-1200
 TBP# FIRM #5951

DEVELOPMENT PLANS FOR
BREEZY HILL
 PHASE 2
 ROCKWALL, TEXAS

LONE RUN DRIVE

DRAWN BY	DESIGNED BY	CHECKED BY	SHEET NO.
JOB NUMBER	DATE	SCALE: HOR: 1"=40' VER: 1"=4'	10 of 25
13022	MAY 2013		