

NOTE:  
CONTRACTOR SHALL VERIFY ALL EXISTING UTILITIES PRIOR TO CONSTRUCTION. EXISTING UTILITY LOCATION AND ELEVATION ARE BASED ON AS-BUILT DRAWINGS AND MAY DIFFER IN ACTUAL LOCATION AND ELEVATION.

9+85.78 LINE 'S-2'  
- 0+00.00 LINE 'S-5'  
CONST. STD. 4' DIA. M.H.  
T. RIM = 532.80

8" S.S. @ 1.30%

8" S.S. @ 3.00%

8" S.S. @ 3.30%

8" S.S. @ 2.20%

8" S.S. @ 0.33%

LINE 'S-3'

LINE 'S-1'

8" S.S. @ 3.71%

8" S.S. @ 2.70%

8" S.S. @ 0.33%

8" S.S. @ 0.50%


RELEASED FOR CONSTRUCTION  
ALL RESPONSIBILITY FOR ADEQUACY OF DESIGN REMAINS WITH THE DESIGN ENGINEER. THE CITY OF ROCKWALL, IN REVIEWING AND RELYING ON THESE PLANS FOR CONSTRUCTION, ASSUMES NO RESPONSIBILITY FOR ADEQUACY OR ACCURACY OF DESIGN.

**CORWIN ENGINEERING, INC.**  
200 W. BELMONT, SUITE E  
ALLEN, TEXAS 75013 (972)396-1200  
TBP FIRM #5951

DEVELOPMENT PLANS FOR  
**BREEZY HILL**  
PHASE 2  
ROCKWALL, TEXAS

SANITARY SEWER PROFILES

**AS-BUILT JULY 2014**  
INFORMATION PROVIDED BY CONTRACTORS  
(NOT FIELD VERIFIED)

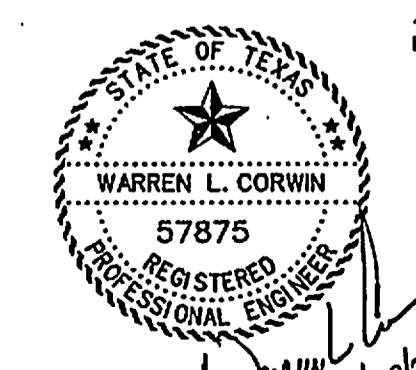

The seal appearing on this document was authorized by  
Warren L. Corwin,  
P.E. 57875, on  
August 19, 2013

DRAWN BY	DESIGNED BY	CHECKED BY	SHEET NO.
J3022	MAY 2013	SCALE: HOR: 1"=40' VER: 1"=4'	15 OF 25