


NOTE:  
CONTRACTOR SHALL VERIFY ALL EXISTING  
UTILITIES PRIOR TO CONSTRUCTION. EXISTING  
UTILITY LOCATION AND ELEVATION ARE BASED ON  
AS-BUILT DRAWINGS AND MAY DIFFER IN ACTUAL  
LOCATION AND ELEVATION.

RELEASED FOR CONSTRUCTION  
ALL RESPONSIBILITY FOR ADEQUACY OF DESIGN  
REMAINS WITH THE DESIGN ENGINEER. THE CITY  
OF ROCKWALL, IN REVIEWING AND REVISIONING  
PLANS FOR CONSTRUCTION, ASSUMES NO  
RESPONSIBILITY FOR ADEQUACY OR ACCURACY  
OF DESIGN.

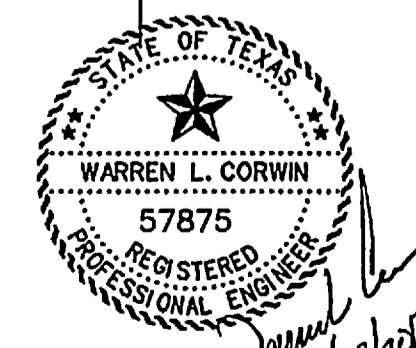

The seal appearing on  
this document was  
authorized by  
Warren L. Corwin,  
P.E. 57875, on  
August 19, 2013

**AS-BUILT JULY 2014**  
INFORMATION PROVIDED BY CONTRACTORS  
(NOT FIELD VERIFIED)

**CORWIN ENGINEERING, INC.**  
200 W. BELMONT, SUITE E  
ALLEN, TEXAS 75013 (972)396-1200  
TBPE FIRM #5951

DEVELOPMENT PLANS FOR  
**BREZY HILL**  
PHASE 2  
ROCKWALL, TEXAS

SANITARY SEWER PROFILES

DRAWN BY	DESIGNED BY	CHECKED BY	SHEET NO.
JOB NUMBER	DATE	SCALE: HOR: 1"=40' VER: 1"=4'	16 OF 25
13022	MAY 2013		