

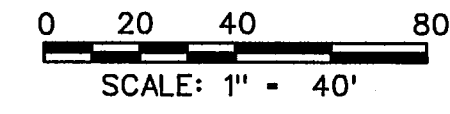


CURVE DATA				
CURVE NO.	①	②	③	④
Δ	01° 49' 24"	02° 02' 41"	07° 26' 03"	51° 52' 34"
R	625.00'	1755.00'	1755.00'	65.00'
T	9.95'	36.93'	114.02'	31.62'
L	19.89'	73.86'	227.72'	58.85'

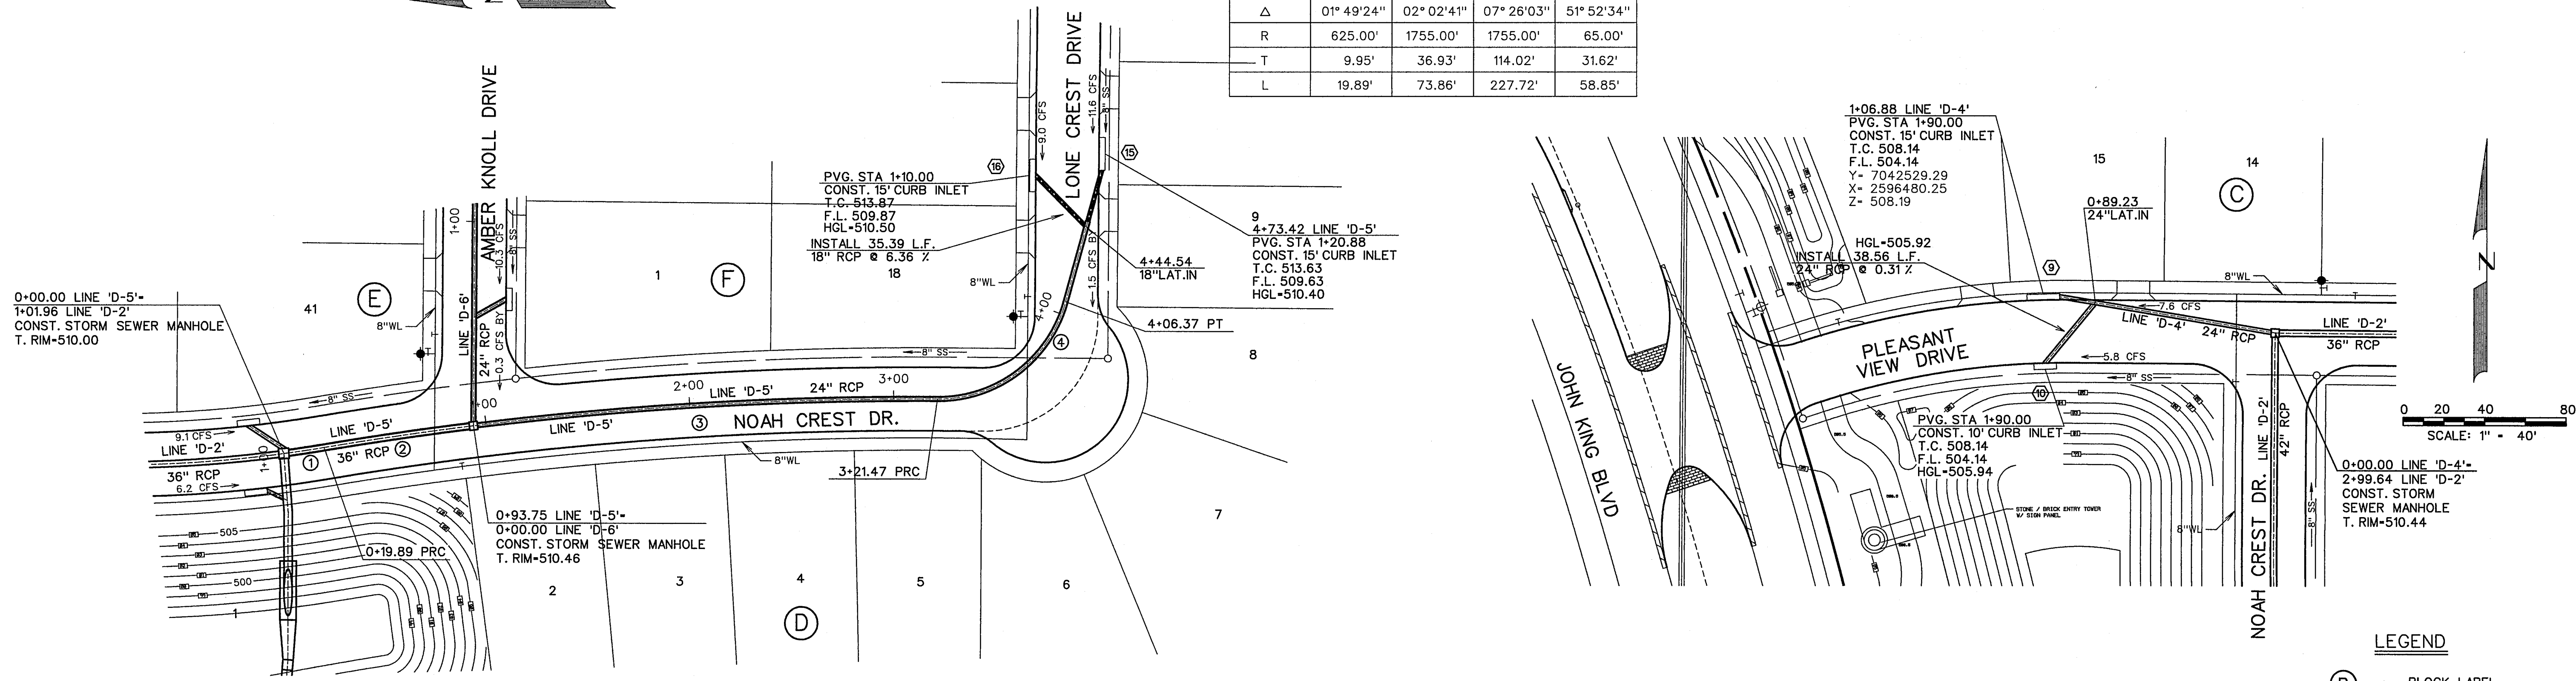

**LEGEND**

- ⓑ - BLOCK LABEL
- Ⓢ - INLET NUMBER
- ① - CURVE NUMBER
- - SANITARY SEWER
- ⊕ - WATER
- ══ - PROPOSED STORM SEWER

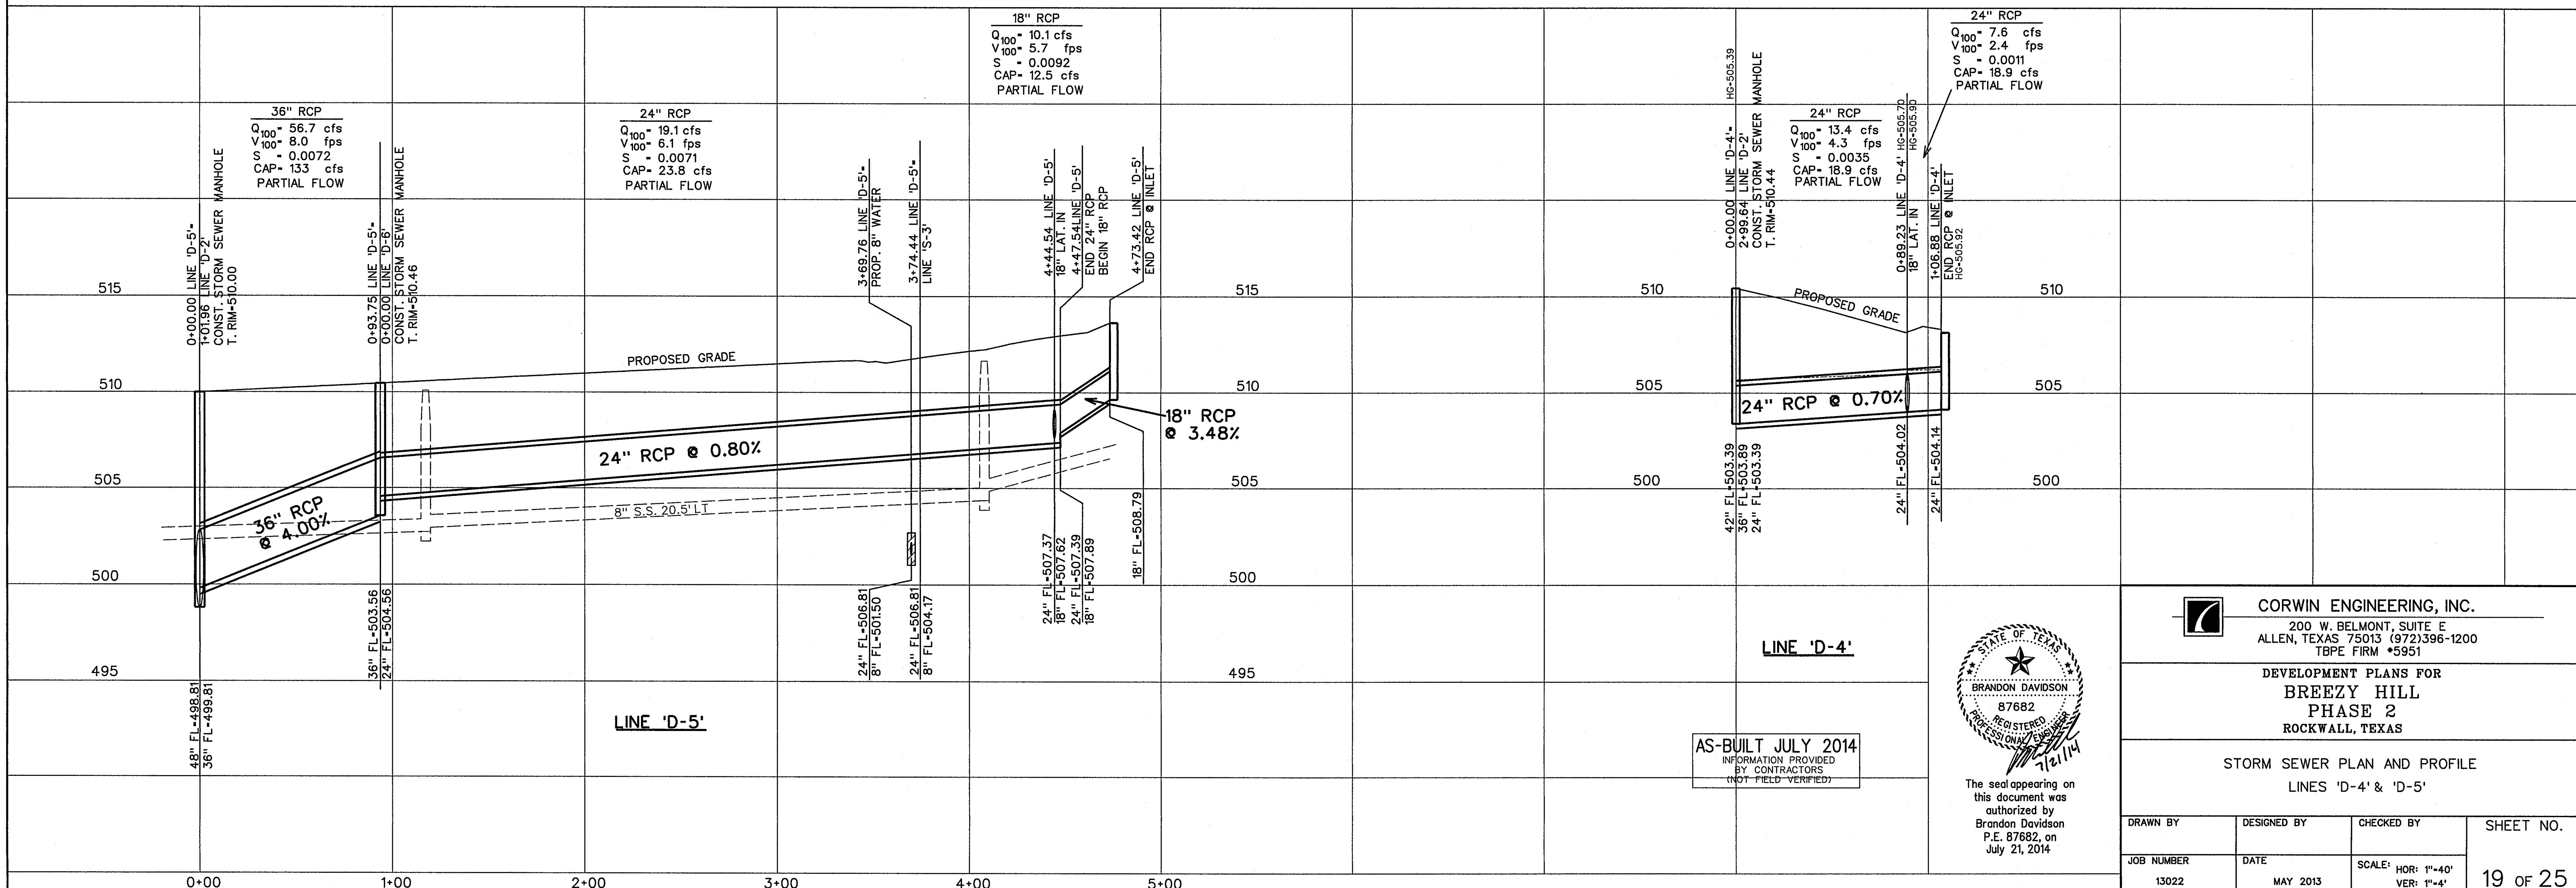

AS-BUILT JULY 2014  
INFORMATION PROVIDED  
BY CONTRACTORS  
(NOT FIELD VERIFIED)



The seal appearing on this document was authorized by Brandon Davidson P.E. 87682, on July 21, 2014

**CORWIN ENGINEERING, INC.**  
200 W. BELMONT, SUITE E  
ALLEN, TEXAS 75013 (972)396-1200  
TBPE FIRM #5951

DEVELOPMENT PLANS FOR  
**BREEZY HILL**  
PHASE 2  
ROCKWALL, TEXAS

STORM SEWER PLAN AND PROFILE  
LINES 'D-4' & 'D-5'

DRAWN BY	DESIGNED BY	CHECKED BY	SHEET NO.
J3022	MAY 2013		19 OF 25