



CURVE DATA			
CURVE NO.	①	②	③
Δ	49° 05' 54"	21° 41' 33"	0° 11'
R	325.00'	515.00'	'
T	148.45'	98.67'	'
L	278.50'	194.98'	'

SCALE: 1" = 40'

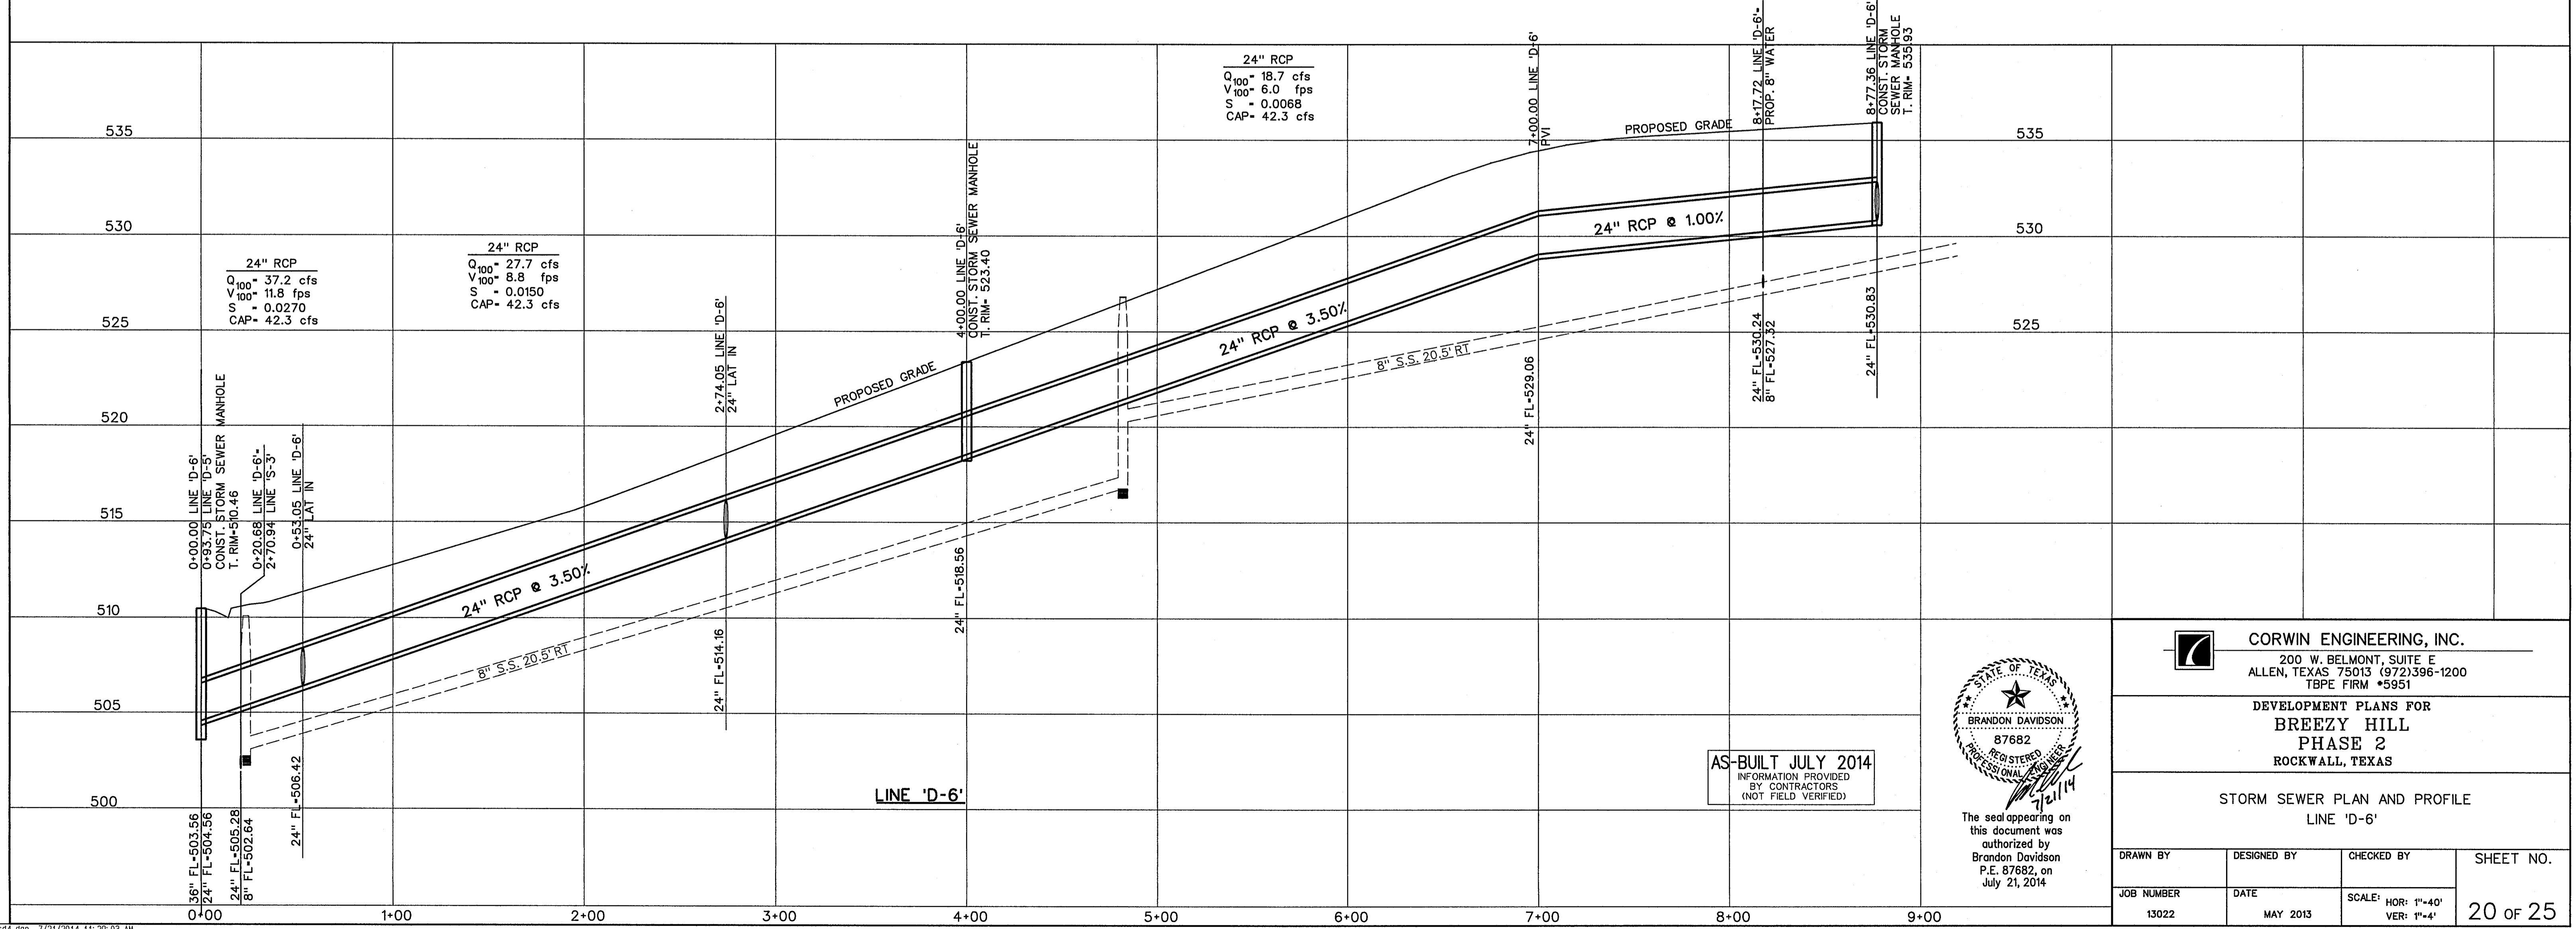

AS-BUILT JULY 2014  
INFORMATION PROVIDED  
BY CONTRACTORS  
(NOT FIELD VERIFIED)

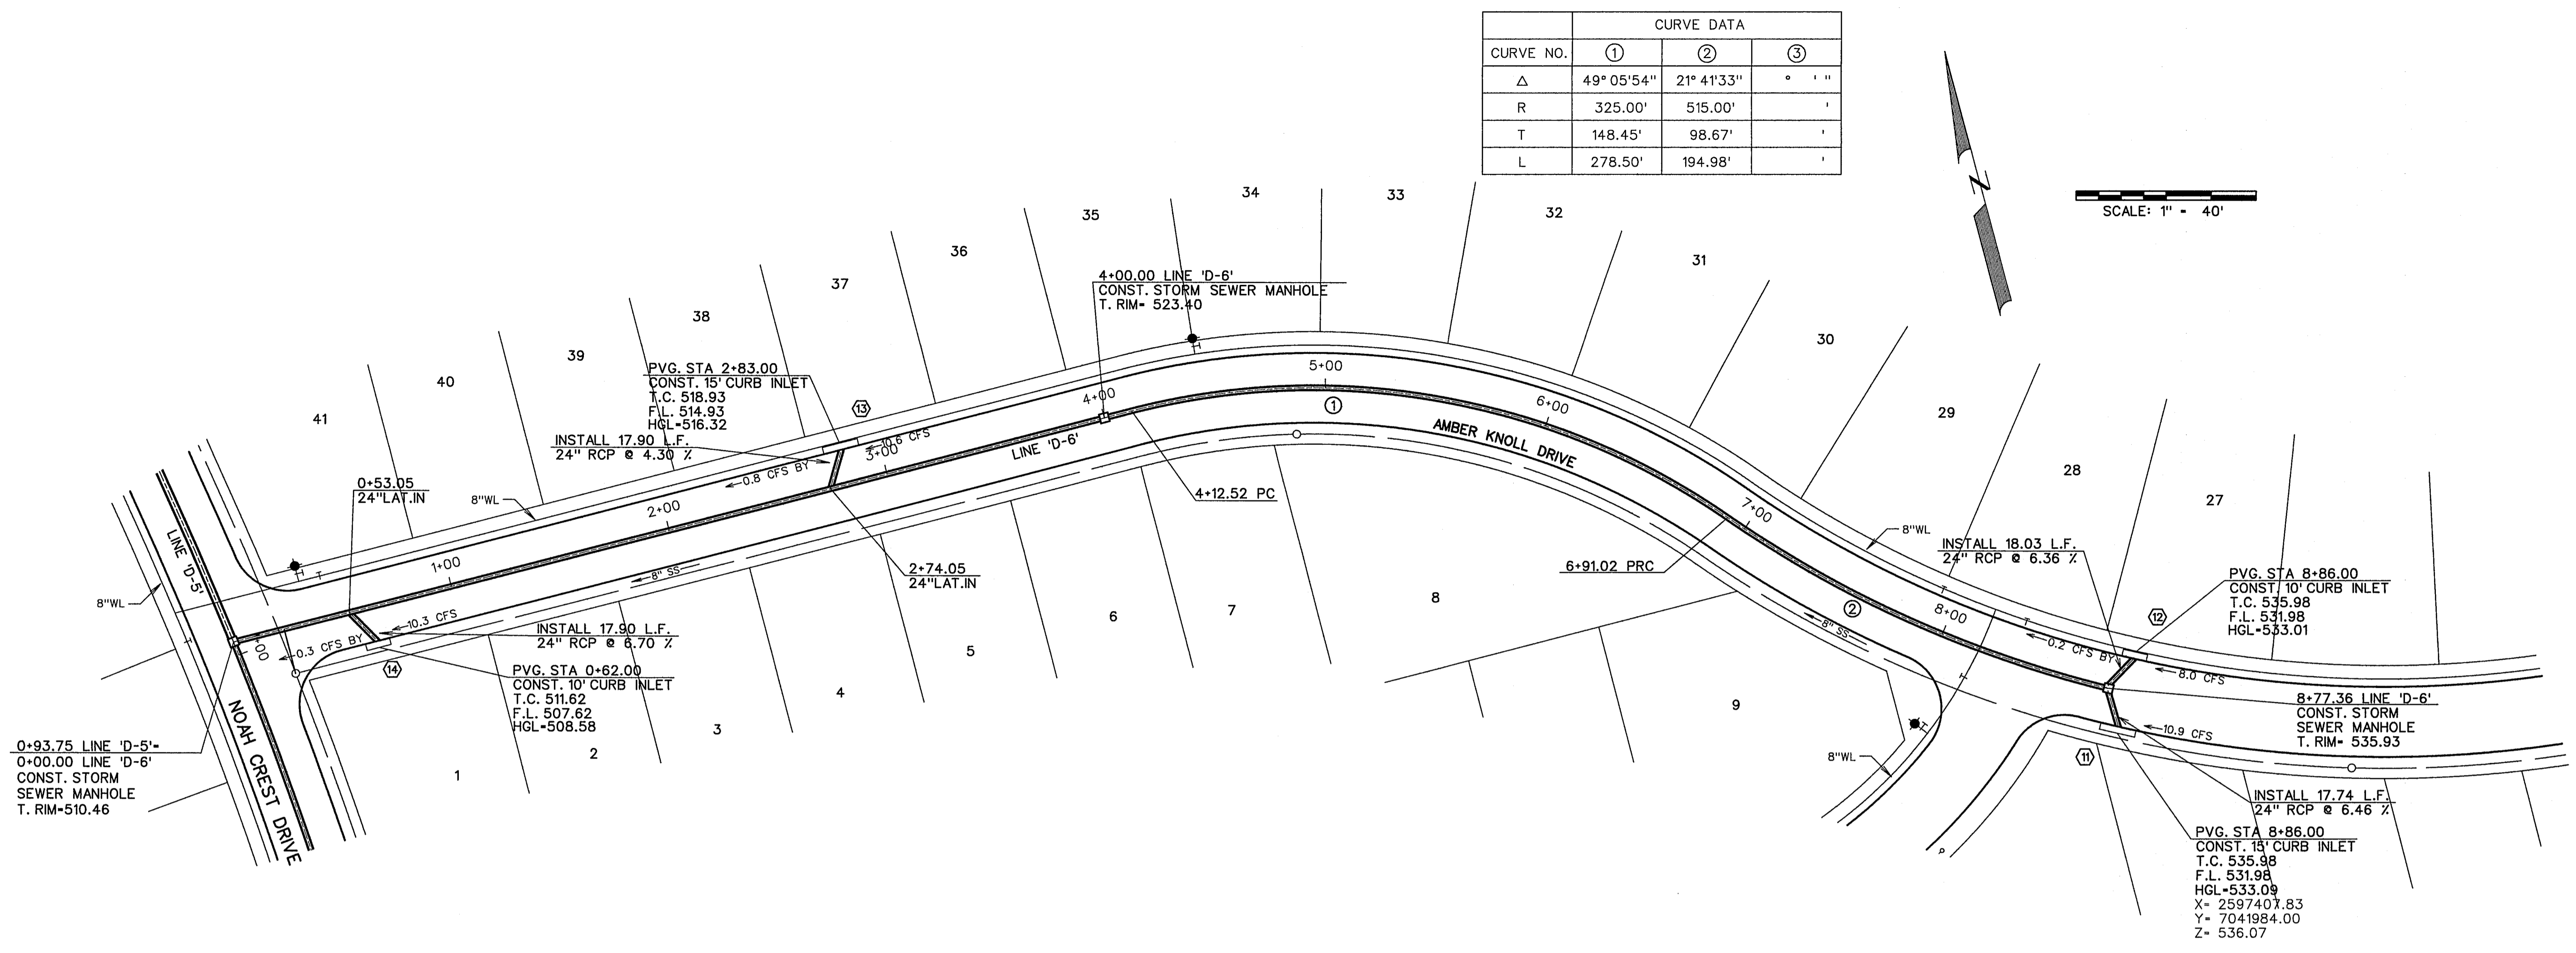

The seal appearing on this document was authorized by Brandon Davidson P.E. 87682, on July 21, 2014

**CORWIN ENGINEERING, INC.**  
200 W. BELMONT, SUITE E  
ALLEN, TEXAS 75013 (972)396-1200  
TBPE FIRM #5951

DEVELOPMENT PLANS FOR  
**BREEZY HILL  
PHASE 2**  
ROCKWALL, TEXAS

STORM SEWER PLAN AND PROFILE  
LINE 'D-6'

DRAWN BY	DESIGNED BY	CHECKED BY	SHEET NO.
JOB NUMBER	DATE	SCALE: HOR: 1"=40' VER: 1"=4'	20 OF 25
13022	MAY 2013		