


DEVELOPMENT PLANS
FOR
BREEZY HILL
PHASE V

CITY OF ROCKWALL, TEXAS

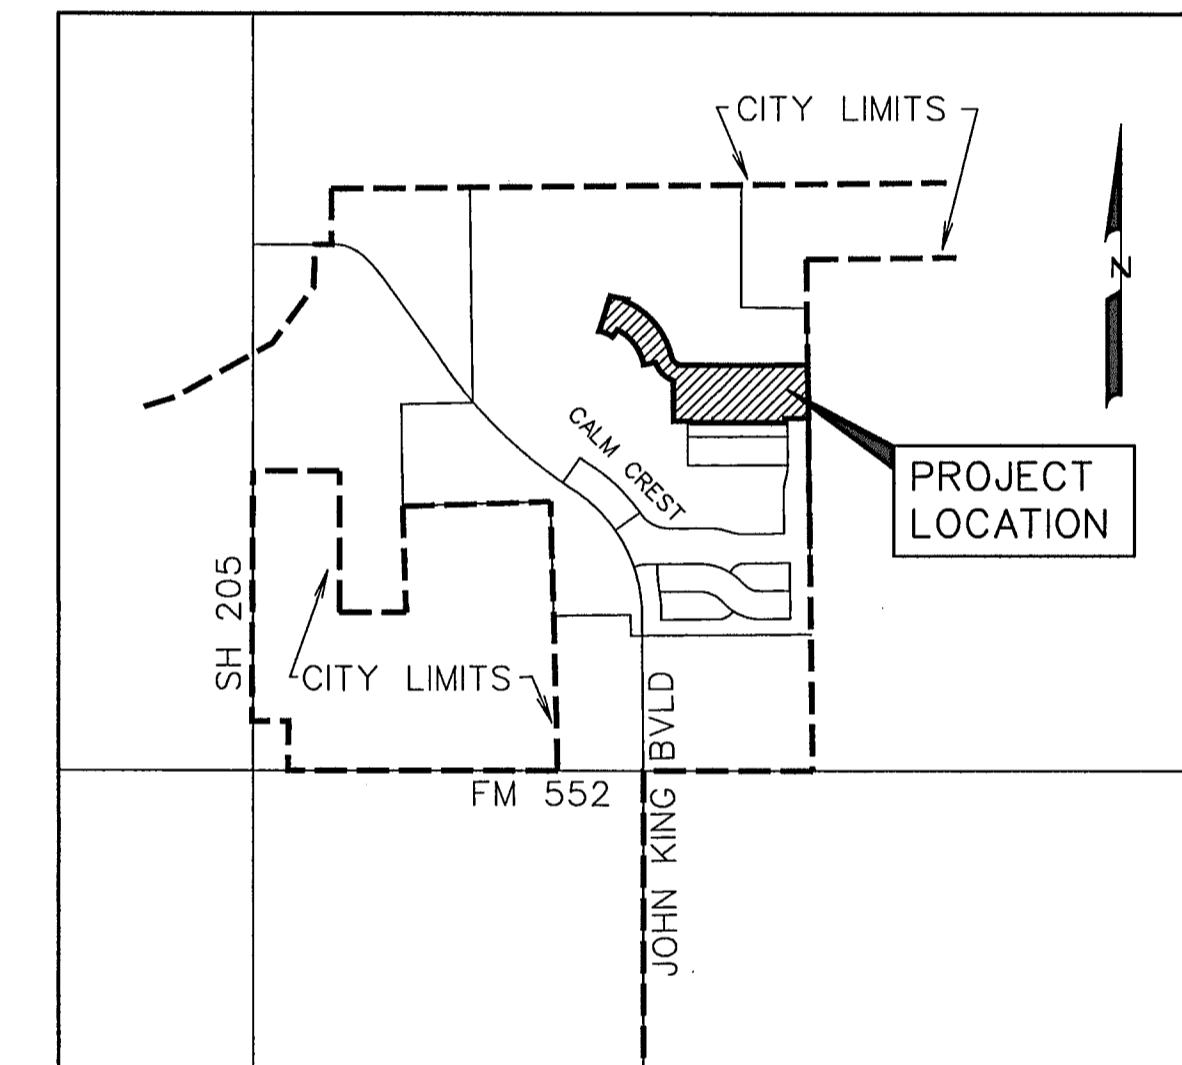

INDEX

- 1 TITLE
- 2 PLAT
- 3 KETTON DRIVE
- 4 HEATHER FALLS DRIVE
- 5 LAZY BROOKE DRIVE STA. 0+00 TO 10+00
- 6 LAZY BROOKE DRIVE 10+00 TO END
- 7 LORION DRIVE
- 8 RAVENBANK DRIVE
- 9 WATER AND SANITARY SEWER PLAN
- 10 SANITARY SEWER PROFILES
- 11 SANITARY SEWER PROFILES
- 12 EXISTING CONDITIONS DRAINAGE AREA MAP
- 13 PROPOSED DRAINAGE AREA MAP
- 13A PROPOSED DRAINAGE AREA MAP
- 14 DRAINAGE CALCULATIONS
- 15 STORM SEWER PLAN AND PROFILE LINES 'D-1' & 'D-2'
- 16 STORM SEWER PLAN AND PROFILE LINES 'D-3' & 'D-4'
- 17 STORM SEWER PLAN AND PROFILE LINE 'D-5'
- 18 STORM SEWER PLAN AND PROFILE LINES 'D-6' & 'D-7'
- 19 STORM SEWER PLAN AND PROFILE LINES 'D-8' & 'D-9'
- 20 STORM SEWER LATERAL PROFILES
- 21 DETENTION POND PLAN - POND 1
- 22 DETENTION POND PLAN - POND 2
- 23 GRADING PLAN
- 24 GRADING PLAN
- 25 EROSION CONTROL PLAN
- 26 STREET SIGN PLAN

PREPARED FOR
BH PHASE III SF, LTD.

8214 WESTCHESTER DRIVE, SUITE 710 DALLAS, TEXAS 75225

CORWIN ENGINEERING, INC. — CONSULTING ENGINEERS


200 W. BELMONT, SUITE E

TBPE FIRM #5951

ALLEN, TEXAS 75013




The seal appearing on
this document was
authorized by
Warren L. Corwin,
P.E. 57875, on
September 27, 2016

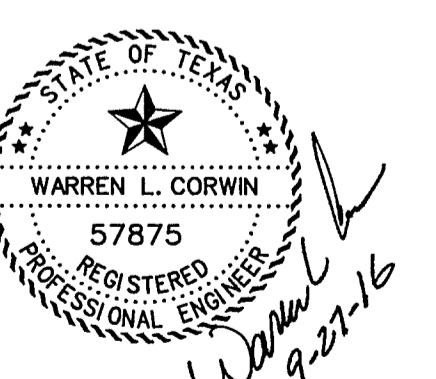

1	CITY COMMENTS	07/27/15
NO.	REVISIONS	DATE

JUNE 2015



NOTE:
CITY OF ROCKWALL STANDARDS
AND NCTCOG 3rd ADDITION STANDARDS
SHALL BE USED FOR REFERENCE.


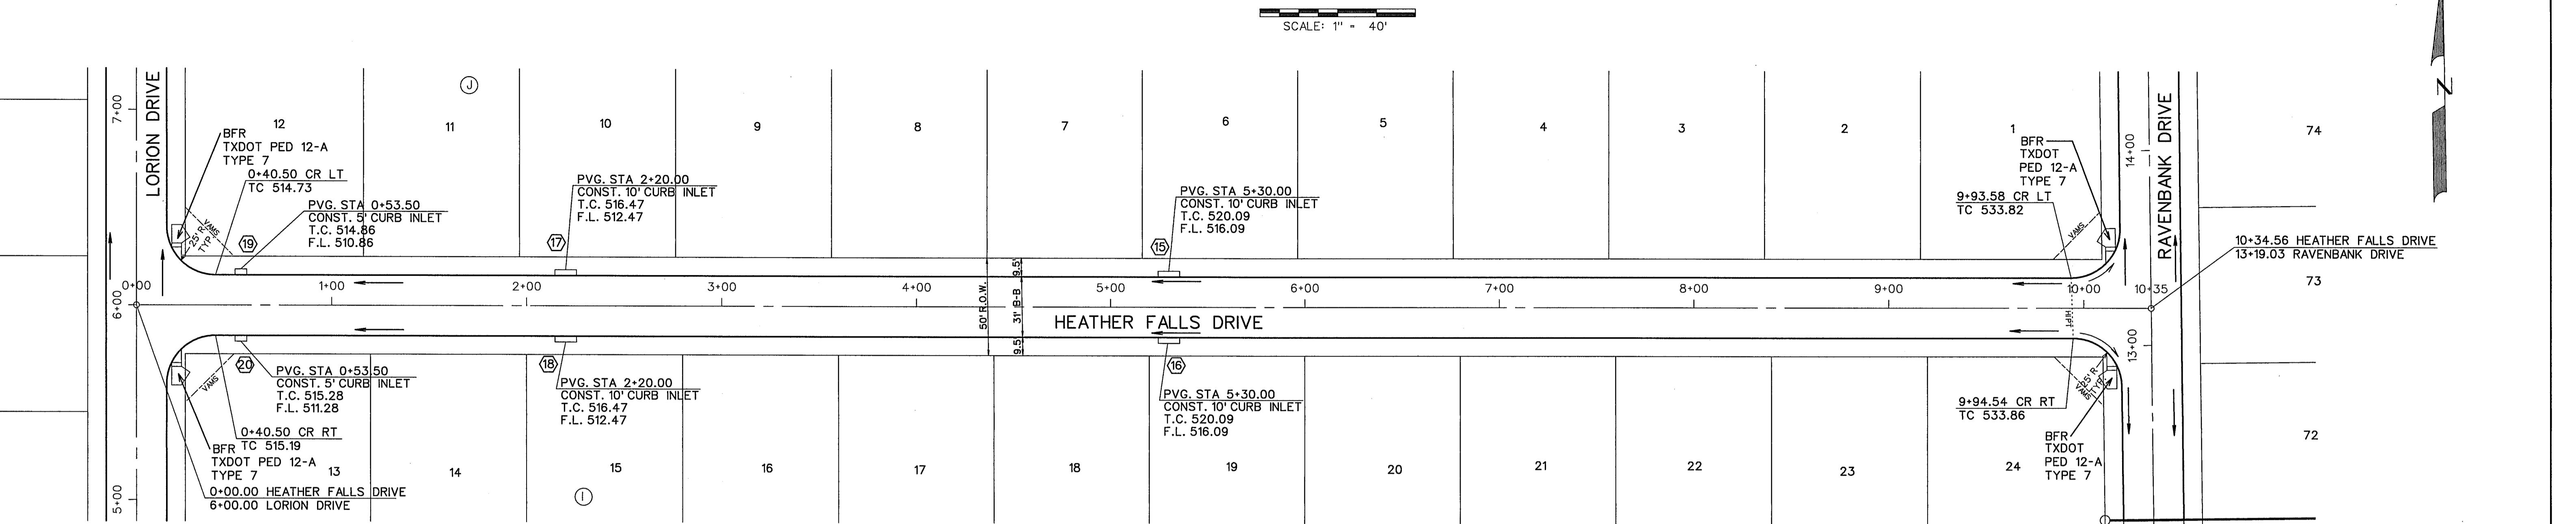



BENCHMARK:

" X " Cut on top of curb on east side of John King Blvd.
approx. 48' north of the centerline of Pleasant View Dr.

ELEVATION = 505.61

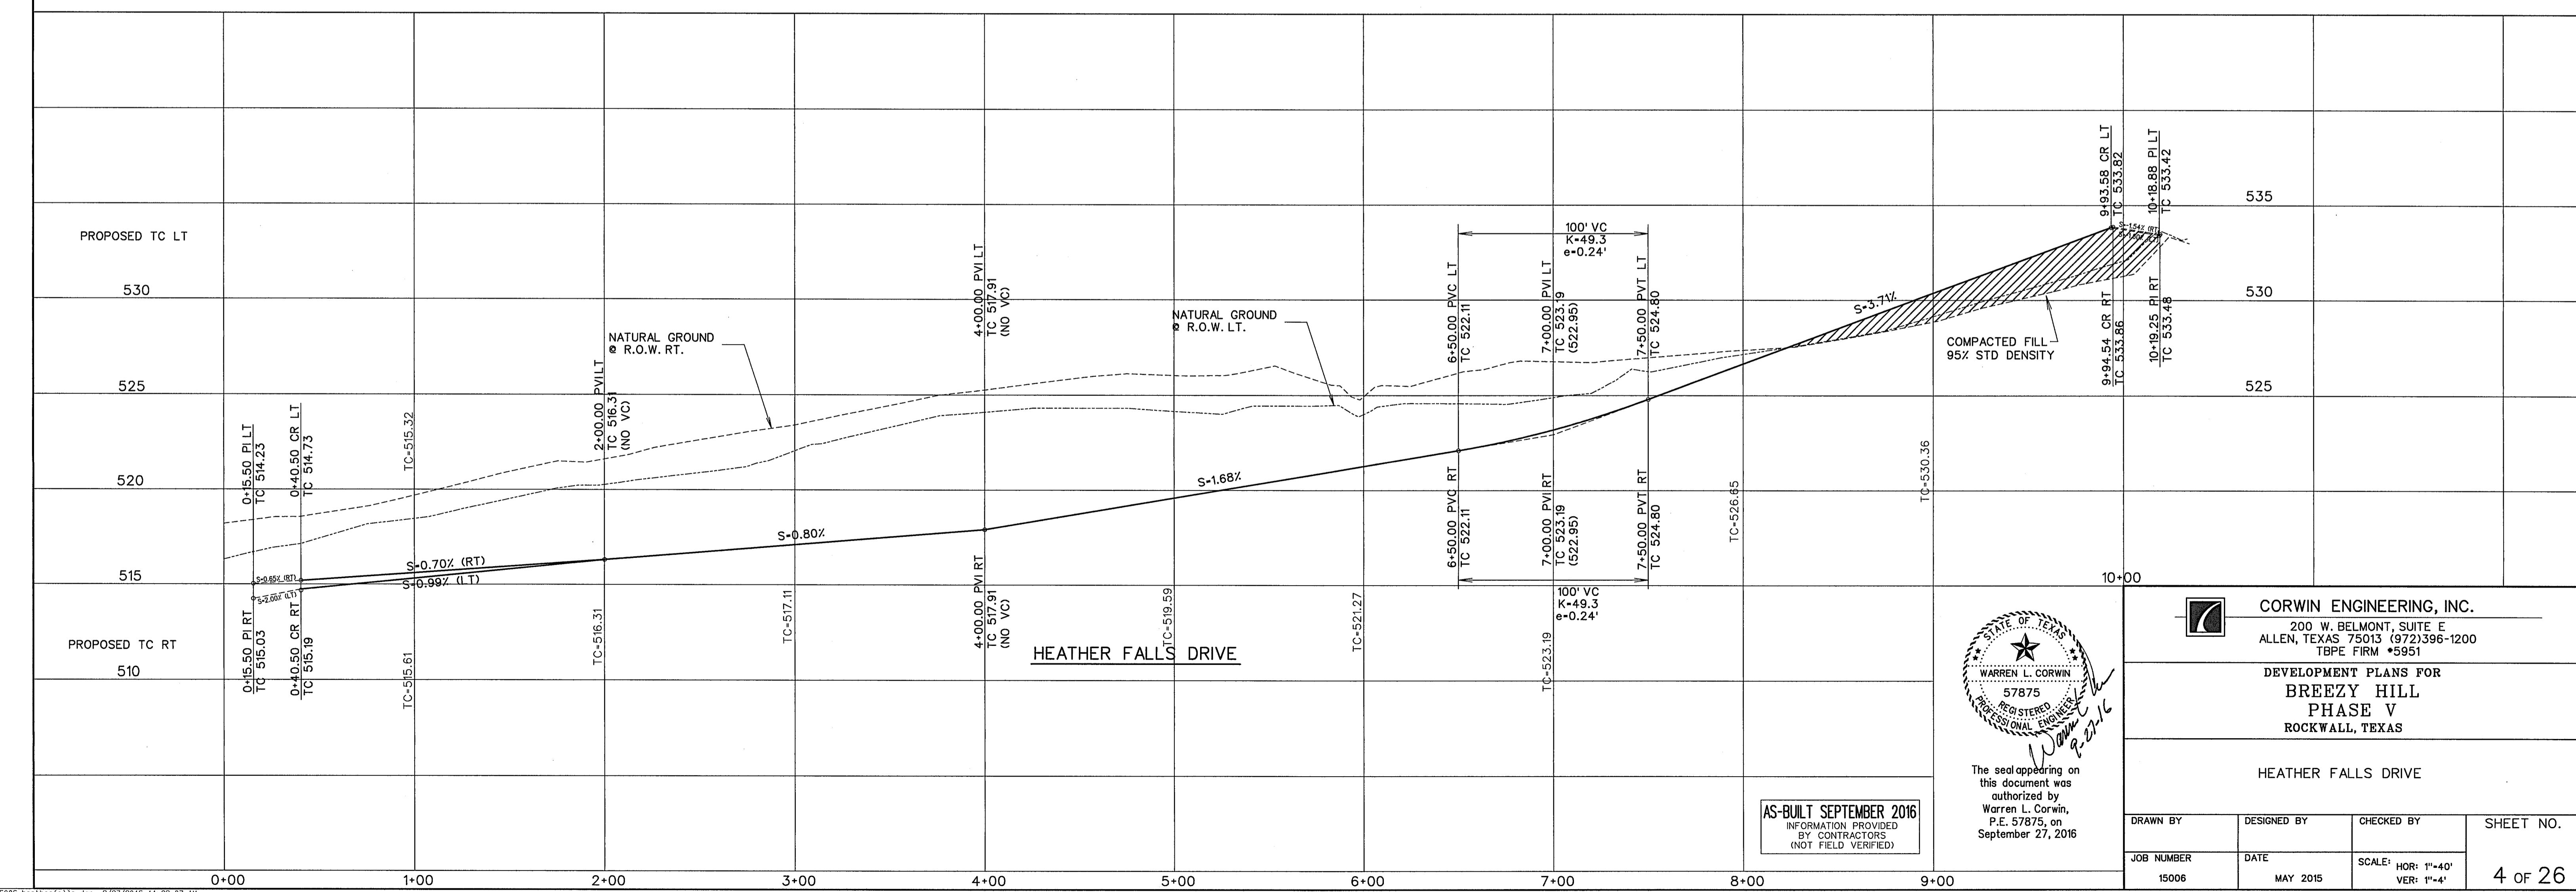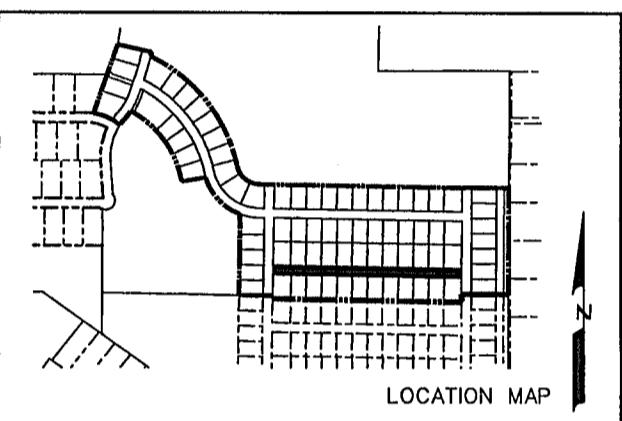


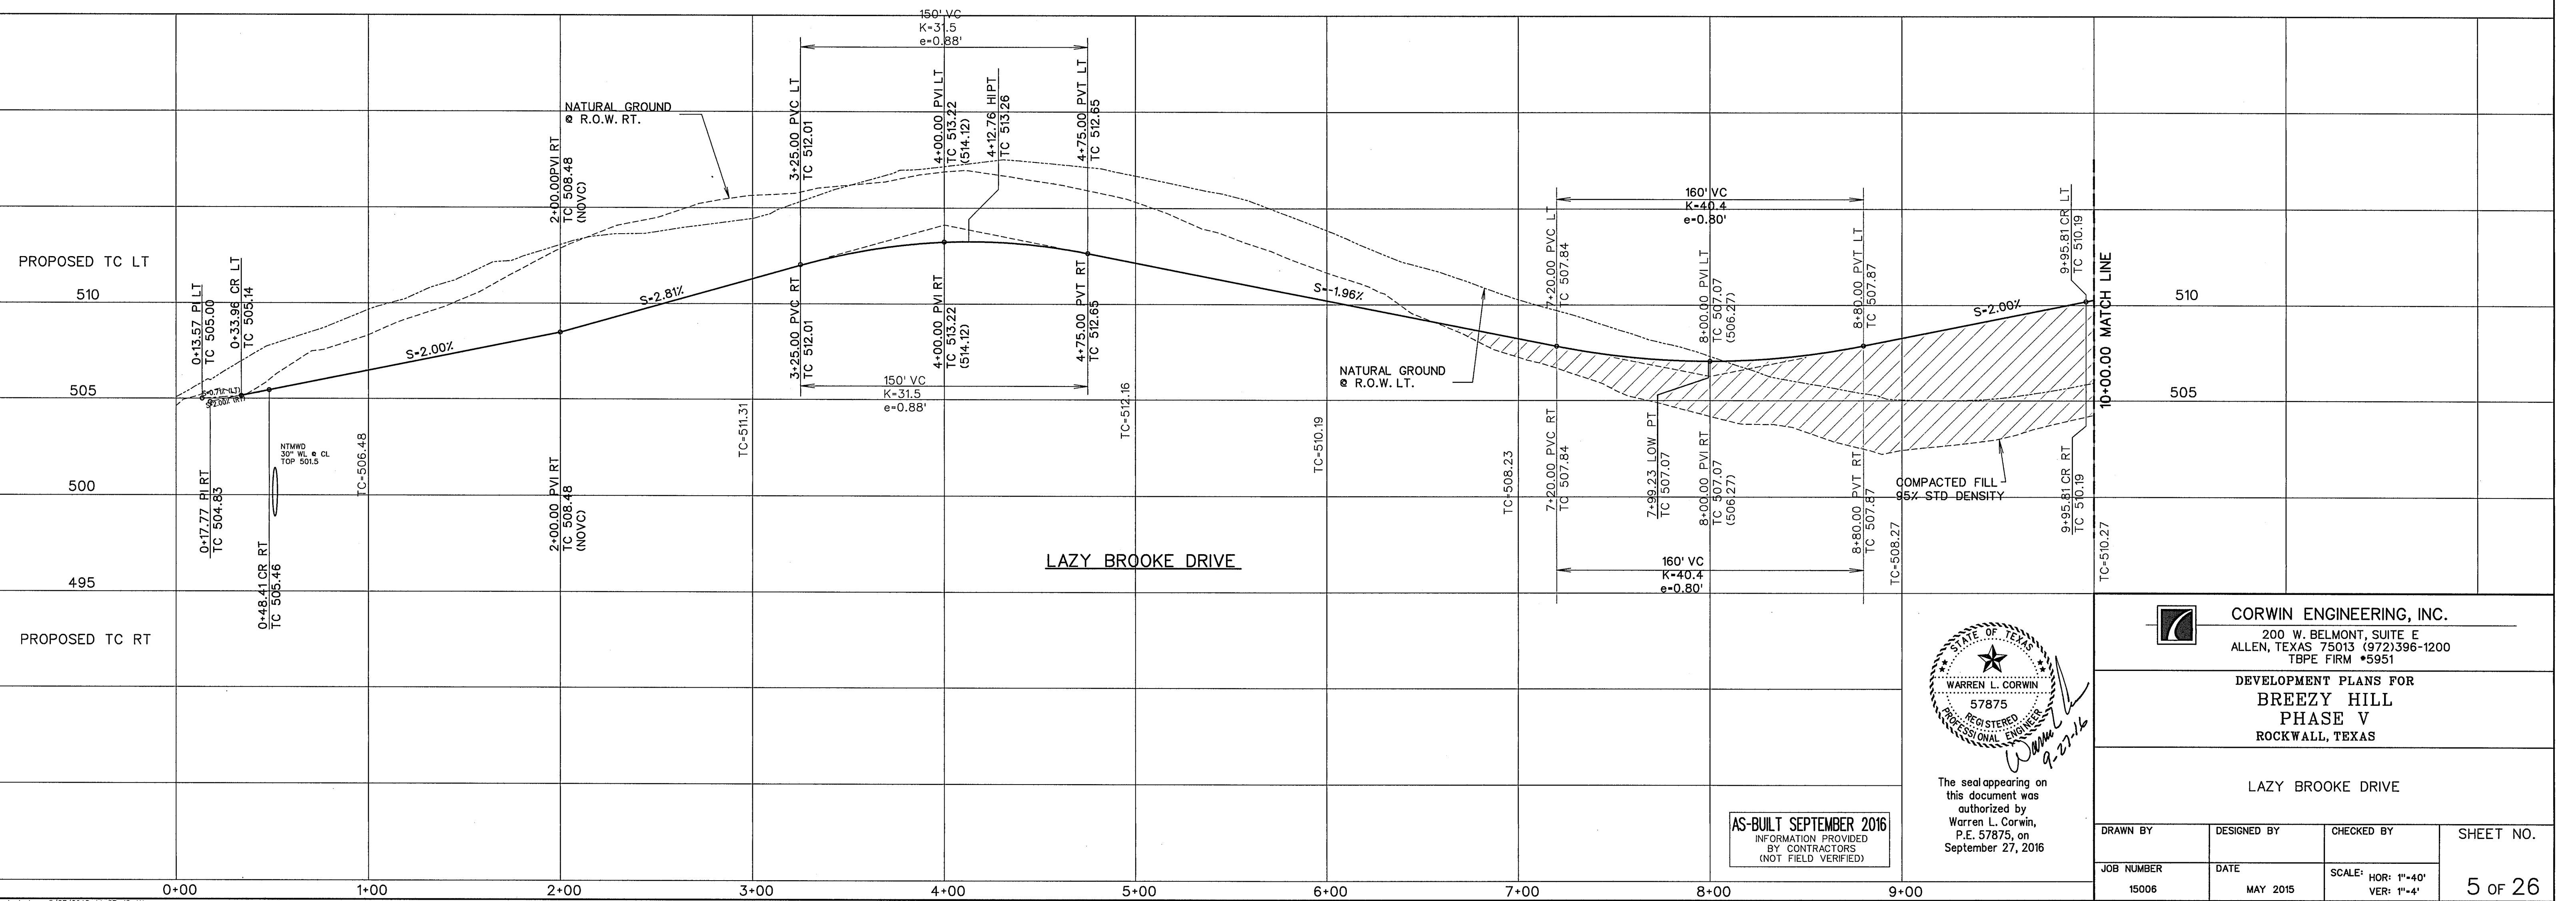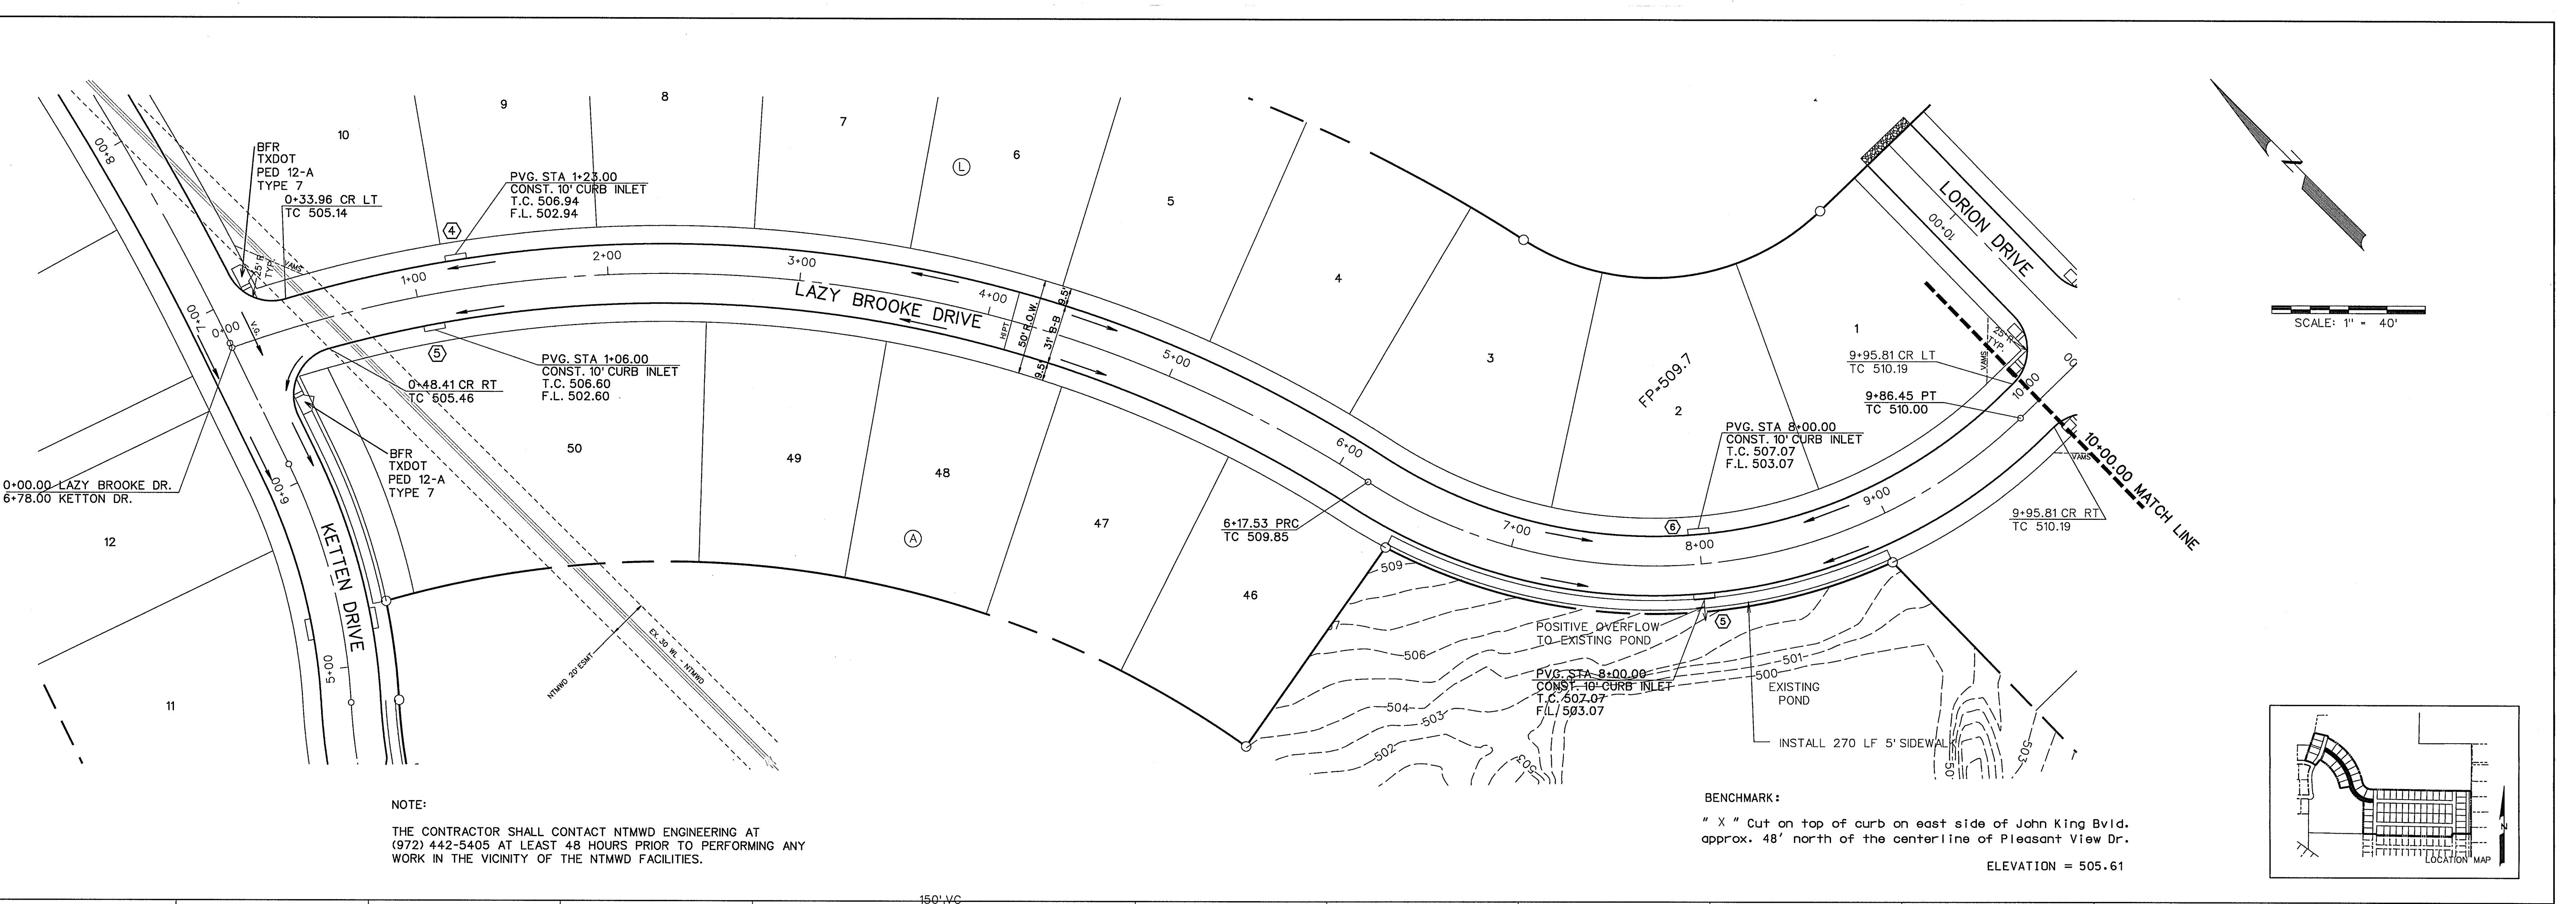

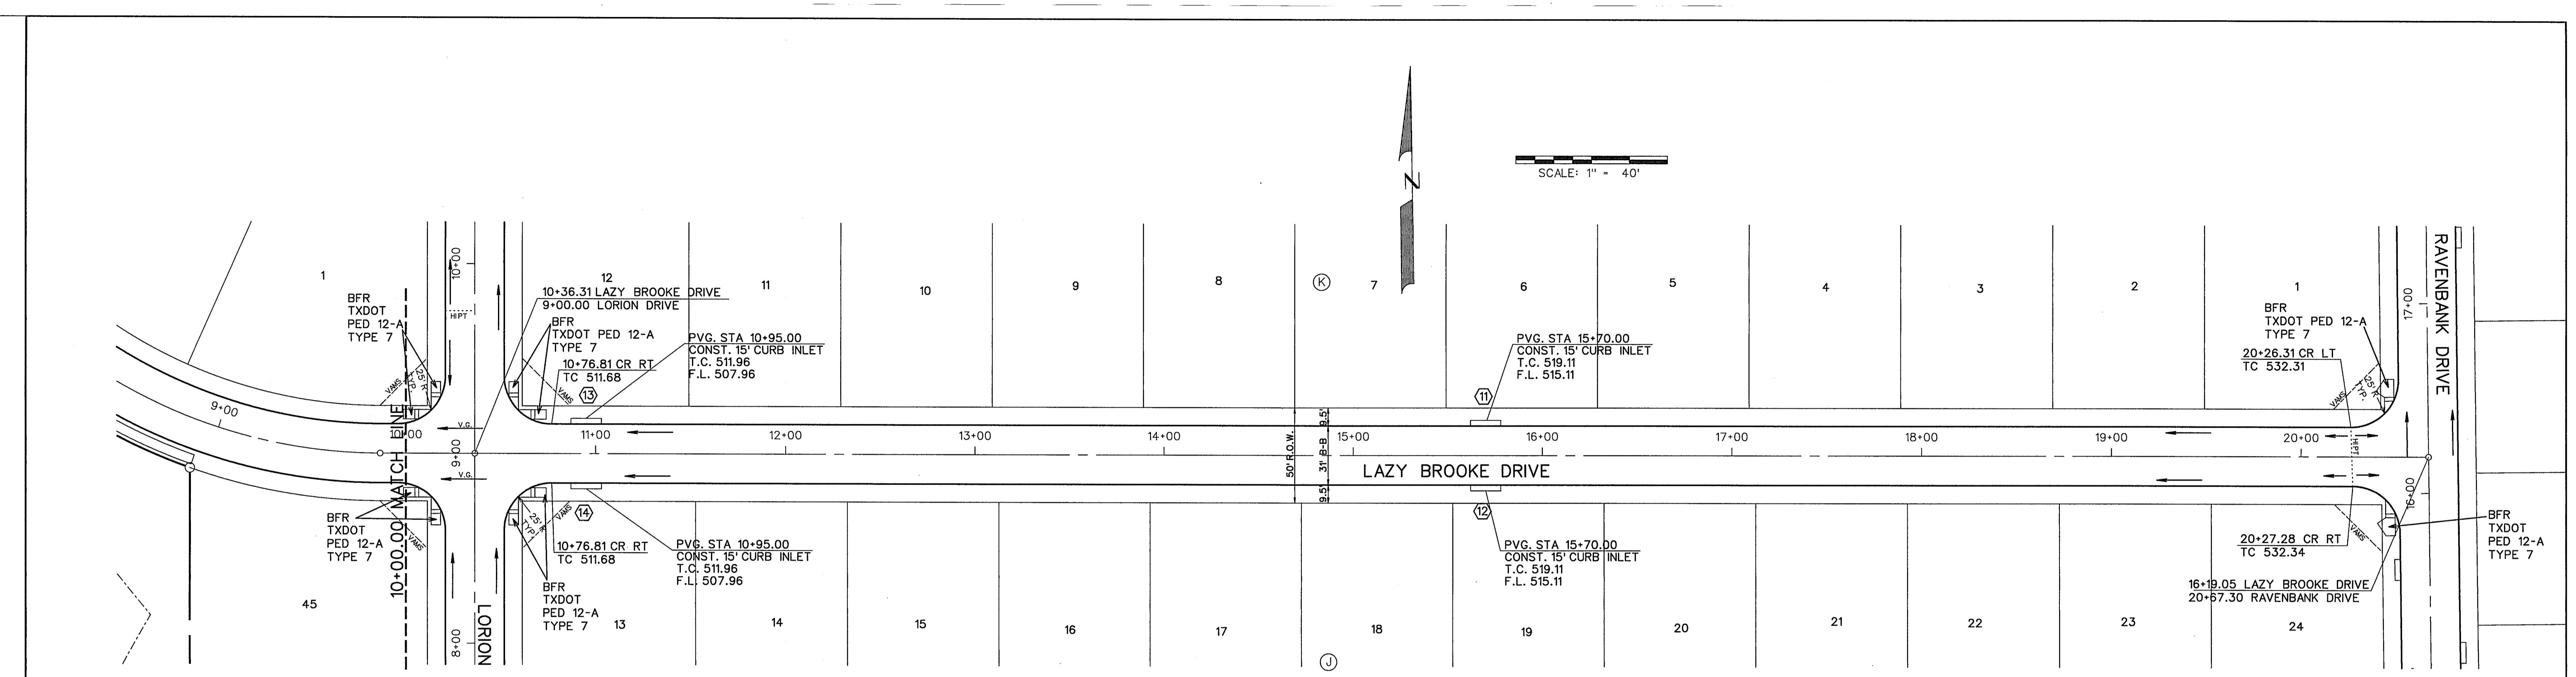


BENCHMARK:
" X " Cut on top of curb on east side of John King Blvd.
approx. 48' north of the centerline of Pleasant View Dr.

ELEVATION = 505.61

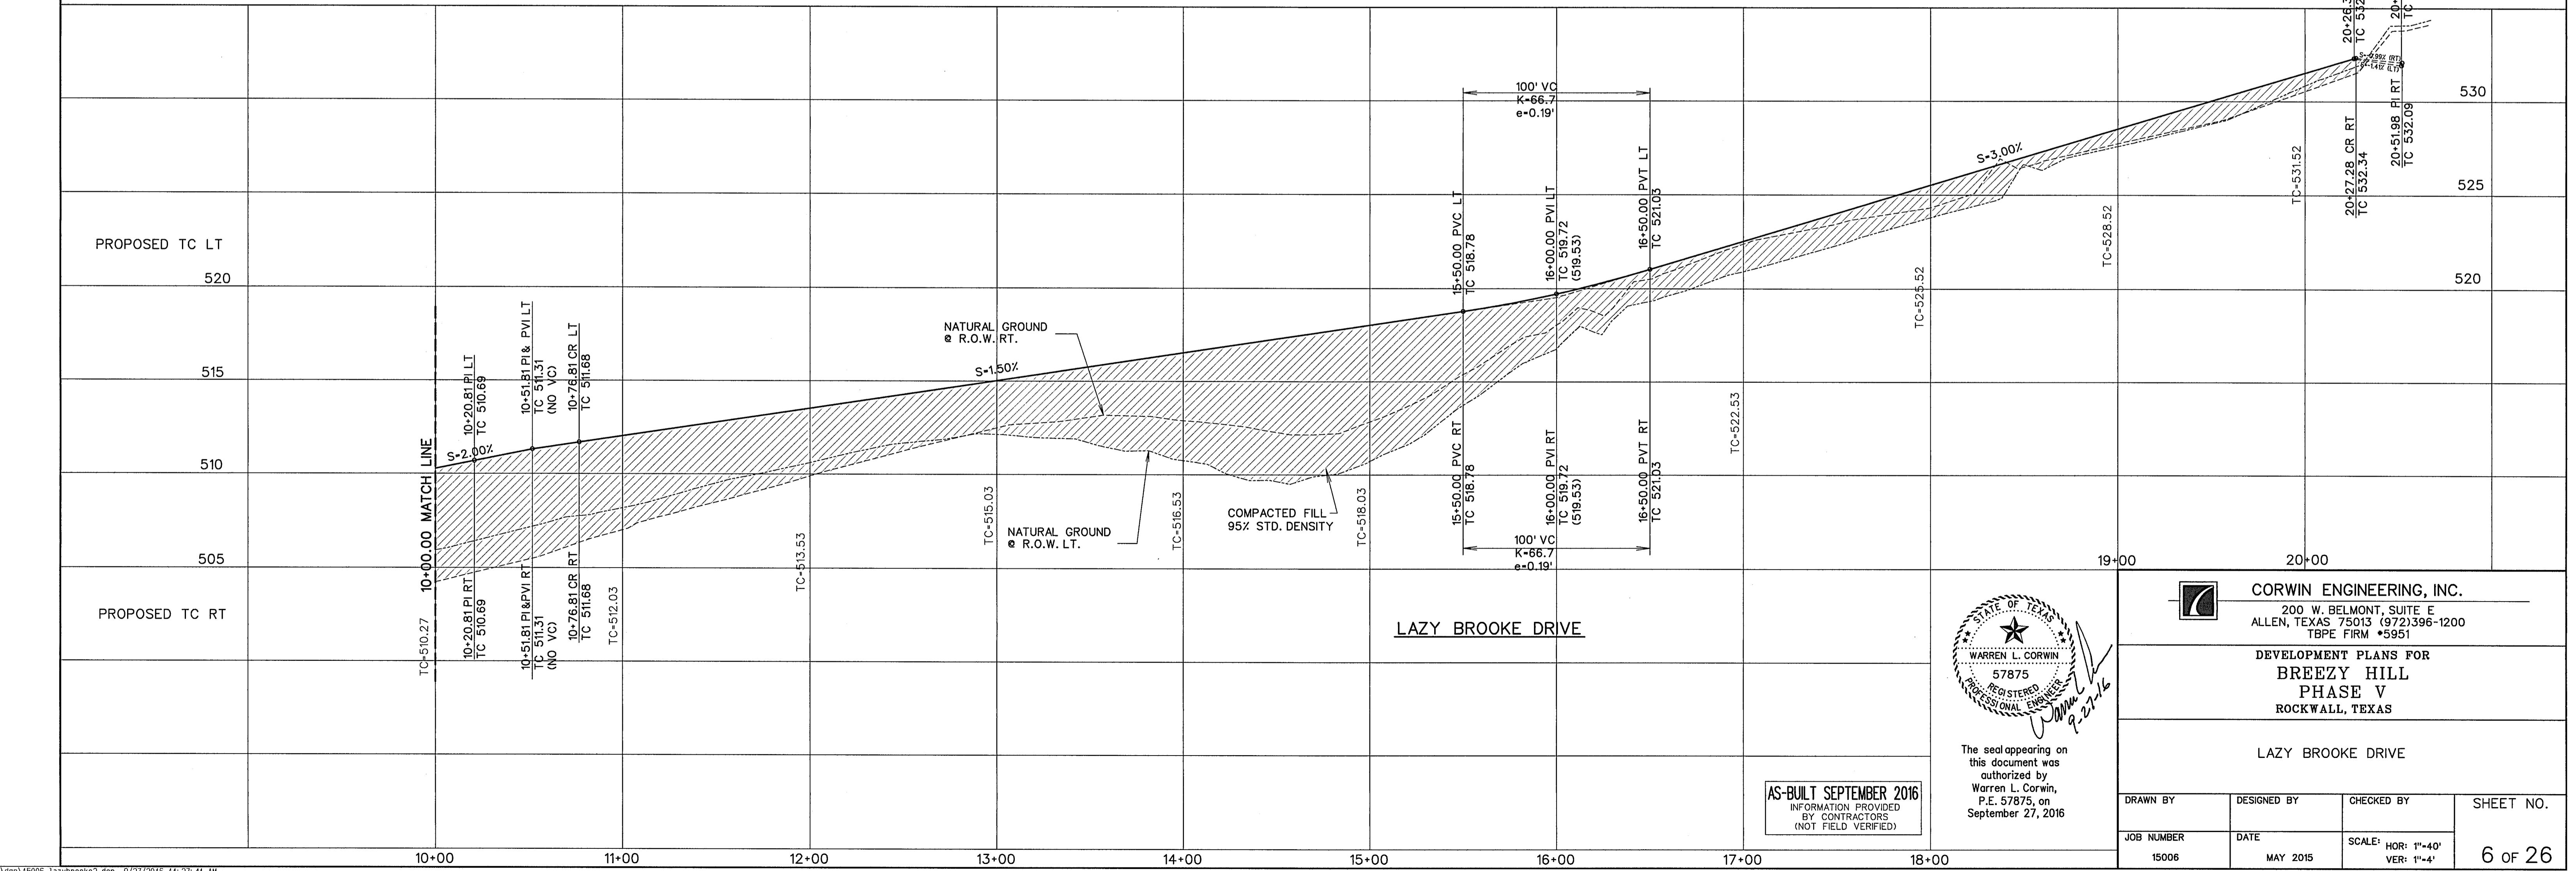




SCALE: 1" = 40'

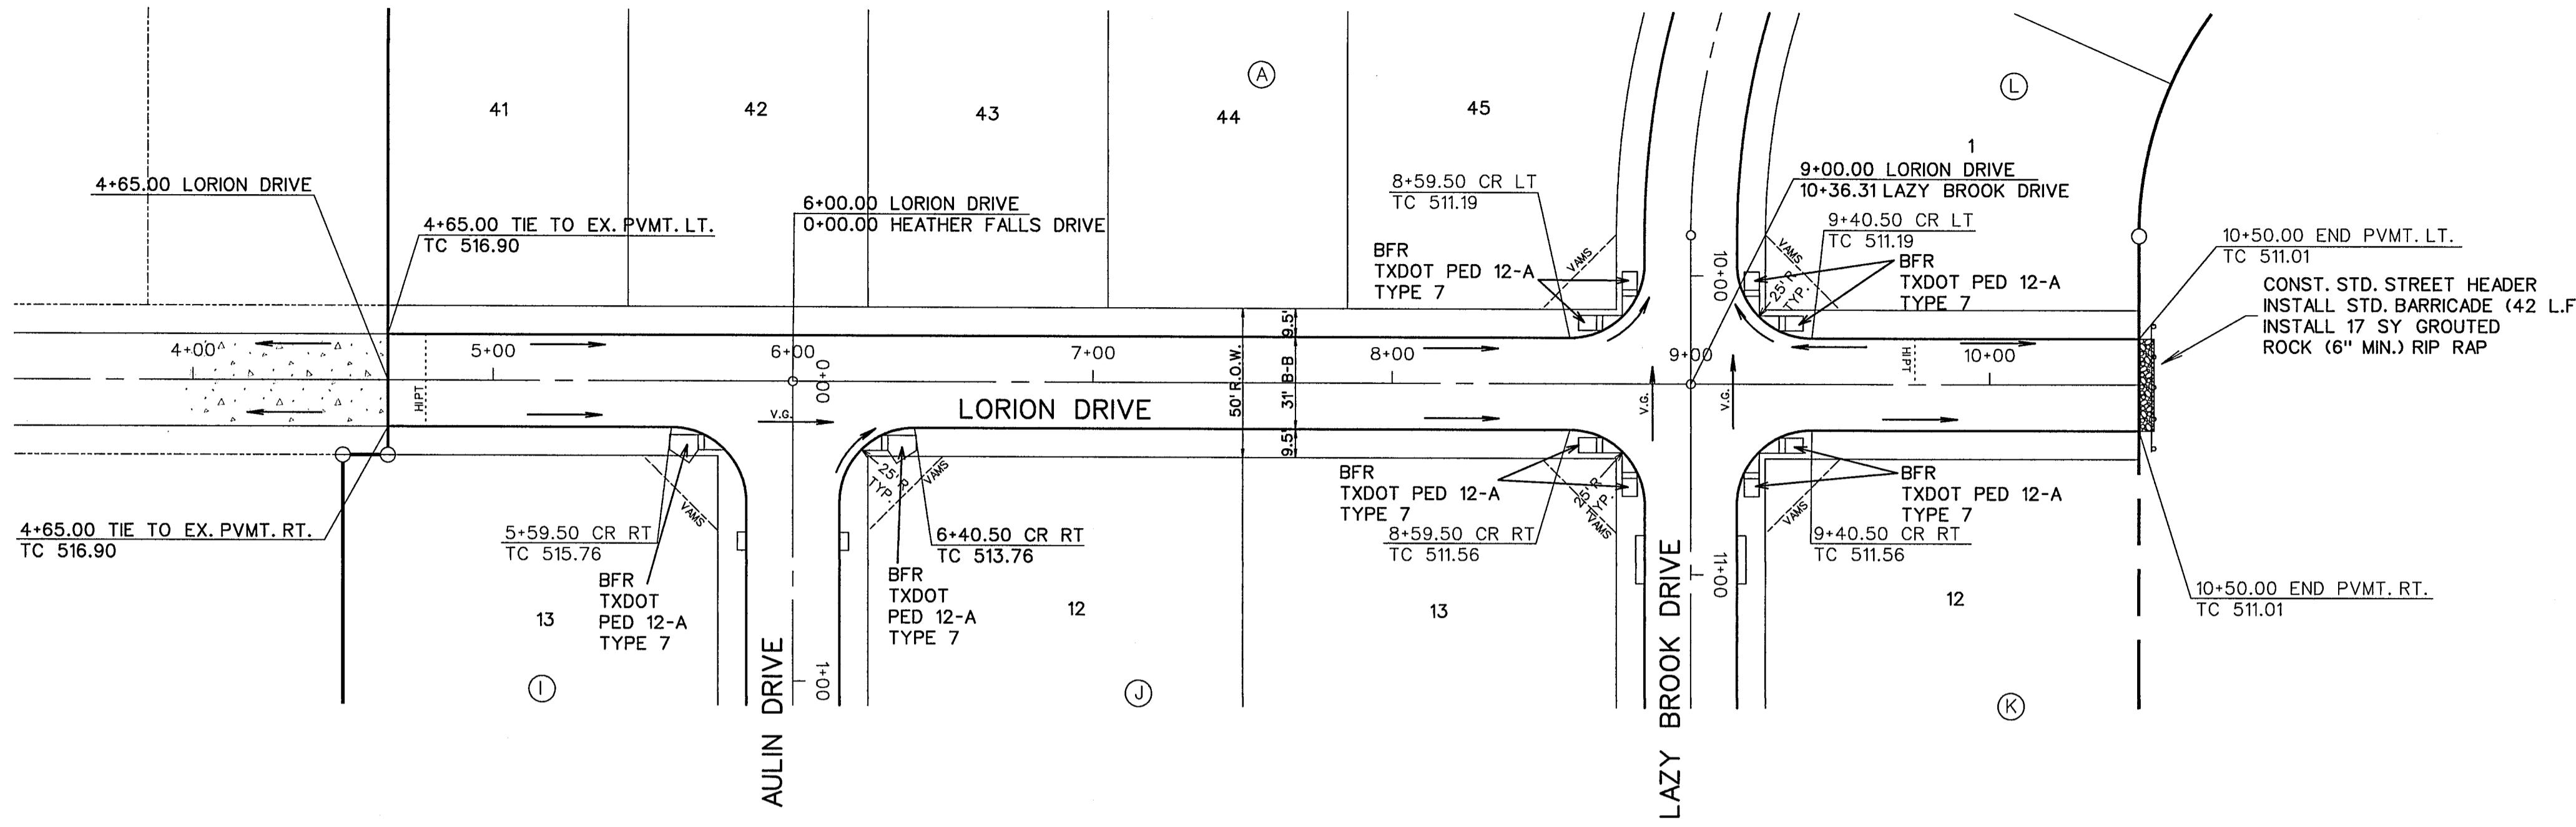

BENCHMARK:

"X" Cut on top of curb on east side of John King Blvd.
approx. 48' north of the centerline of Pleasant View Dr.

ELEVATION = 505.61

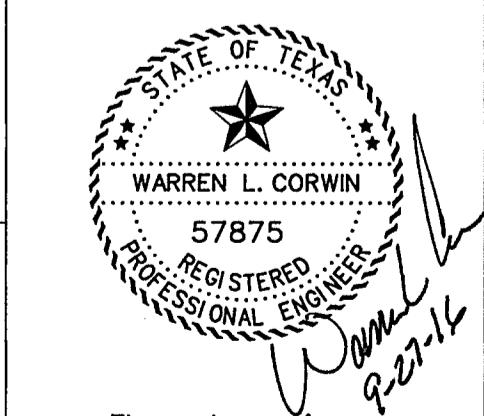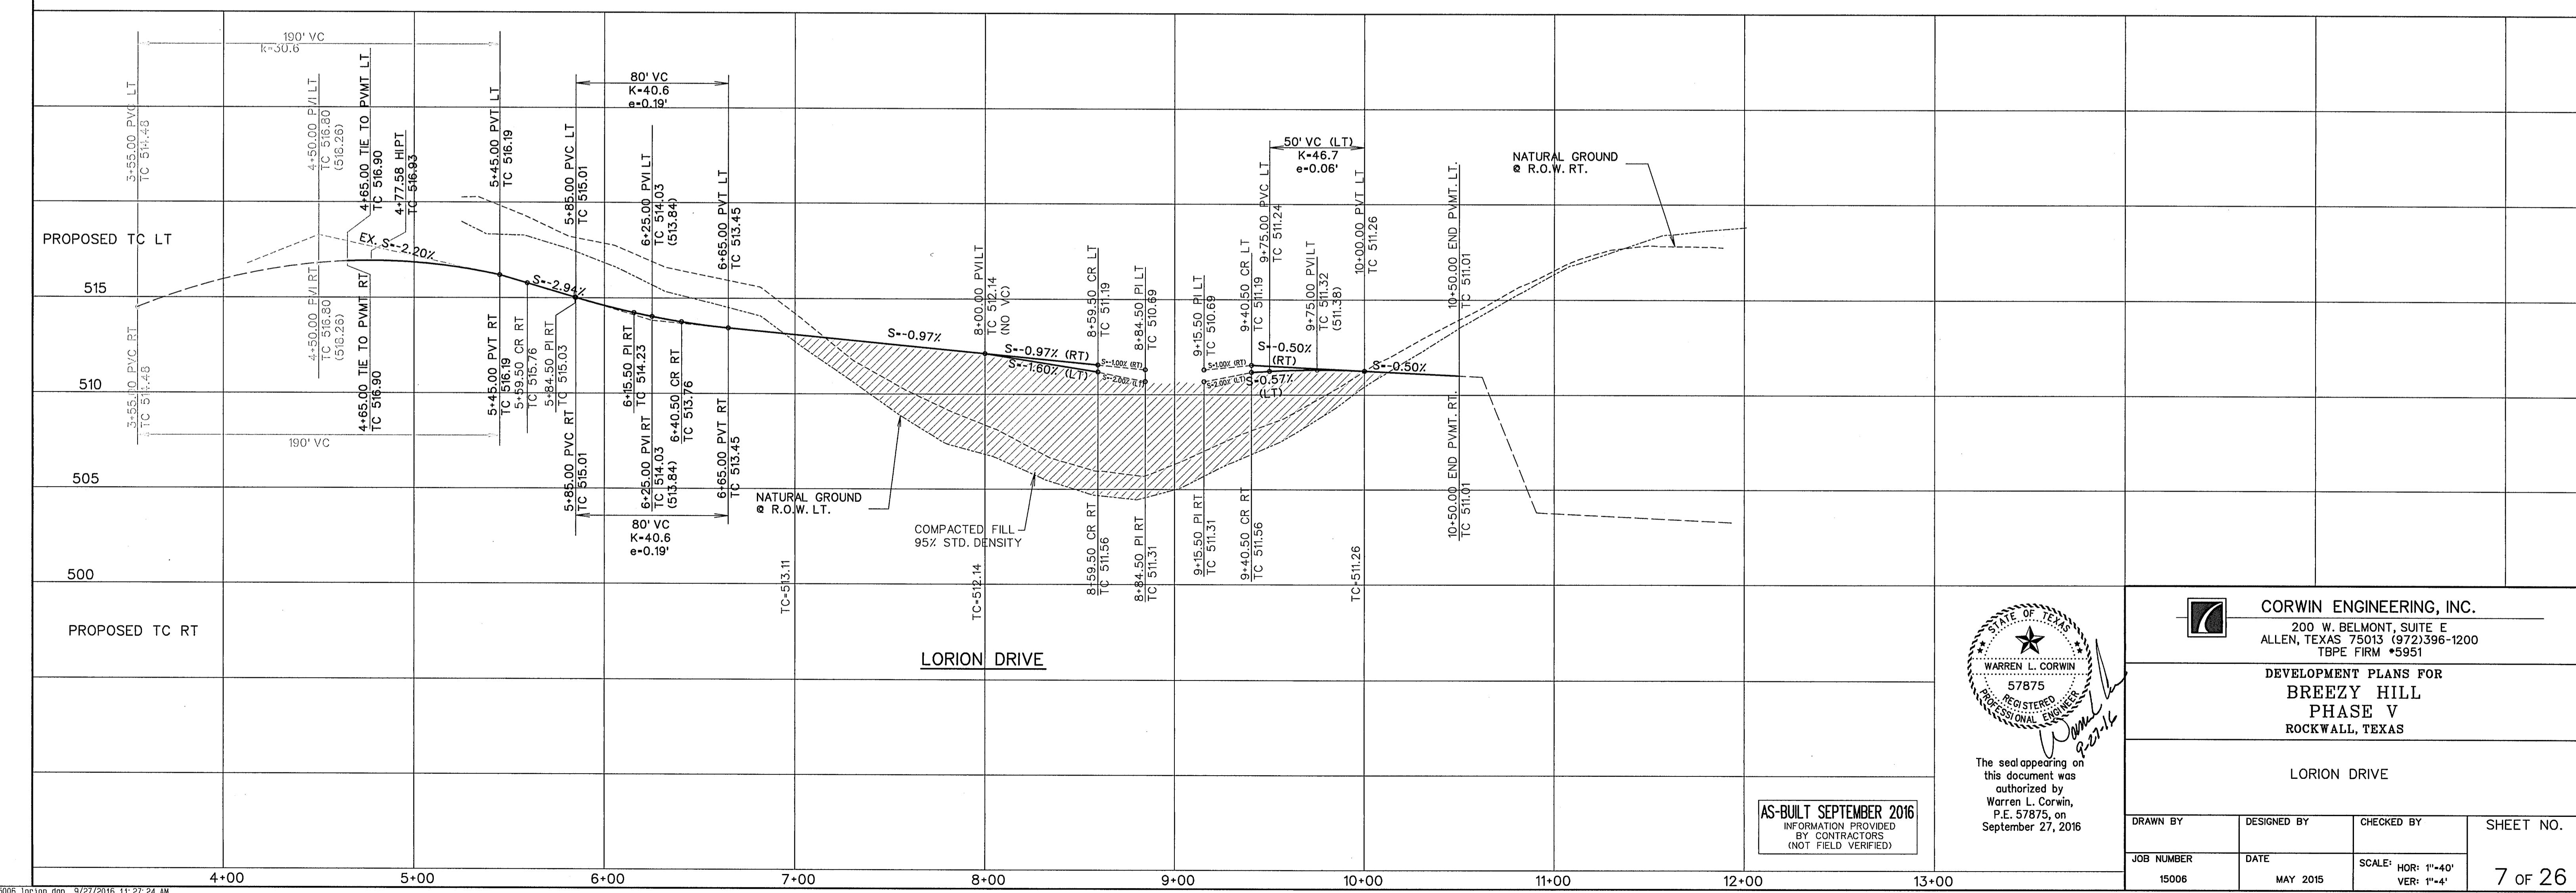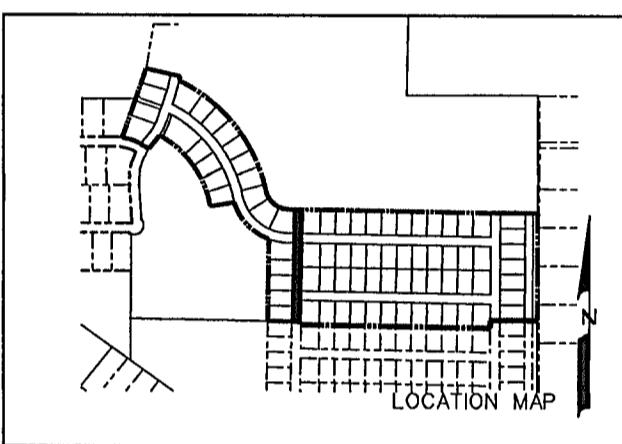

The seal appearing on
this document was
authorized by
Warren L. Corwin,
P.E. 57875, on
September 27, 2016


CORWIN ENGINEERING, INC.
200 W. BELMONT, SUITE E
ALLEN, TEXAS 75013 (972)396-1200
TBPE FIRM •5951

DEVELOPMENT PLANS FOR
BREEZY HILL
PHASE V
ROCKWALL, TEXAS

LORION DRIVE

AS-BUILT SEPTEMBER 2016
INFORMATION PROVIDED
BY CONTRACTORS
(NOT FIELD VERIFIED)



DRAWN BY	DESIGNED BY	CHECKED BY	SHEET NO.
15006	MAY 2015	SCALE: HOR: 1"-40' VER: 1"-4"	7 OF 26

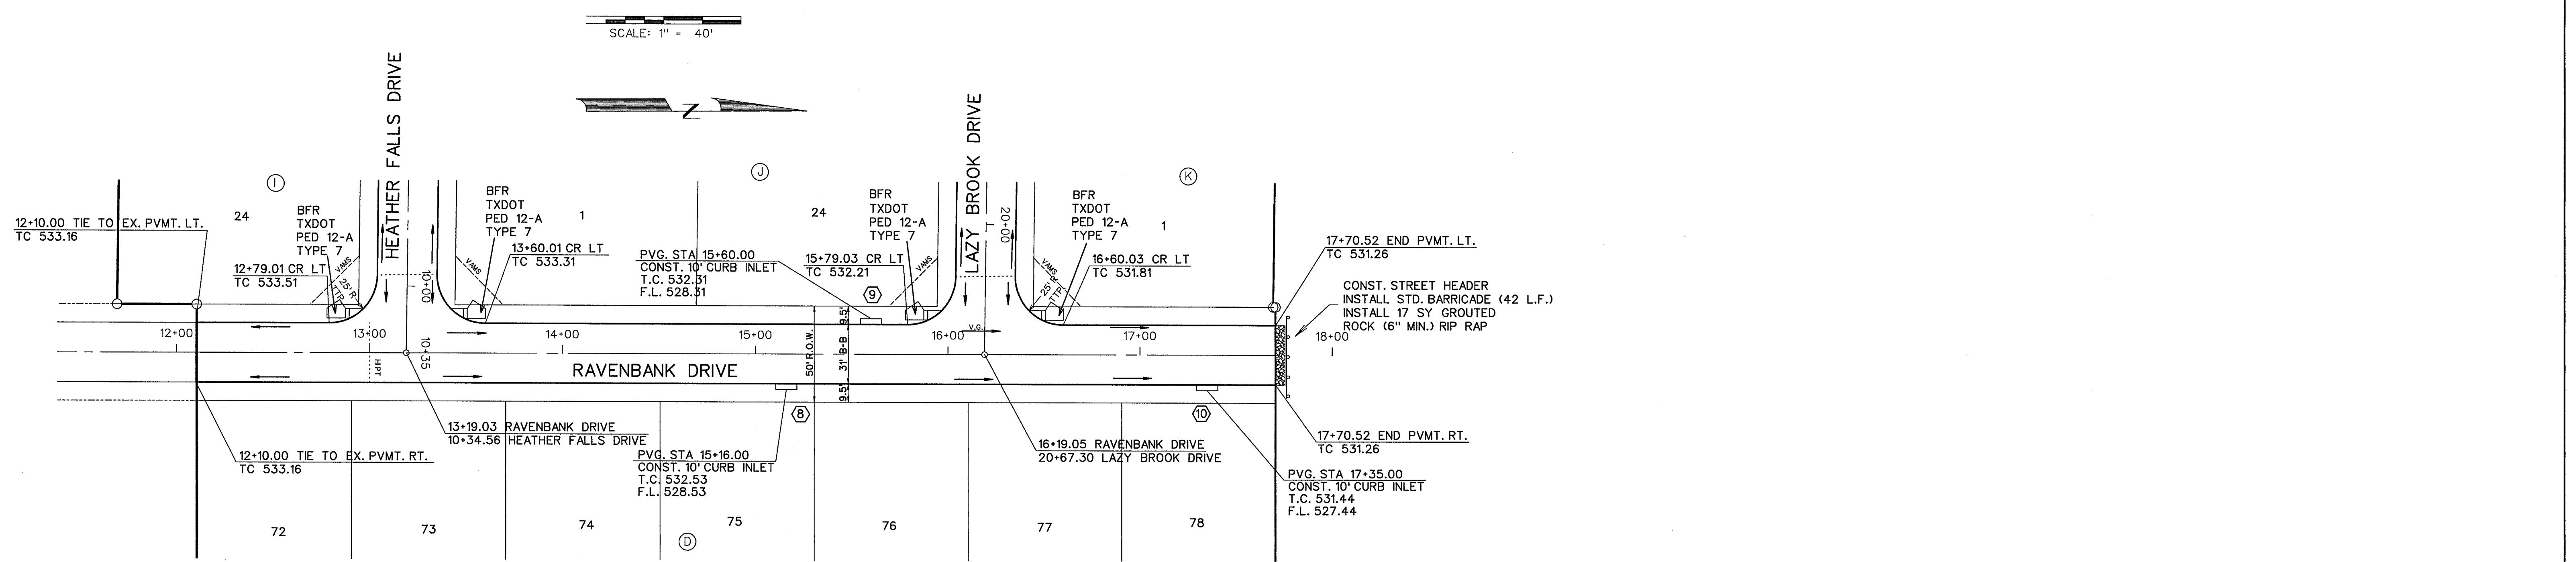

BENCHMARK:


" X " Cut on top of curb on east side of John King Blvd.
approx. 48' north of the centerline of Pleasant View Dr.


ELEVATION = 505.61

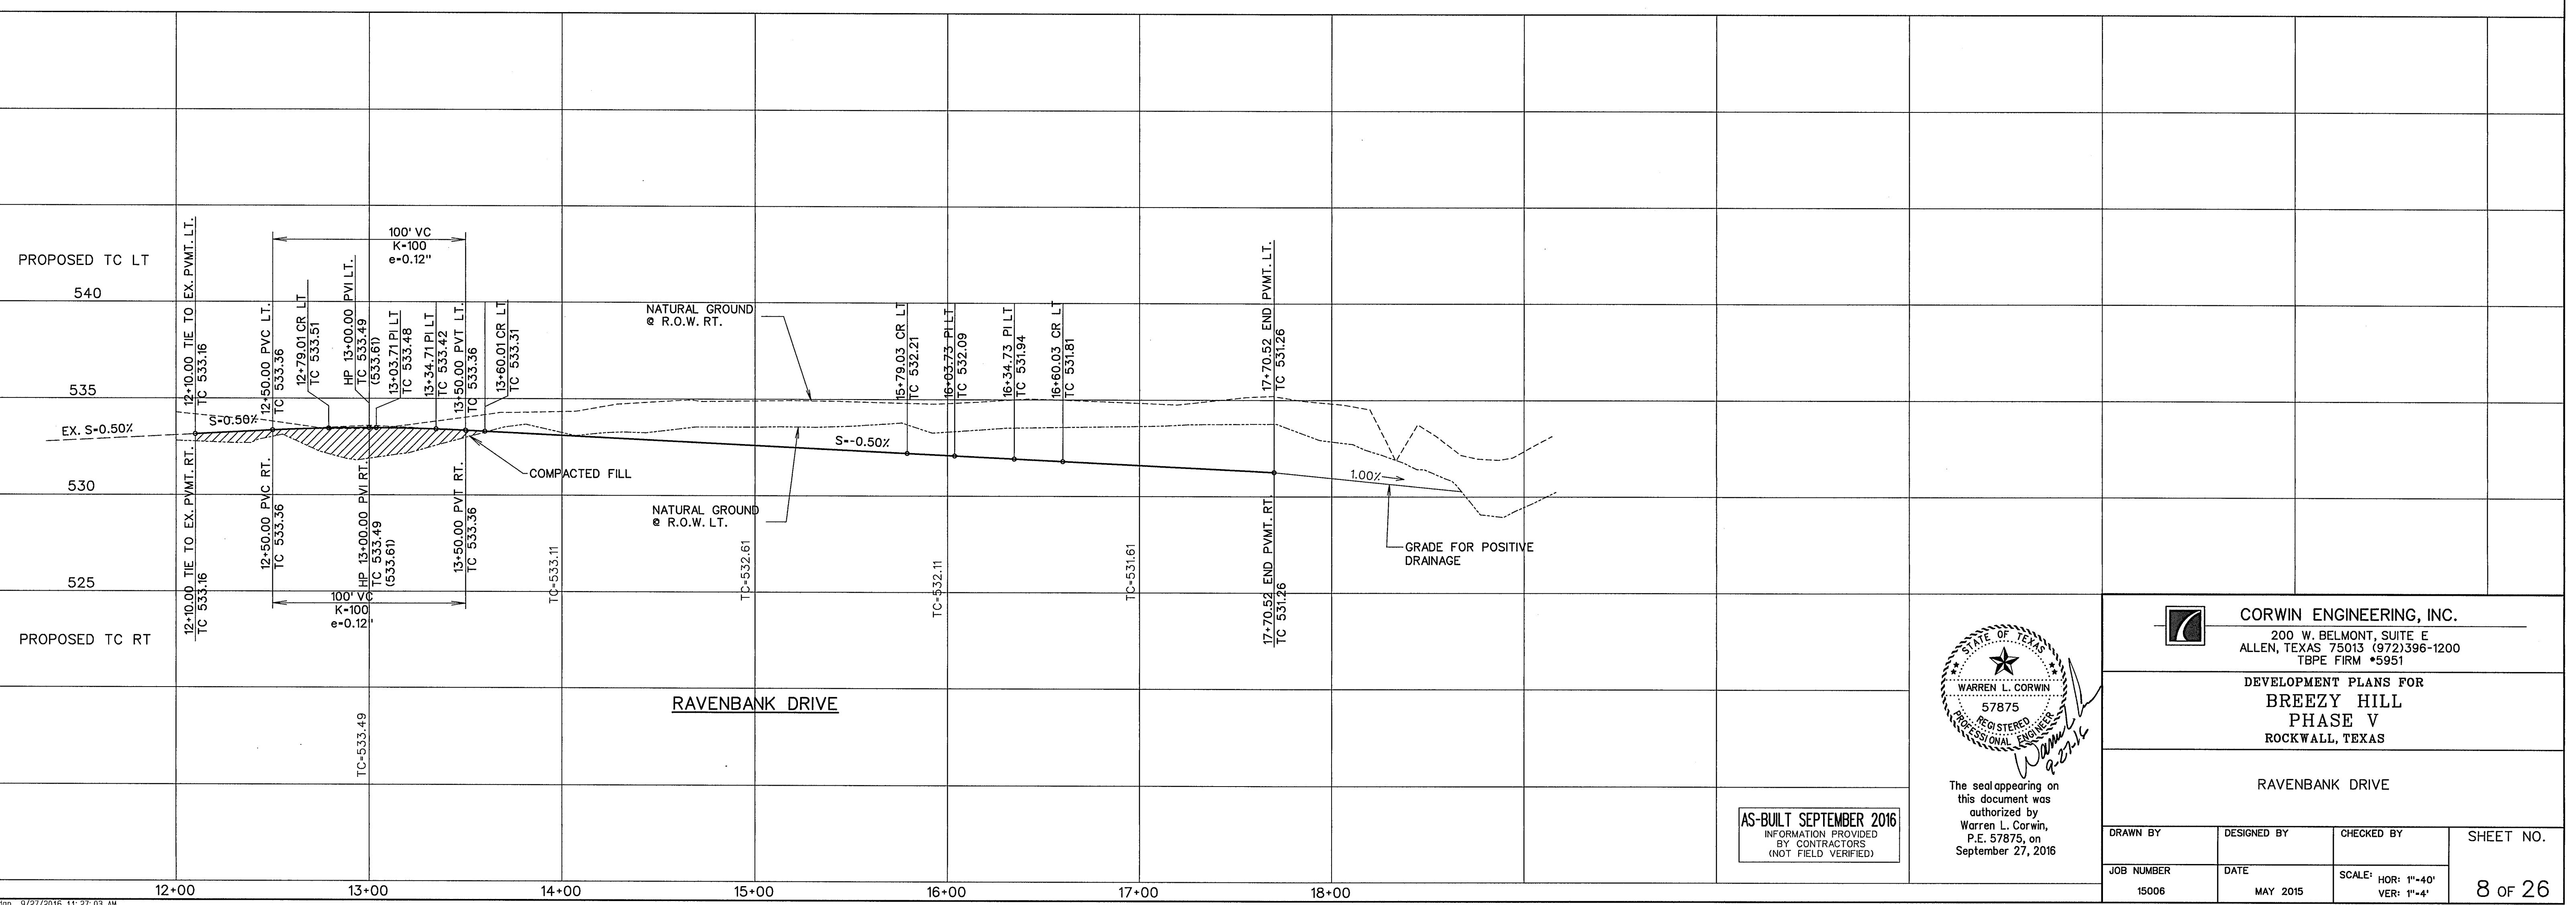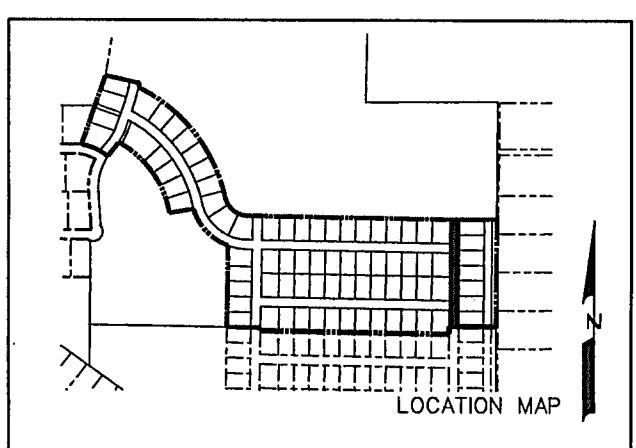


BENCHMARK:
"X" Cut on top of curb on east side of John King Blvd.
approx. 48' north of the centerline of Pleasant View Dr.

ELEVATION = 505.61

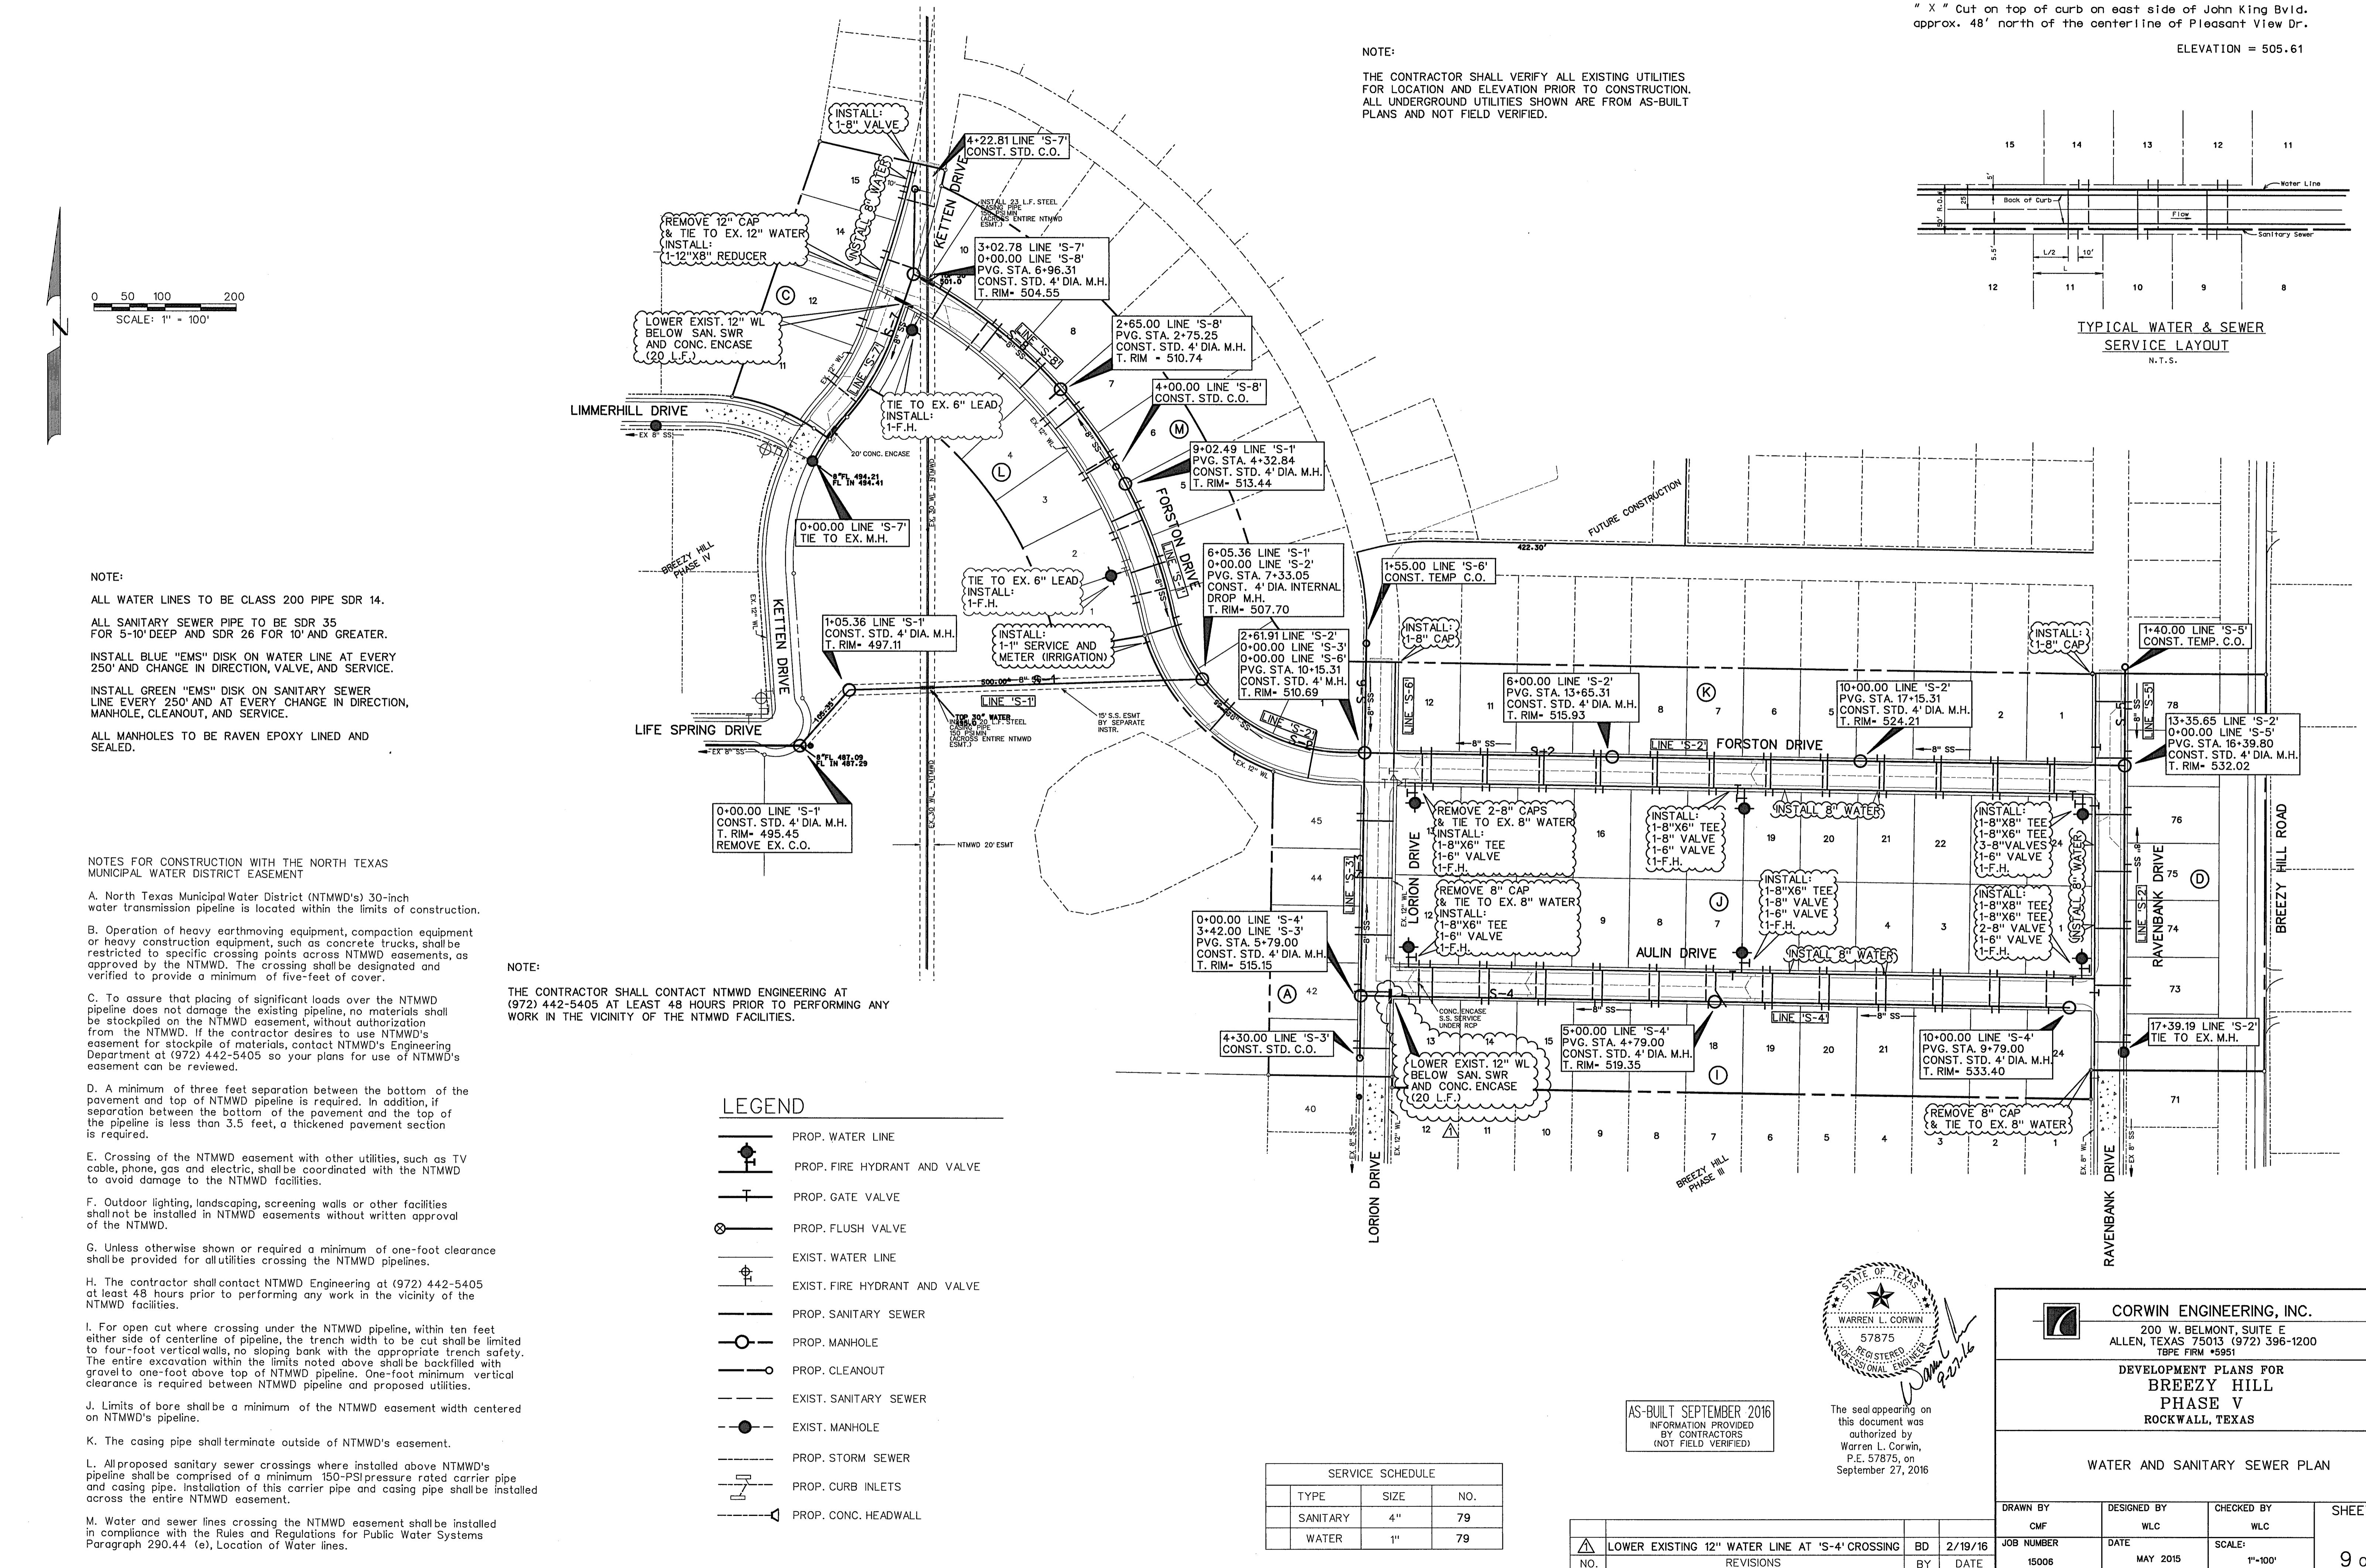


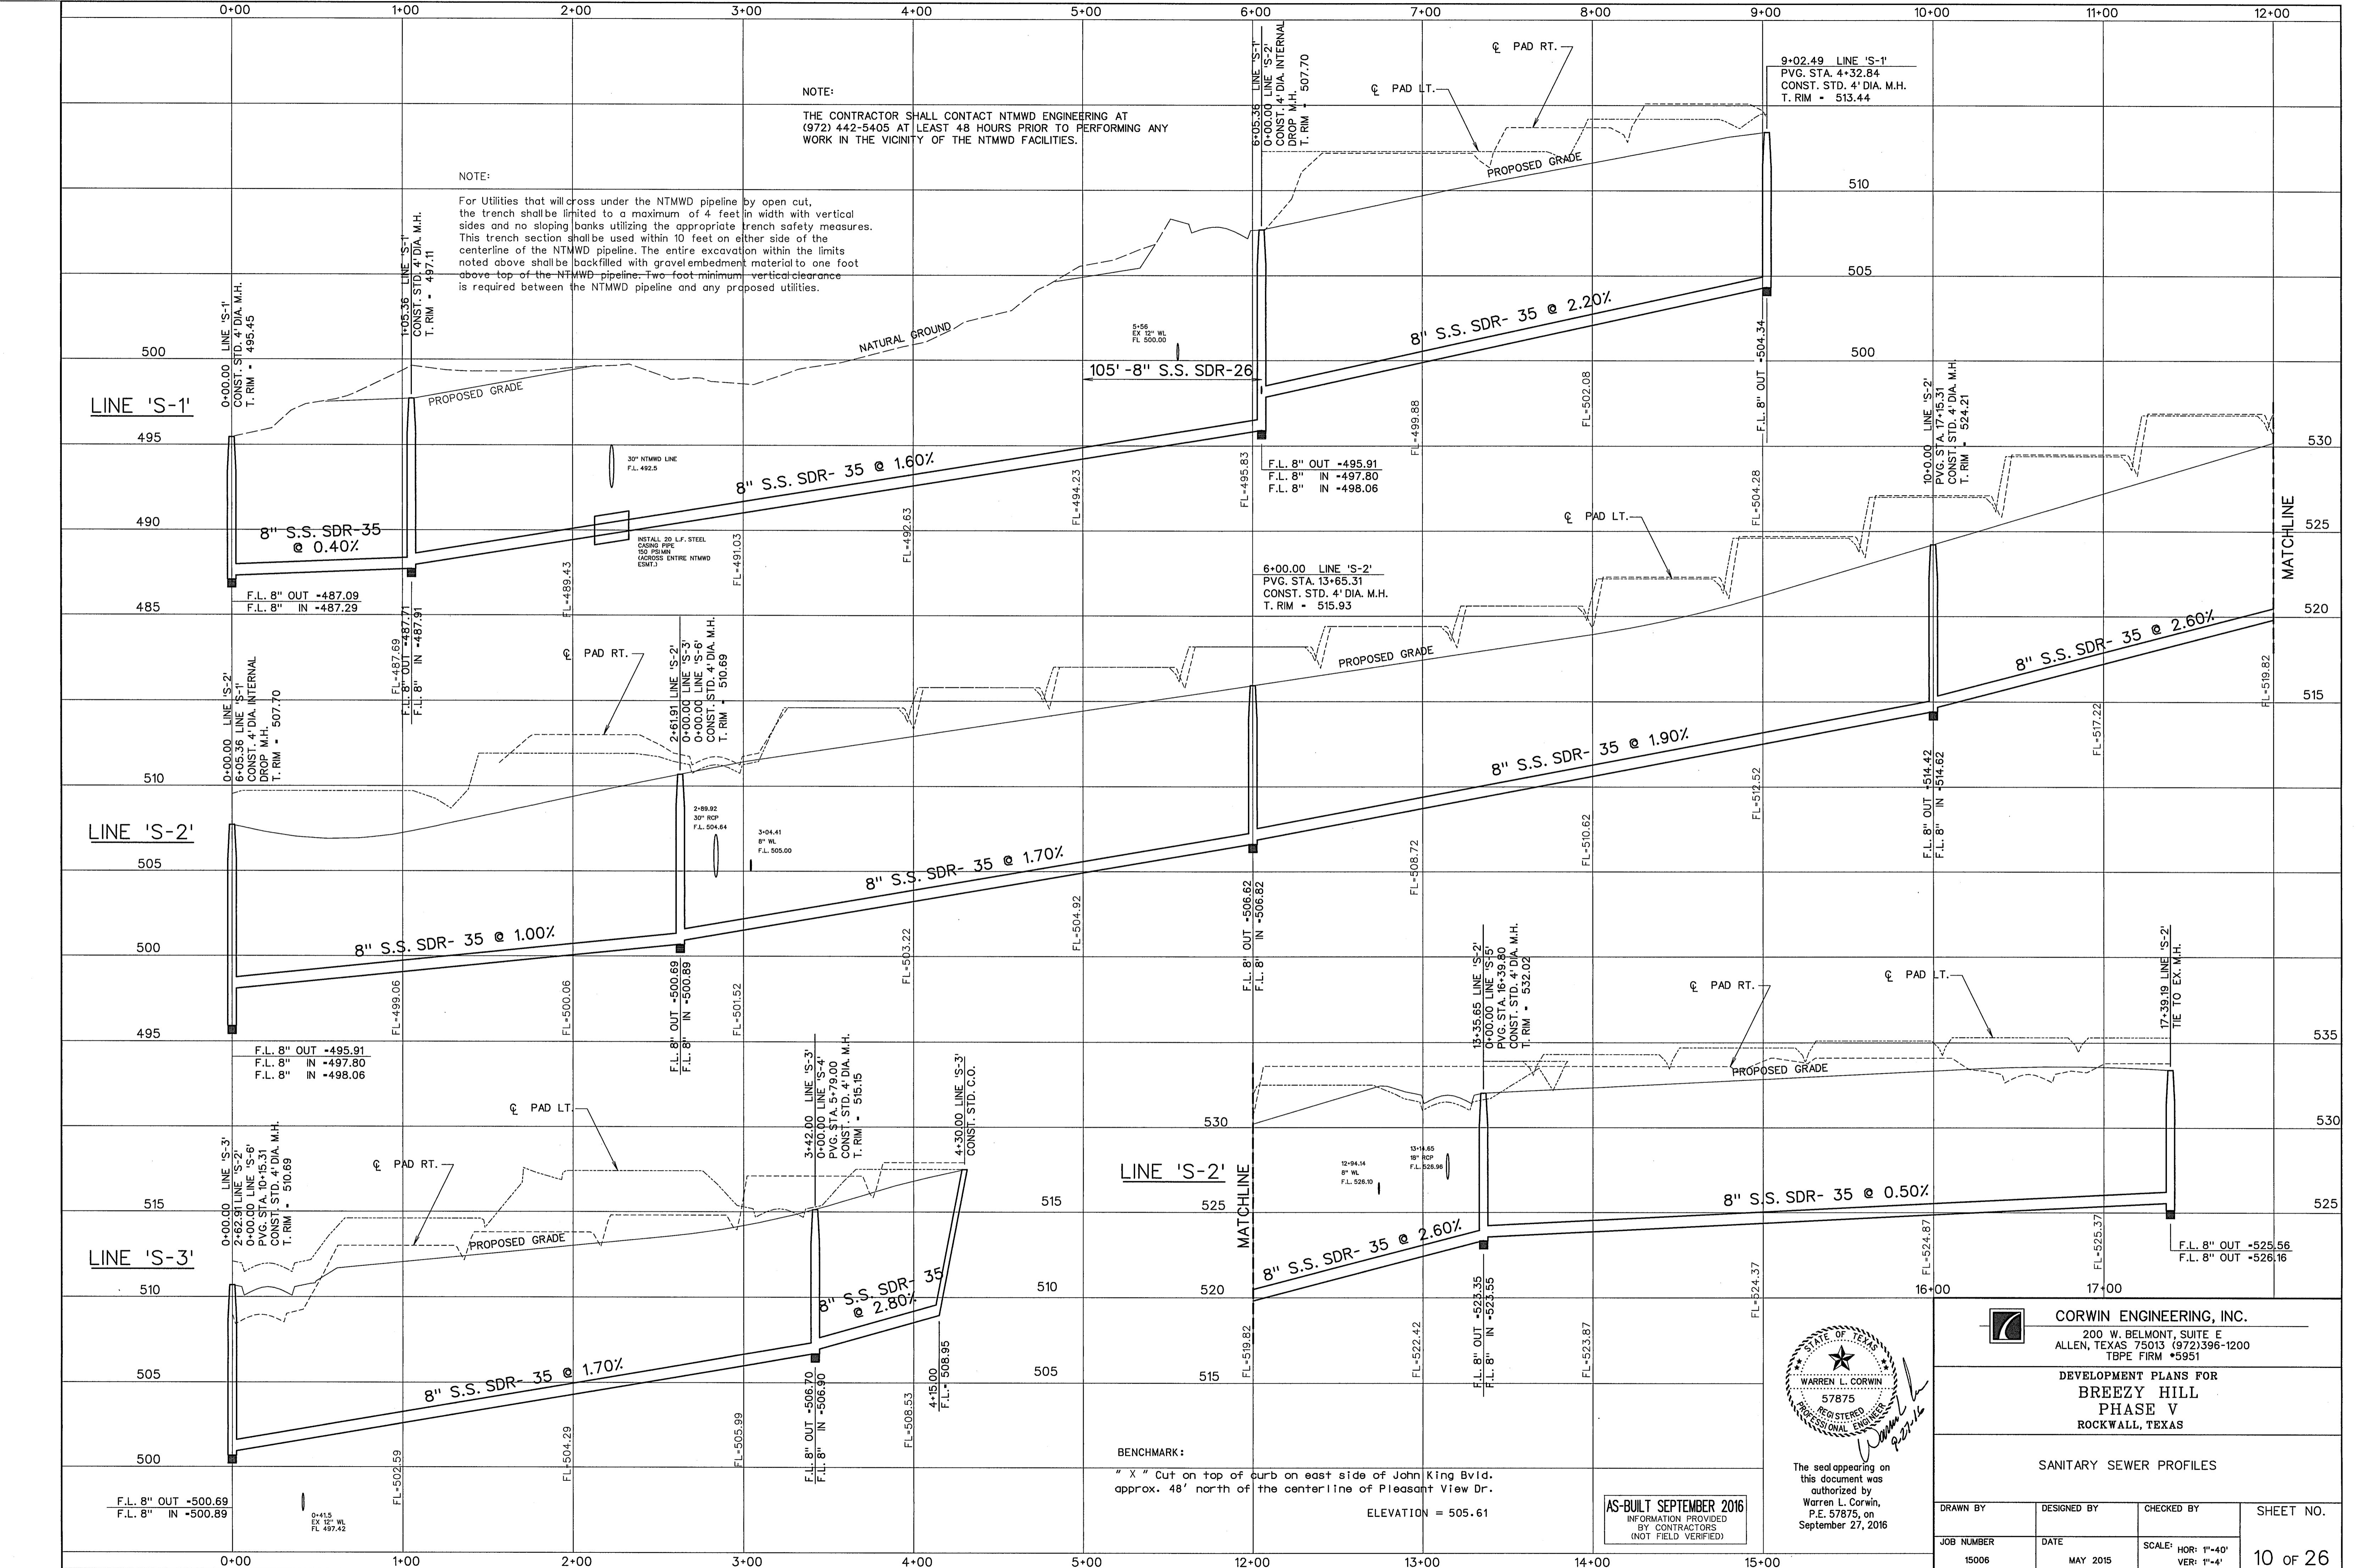

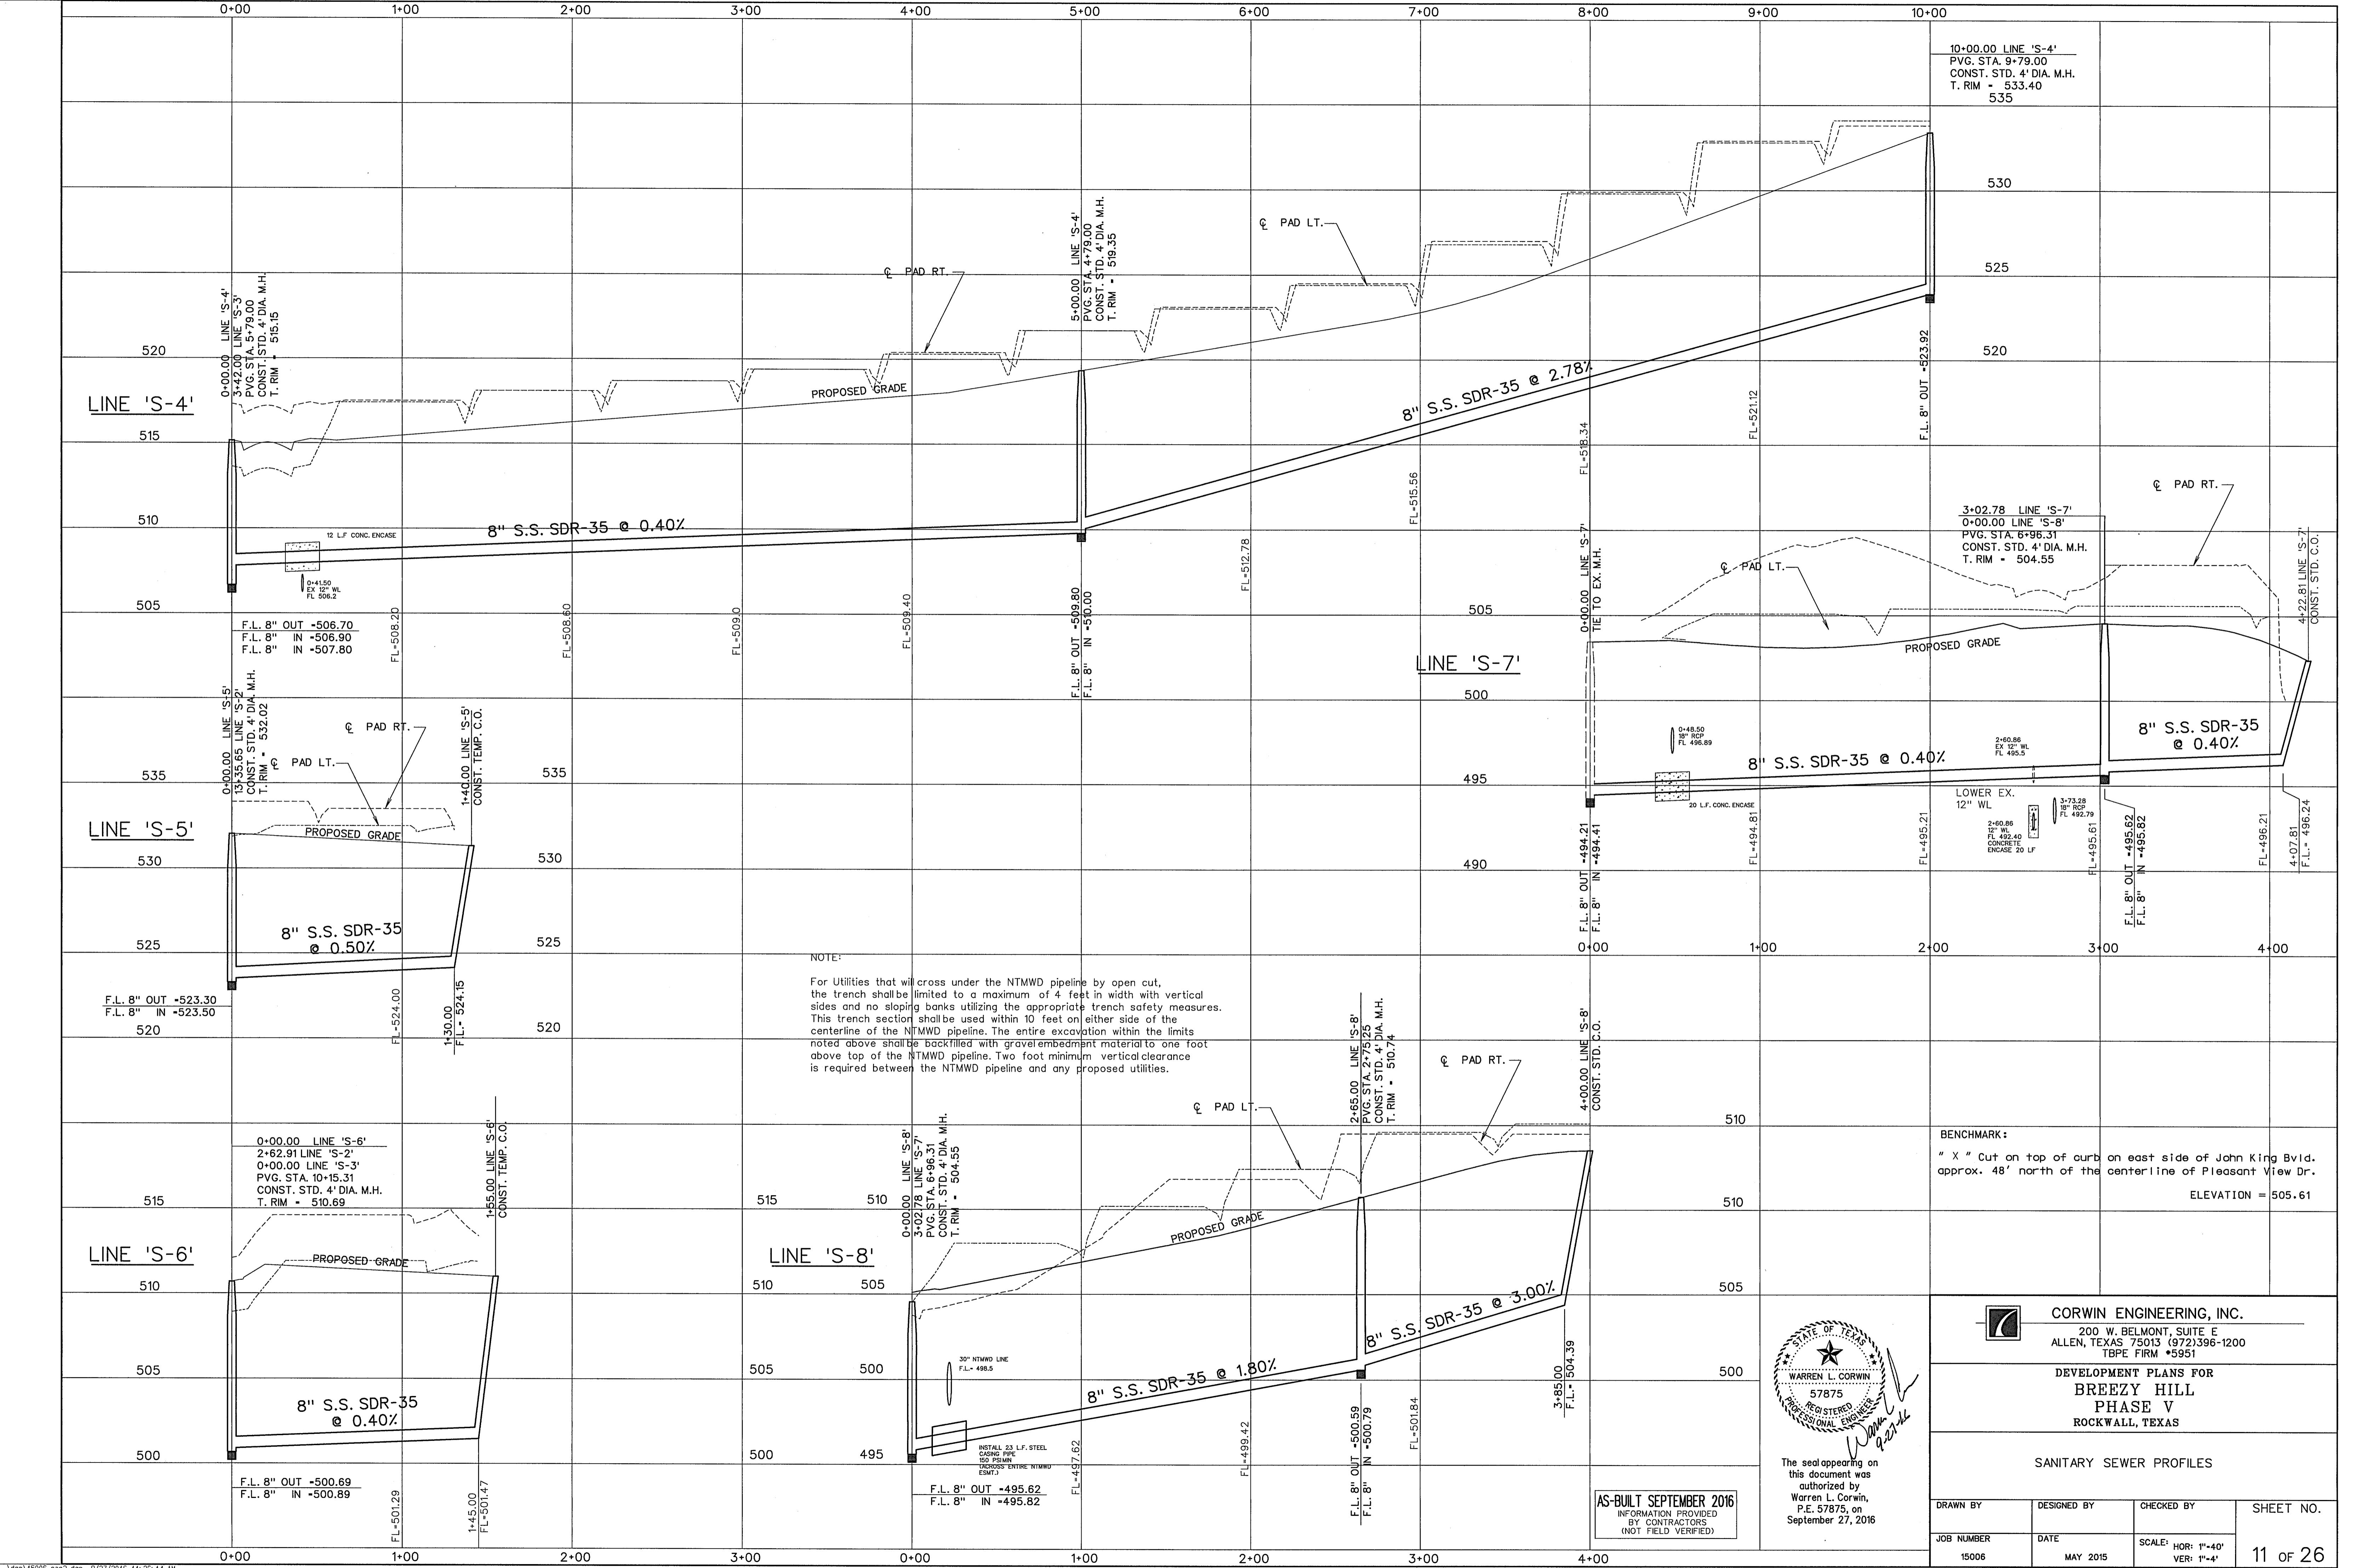

0 50 100 200
SCALE: 1" - 100'

N

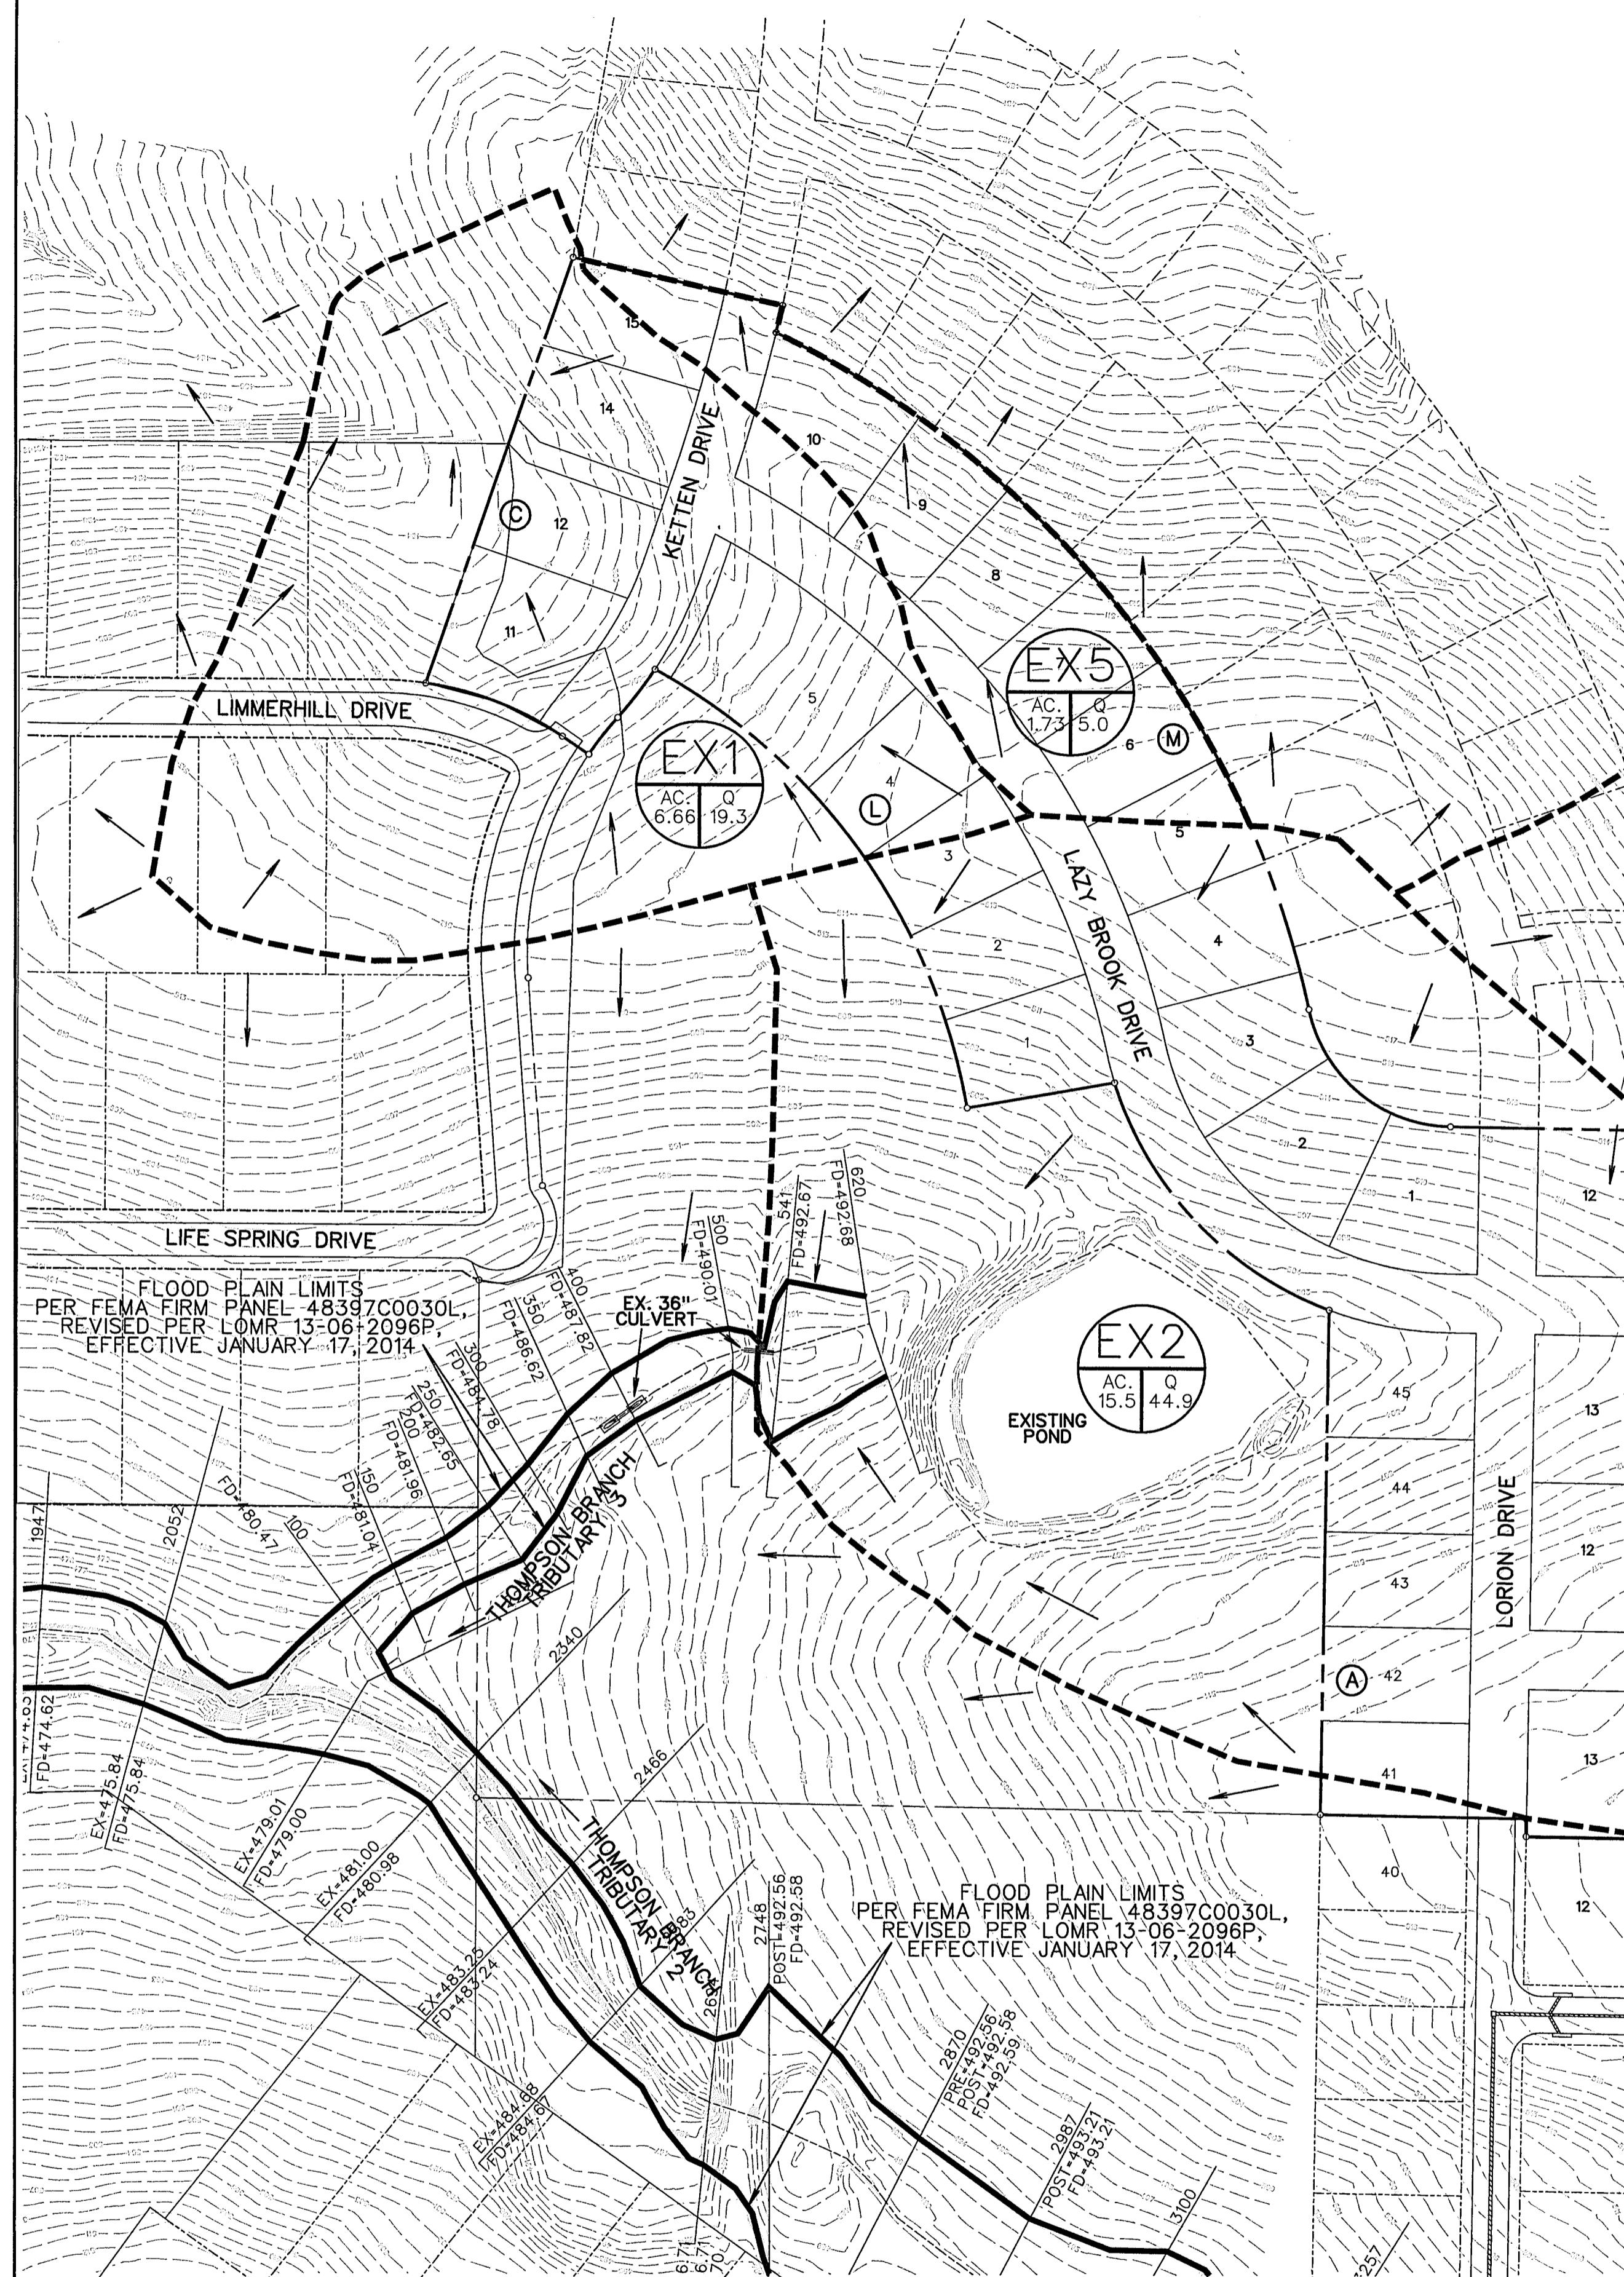

LEGEND

- PROP. STORM SEWER
- DRAINAGE AREA DIVIDE
- PROP. CURB INLETS
- FLOW ARROW
- PROP. CONC. HEADWALL
- EXIST. STORM SEWER
- DRAINAGE AREA NO.

RUNOFF COMPUTATIONS

Area #	Area (sf)	Area (acres)	Runoff Coefficient	CA	Tc (min)	I(100) (in/hr)	Q(100) (cfs)
EX1	289988	6.66	0.35	2.33	20	8.30	19.3
EX2	673049	15.5	0.35	5.41	20	8.30	44.9
EX3	1243893	28.56	0.35	9.99	20	8.30	83.0
EX4	224945	5.16	0.35	1.81	20	8.30	15.0 Detention Pond #2
EX5	75236	1.73	0.35	0.60	20	8.30	5.0

AS-BUILT SEPTEMBER 2016
INFORMATION PROVIDED
BY CONTRACTORS
(NOT FIELD VERIFIED)




The seal appearing on
this document was
authorized by
Brandon Davidson
P.E. 87682, on
September 27, 2016

CORWIN ENGINEERING, INC.
200 W. BELMONT, SUITE E
ALLEN, TEXAS 75013 (972)396-1200
TBPE FIRM •5951

DEVELOPMENT PLANS FOR
BREEZY HILL
PHASE V
ROCKWALL, TEXAS

EXISTING CONDITIONS DRAINAGE AREA MAP

DRAWN BY	DESIGNED BY	CHECKED BY	SHEET NO.
JOB NUMBER 15006	DATE MAY 2015	SCALE: 1"-100'	

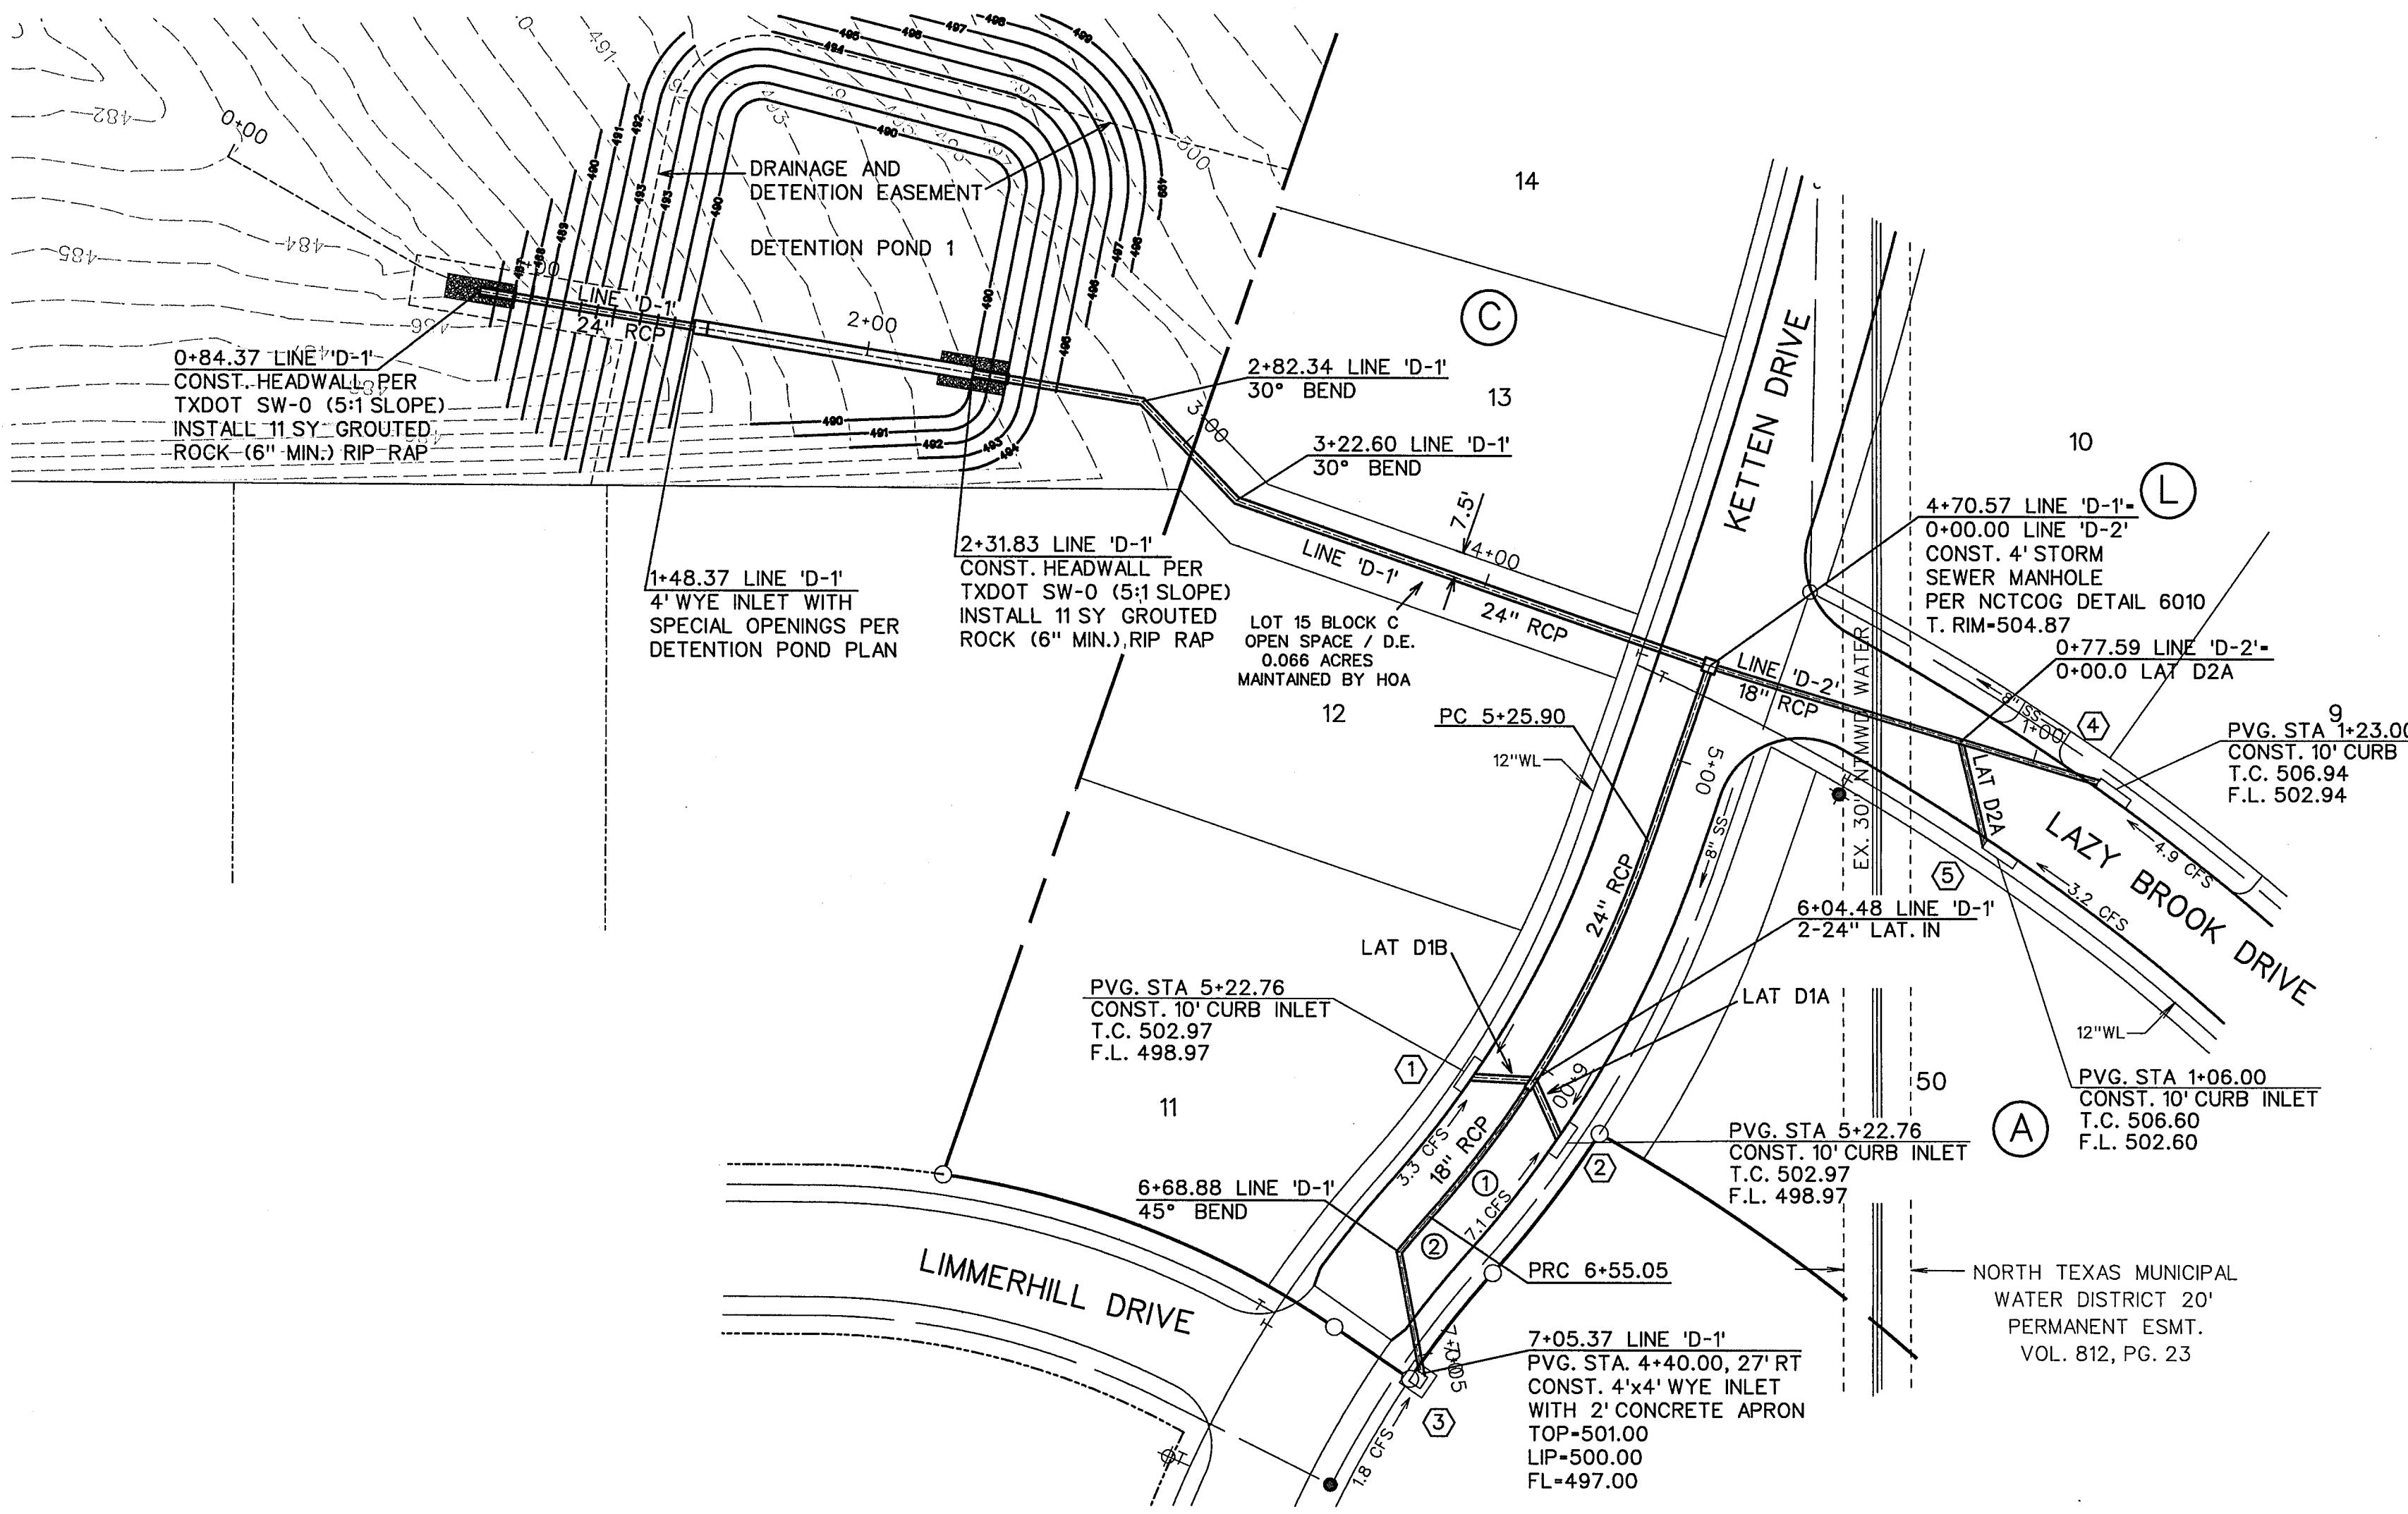



STORM SEWER CURVE DATA		
CURVE NO.	(1)	(2)
△	22° 46'07"	02° 26'17"
R	325.00'	325.00'
T	65.44'	6.92'
L	129.15'	13.83'

18" RCP	
Q ₁₀₀	8.1 cfs
V ₁₀₀	4.6 fps
S	0.0059
CAP	26.3 cfs
PARTIAL FLOW	VEL-13.1 FPS

18" RCP	
Q ₁₀₀	4.9 cfs
V ₁₀₀	2.8 fps
S	0.0022
CAP	38.1 cfs
PARTIAL FLOW	VEL-14.9 FPS




- LEGEND**
- BLOCK LABEL
 - INLET NUMBER
 - CURVE NUMBER
 - SANITARY SEWER
 - WATER
 - PROPOSED STORM SEWER
 - EXISTING STORM SEWER

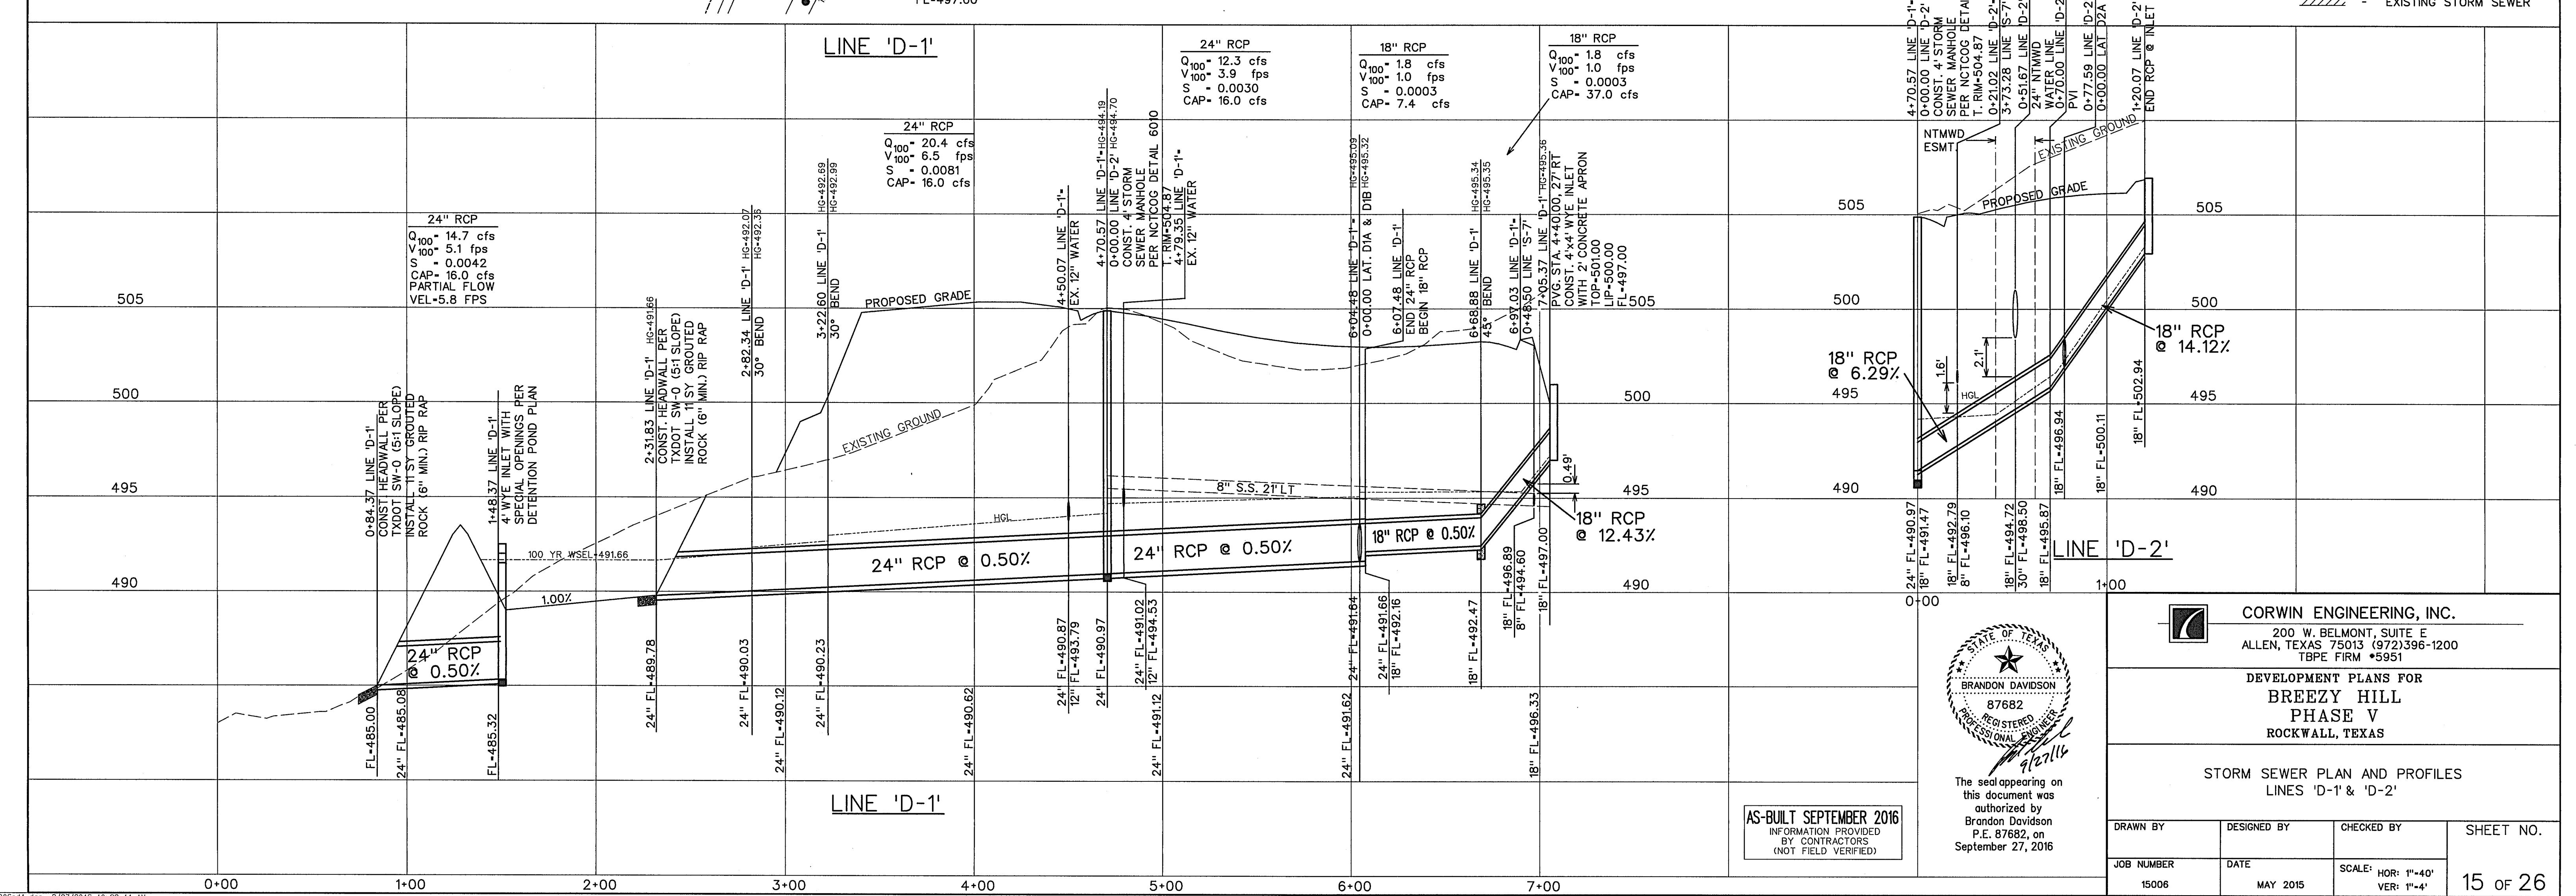

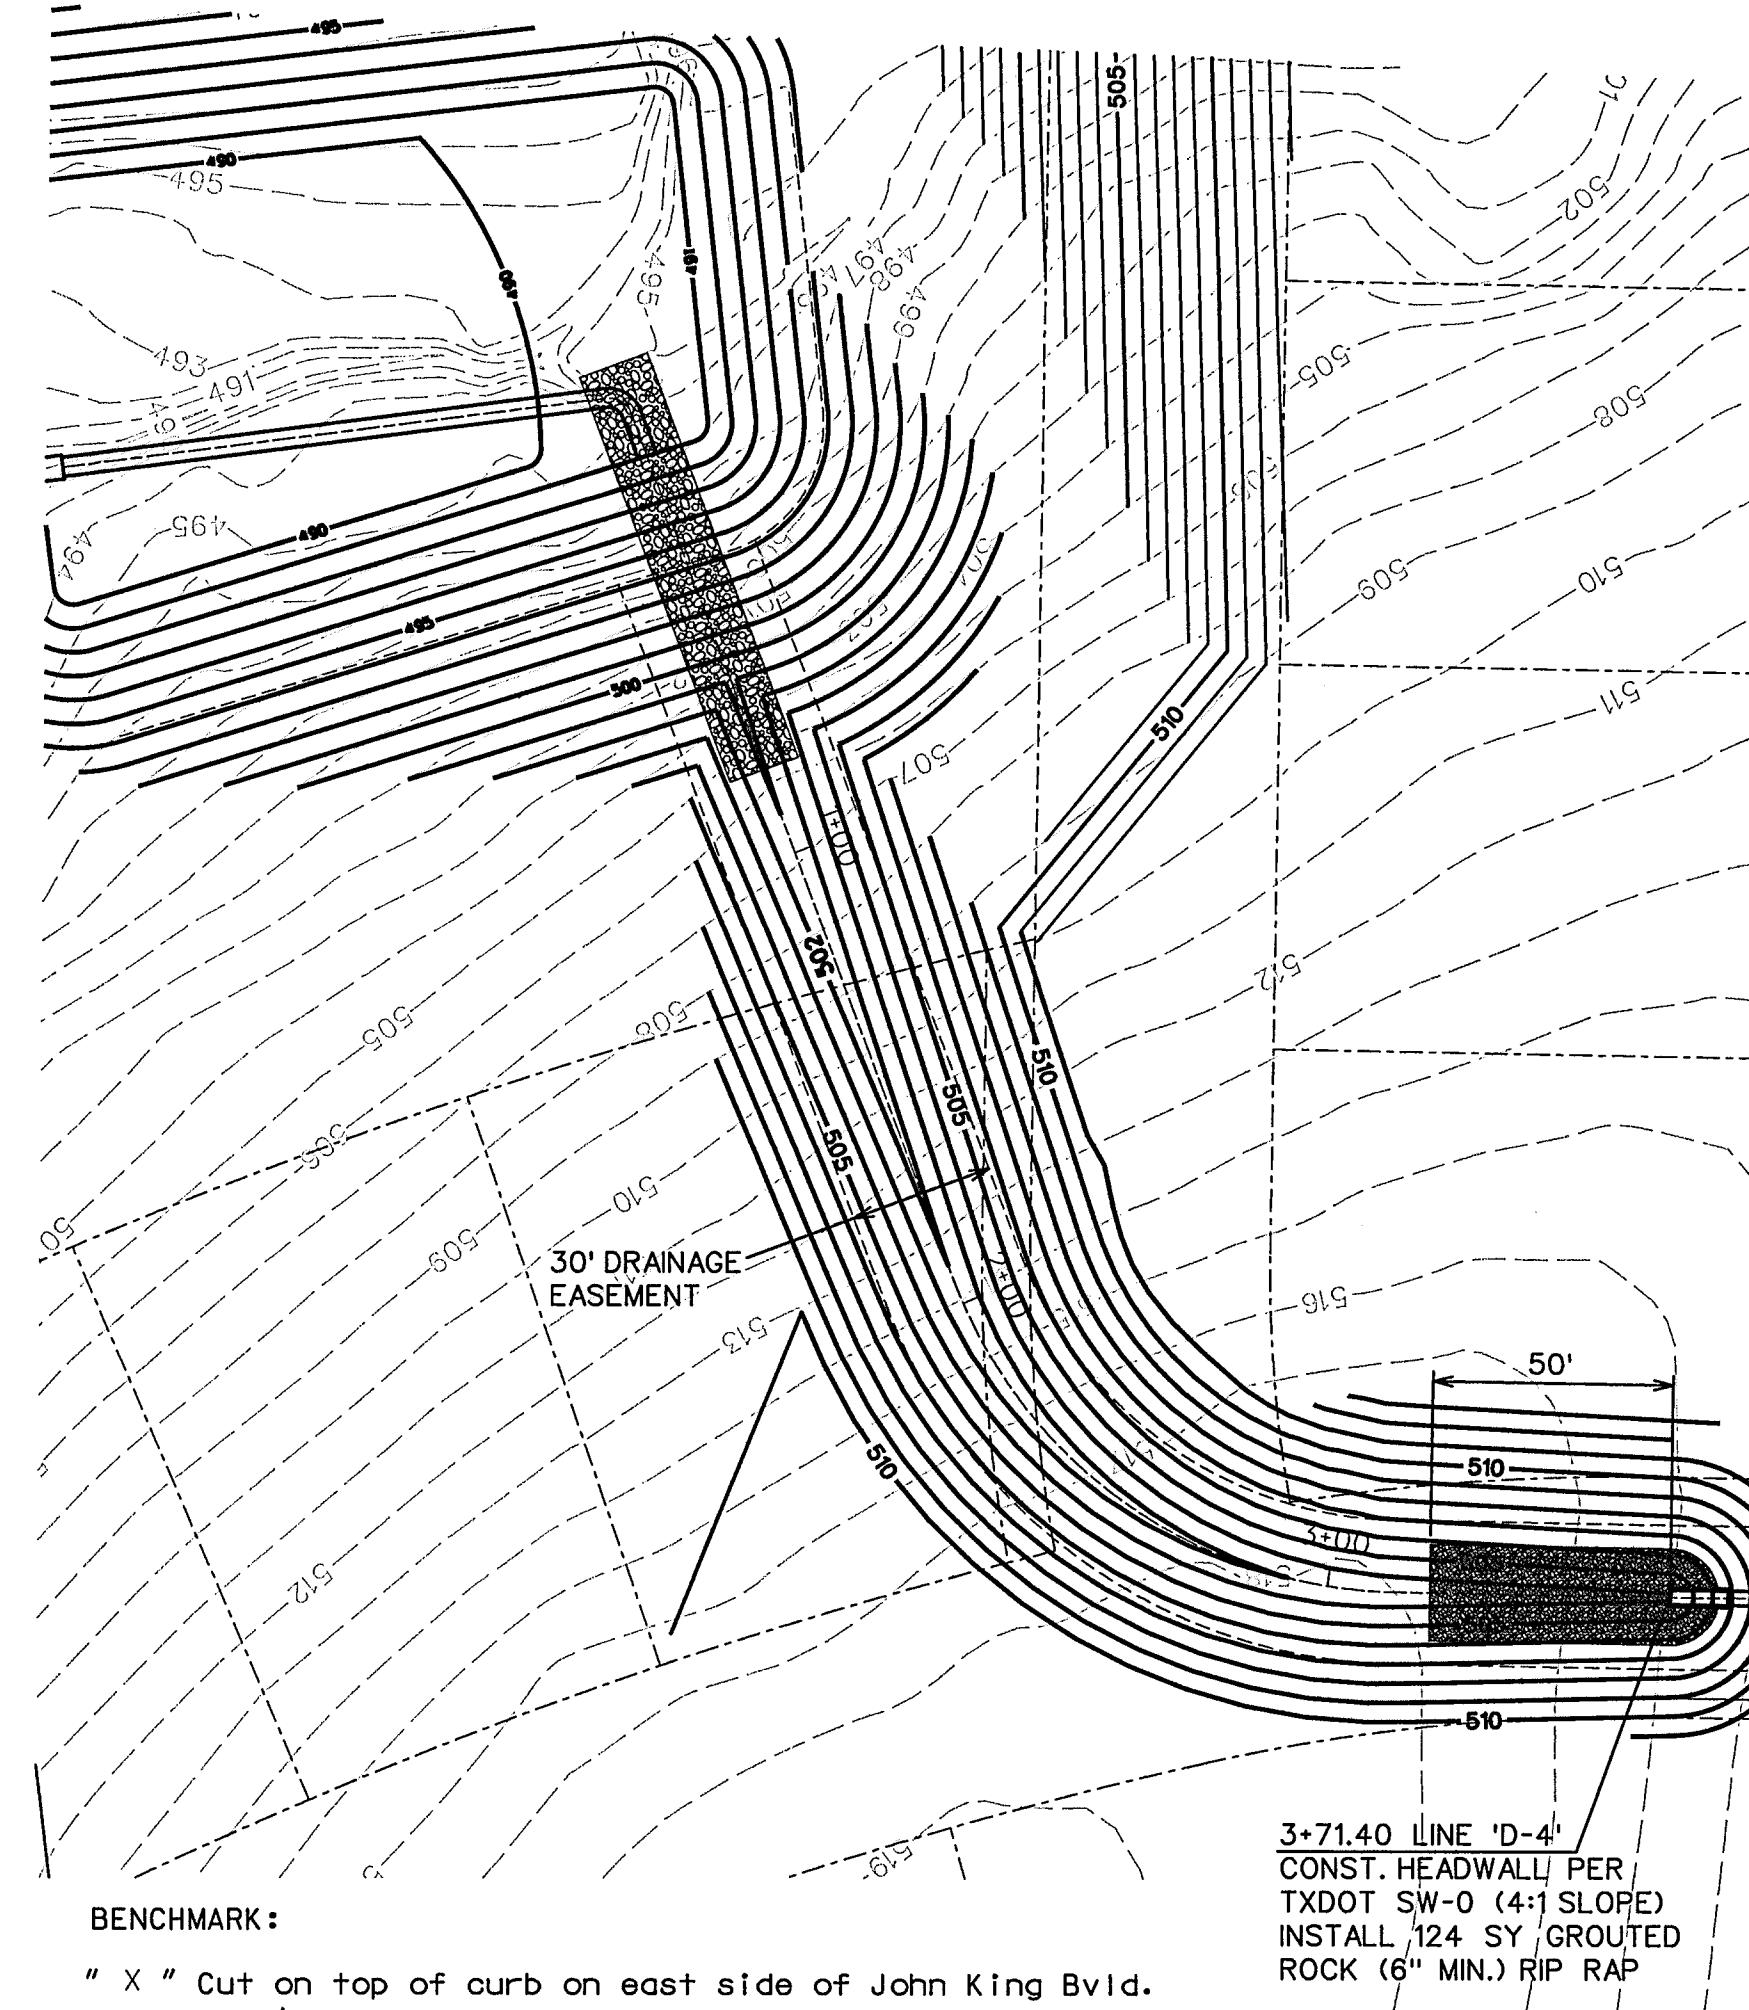



0 20 40 80
SCALE: 1" - 40'

LEGEND
 (B) BLOCK LABEL
 (I) INLET NUMBER
 (C) CURVE NUMBER
 (S) SANITARY SEWER
 (W) WATER
 (P) PROPOSED STORM SEWER
 (E) EXISTING STORM SEWER

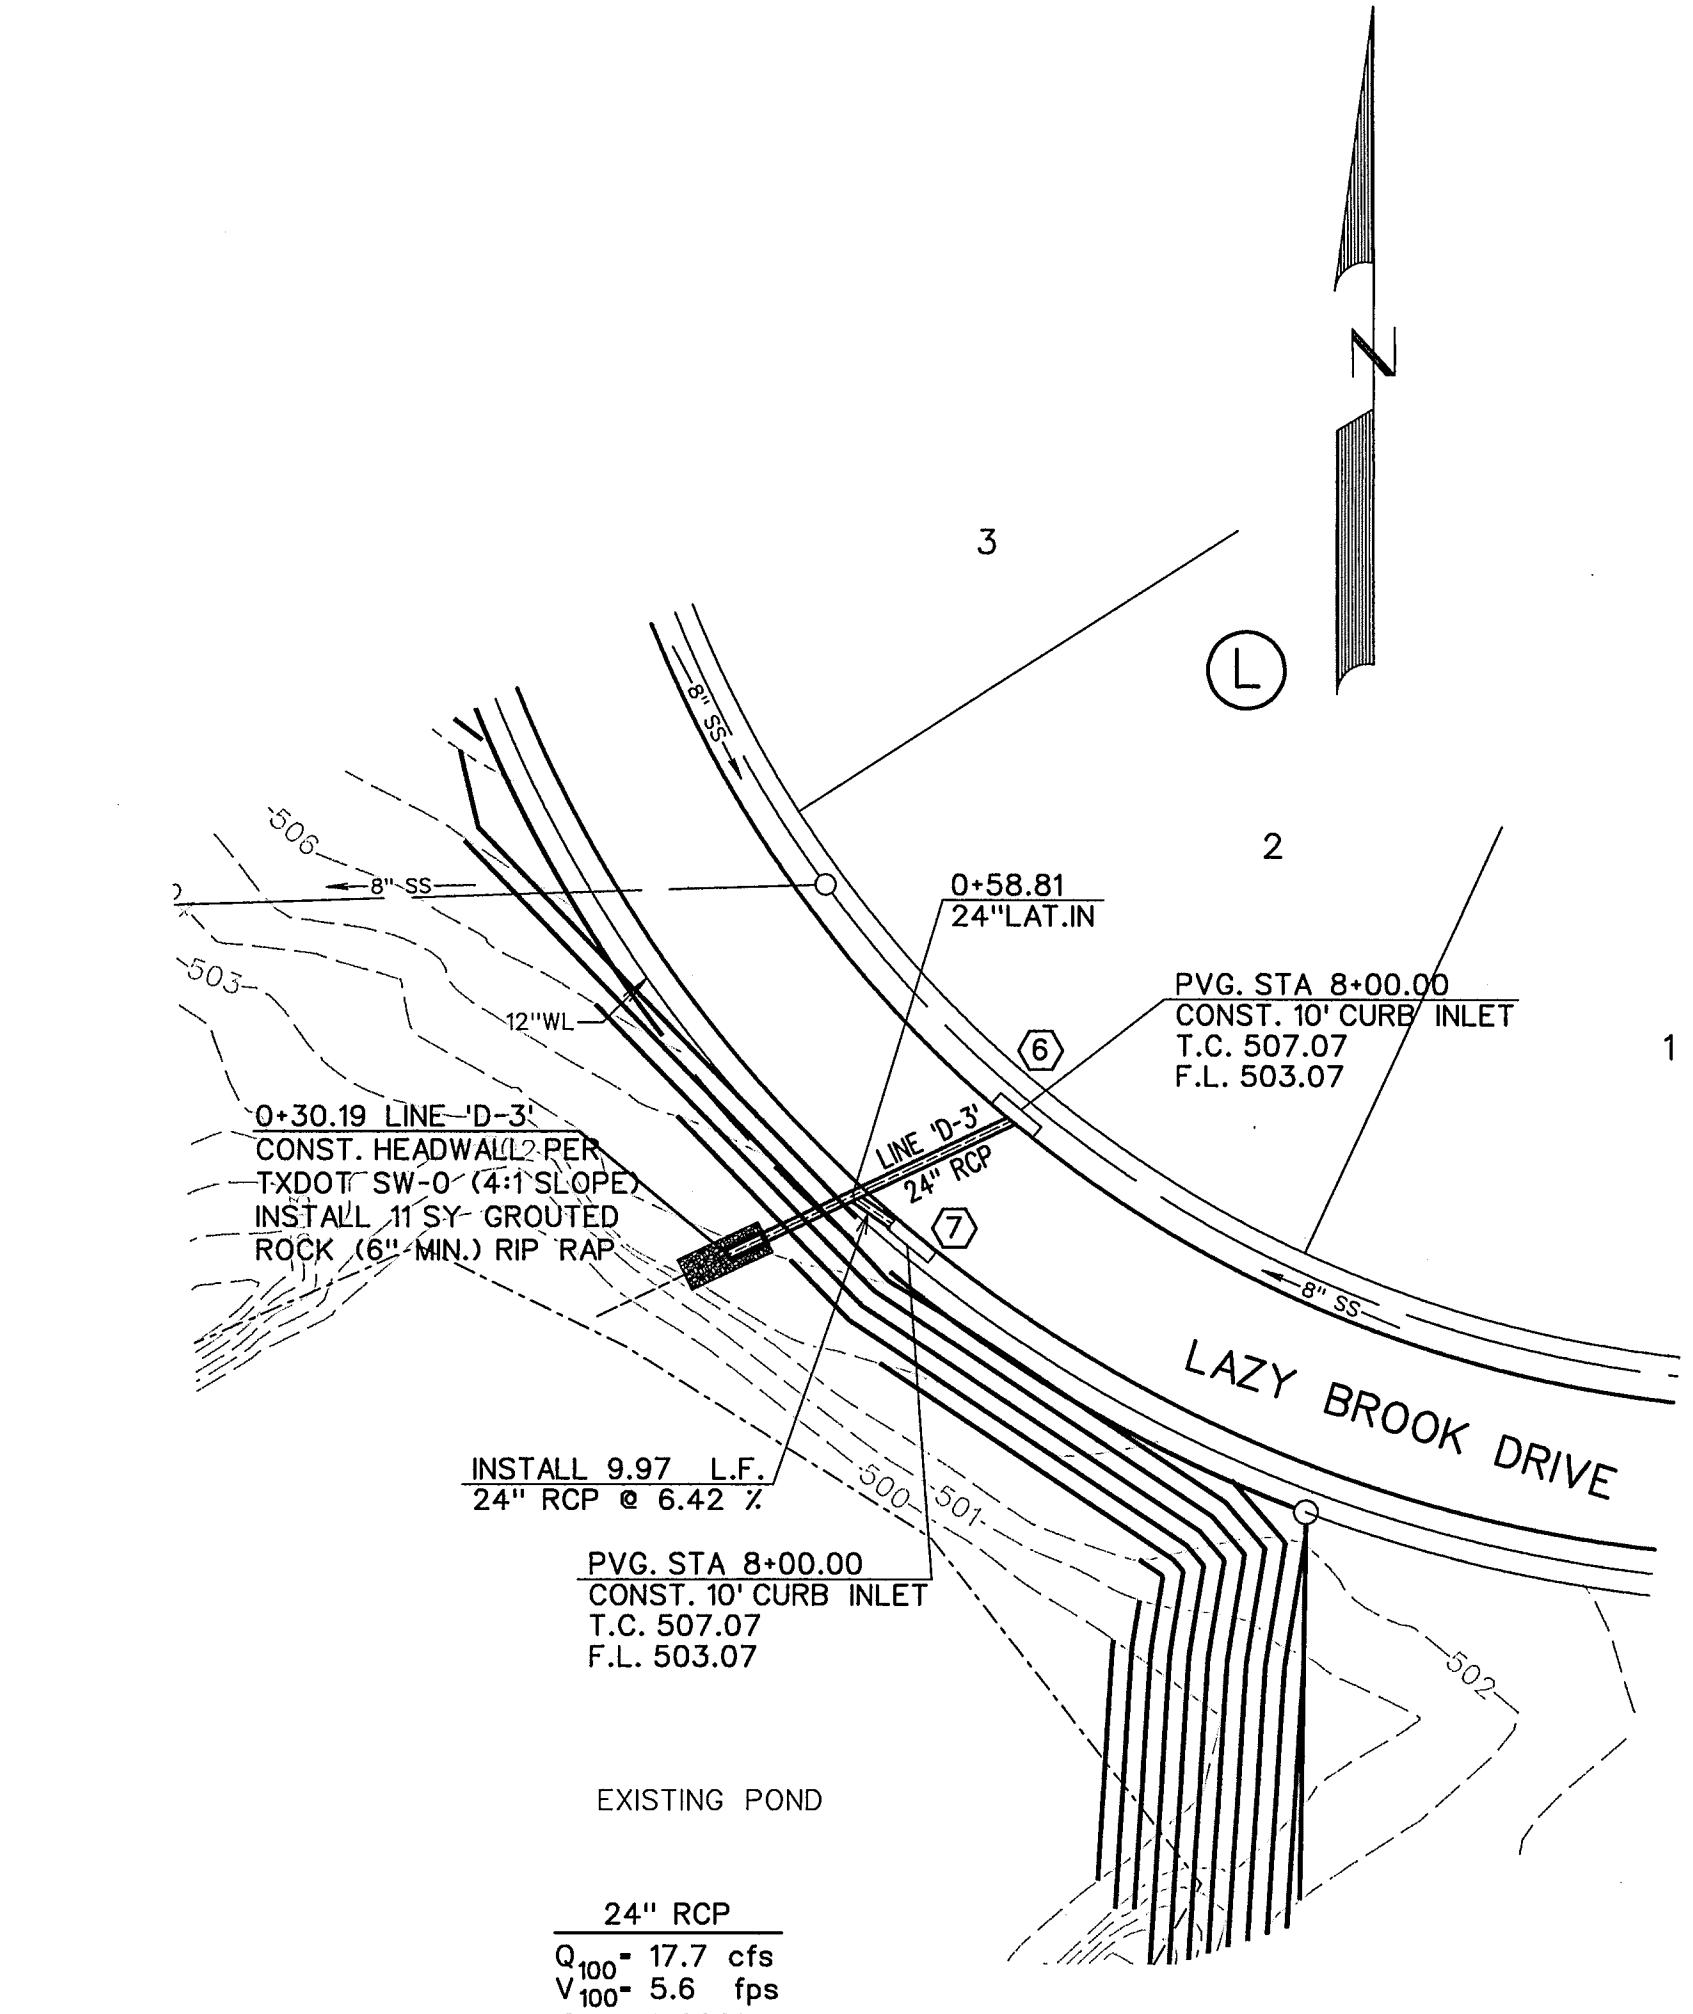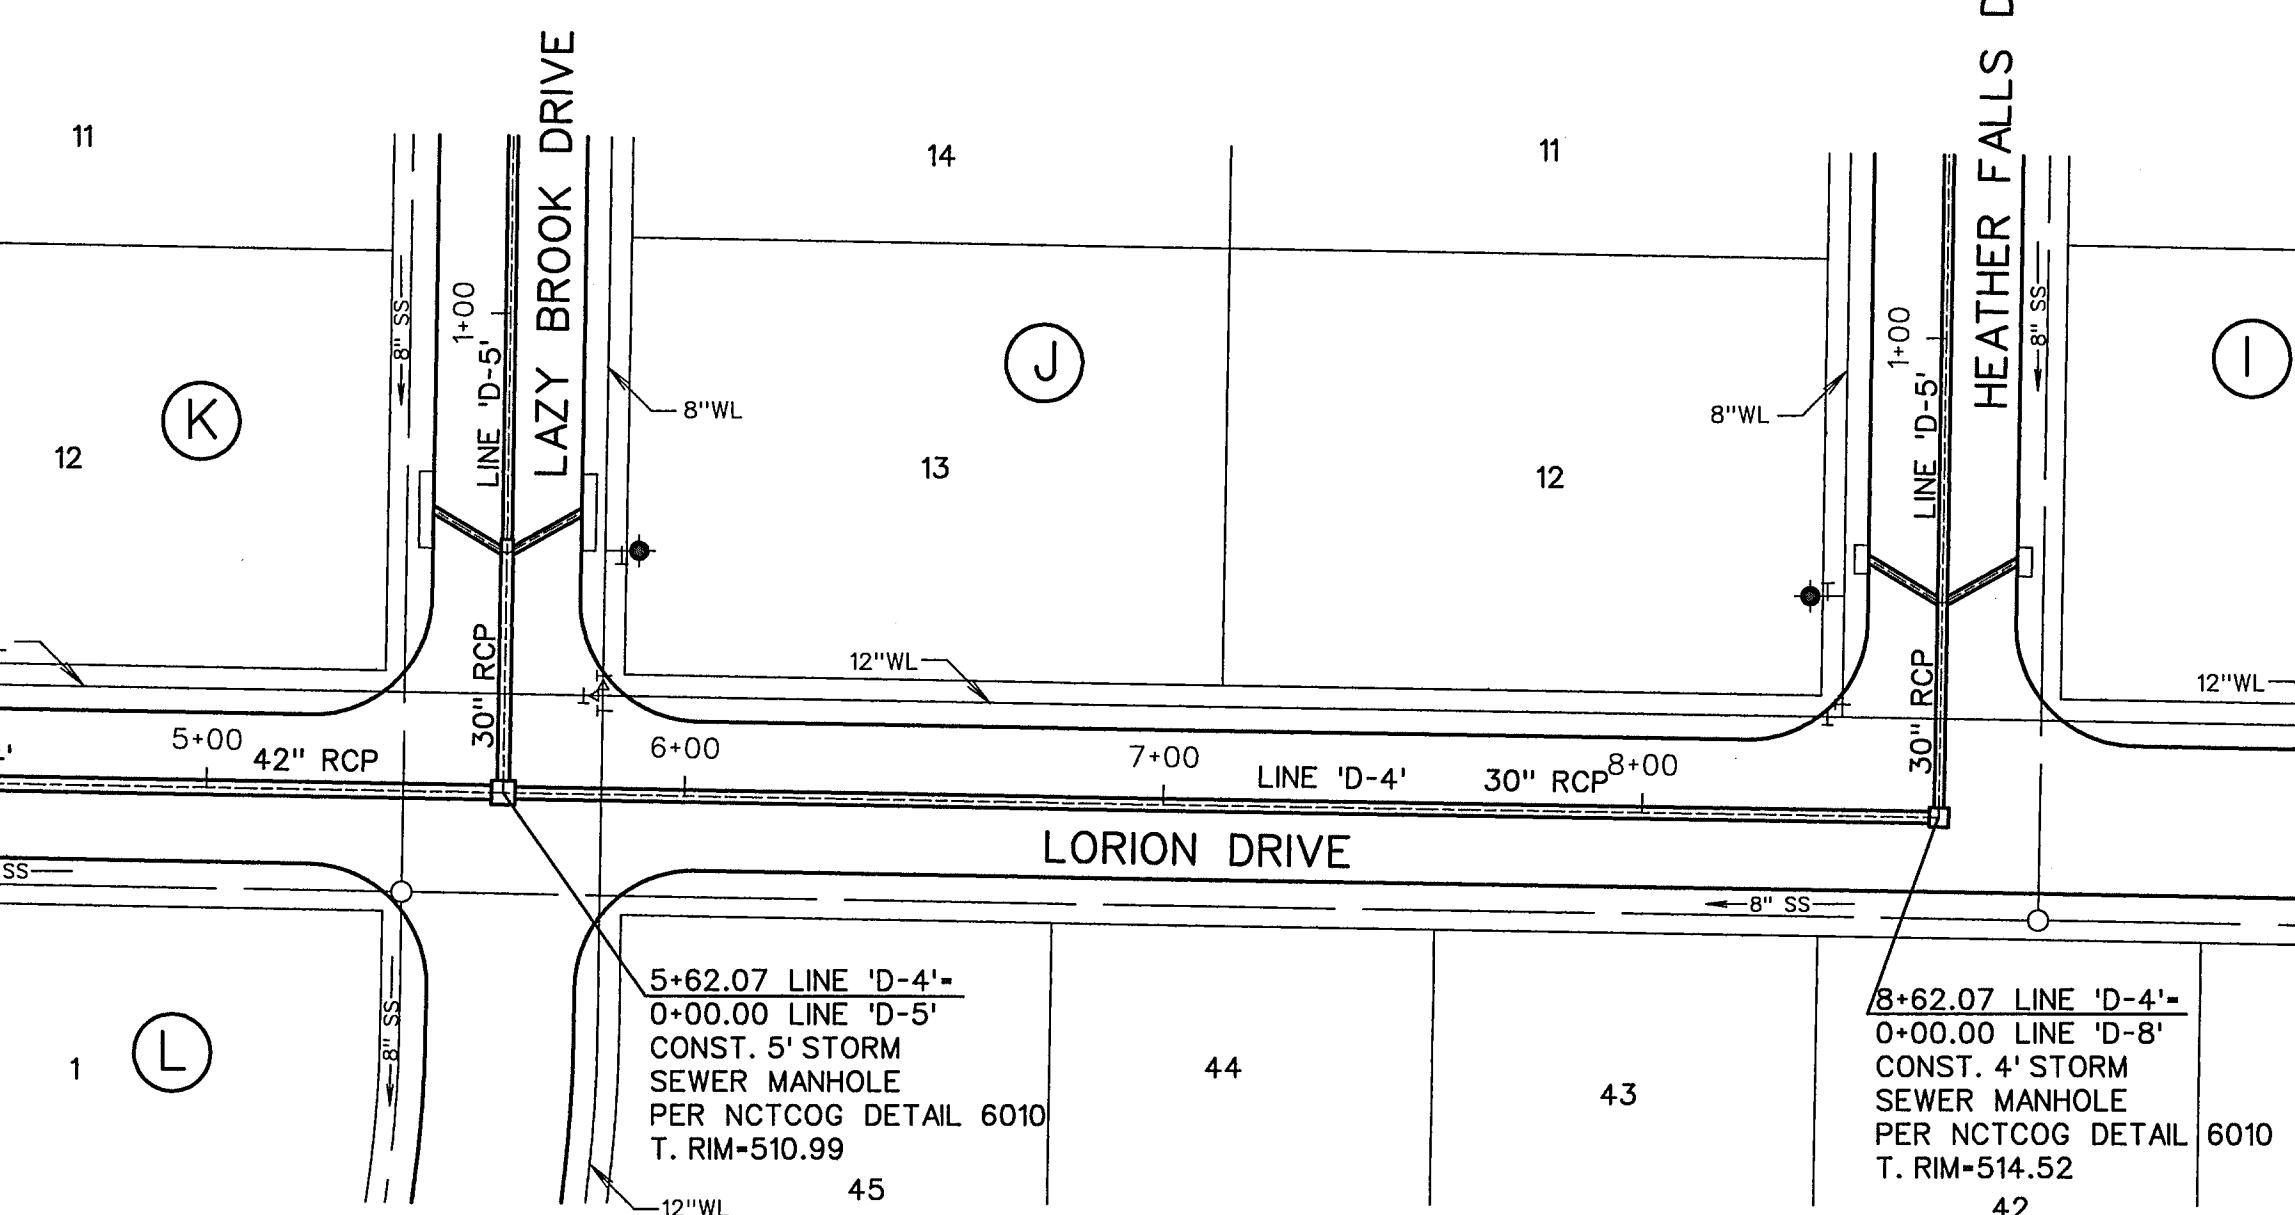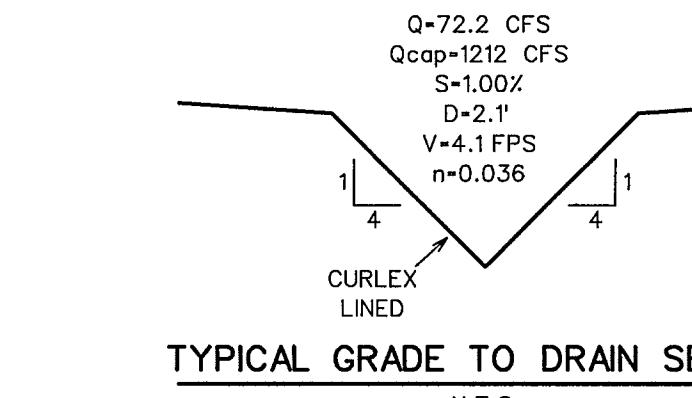


LINE 'D-3'

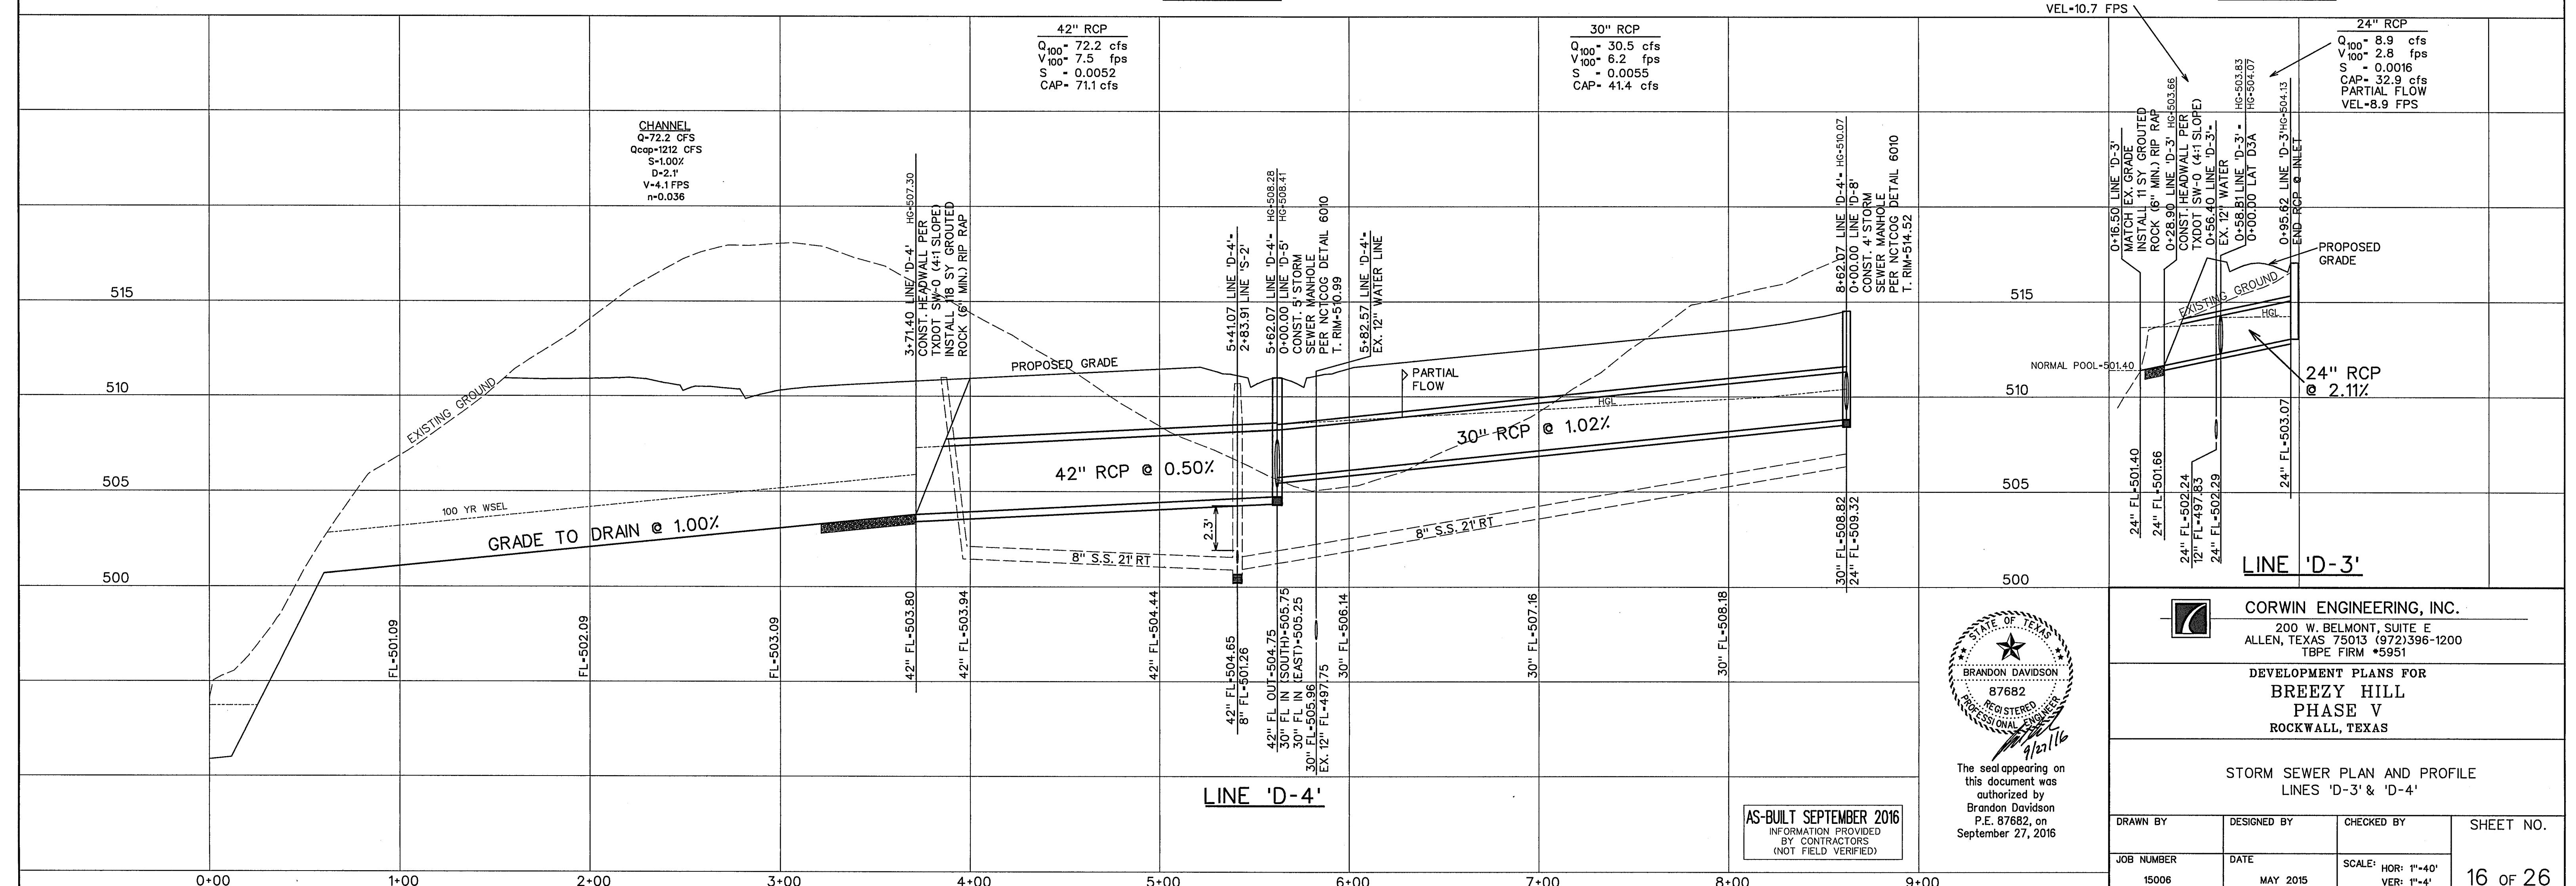

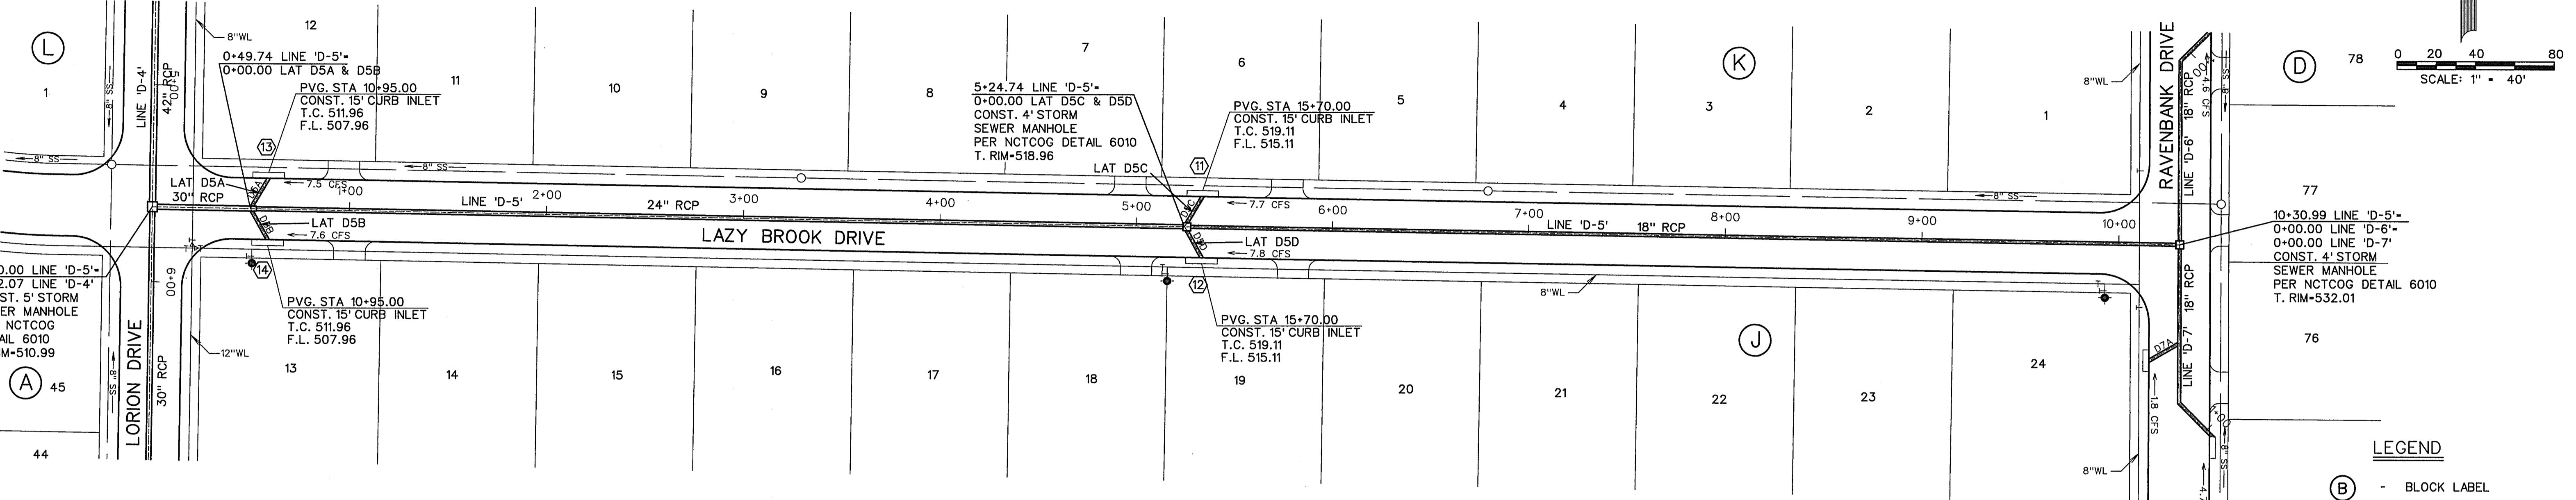


LEGEND

- (A) BLOCK LABEL
- (B) INLET NUMBER
- (C) CURVE NUMBER
- (D) SANITARY SEWER
- (E) WATER
- (F) PROPOSED STORM SEWER
- (G) EXISTING STORM SEWER

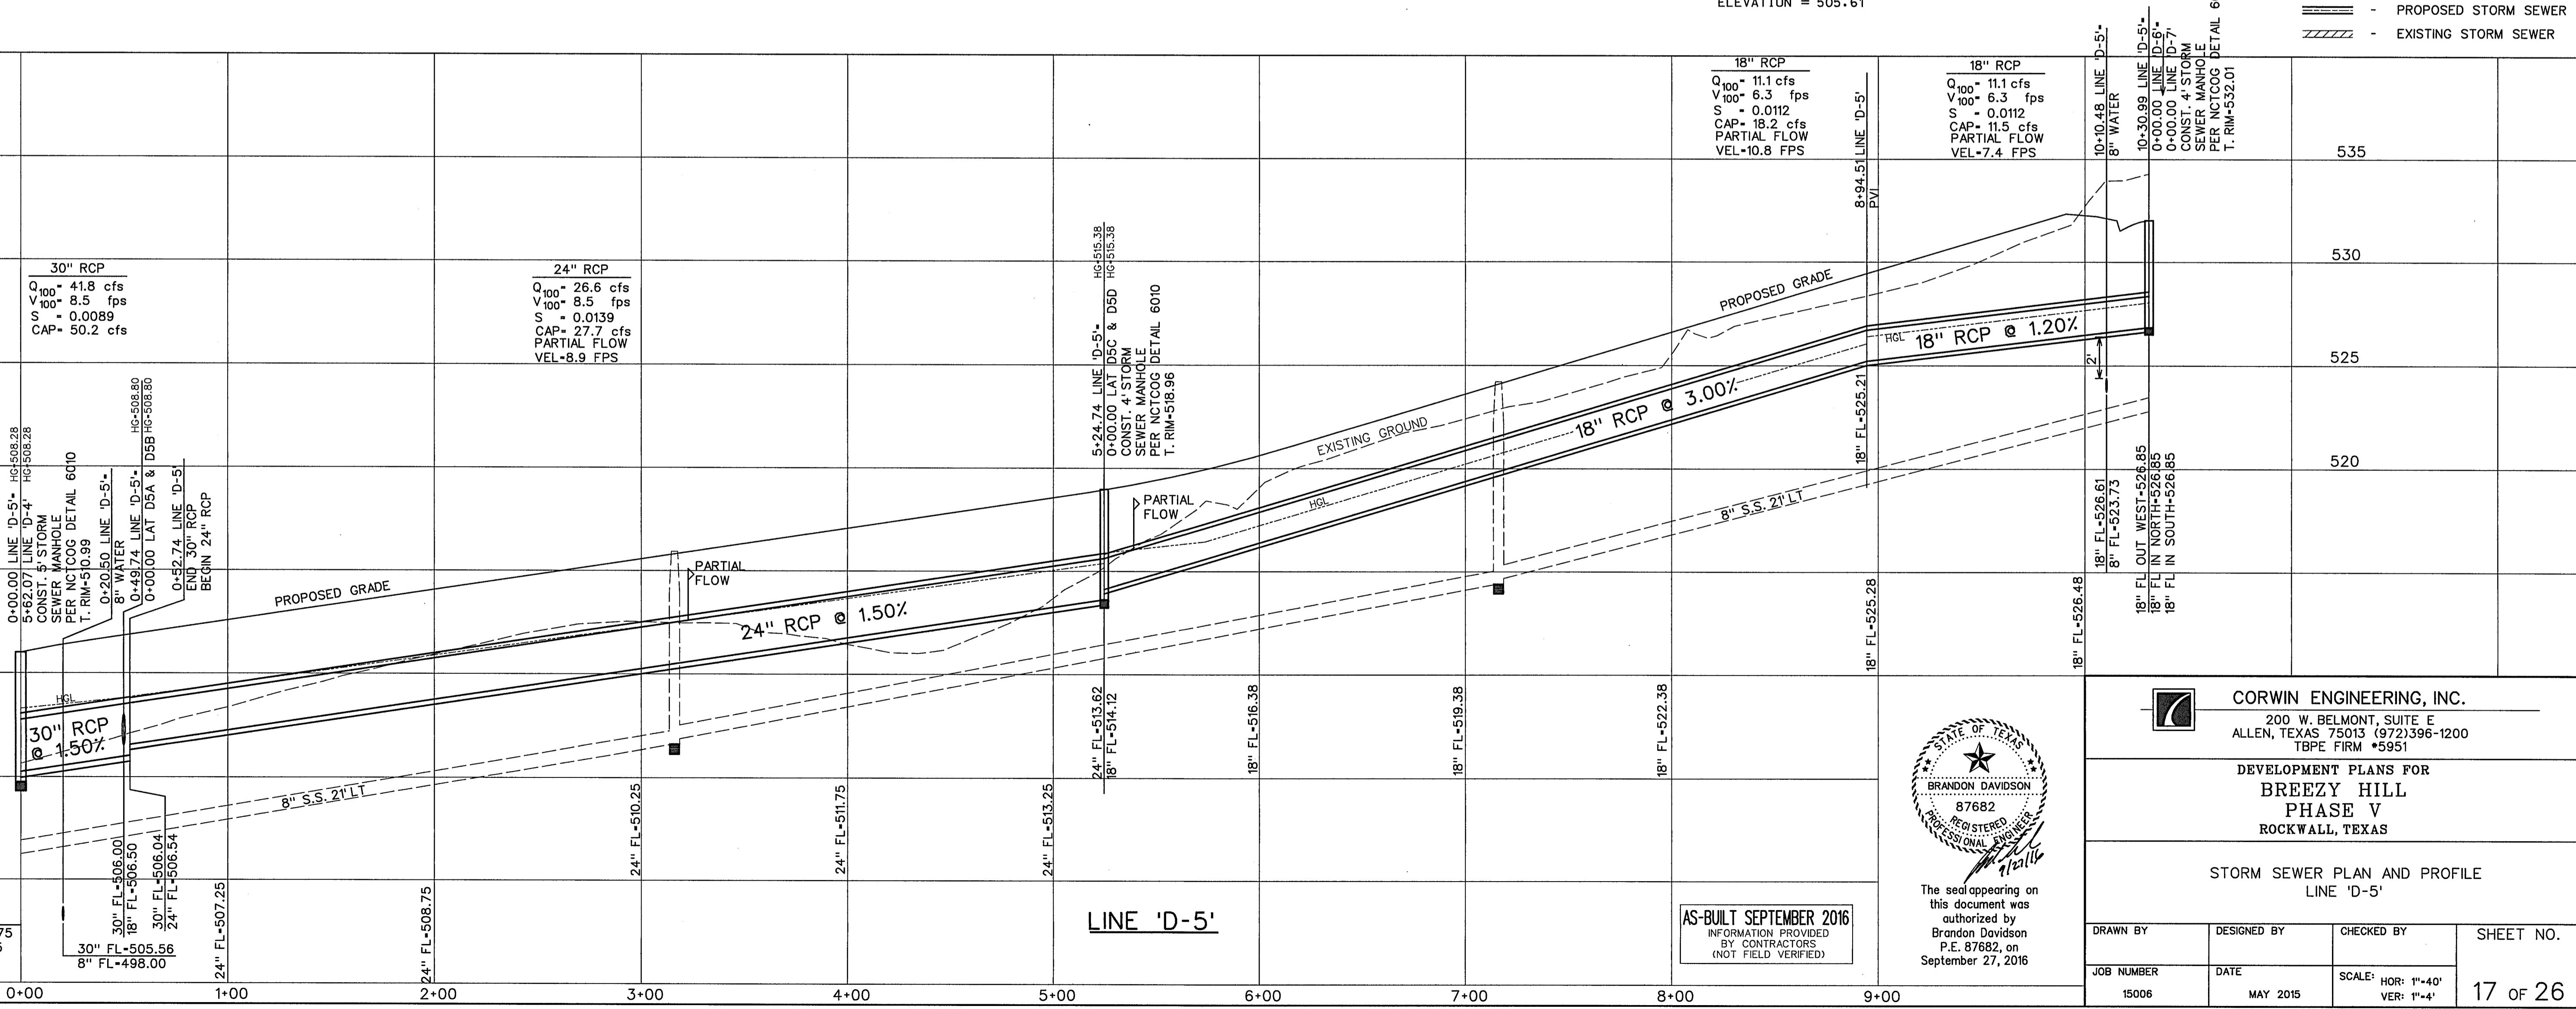

0 20 40 80
SCALE: 1" - 40'

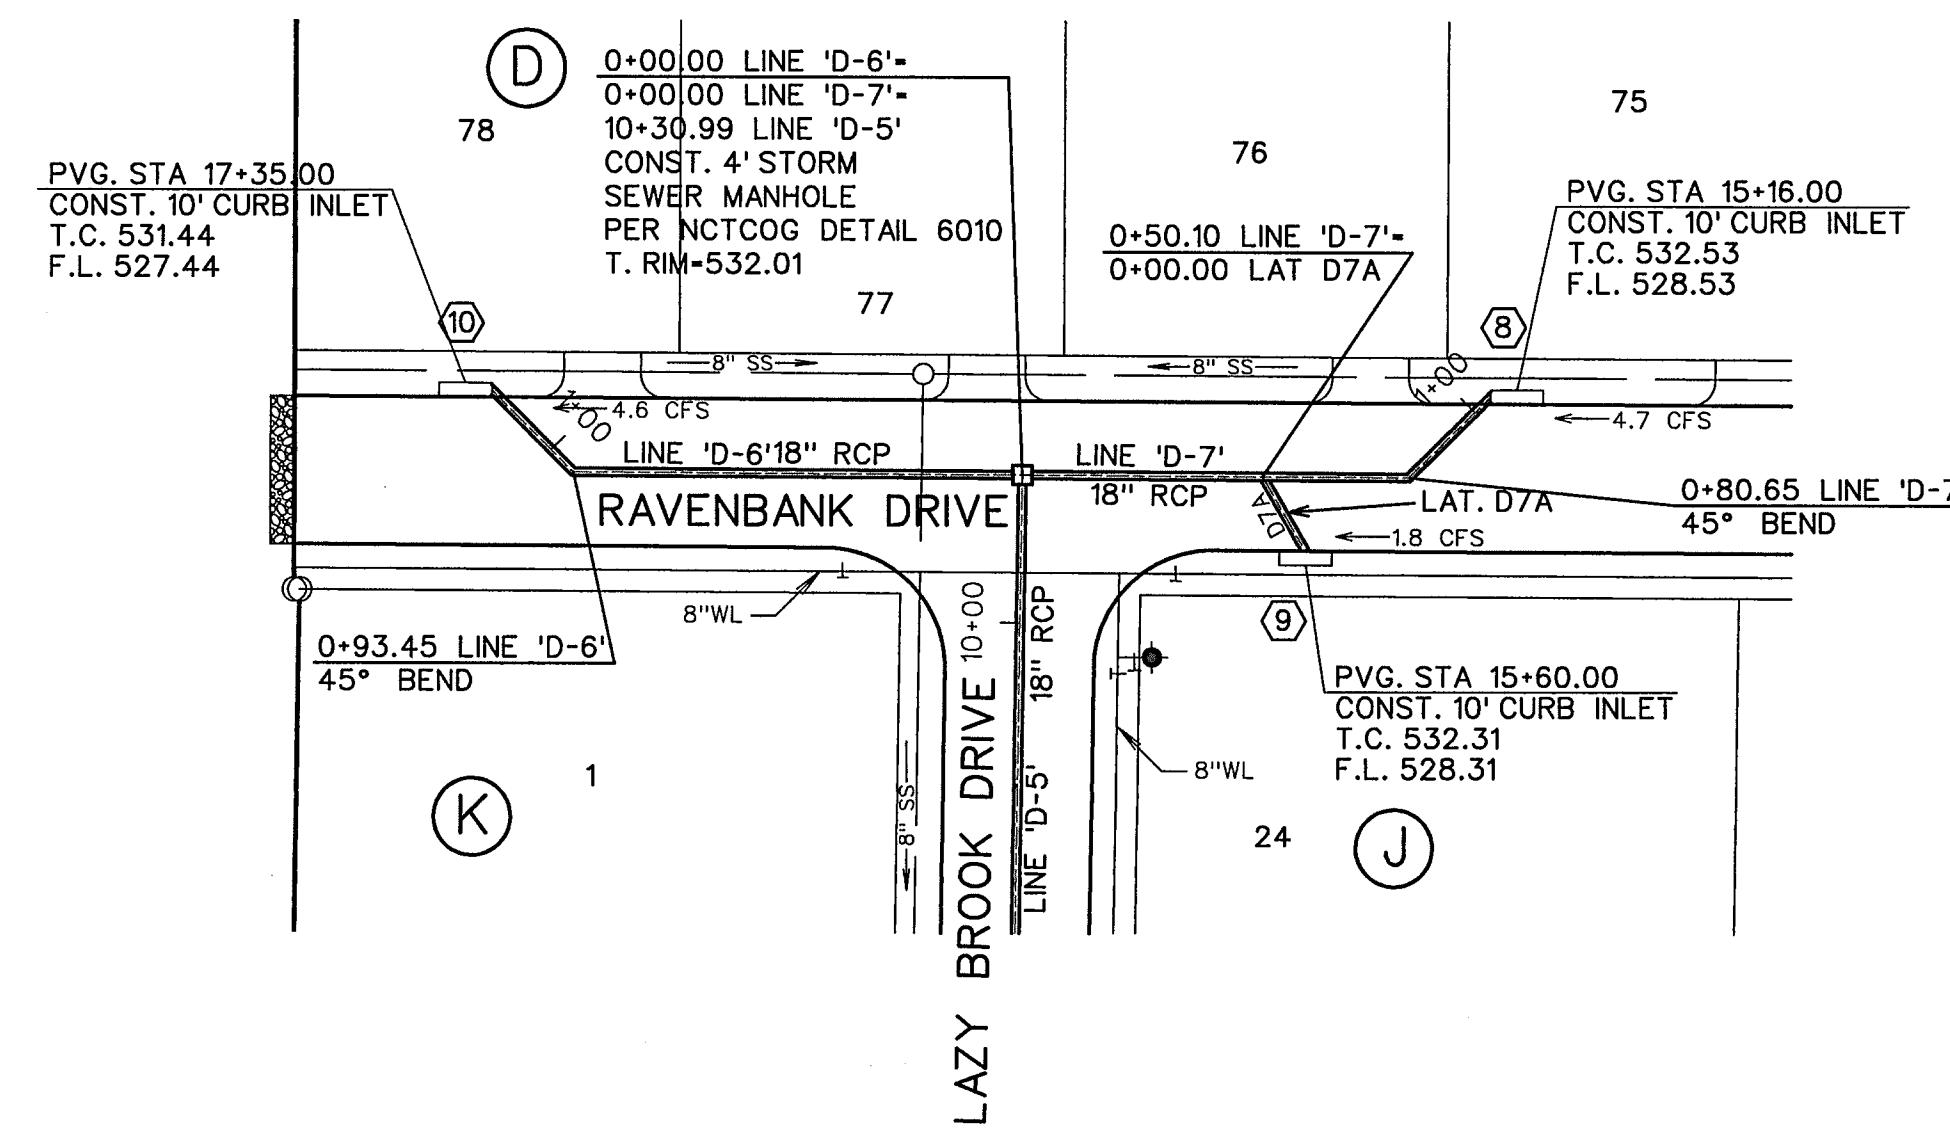

LINE 'D-6' & 'D-7'


BENCHMARK:

" X " Cut on top of curb on east side of John King Blvd.
approx. 48' north of the centerline of Pleasant View Dr.

ELEVATION = 505.61

LEGEND

- (B) - BLOCK LABEL
- (⑩) - INLET NUMBER
- (①) - CURVE NUMBER
- (—) - SANITARY SEWER
- (WATER)
- (—) - PROPOSED STORM SEWER
- (//) - EXISTING STORM SEWER

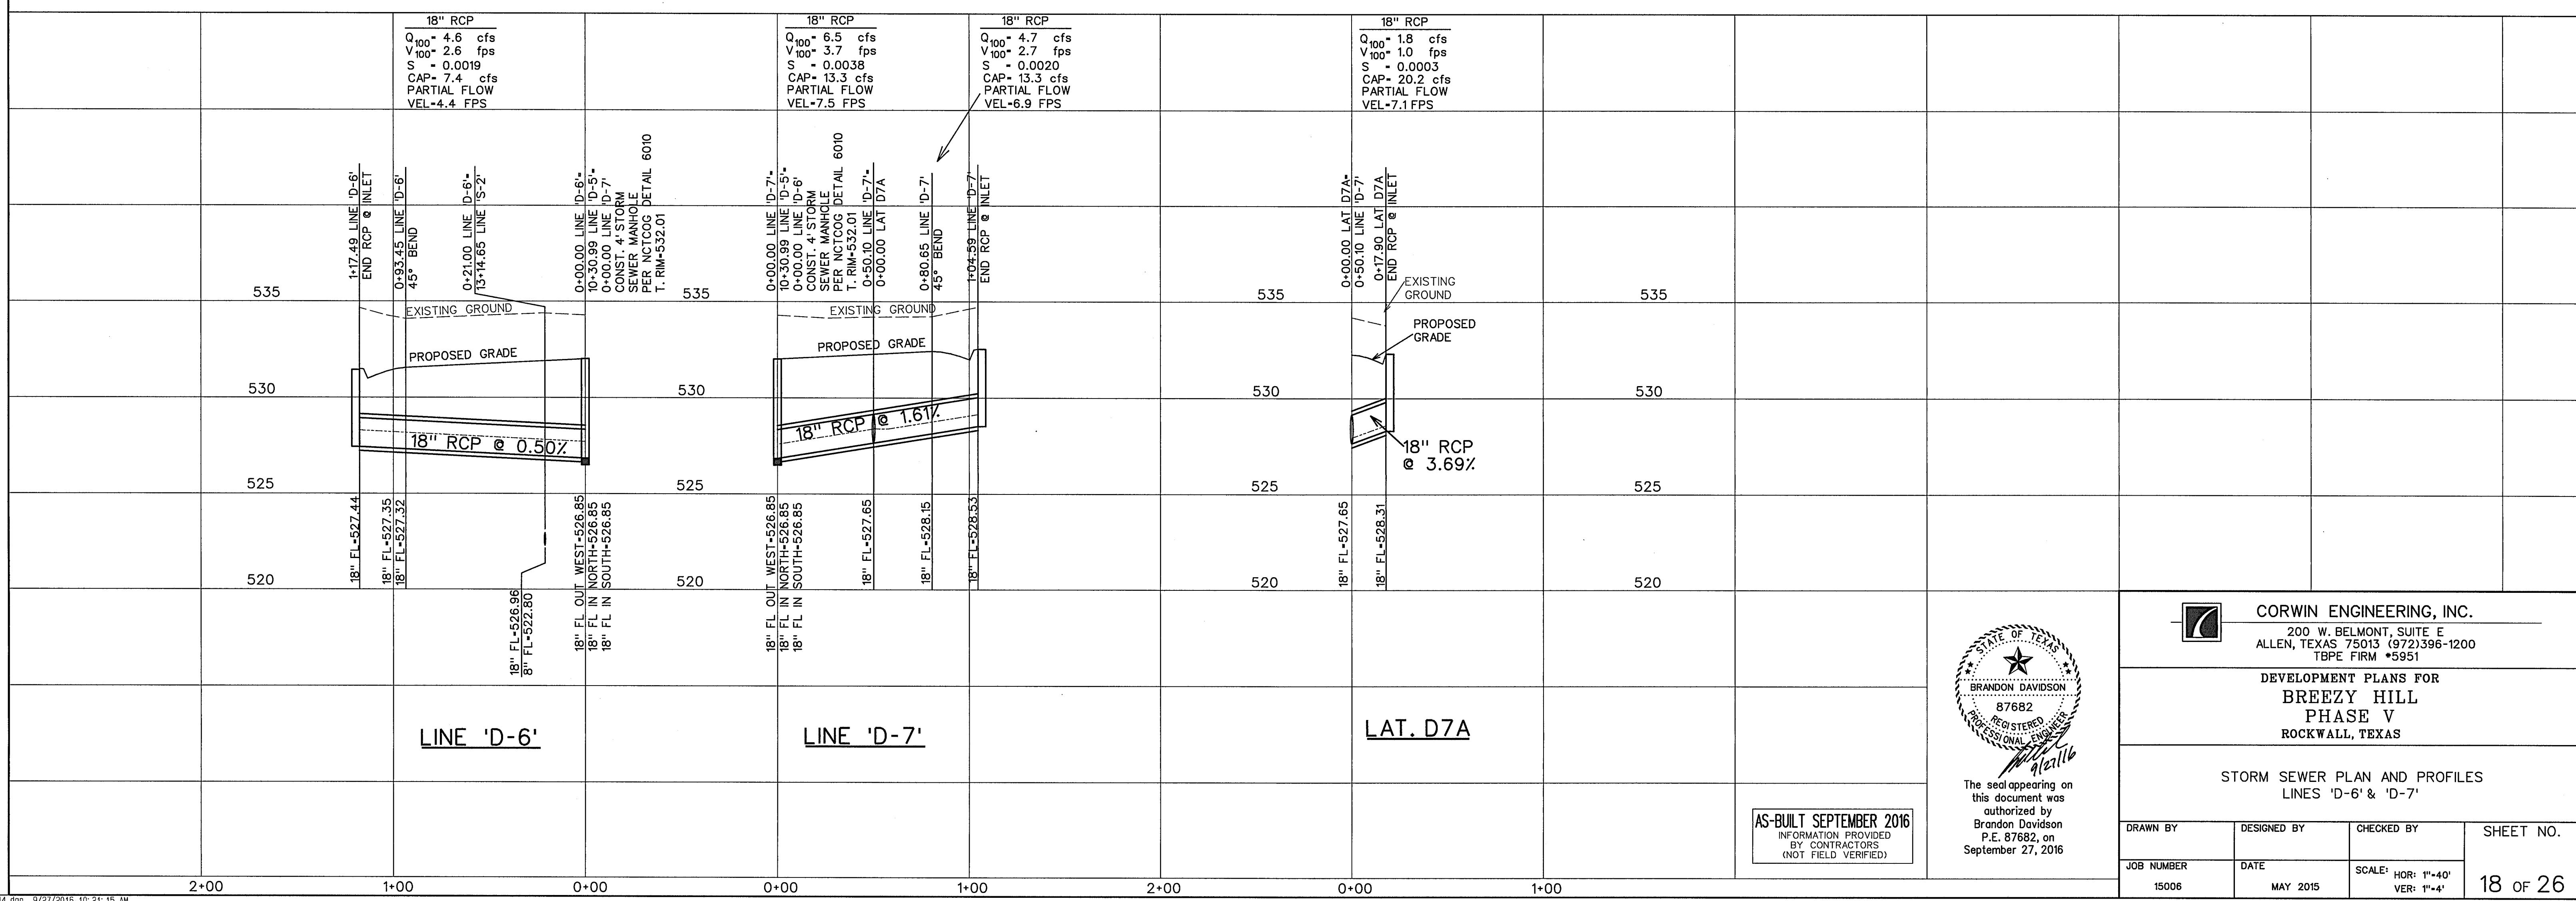


BENCHMARK:

"X" Cut on top of curb on east side of John King Blvd.
approx. 48' north of the centerline of Pleasant View Dr.


ELEVATION = 505.61



0 20 40 80
SCALE: 1" - 40'

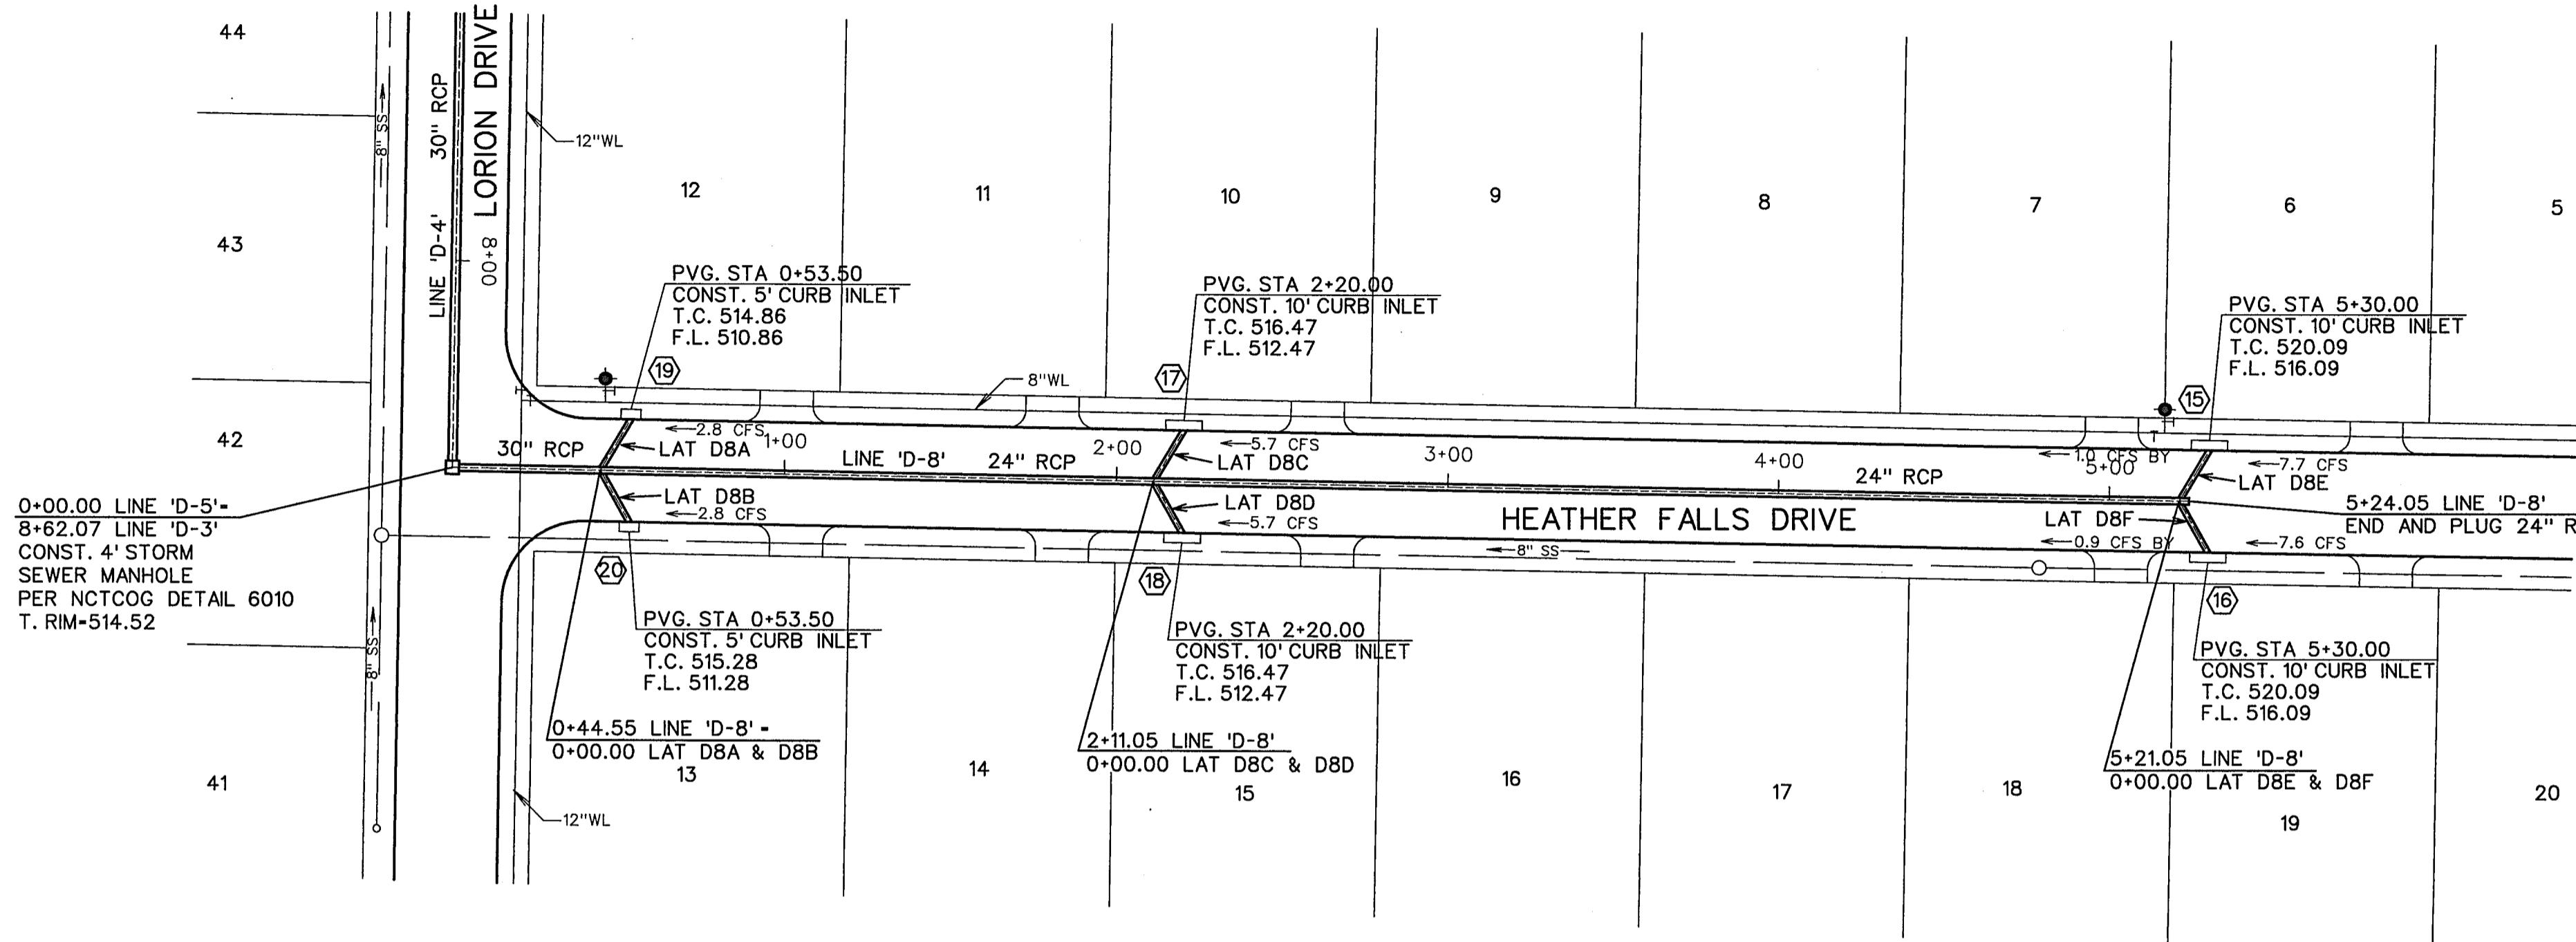

LINE 'D-8'

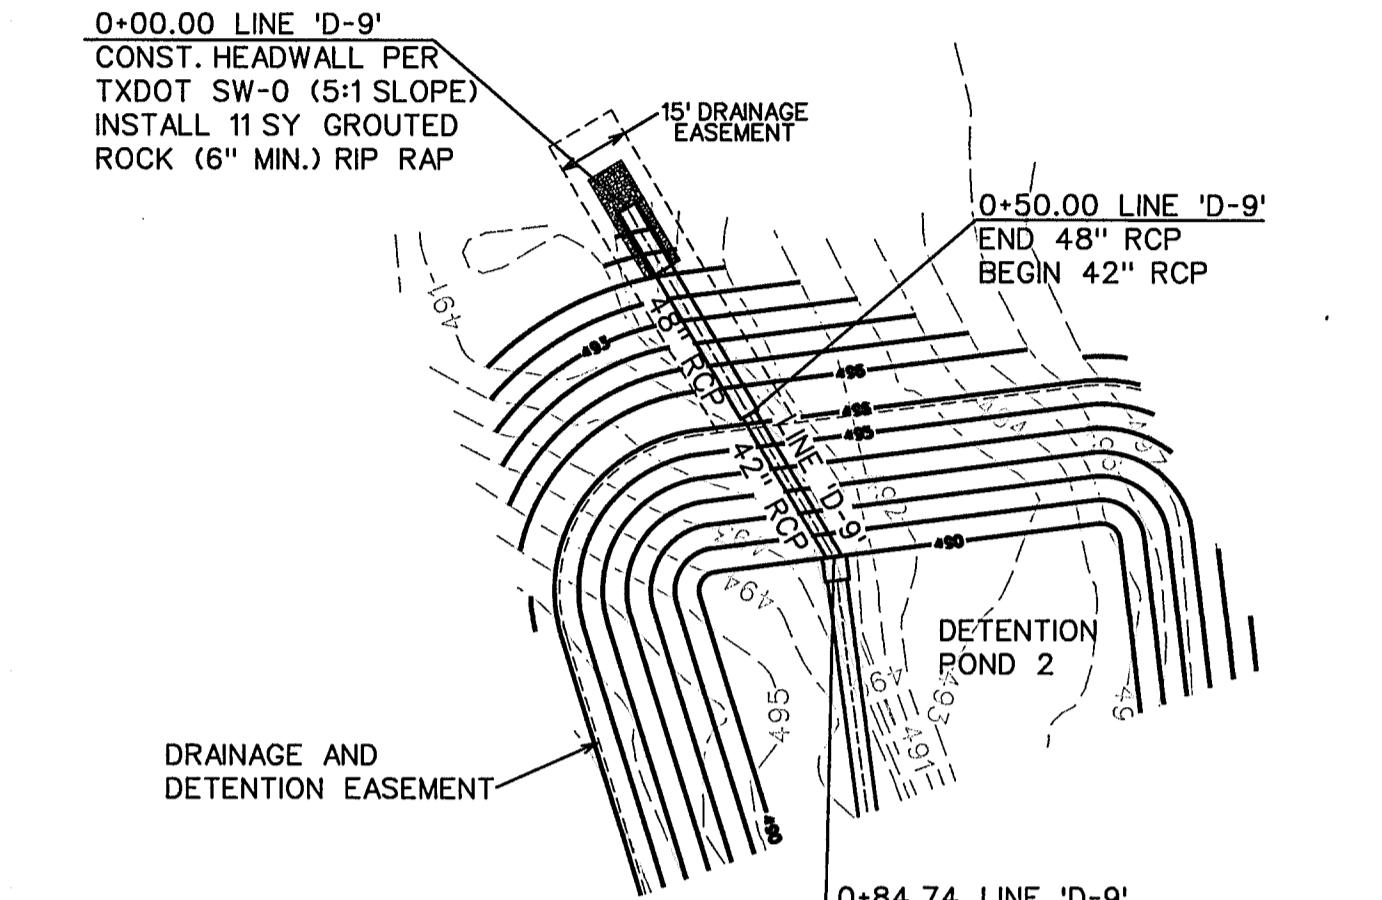


LEGEND

- (B) - BLOCK LABEL
- (1) - INLET NUMBER
- (1) - CURVE NUMBER
- (+) - SANITARY SEWER
- (+) - WATER
- PROPOSED STORM SEWER
- ==== EXISTING STORM SEWER

LINE 'D-9'

48" RCP	42" RCP
$Q_{100} = 96.4 \text{ cfs}$	$Q_{100} = 96.4 \text{ cfs}$
$V_{100} = 7.7 \text{ fps}$	$V_{100} = 10.0 \text{ fps}$
$S = 0.0045$	$S = 0.0092$
CAP = 90.8 cfs	CAP = 93.3 cfs

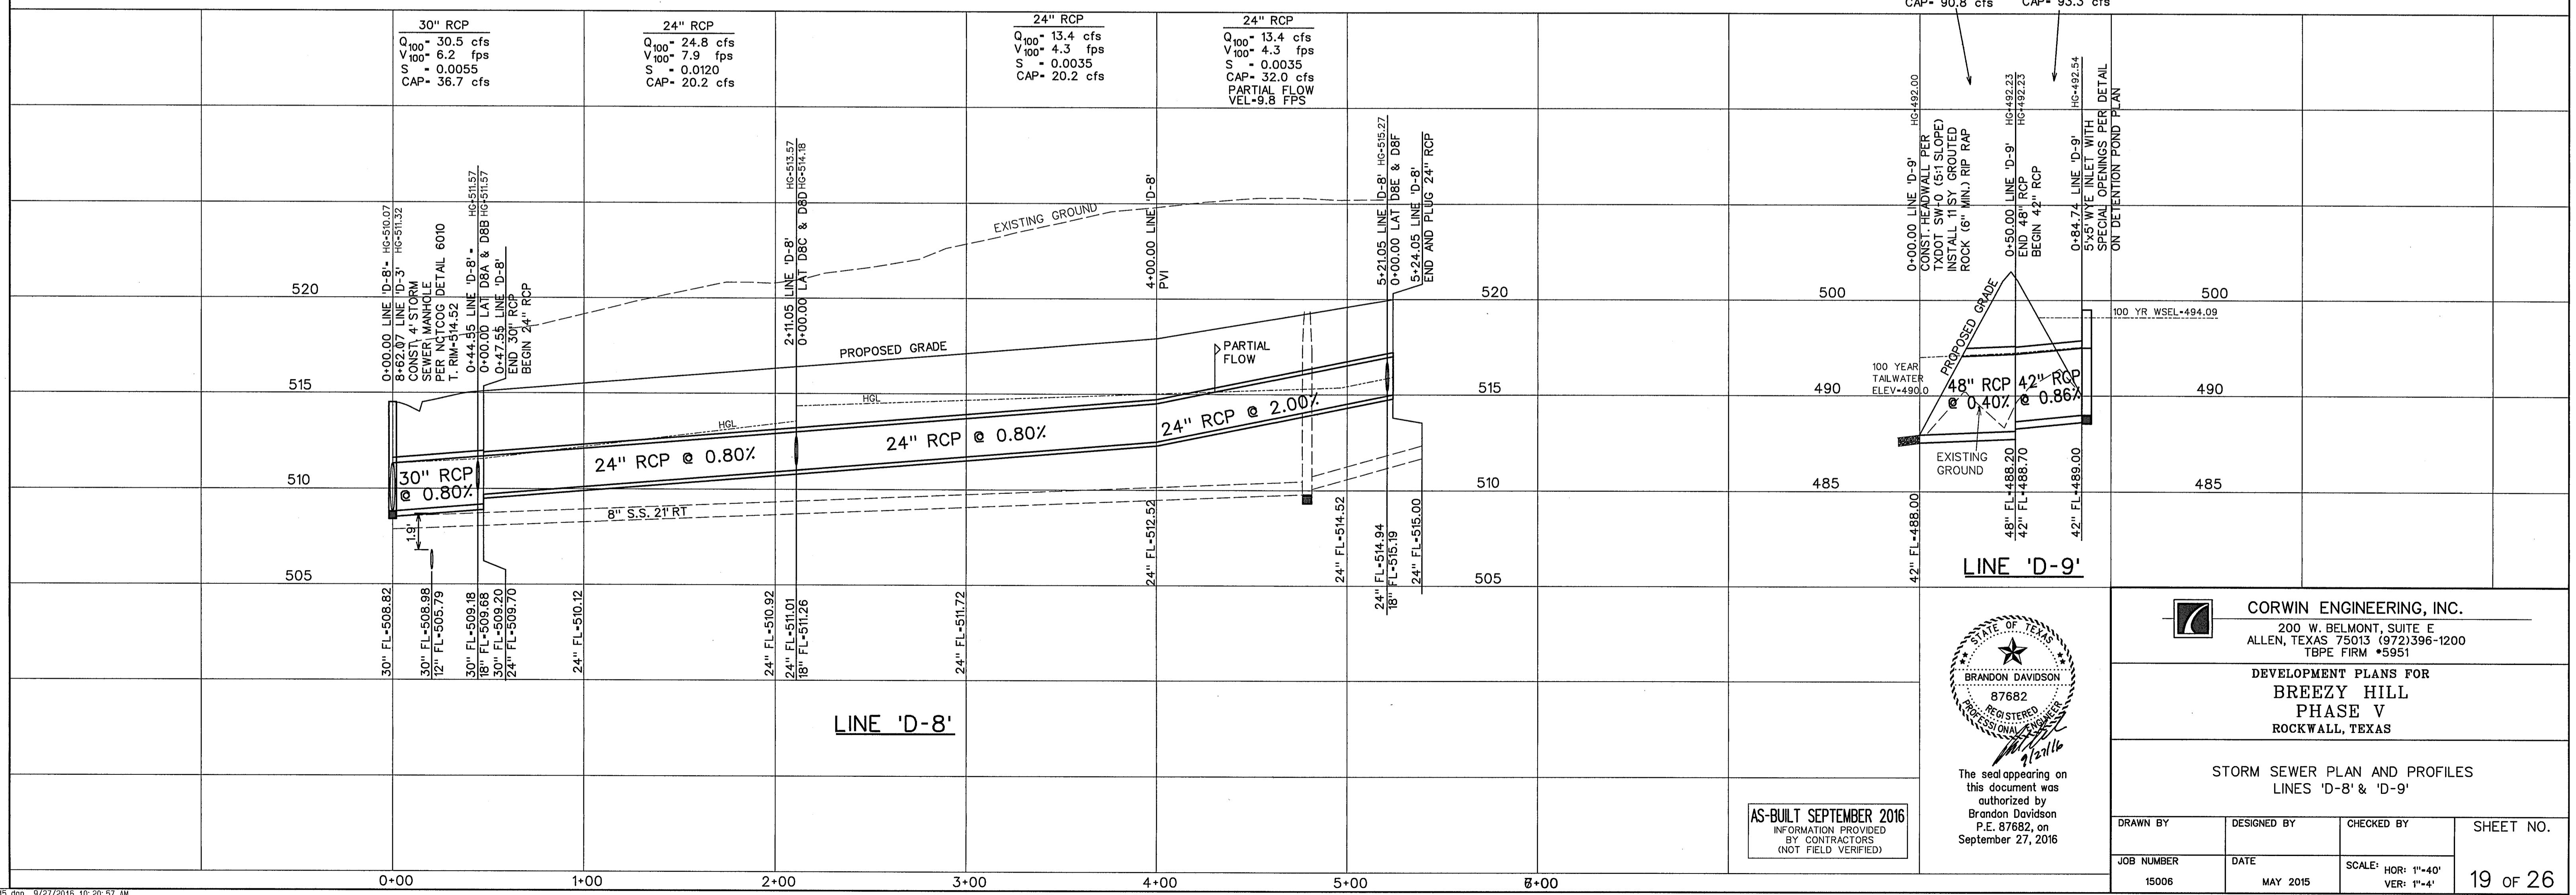

LINE 'D-8'

0+00 1+00 2+00 3+00 4+00 5+00 6+00

AS-BUILT SEPTEMBER 2016
INFORMATION PROVIDED
BY CONTRACTORS
(NOT FIELD VERIFIED)




The seal appearing on
this document was
authorized by
Brandon Davidson
P.E. 87682, on
September 27, 2016

CORWIN ENGINEERING, INC.
200 W. BELMONT, SUITE E
ALLEN, TEXAS 75013 (972)396-1200
TBPE FIRM • 5951

DEVELOPMENT PLANS FOR
BREEZY HILL
PHASE V
ROCKWALL, TEXAS

STORM SEWER PLAN AND PROFILES
LINES 'D-8' & 'D-9'

DRAWN BY	DESIGNED BY	CHECKED BY	SHEET NO.
JOB NUMBER 15006	DATE MAY 2015	SCALE: HOR: 1"-40" VER: 1"-4"	19 OF 26

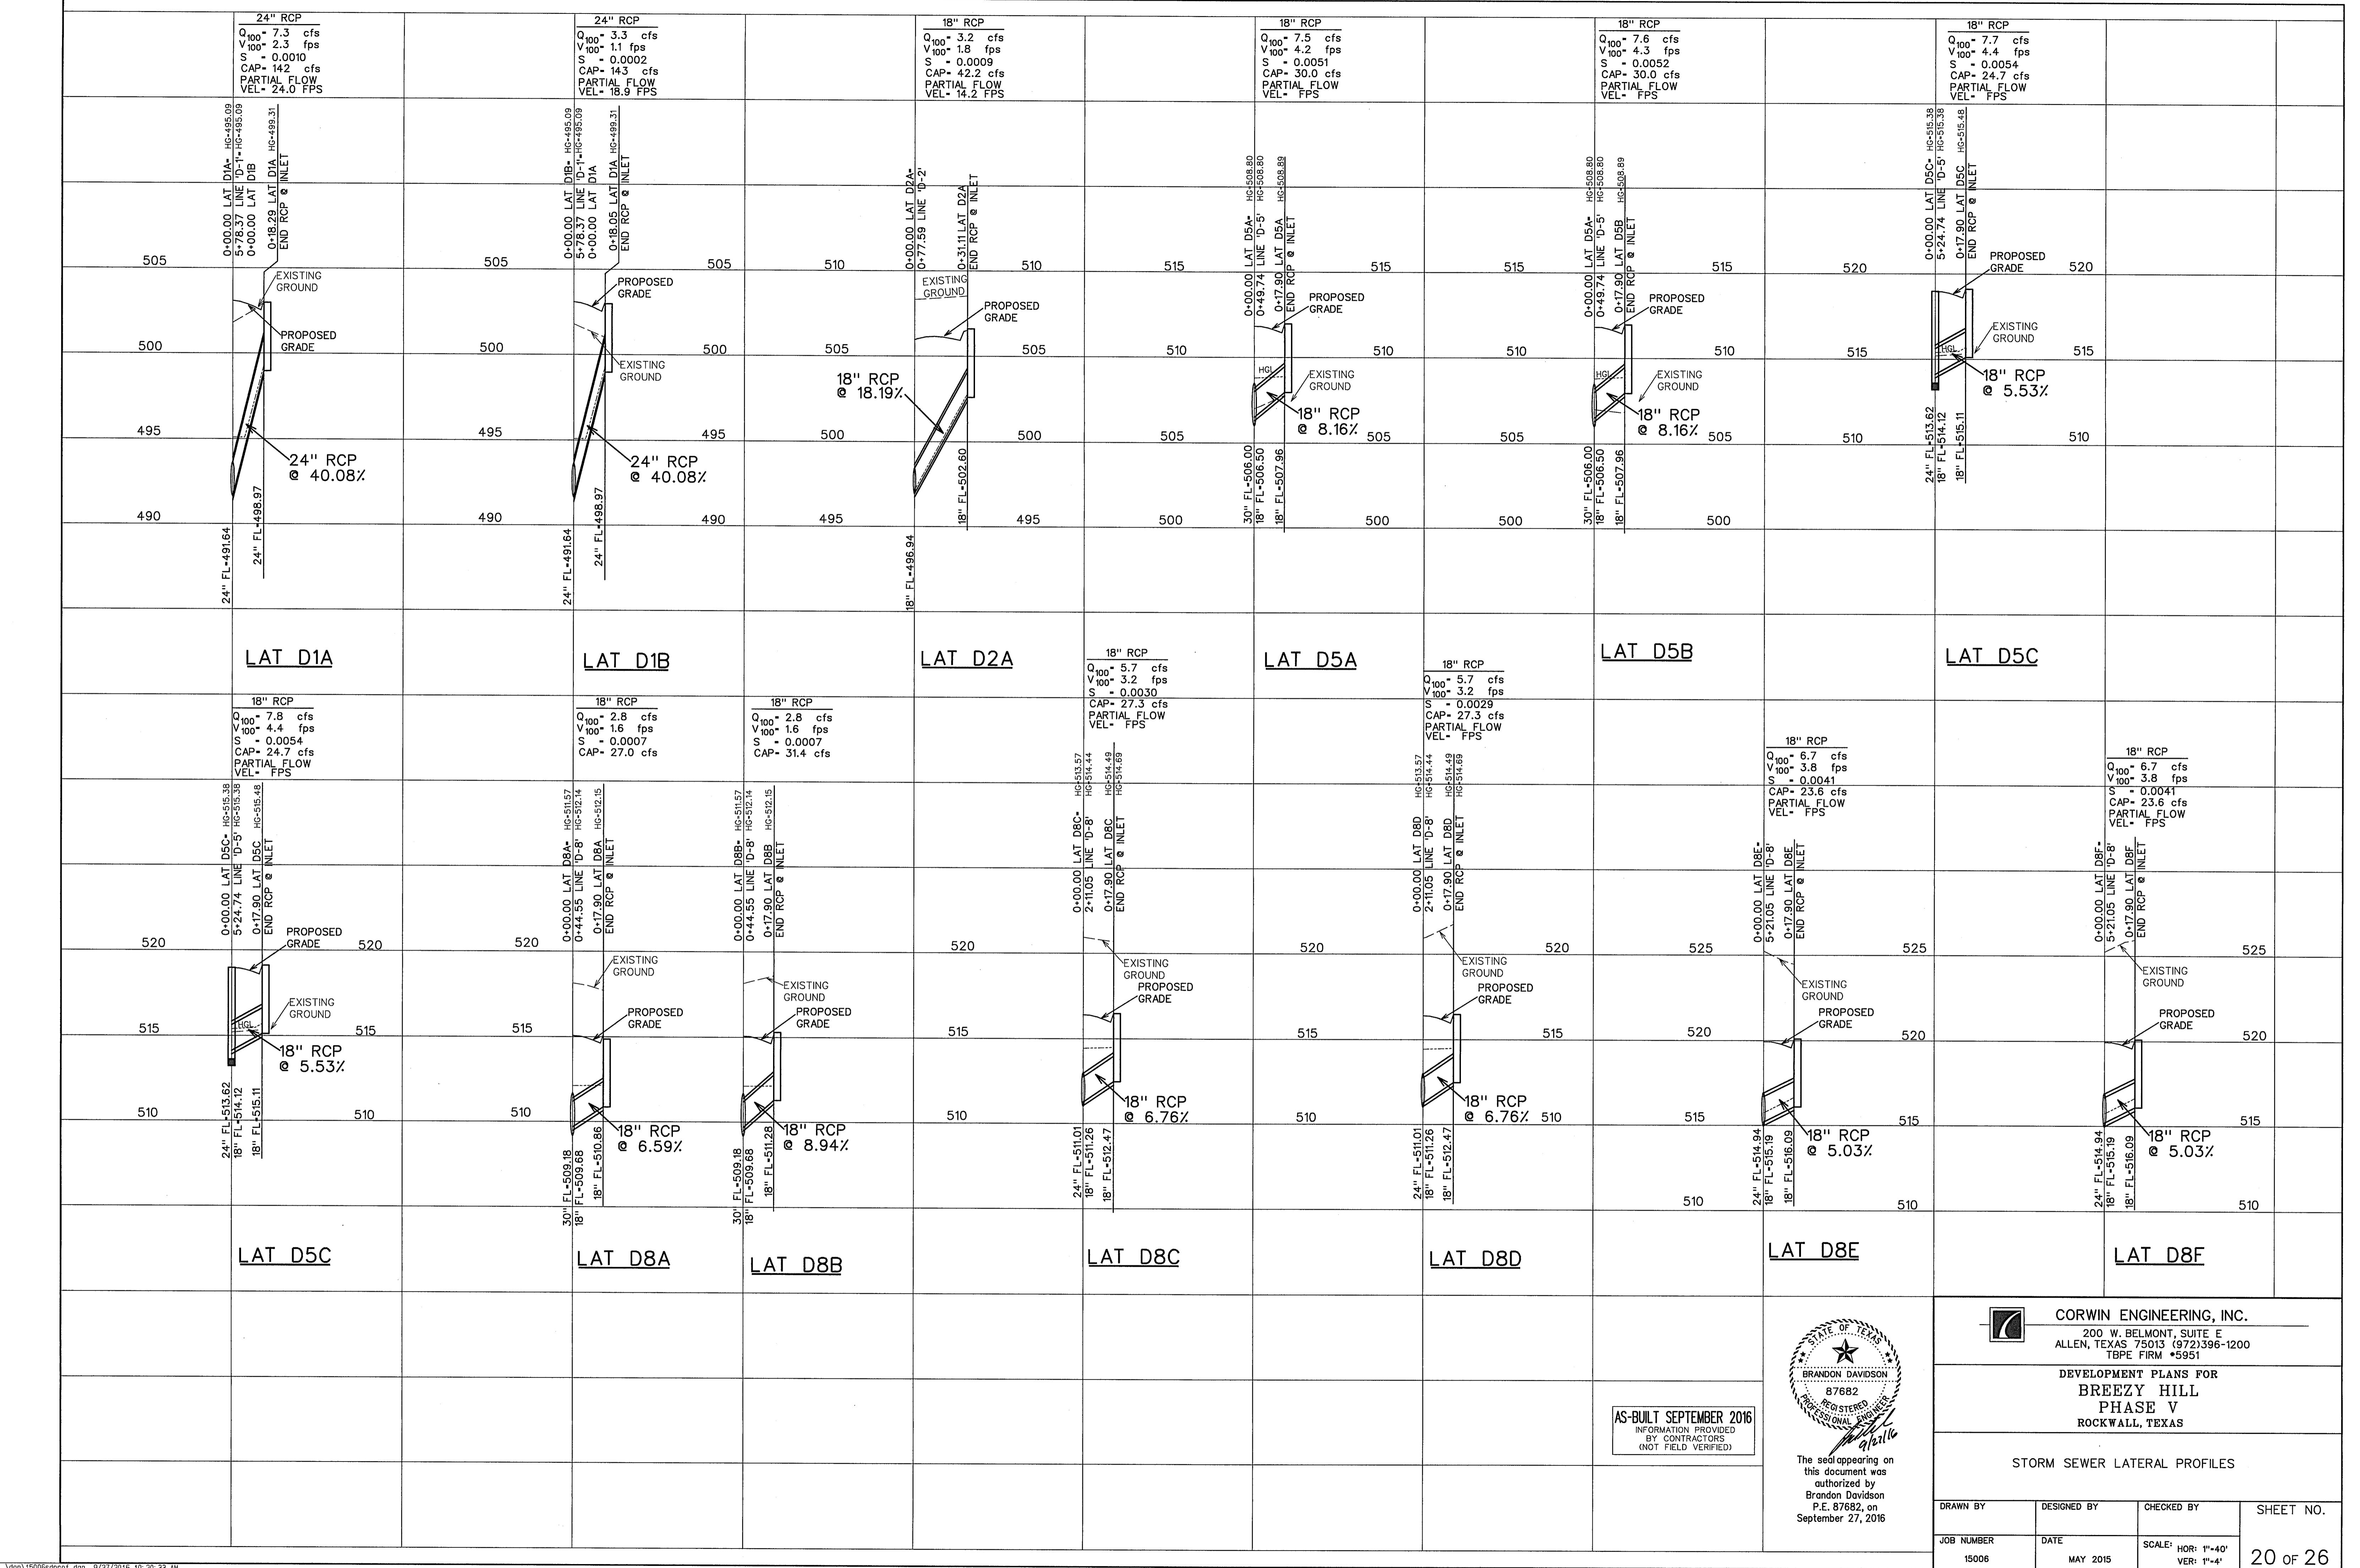



NOTE:

RETAINING WALLS 3' IN HEIGHT AND OVER
NEED AN ENGINEERED SEALED PLAN.
(PLANS TO BE SUBMITTED PRIOR
TO ENGINEERING APPROVAL)

Note:

Each lot will need a detailed grading plan
with building permit submittal. This is a
general grading plan for site work only.

SCALE: 1" - 50'

LEGEND

SPOT ELEVATION 706.2
EXIST. CONTOUR — 700 —
PROP. CONTOUR — 704 —
RETAINING WALL - - - - -

BENCHMARK:

" X " Cut on top of curb on east side of John King Blvd.
approx. 48' north of the centerline of Pleasant View Dr.


ELEVATION = 505.61

NOTES:

1. Finish Floor Elevation to be 0.70 Feet above Finished Pad.(FP)
2. Additional Erosion Control to be installed in Parkways as determined by the City Inspector.
3. Finished Pad Elevations are within ± 0.3 Feet.
4. All fill compacted to min 95% std. density using sheep's foot roller.
5. All portions of the wall to be on one lot. Do not install on property line

AS-BUILT SEPTEMBER 2016
INFORMATION PROVIDED
BY CONTRACTORS
(NOT FIELD VERIFIED)



The seal appearing on
this document was
authorized by
Warren L. Corwin,
P.E. 57875, on
September 27, 2016

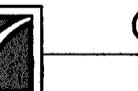 CORWIN ENGINEERING, INC.
200 W. BELMONT, SUITE E
ALLEN, TEXAS 75013 (972)396-1200
TBPE FIRM •5951

DEVELOPMENT PLANS FOR
BREEZY HILL
PHASE V
ROCKWALL, TEXAS


GRADING PLAN

DRAWN BY	DESIGNED BY	CHECKED BY	SHEET NO.
JOB NUMBER 15006	DATE MAY 2015	SCALE: HOR: 1"=40' VER: 1"=4'	

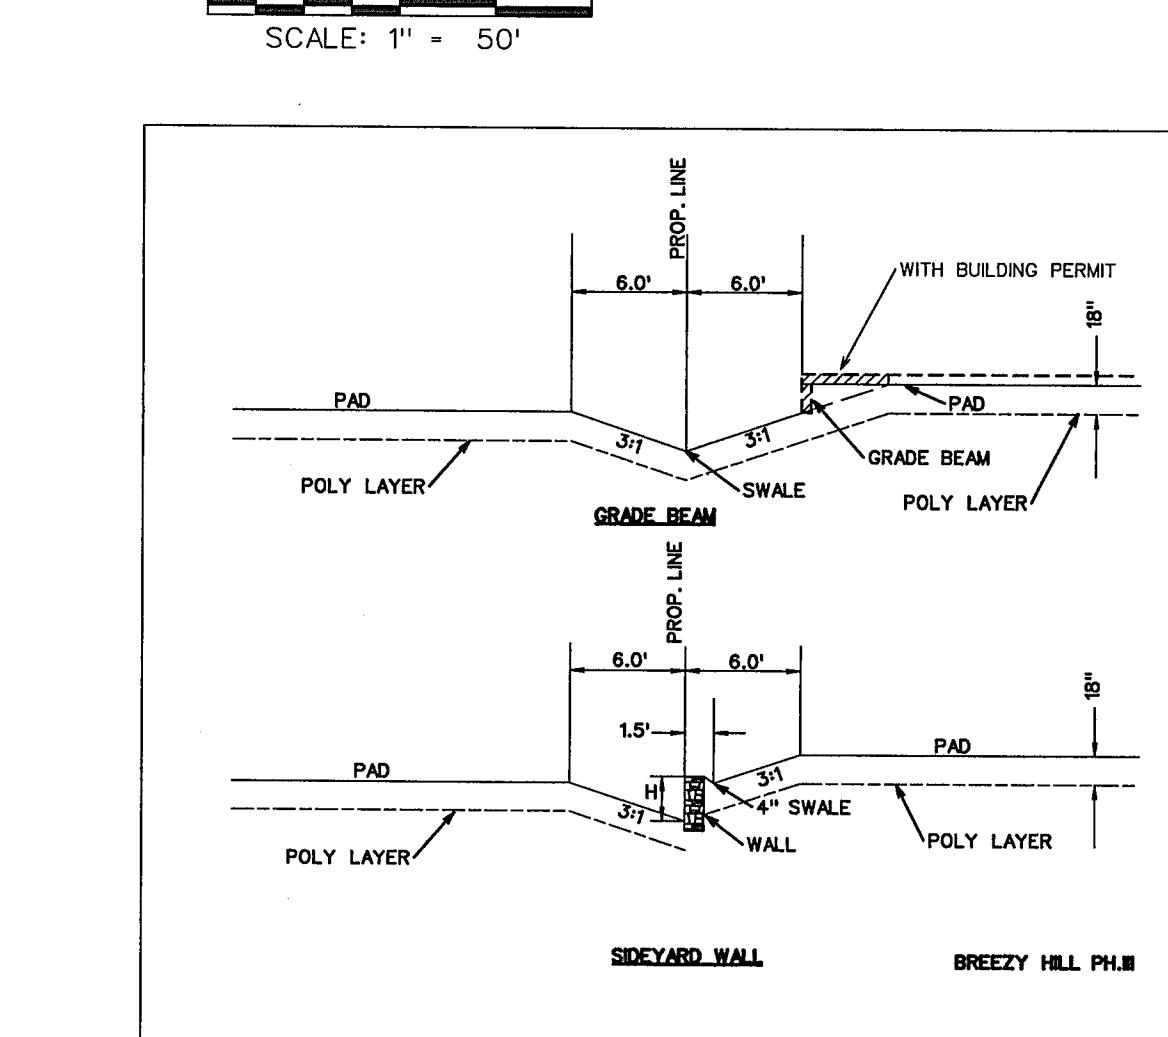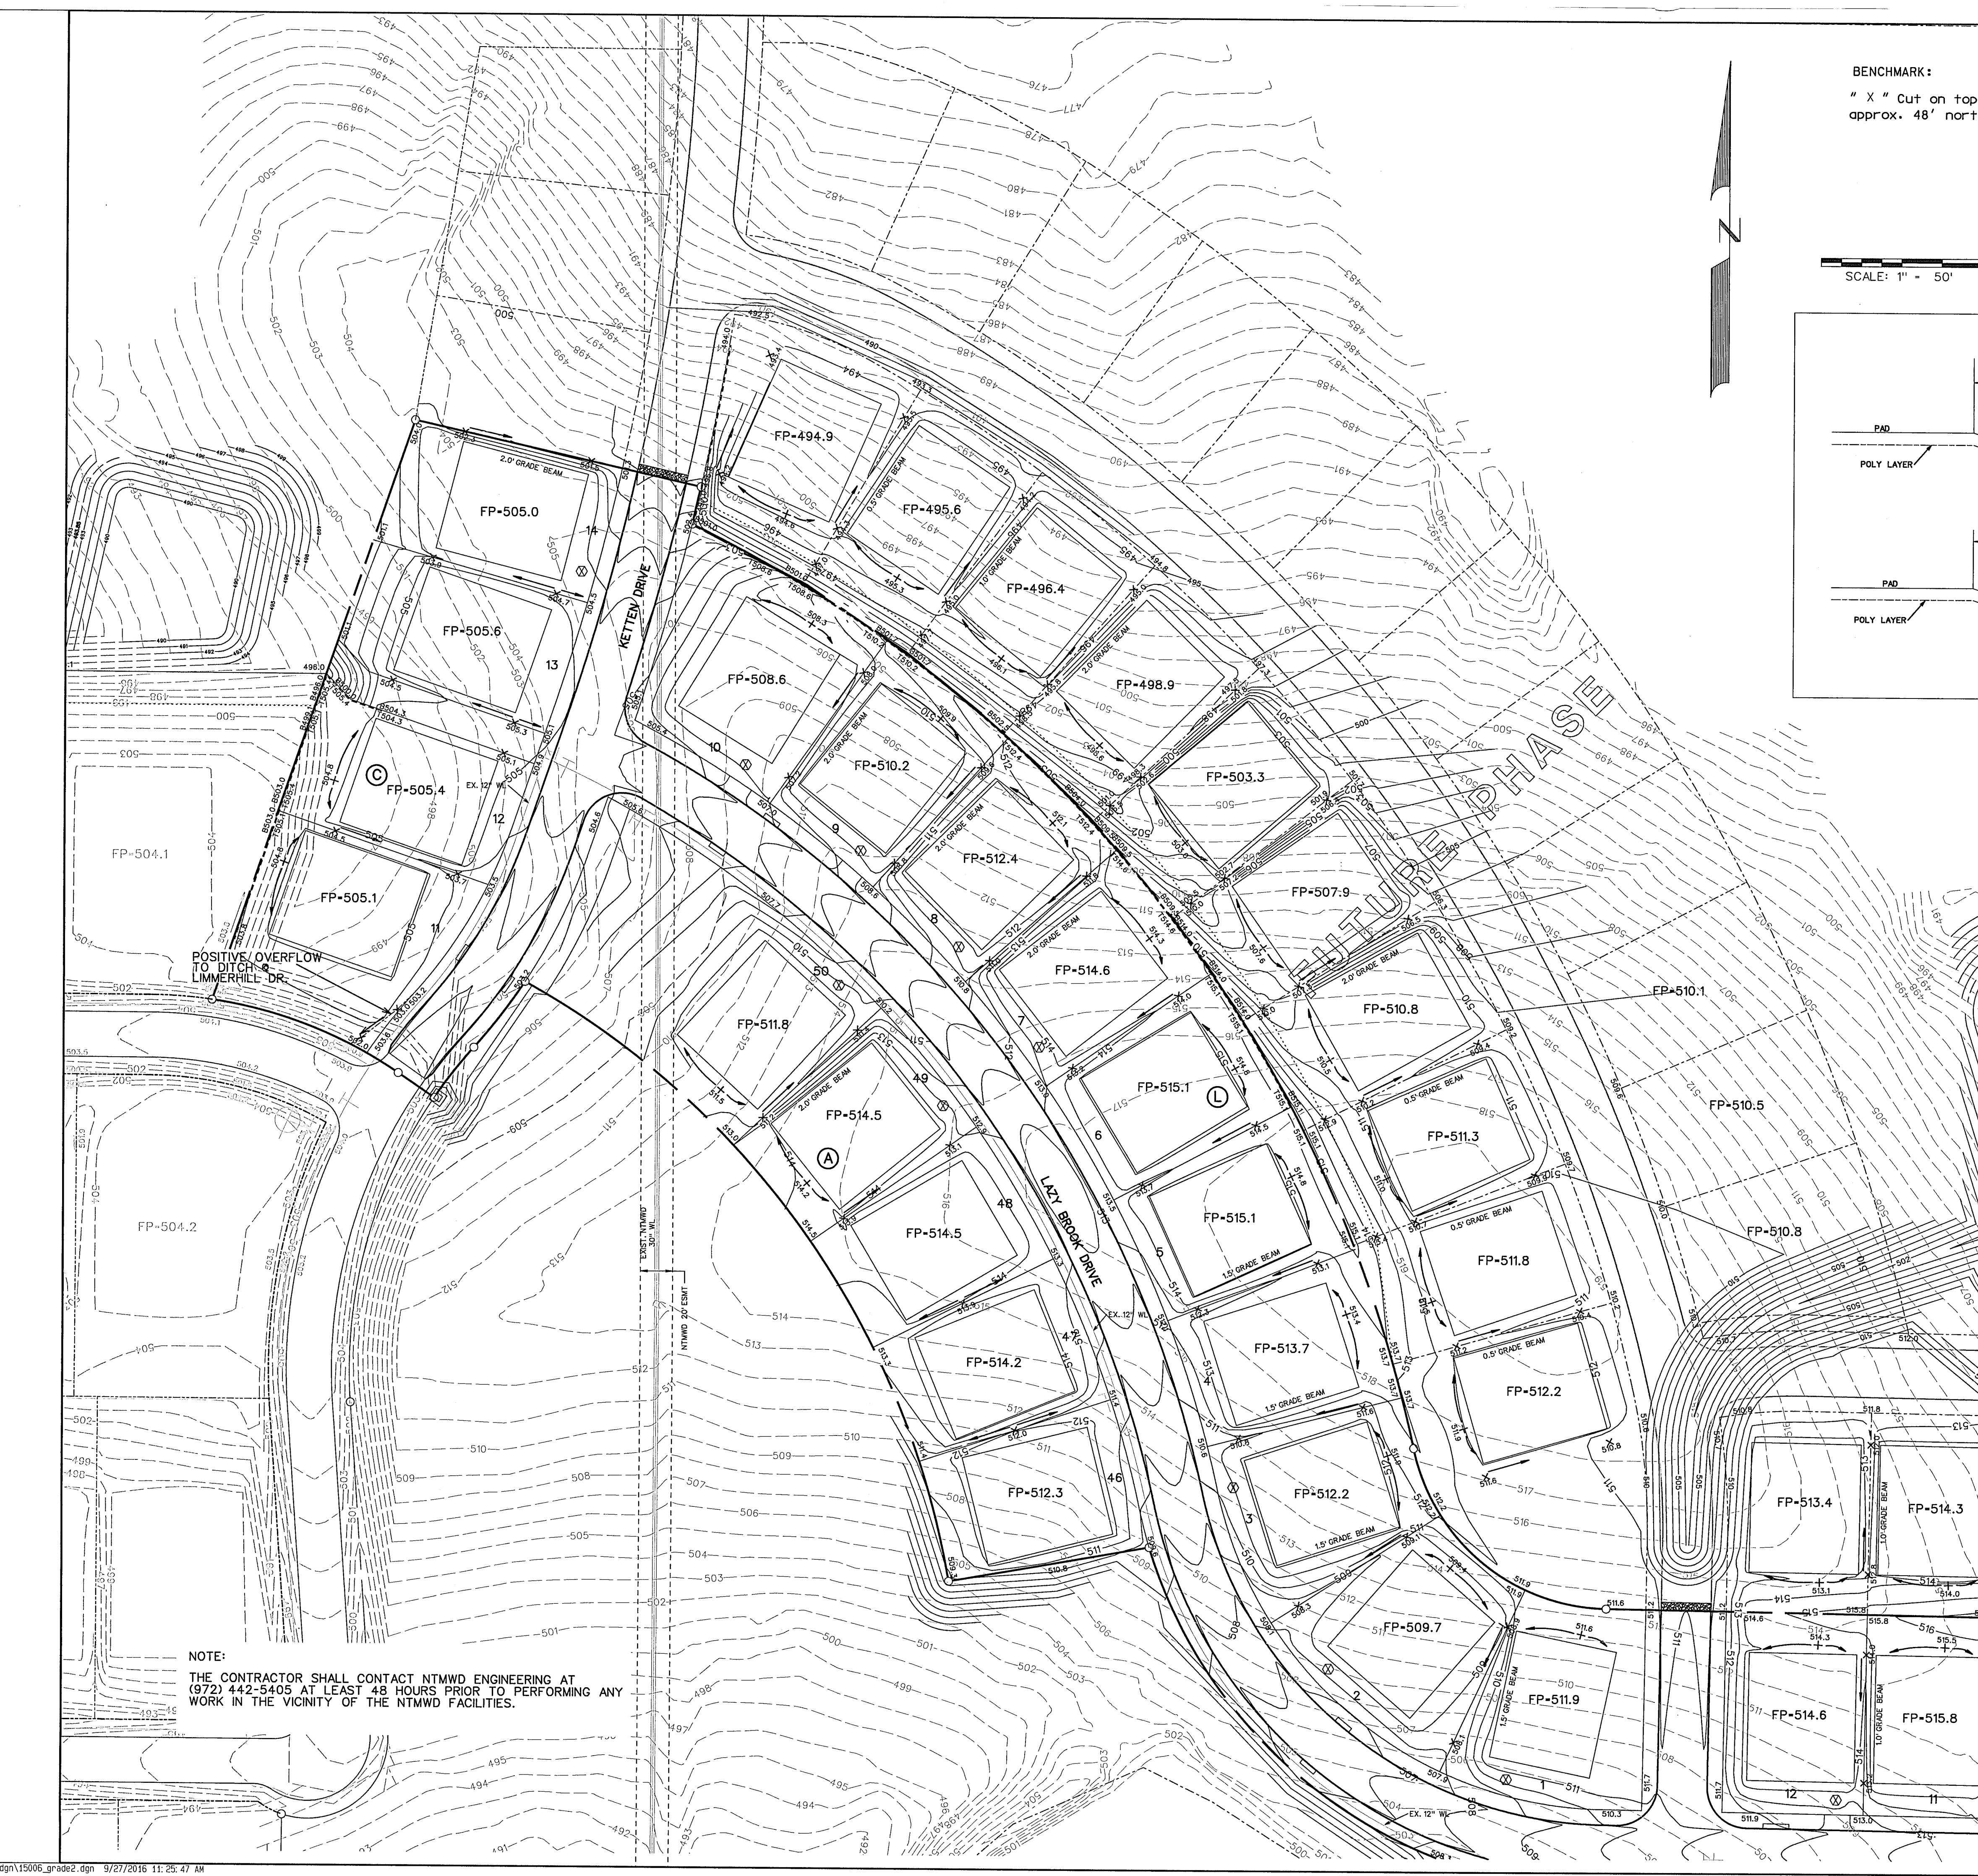

NOTE:
RETAINING WALLS 3' IN HEIGHT AND OVER
NEED A ENGINEERED SEALED PLAN.
(PLANS TO BE SUBMITTED PRIOR
TO ENGINEERING APPROVAL)

Note:
Each lot will need a detailed grading plan
with building permit submittal. This is a
general grading plan for site work only.




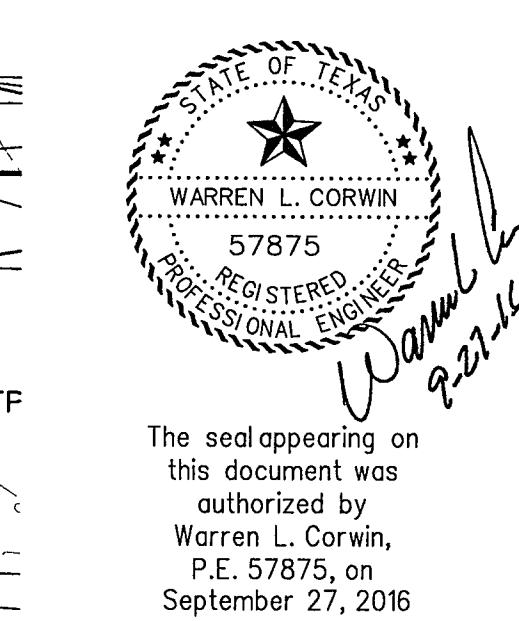


The seal appearing on this document was authorized by Warren L. Corwin, P.E. 57875, on September 27, 2016

CORWIN ENGINEERING, INC.		
200 W. BELMONT, SUITE E		
ALLEN, TEXAS 75013 (972) 396-1200		
TBPE FIRM •5951		
DEVELOPMENT PLANS FOR		
BREEZY HILL		
PHASE V		
ROCKWALL, TEXAS		
GRADING PLAN		
DRAWN BY	DESIGNED BY	CHECKED BY
JOB NUMBER	DATE	SCALE: HOR: 1"-40' VER: 1"-4"


CONSTRUCTION SEQUENCE

1. GRADING CONTRACTOR TO INSTALL TEMPORARY STABILIZED ENTRANCE.
2. INSTALL SILT FENCE AS SHOWN, (TS-600 POLY FELT) PER C.O.G. SPECIFICATIONS.
3. CONSTRUCT SEDIMENT BASIN
4. PERFORM GRADING AND UTILITY CONSTRUCTION.
5. AFTER THE INLET BOTTOMS ARE CONSTRUCTED, THE INLETS SHALL BE FILLED WITH STONE AND COVERED WITH A FILTER FABRIC (TS-600 POLY FELT OR EQUIVALENT) BY UTILITY CONTRACTOR.
6. PRIOR TO CITY RELEASING PAVING, SOD OR SEEDED CURBEX SHALL BE INSTALLED ON SIDES AND BOTTOM OF ALL DETENTION PONDS AND ALL DETENTION PONDS MUST BE FUNCTIONING.
7. AFTER PAVING AND COMPLETION OF INLETS, INLET FILTERS SHALL BE INSTALLED IN ALL INLETS AND MAINTAINED UNTIL RE-VEGETATION HAS BEEN COMPLETED BY PAVING CONTRACTOR.
8. SILT FENCE SHALL REMAIN IN PLACE UNTIL RE-VEGETATION HAS BEEN COMPLETED.
9. PAVING CONTRACTOR SHALL REMOVE TEMPORARY STABILIZED ENTRANCE.
10. PRIOR TO CITY ACCEPTANCE THE PAVING CONTRACTOR SHALL BE RESPONSIBLE FOR REMOVING ANY MUD OR SILT WHICH COLLECTS ON THE EXISTING AND NEW PAVEMENT AND INSTALLING SILT FENCE AT BACK OF CURB THROUGHOUT THE ENTIRE SITE.
11. 75%-80% OF ALL DISTurbed AREA TO HAVE A MINIMUM 1" STAND OF GRASS PRIOR TO ENGINEERING ACCEPTANCE.
12. AT TIME OF ACCEPTANCE, ALL INLET PROTECTION IS TO BE REMOVED.

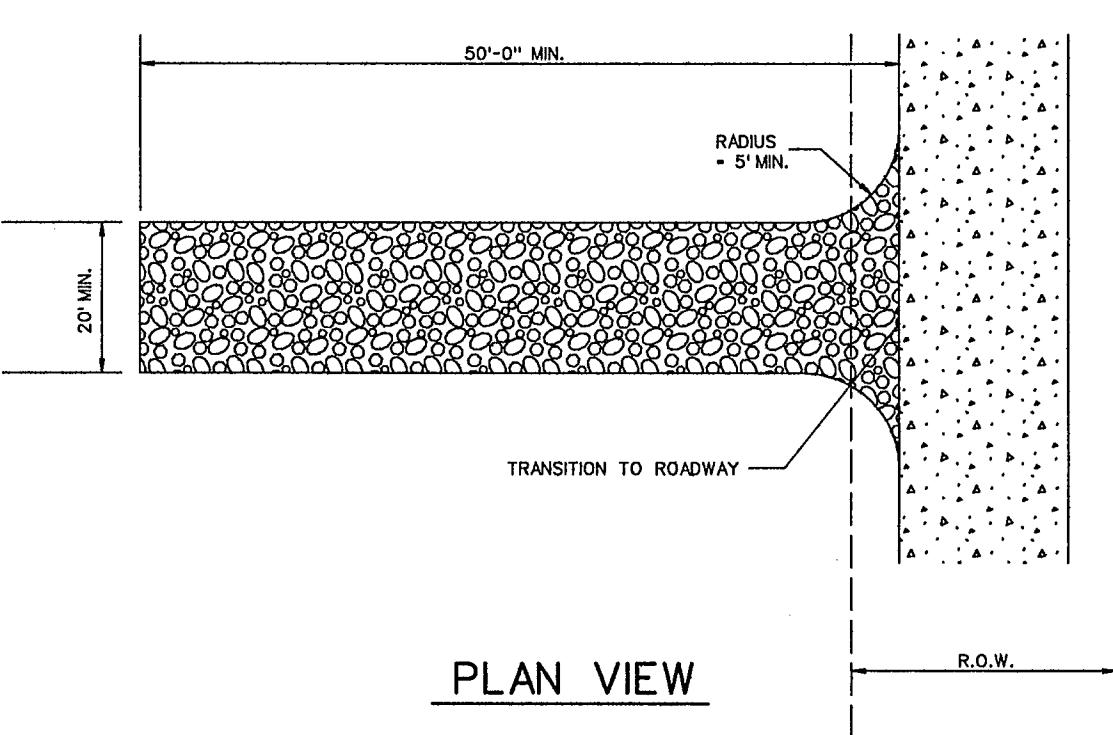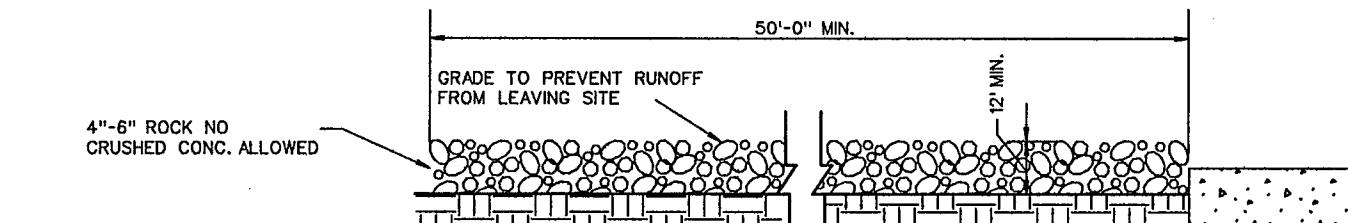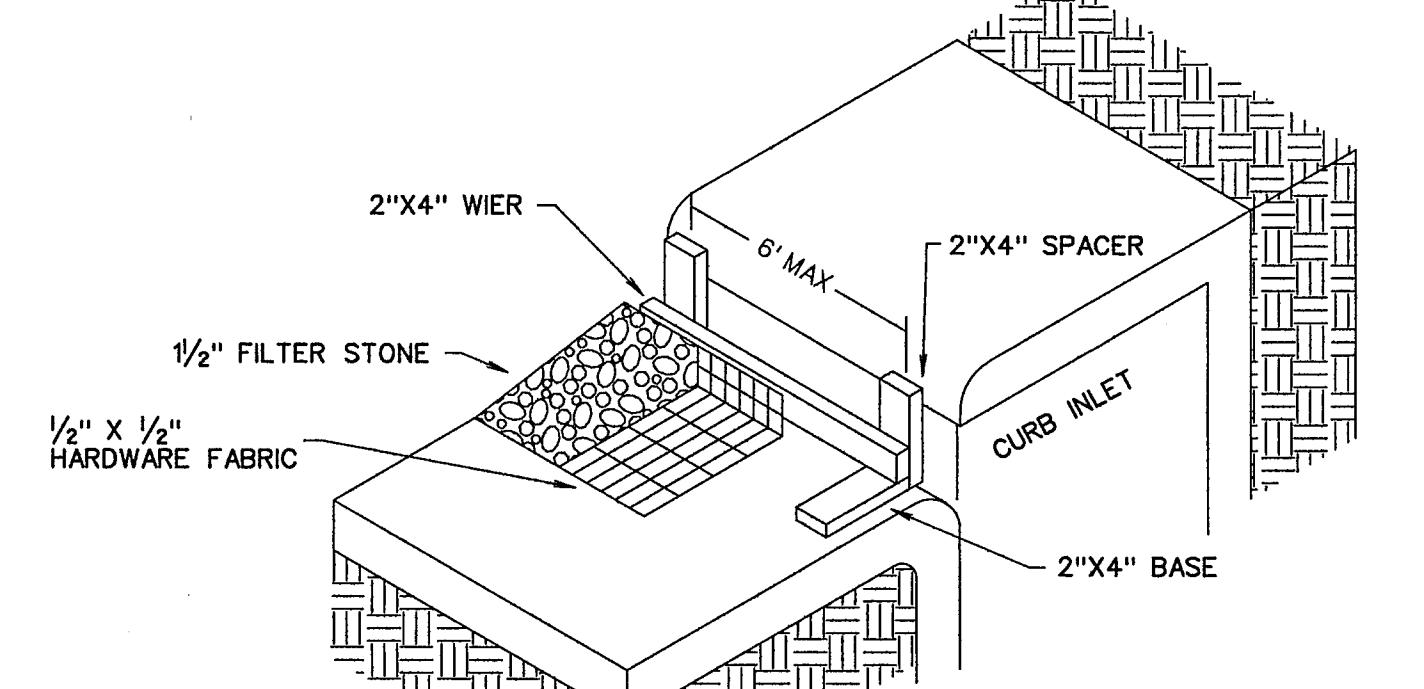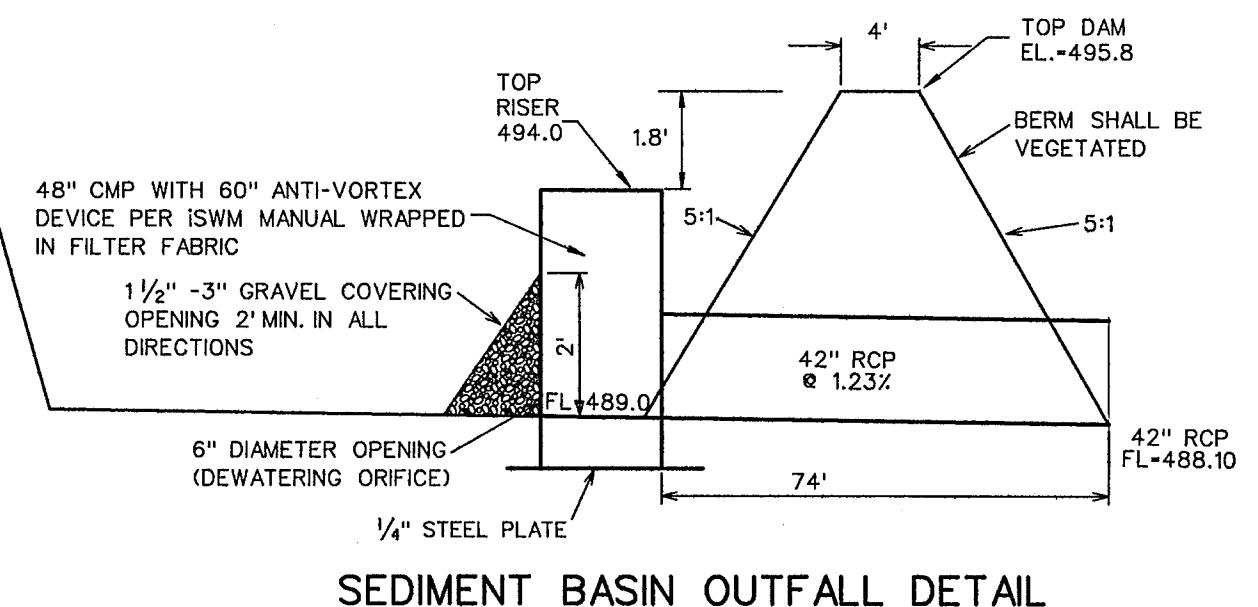

STABILIZED ENTRANCE DETAIL

SCALE: 1" - 100"

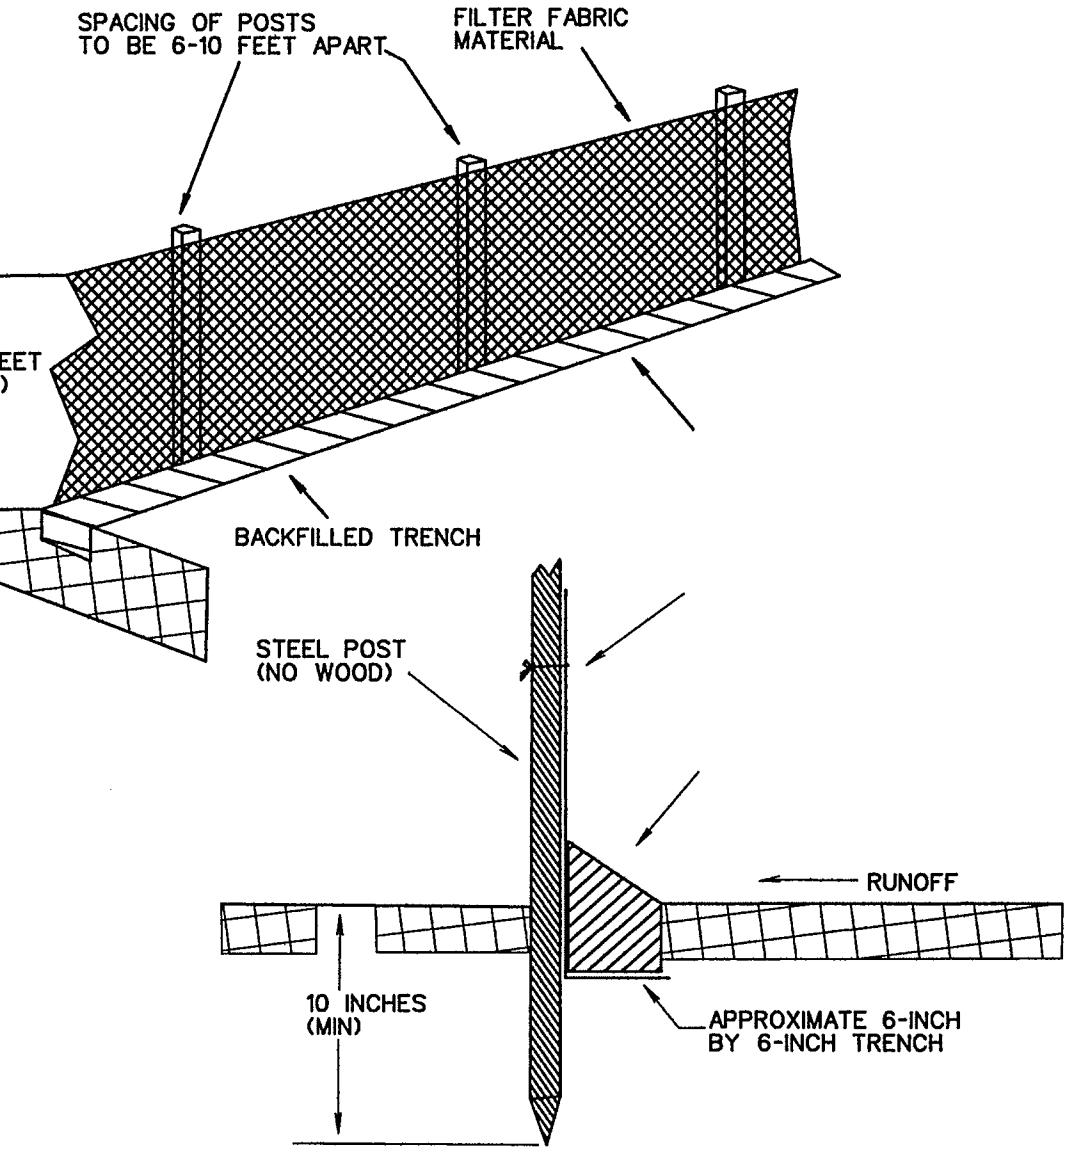

AREA DISTURBED 36.7 AC


DISTURBED AREA BY BASIN:

BASIN EX1 - 6.6 ACRES - NO SEDIMENT BASIN REQUIRED
BASIN EX2 - 5.2 ACRES - NO SEDIMENT BASIN REQUIRED
BASIN EX3 - 20.7 ACRES - SEDIMENT BASIN REQUIRED
BASIN EX4 - 4.2 ACRES - NO SEDIMENT BASIN REQUIRED

LEGEND

SILT FENCE (BEFORE CONSTRUCTION)

INLET PROTECTION

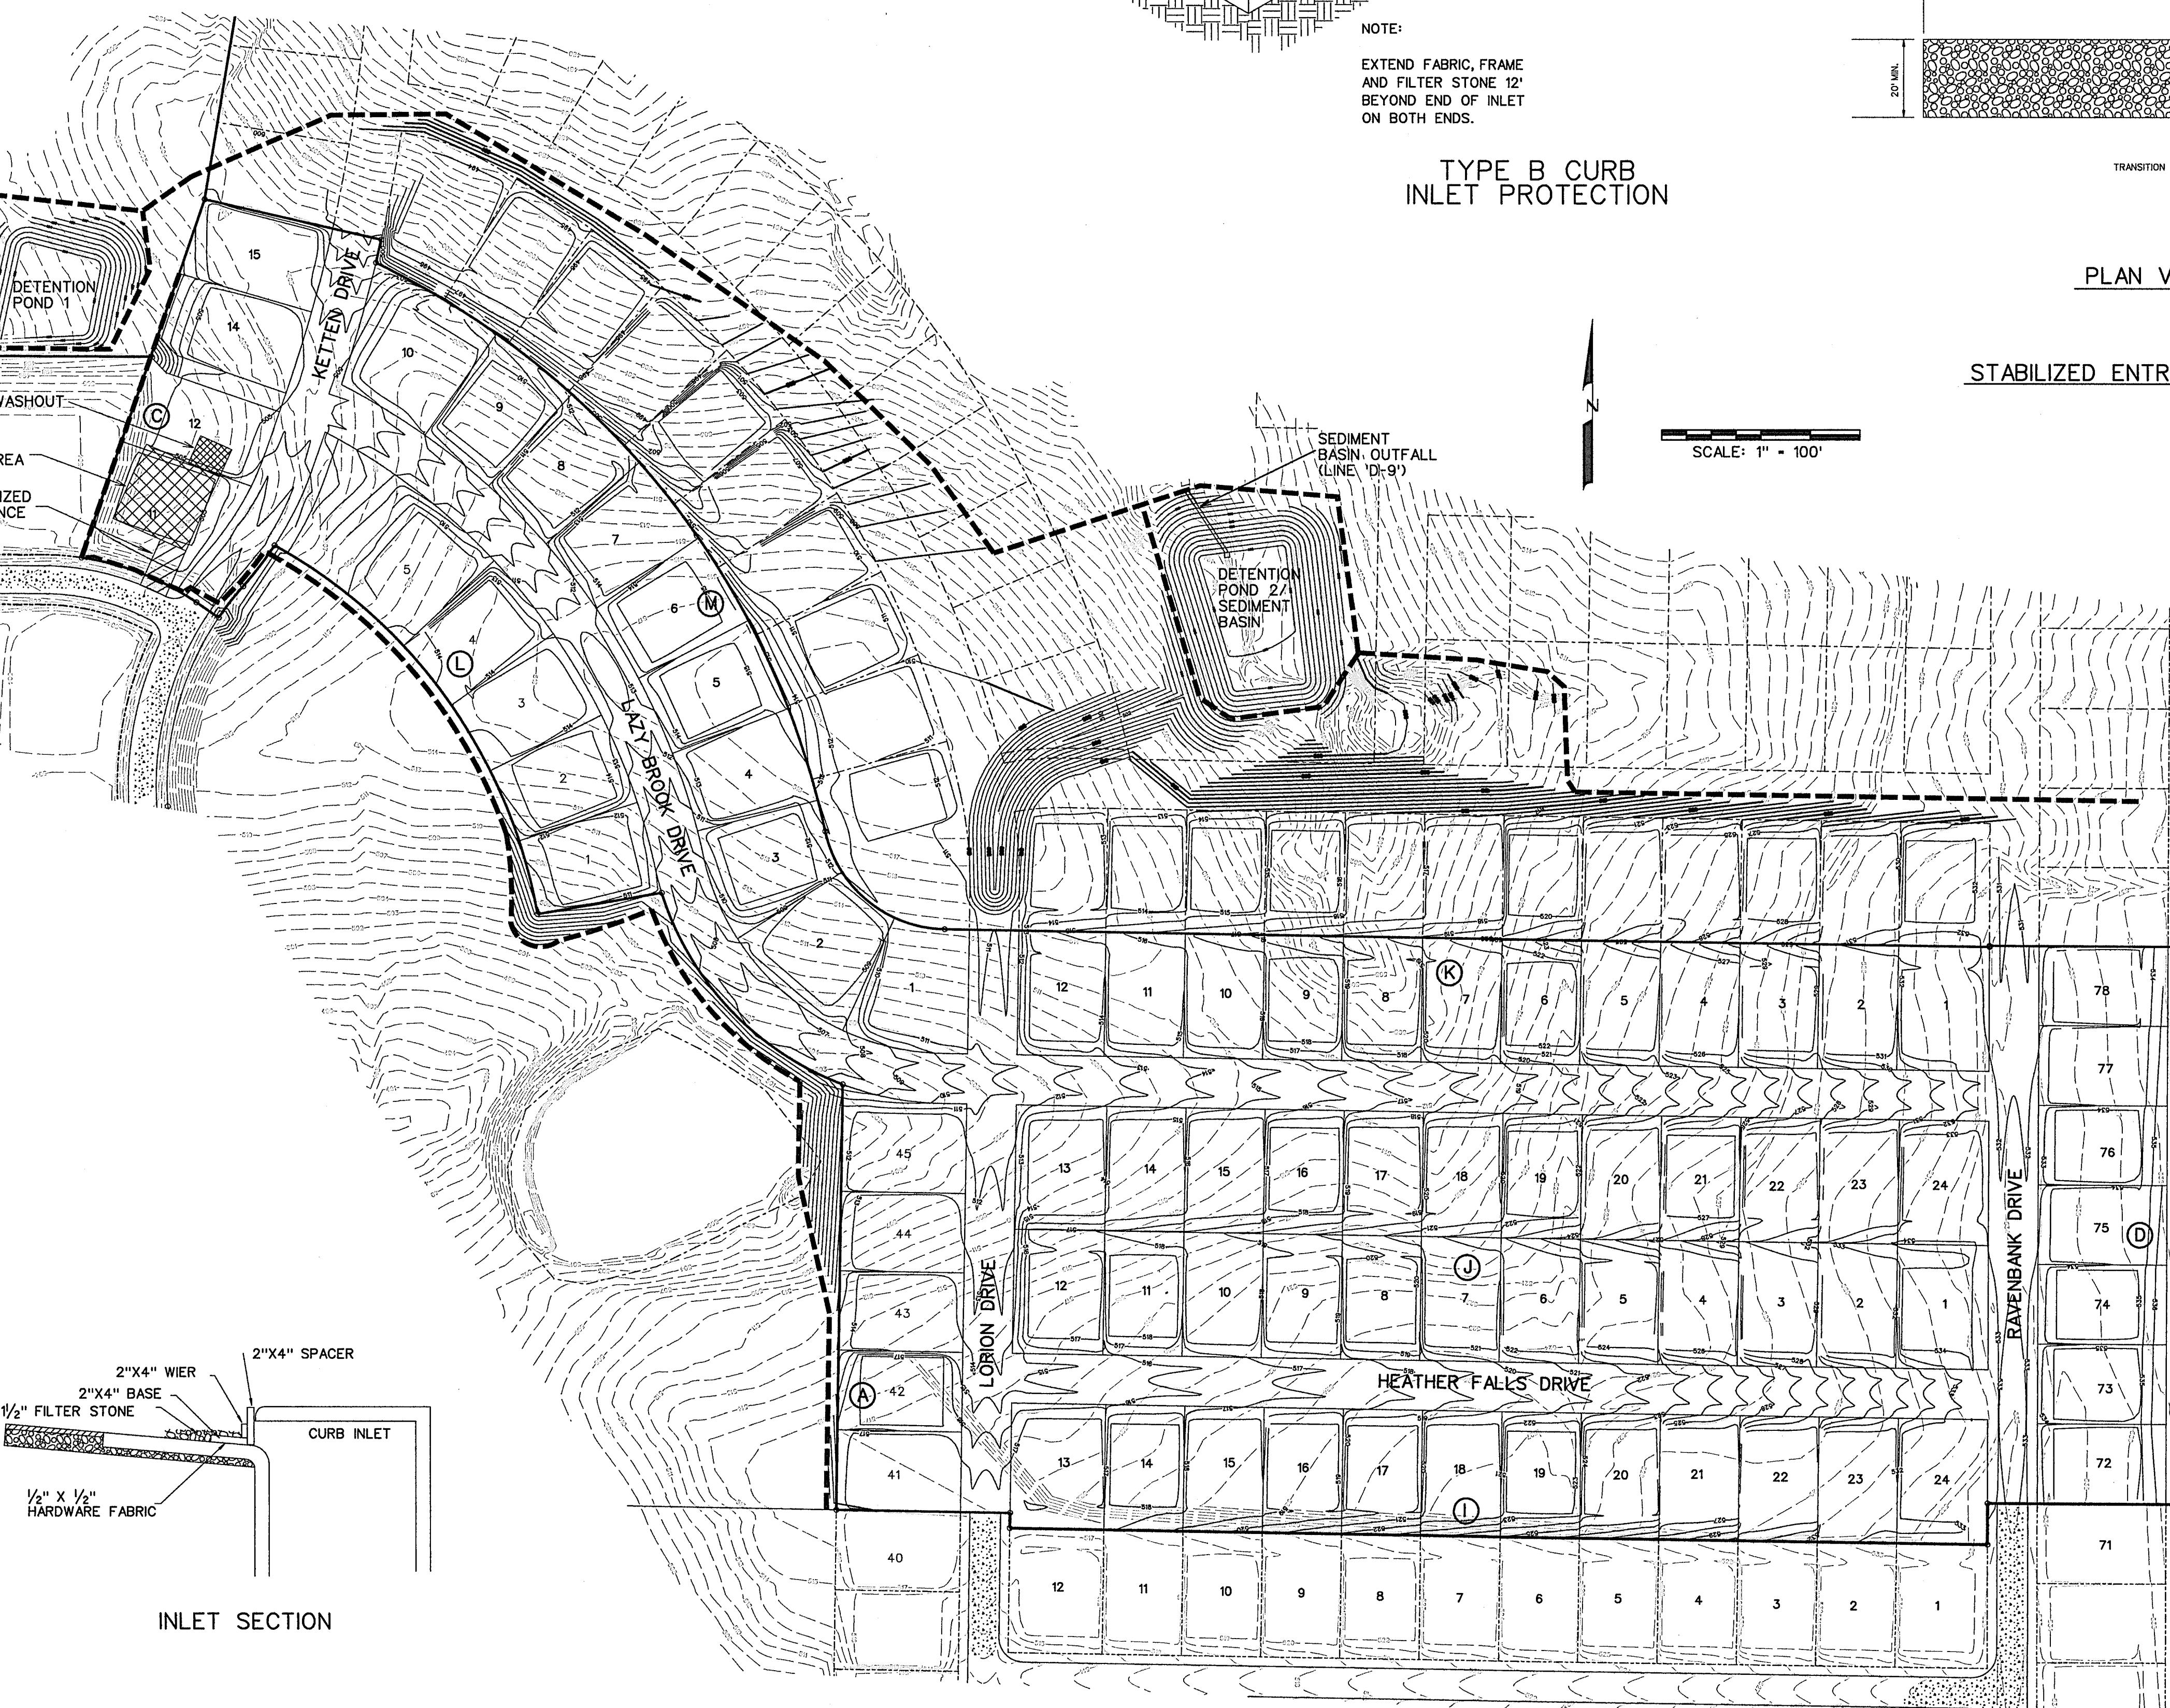


CORWIN ENGINEERING, INC. 200 W. BELMONT, SUITE E ALLEN, TEXAS 75013 (972)396-1200 TBE FIRM •5951			
DEVELOPMENT PLANS FOR BREEZY HILL PHASE V ROCKWALL, TEXAS			
EROSION CONTROL PLAN			

DRAWN BY	DESIGNED BY	CHECKED BY	SHEET NO.
JOB NUMBER	DATE	SCALE:	1"-100'
15006	MAY 2015		25 OF 26

PLANT SCHEDULE					
SYM	BOTANICAL NAME	COMMON NAME	QUANTITY	SIZE	NOTES
Trees					
BC	Taxodium distichum	Bald Cypress	6 EA.	3" cal, 12' Ht min, 6' Spread min.	B. & B., Single trunk, Well branched with Central Leader, 4' branching height
RB	Cercis canadensis 'Texana'	Texas Redbud	6 EA.	6' Ht Min, 3' Spread Min.	B. & B., Single trunk, Well branched with Central Leader, Speciman
Misc					
BG	Cynodon dactylon	Bermuda Grass	23,720 Sq. Ft.	Solid Sod	Staggered tight joints, sand filled and rolled


PLANTING NOTES:

- Submit a construction schedule of work to be approved by Landscape Architect and Owner. Failure to submit schedule may result in Landscape Architect stopping construction until submitted. No extensions of time will be considered for failure to promptly submit schedule.
- Notify Landscape Architect 48 hours in advance of commencement of work to coordinate project inspection schedules.
- Locate existing underground utilities and obstructions prior to commencing work. Repair damage to utilities resulting from the installation of the work at no additional cost to Owner.
- Notify Landscape Architect immediately upon encountering any unknown obstructions, grade differences or conditions not indicated on drawings. Make necessary revisions as required to conform to plans and specifications due to failure to give such notification.
- Coordinate with other trades and subcontractors as required to accomplish the planting operation.
- Plant material shall be tagged or approved at site by Landscape Architect prior to installation. Install plant material free of pest and diseases. Guaranteed plant material for a period of 365 calendar days from date of issuance of final acceptance by Landscape Architect.
- Layout proposed planting beds and receive Landscape Architect's approval prior to installation. Notify Landscape Architect of layout conflicts. Failure to notify Landscape Architect will result in Contractor's liability to relocate materials at no additional expense to Owner.
- Excavate bed areas to a depth of 4 inches, backfill with 4 inches of Acid Gro Complete mix as manufactured by Soil Building Systems and rototill to a depth of 12 inches producing a homogeneous mixture.
- Final locations of plant material shall be subject to approval by Landscape Architect. Install groundcover 12 inches from the edge of shrubs and tree root balls and 4 inches from edge of paving, walls and other structures.
- Backfill tree and shrub pits with one part compost as manufactured by Soil Building Systems and two parts existing soil.
- Stake tree locations and acquire written approval from Landscape Architect prior to installation of irrigation system. Do not locate tree(s) within 10 feet of any irrigation rotary spray head. Install tree(s) in areas covered by irrigation system. Provide supplemental watering as required until final acceptance by Landscape Architect. Locate tree(s) 4 feet minimum from walls, headers, property lines and other trees within project. Notify Landscape Architect of location conflicts for resolution. Failure to notify Landscape Architect will result in Contractor's liability to relocate trees at no additional expense to Owner.
- Stake tree(s) immediately upon installation and within same day as planted.
- Mulch planting beds and tree pits with shredded hardwood mulch.
- Provide full service maintenance of landscape within project scope for a period of four (4) months, 120 calendar days, from date of issuance of final acceptance by Landscape Architect. Failure to properly maintain landscape and irrigation system will result in extending the guarantee and maintenance period at no additional expense to Owner.
- All landscape areas to be watered by an automatic landscape irrigation system.

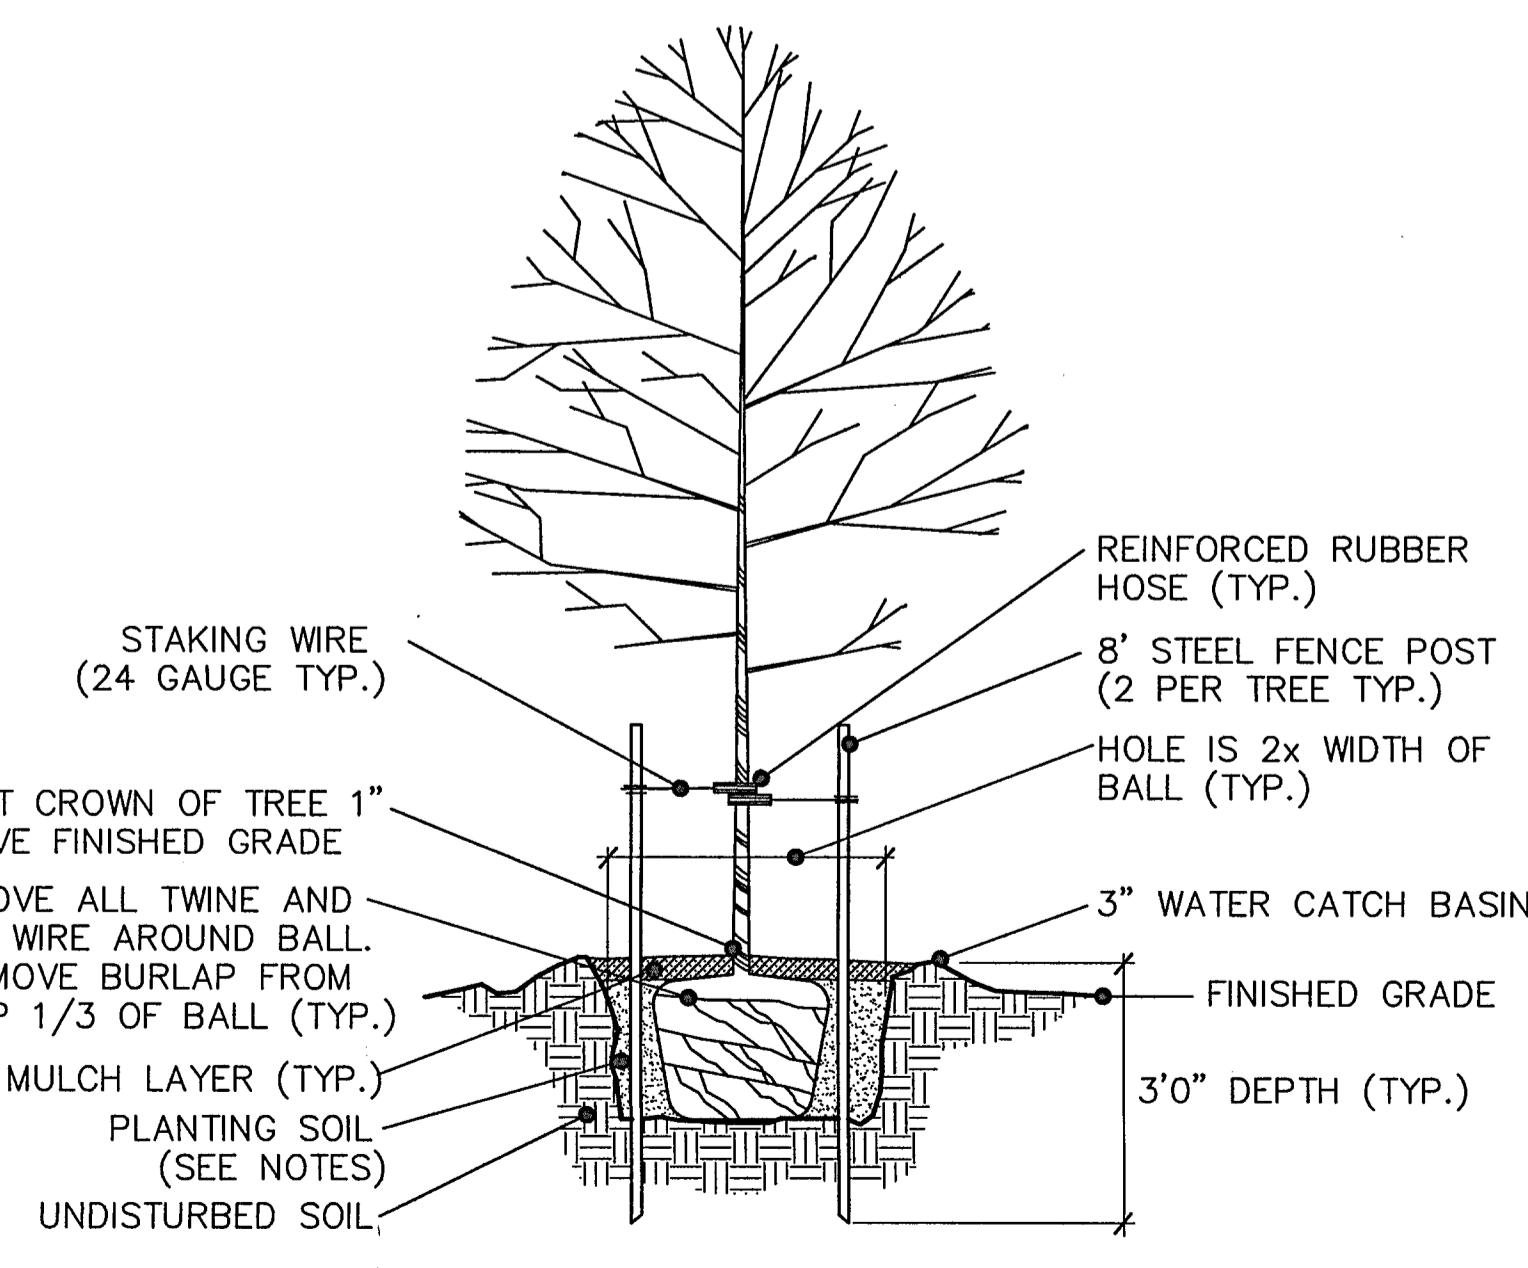

2 TREE PLANTING

SCALE: NONE

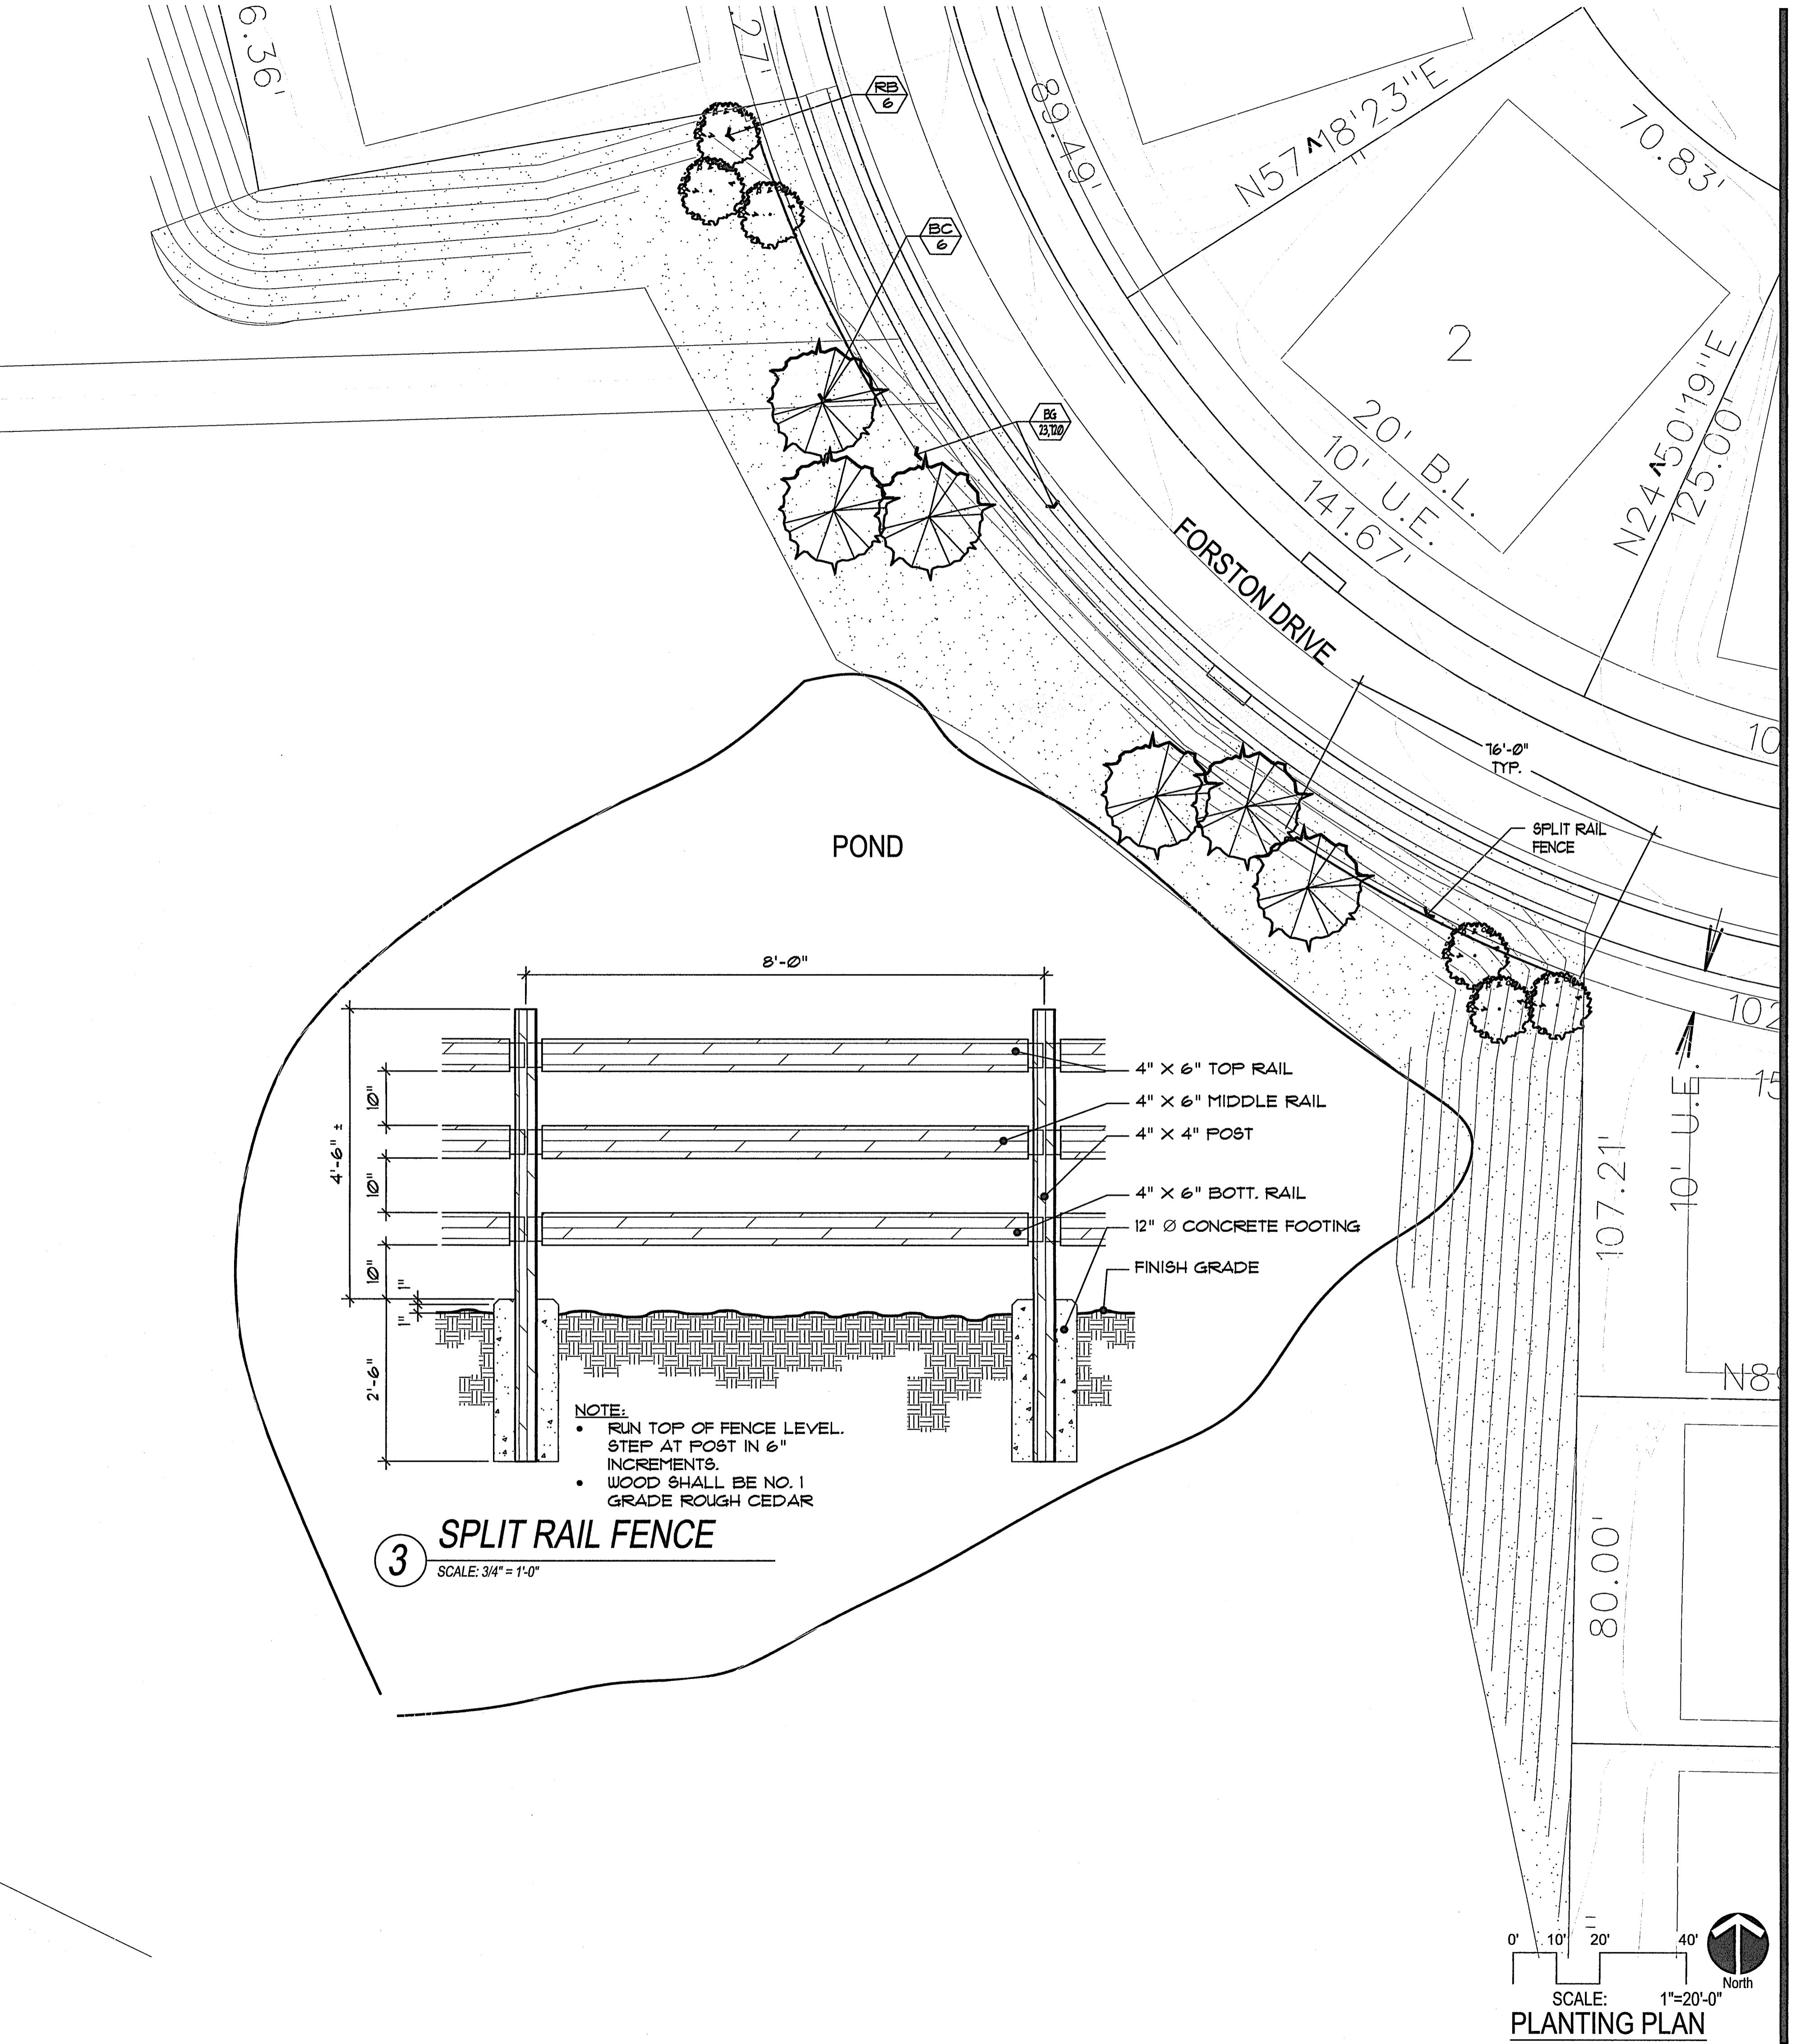

PROJECT NAME: Breezy Hill Phase V Rockwall, Texas
 LANDSCAPE ARCHITECT: RICKY D. PETTY
 PHONE: (214) 543-5265 e-mail: rdpetty@xr.com
 TITLE: Planting Plan DATE: September 16, 2016 SCALE: 1" = 20'-0" SHEET: PLANTING PLAN
 L1-1

Breezy Hill
Phase V
Rockwall, Texas

PROJECT NAME: Breezy Hill PH V
PROJECT NUMBER: 16-070
REVISIONS

IRRIGATION LEGEND and SCHEDULE

SYM	DESCRIPTION	MANUFACTURER	MODEL	SIZE / NOZZLE	NOTES
C	Automatic Controller	Hunter	XC HYBRID	Refer to Plan for Size	Pedestal mount with Wireless Solar Sync Sensor
+○	Master Valve (w/ Pressure Regulator)	Hunter	PGV w/ AS-10 & 483000 DC Latching Solenoid	Refer to Plan for Size	Install per detail in 10" diameter valve box w/ snap on lid. Rout and paint valve number on lid.
+○	Remote Control Valve	Hunter	PGV w/ 483000 DC Latching Solenoid	Refer to Plan for Size	Install per detail in 10" diameter valve box w/ snap on lid. Rout and paint valve number on lid.
+○ D	Drip Zone Valve Kit	Hunter	ICZ-101 w/ 483000 DC Latching Solenoid	Refer to Plan for Size	Install per detail in 10" diameter valve box w/ snap on lid. Rout and paint valve number on lid.
●	Rotary Spray Head Small Part - Circle	Hunter	FGP	*4 Nozzle	Install per detail with 40 FSL at base of head
+	Rotary Spray Head Small Full - Circle	Hunter	FGP	*1 Nozzle	Install per detail with 40 FSL at base of head
■	Water Meter	---	per City	Refer to Plan for Size	Installed by General Contractor
■	Wye Strainer	Febco	4305	Line Size	Install 10" RD valve box. Ref Backflow Connection Detail.
■	Ball Valve	Nibco	46608	Line Size	Install 10" RD valve box.
❖	Double Check Valve	Febco	850	Refer to Plan for Size	Furnish and install per local code by Licensed Irrigation Contractor
----	Irrigation Sleeve	---	Sch 40 w/ 12 ga. Full wire in sleeve	Refer to Plan for Size	Driveway sleeve(s) installed by General Contractor Sidewalk sleeves installed by Irrigation Contractor
—	Irrigation Main Line	---	Class 200	Refer to Plan for Size	18" installation depth
—	Irrigation Lateral Line	---	Class 200	Refer to Plan for Size	12" installation depth
—	Drip Tubing	Hunter	PLD-06	536"ID x 12" emitter spacing at 06 GPM	Install per details at 12 inches on center

← Program and Station number for Automatic Controller

← Valve size in inches

← Gallons per minute, per valve


IRRIGATION NOTES:

- Provide a complete, functioning automatic irrigation system including labor, materials, fees, taxes, equipment and other costs incidental to accomplishing work.
- Acquire written approval from Landscape Architect for material substitutes prior to commencing the installation.
- Locate existing underground utilities or obstacles prior to commencing installation. Repair damage to utilities or finishes resulting from work at no additional expense to Owner.
- Piping is diagrammatic. Adjust as required for existing utilities, obstructions, tree root balls, etc.
- Install work in accordance with applicable local codes and ordinances.
- Coordinate installation with landscape contractor and other trades.
- Locate each end of irrigation sleeves dimensionally on the Record "As-Built" Drawings.
- Contractor shall be responsible for damage to plant material due to system failure from inferior workmanship, during the installation of plants and maintenance period.
- Extend one extra control wire to farthest valve, routed parallel to common ground wire with installation of lead and common wires.
- Control wire shall be direct burial, 600 volt, single conductor, solid copper, plastic insulated cable, rated for direct burial applications, UF, U.L. approved, 14 gauge minimum lead and common ground return wire unless noted otherwise. Color of insulation as follows:
 - Lead Wire: any color (same color), except white or orange
 - Common Ground Wire: white (color)
 - Extra Control Wire: Orange (color)
- All P.V.C. pressure main line and lateral lines shall receive as follows:
 - 18" minimum cover for main lines
 - 12" minimum cover for lateral lines
- Make final electrical connection of controller per local electrical code. Provide all necessary fuse boxes, conduit, fittings, connectors or other electrical devices to make connection. Owner shall provide electrical service within 20 linear feet of controller location unless noted otherwise on drawings.
- Coordinate sleeve and conduit requirements with General Contractor.
- Connect remote sensors to controller with ground wire in series prior to connecting to remote control valves.
- Owner or Landscape Architect shall determine final controller location.

EQUIPMENT SHALL BE INSTALLED AS SPECIFIED. EQUIPMENT SUBSTITUTIONS WILL NOT BE ALLOWED.

HYDRAULIC CALCULATIONS

ITEM	SIZE	FSL	NOTES
Maximum GPM			Fitting Loss Accounted By Adding 10% To Flow Shown In Manuf. Nozzle Chart.
Estimated - 28 GPM		5.90	
Service	1"	5.90	TYPE K COPPER 25 LN. FT.
Water Meter	1"	4.60	
Ball Valve	1"	0.20	
Wye Strainer	1"	0.20	
Backflow Preventer	1"	6.00	
Master Valve	1&1/2"	3.00	
Main Line	2"	12.0	235 Ln. Ft.
Station Valve	1&1/2"	3.00	
Zone		5.00	
Head		40.00	
Total Loss		63.10	
Assumed Static Pressure		10.00	
Pressure Differential		0.90	

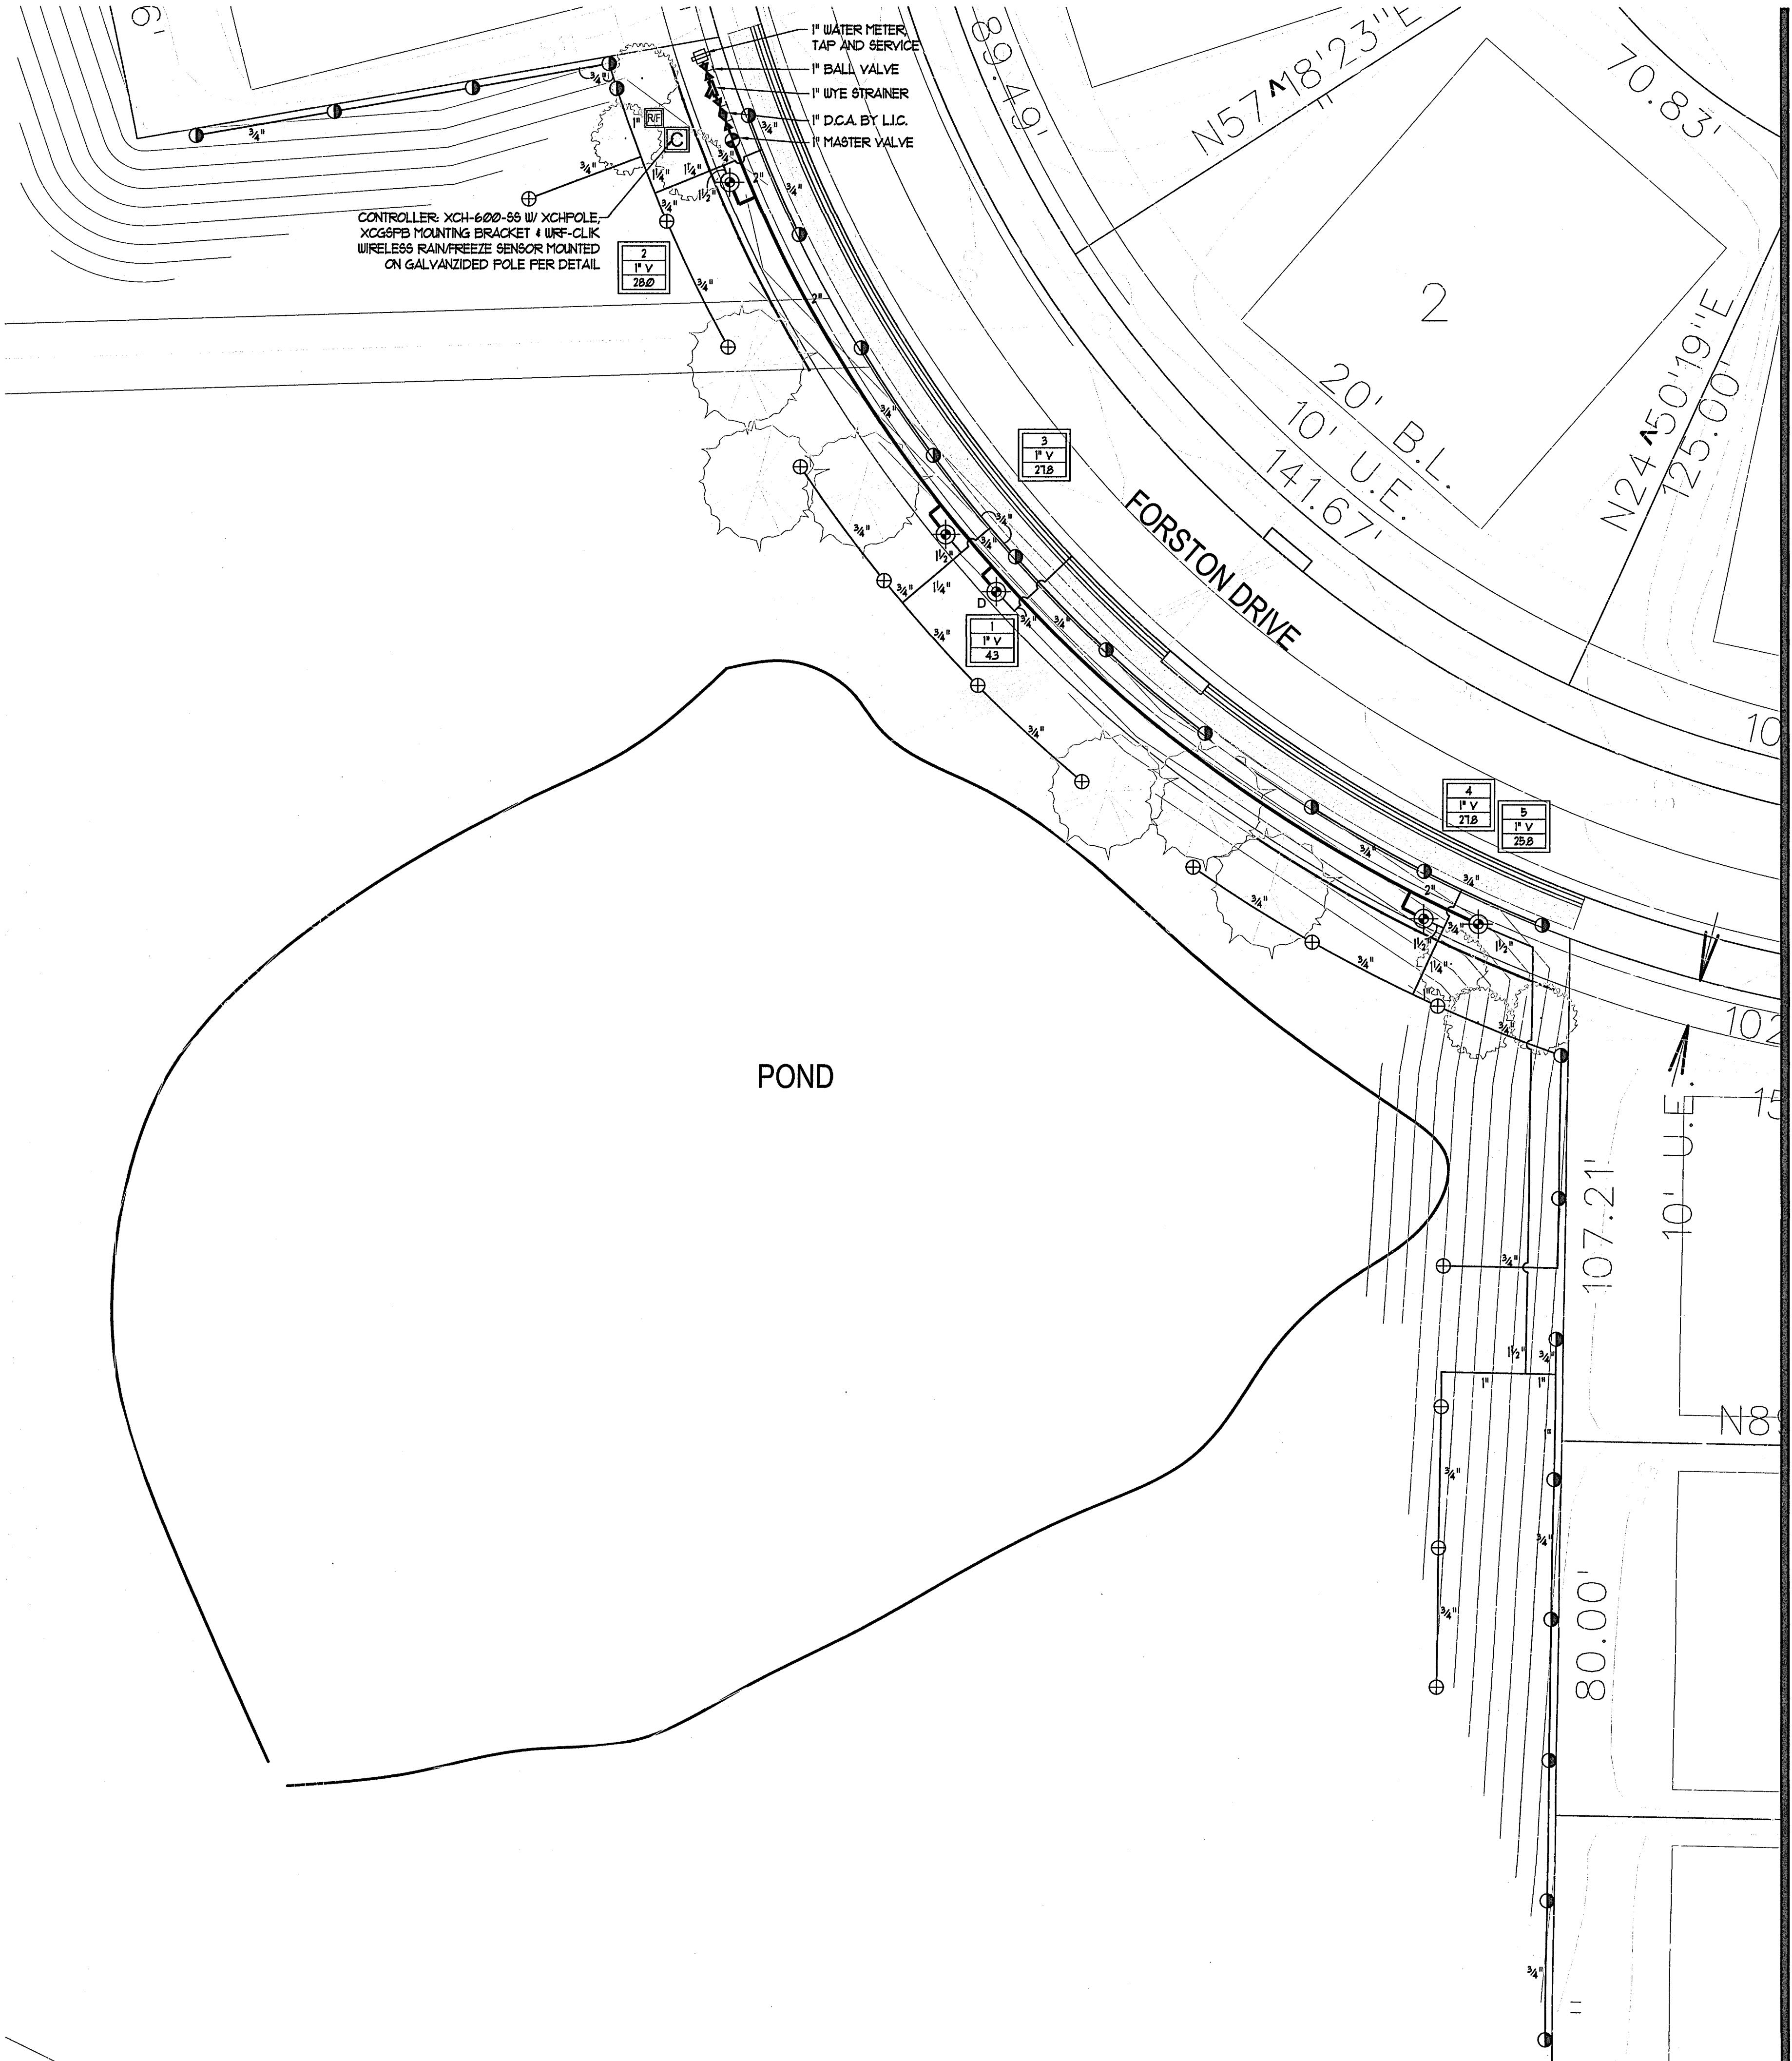

PROJECT NAME: Breezy Hill PH V
PROJECT NUMBER: 16-070
REVISIONS:

Breezy Hill
Phase V
Rockwall, Texas



RICKY D. PETTY
4265
LICENCED IRIGATION CONTRACTOR
09/16/2016

PROJECT NAME: Breezy Hill Phase V Rockwall Texas


RICKY D. PETTY
LANDSCAPE ARCHITECT
7720 ALTO CAVO DRIVE
DALLAS, TEXAS 75248
PHONE: (214) 543-6265
e-mail: rdpetty@xr.com

TITLE: Irrigation Plan
DATE: September 16, 2016
SCALE: 1" = 20'-0"
SCALE: 1" = 20'-0"
SHEET: L2-1

IRRIGATION PLAN

GENERAL NOTES:
CONTRACTOR SHALL PLACE DRIPLINE TO ASSURE ADEQUATE WATERING FOR PLANT GROWTH AND VIABILITY. DO NOT EXCEED DRIP LINE RUNS GREATER THAN 110 LN. FT.

CONSTRUCTION NOTES:
A. MULCH (REF. LANDSCAPE DRAWINGS)
B. DRIP LINE
C. BED PREP (REF. LANDSCAPE PLAN)

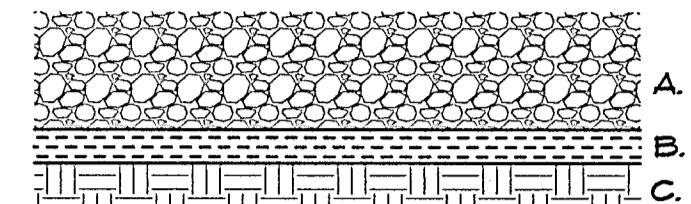


(○) DRIP LINE / CRUSHER FINES
NOT TO SCALE

GENERAL NOTES:
1. SET TOP OF HEAD FLUSH WITH FINISH GRADE
2. FLUSH PIPING PRIOR TO INSTALLING NOZZLE
3. SET HEAD OFFSET OF LATERTAL AND MAINLINE PIPING

CONSTRUCTION NOTES:

- A. FINISH GRADE
- B. ROTARY SPRAY HEAD
- C. 3/4" LASCO UNITEZED O-RING SWING JOINT ASSEMBLY
- D. LATERTAL PIPING
- E. PAVING

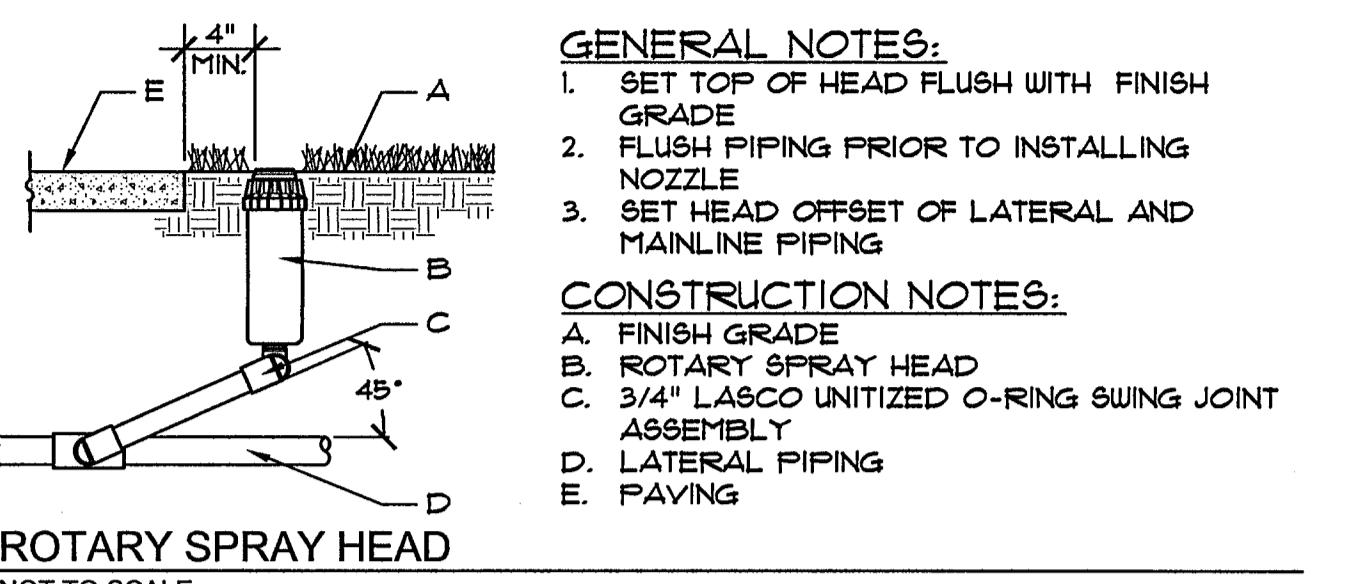

(○) ROTARY SPRAY HEAD
NOT TO SCALE

CONSTRUCTION NOTES:
A. 12" X 11" PLASTIC VALVE BOX WITH LOCKING LID.
B. FINISHED GRADE.
C. 24" WIRE LOOP.
D. AUTOMATIC VALVE, SEE IRRIGATION PART LIST.
E. WATER PROOF WIRE CONNECTOR.
F. SCH 80 NIPPLE.
G. PRESSURE REGULATOR.
H. WYE STRAINER, INSTALL TO PROVIDE ACCESS FOR MAINTENANCE AND REPLACEMENT OF FILTER.
I. LOCKING VALVE BOX COVER.
J. VALVE BOX EXTENSIONS IF NEEDED.
K. LATERTAL LINE.
L. 4" LAYER OF 3/4" GRAVEL.
M. TRUE UNION BALL VALVE.
N. 6MM BLACK POLYETHYLENE PLASTIC, TAPE TO ALL INLET AND OUTLET PIPE AND INSTALL FULL LENGTH OF VALVE BOX BOTTOM.
O. CMU BLOCK.

(○) DRIP VALVE/FILTER ASSEMBLY
NOT TO SCALE

GENERAL NOTES:
1. INSTALL PEA GRAVEL FLUSH WITH BOTTOM OF PIPE + VALVE.
2. MAIN LINE SHALL HAVE A MINIMUM OF 18" COVER.
3. LATERTAL LINE SHALL HAVE A MINIMUM 12" COVER.
4. PROVIDE A 1" WIRE EXPANSION COIL AT EACH DRY SPLICE WIRE CONNECTION.
5. CENTER VALVE ASSEMBLY IN VALVE BOX.

CONSTRUCTION NOTES:

- A. 12" DIA. WIRE COIL
- B. WATERPROOF WIRE CONNECTORS
- C. 10" DIAMETER VALVE BOX W/ LOCKING LID. SET 1/4" ABOVE FINISH GRADE
- D. FINISH GRADE
- E. AUTOMATIC VALVE
- F. LATERTAL LINE PVC, REF. PLAN
- G. WASHED PEAT GRAVEL - 12" DEPTH MIN.
- H. MAINLINE PVC, SEE SPECIFICATION AND PARTS LIST
- I. 6" VALVE BOX EXTENSIONS
- J. VALVE WIRING

(○) REMOTE CONTROL VALVE
NOT TO SCALE

CONCRETE FOOTING NOTES:
1. LOCATE POLE NEXT TO CONTROLLER AS APPROVED BY LA.
2. CONNECT SENSOR TO CONTROLLER PER MANUFACTURER'S SPECS.
3. TOP OF CONCRETE FOOTING 1" ABOVE FINISH GRADE

CONSTRUCTION NOTES:
A. WEATHER STATION - ROTATE SO THERMOSTAT PORTION POINTS SOUTH
B. 2" GALV. SCH. 40 STEEL PIPE
C. FINISH GRADE

(○) RAIN SENSOR
NOT TO SCALE

GENERAL NOTES:
1. INSTALL ELECTRICAL WIRING PER LOCAL CODES.
2. CONTRACTOR SHALL BE RESPONSIBLE FOR ALL ELECTRICAL WORK.
3. PROVIDE DRAINAGE AWAY FROM BASE OF PEDESTAL.
4. GROUND IRRIGATION BOXES WITH GROUNDING ROD PER NEC.
5. INSTALL TEMPERATURE SENSOR TO NORTH SIDE OF CONTROLLER PEDESTAL W/ STAINLESS STEEL SCREWS

CONSTRUCTION NOTES:


- A. CONTROLLER
- B. PEDESTAL
- C. ELECTRICAL SERVICE CONDUIT
- D. REMOTE CONTROL VALVE WIRING CONDUIT
- E. GROUNDING ROD(S) PER MANUFACTURER'S REQUIREMENTS
- F. ANCHOR BOLTS
- G. CONCRETE BASE, 3000 PSI

(○) PEDESTAL MOUNTED CONTROLLER
NOT TO SCALE


GENERAL NOTES:
1. INSTALL WASHED PEA GRAVEL BELOW DCA TO ALLOW ACCESS TO TEST COCKS AND OPERATION OF BALL VALVES.
2. INSTALL PEA GRAVEL FLUSH WITH ELECTRIC VALVE.
3. PROVIDE A 24" WIRE EXPANSION COIL AT EACH DRY SPLICE WIRE CONNECTION.
4. CENTER VALVE ASSEMBLY IN VALVE BOX.

CONSTRUCTION NOTES:

- A. WATER METER (SIZE PER PLAN)
- B. BALL VALVE (SIZE PER LINE)
- C. WYE STRAINER (SIZE PER LINE)
- D. TYPE "K" COPPER PIPE
- E. COPPER SxT COUPLING
- F. TEE NIPPLE
- G. PIPE PER CITY CODE
- H. COUPLING
- I. FINISH GRADE
- J. 12"x11" VALVE BOX, SET FLUSH WITH FINISH GRADE
- K. DOUBLE CHECK VALVE ASSEMBLY
- L. COMPACTED SUBGRADE
- M. MALE ADAPTER
- N. MASTER ELECTRIC VALVE
- O. WIRE COIL
- P. WATERPROOF WIRE CONNECTORS
- Q. 6" ML BLACK PLASTIC
- R. 10" RD VALVE BOX, SET 1/4" ABOVE FINISH GRADE
- S. WASHED PEAT GRAVEL - 6" DEPTH MIN
- T. VALVE WIRING

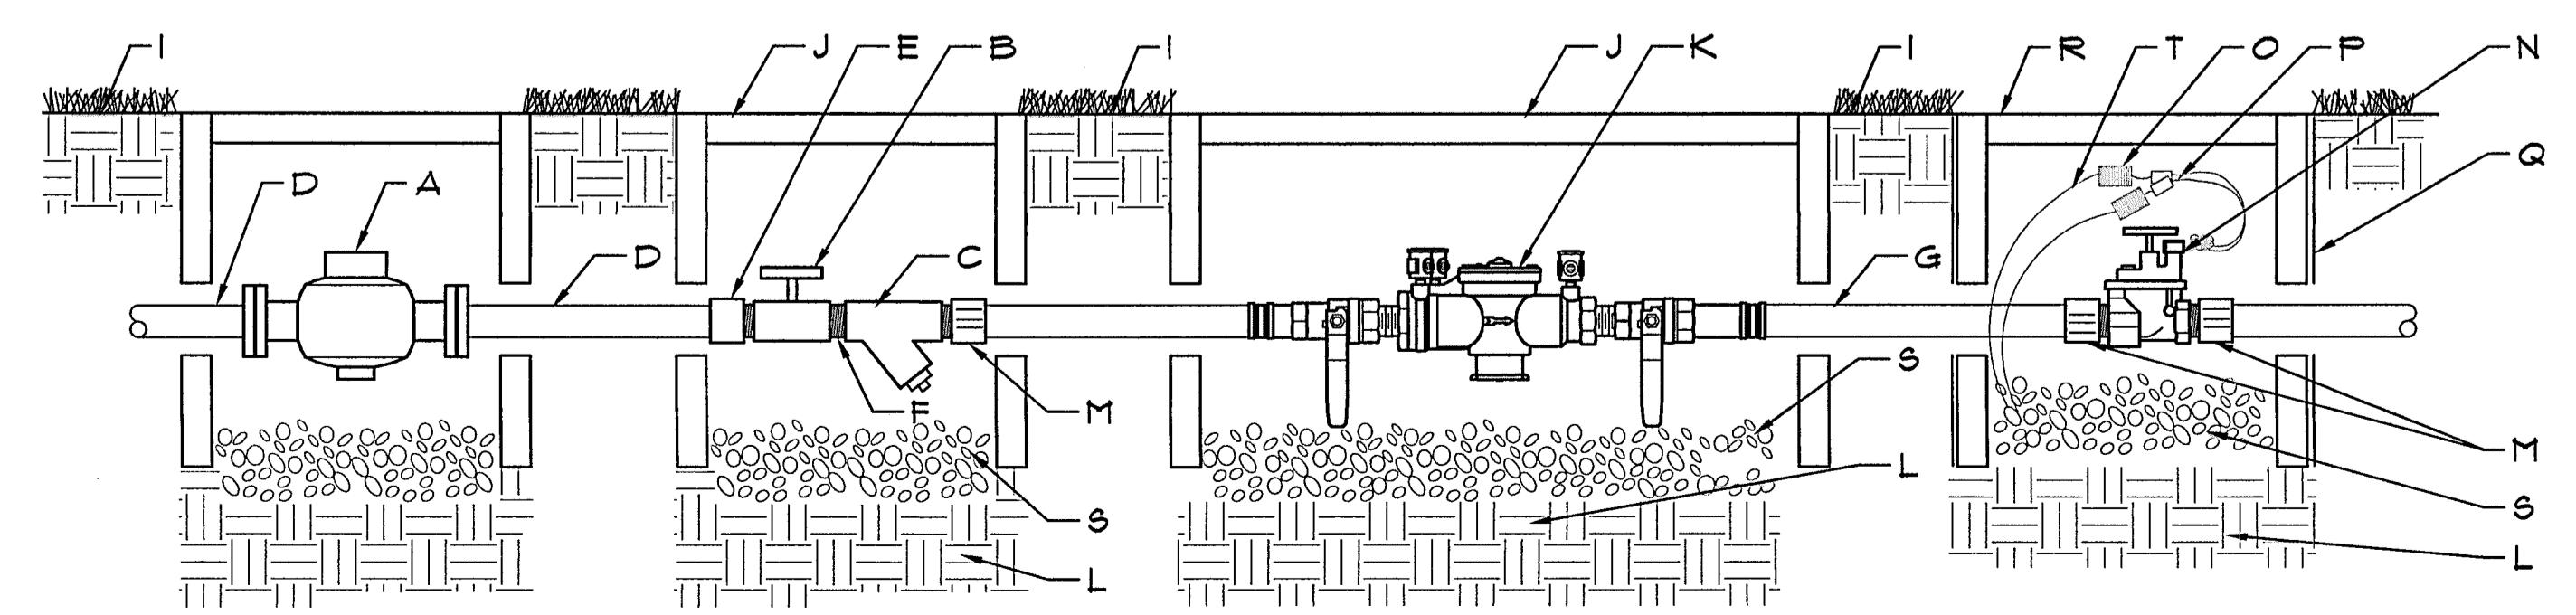


(○) BACKFLOW PREVENTER CONNECTION
NOT TO SCALE

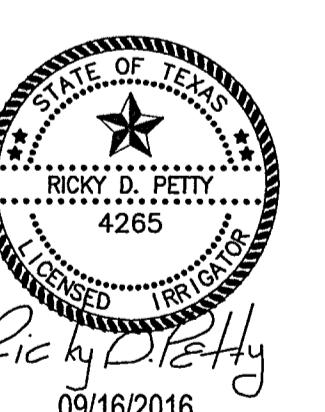

PROJECT NAME	Breezy Hill
Phase V	
Rockwall	
Texas	

RICKY D. PETTY	4265
LANDSCAPE ARCHITECT	
7720 ALTO CARO DRIVE	
DALLAS, TEXAS 75248	
PHONE: (214) 543-5265	
e-mail: rdpetty@xr.com	
TITLE	Irrigation Details
DATE	September 16, 2016
SCALE	NONE
SHEET	L2-2

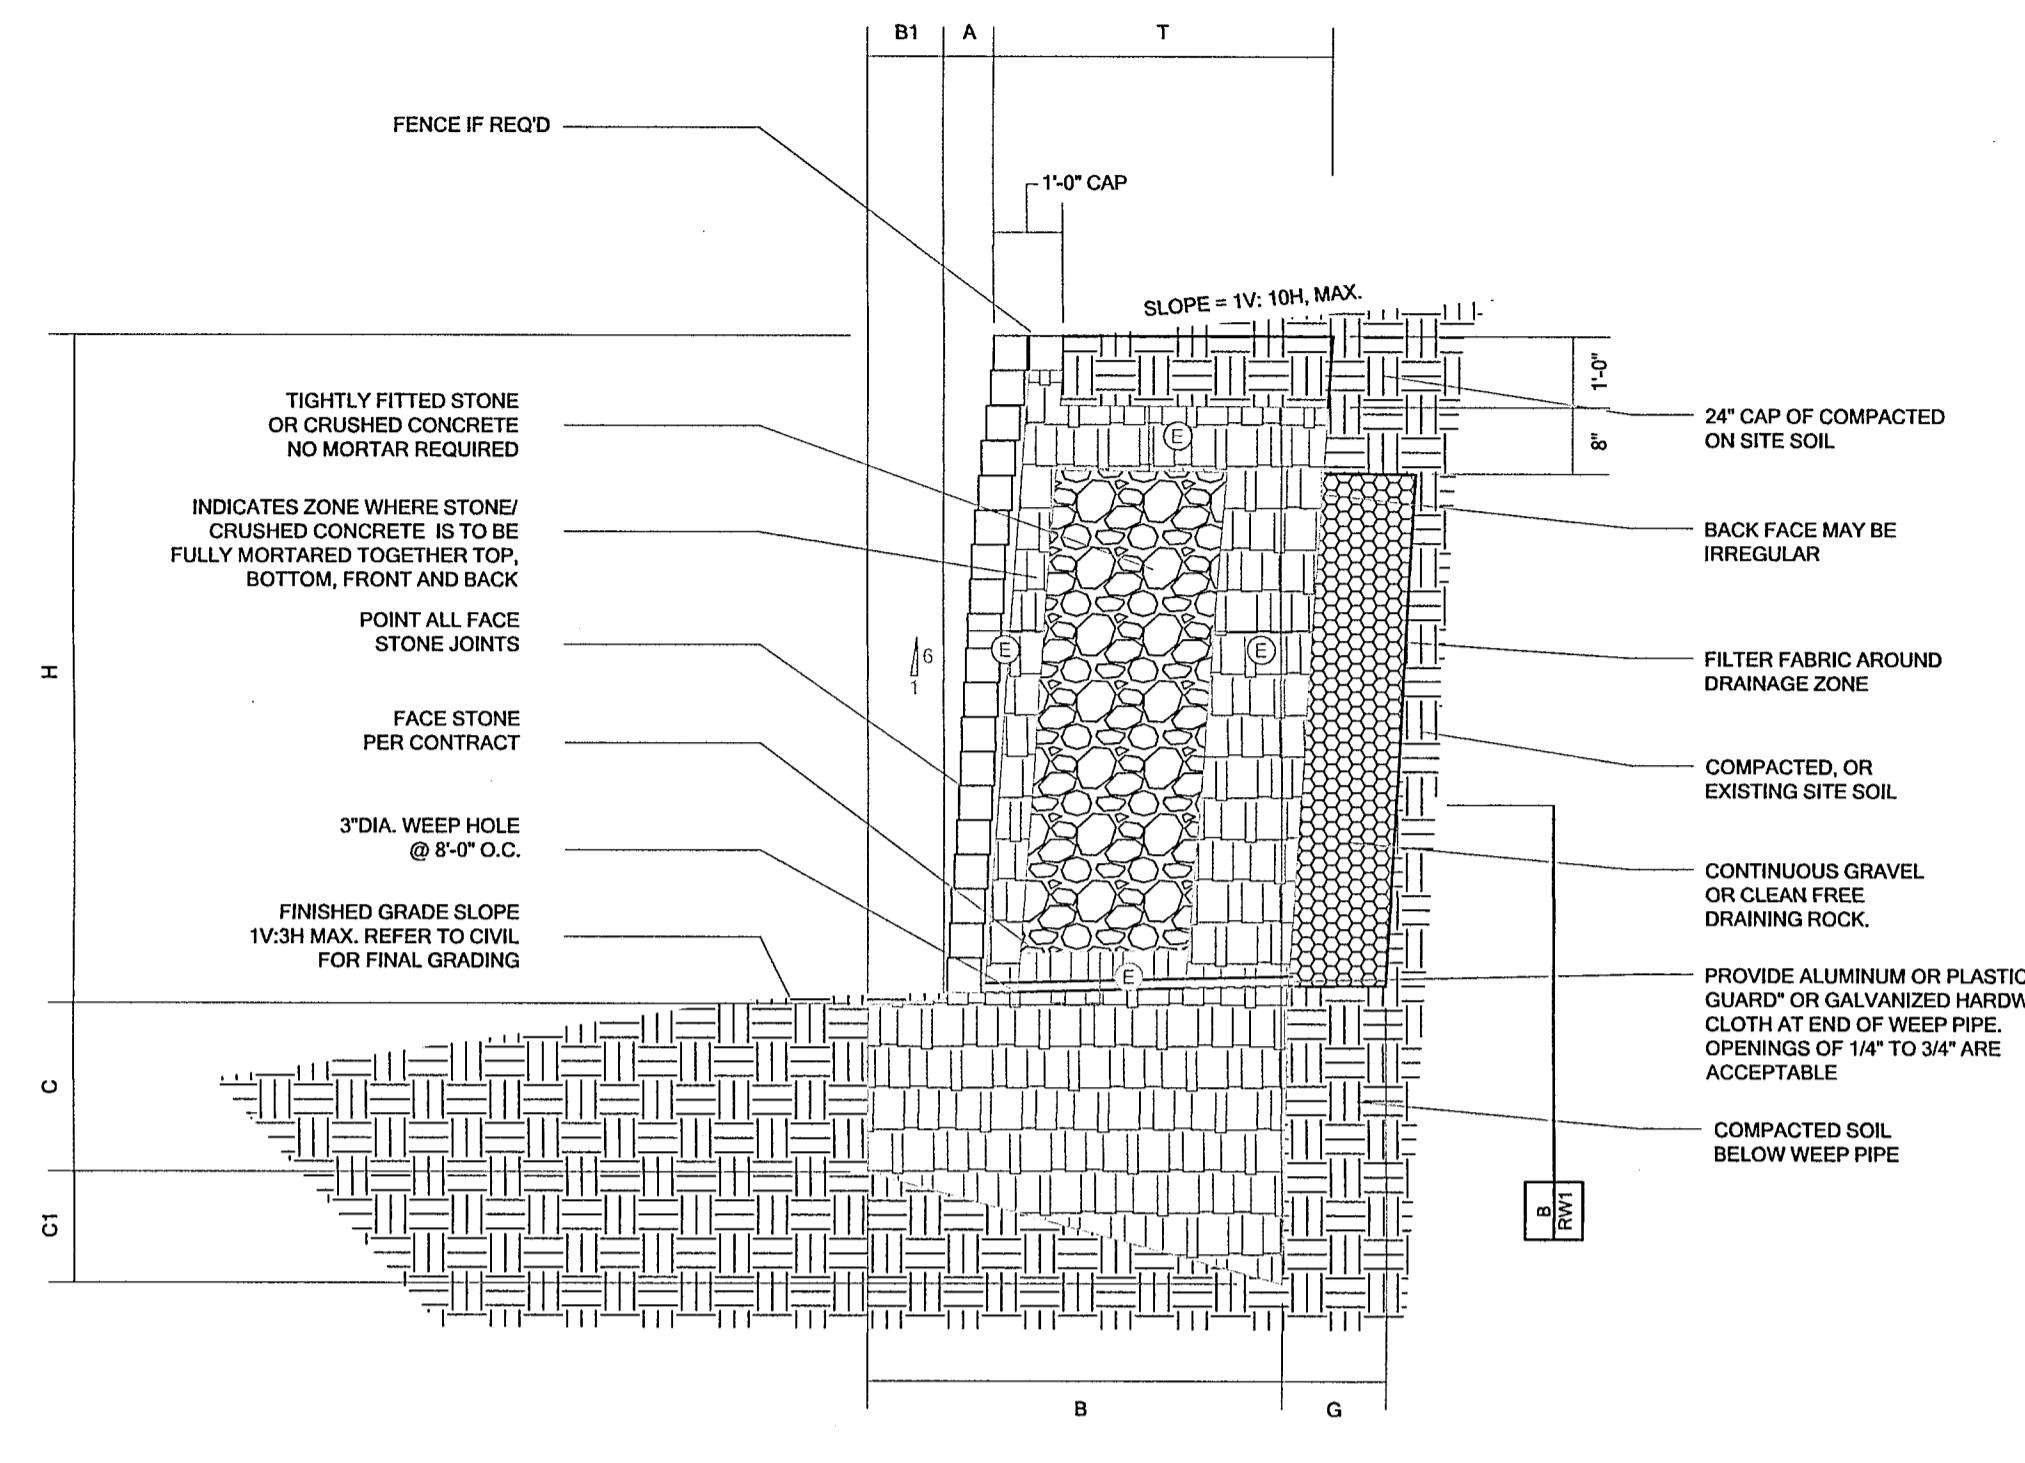


RW2/1 ALTERNATE SLOPE MASONRY WALL

SCALE: N.T.S.

RW2/1 - ALTERNATE MASONRY WALL SCHEDULE - 1800 psf									
1800 psf - BEARING CAPACITY (COMPACTED AND TESTED CR NATURAL SCILLS)									
WALL	BASE	TOE	BASE	BASE	BATTER	FULLY MORTARED ZONE	THICKNESS	DRAINAGE ZONE OF WALL	BEARING CAPACITY
H	B	B1	C	C1	A	E	T	G	
7' - 0"	3' - 10"	0' - 10"	1' - 8"	0' - 8"	1' - 2"	0' - 10"	3' - 0"	1' - 0"	1800 psf
8' - 0"	4' - 6"	1' - 0"	2' - 0"	0' - 10"	1' - 4"	1' - 0"	3' - 6"	1' - 3"	
9' - 0"	5' - 2"	1' - 2"	2' - 6"	0' - 11"	1' - 6"	1' - 2"	4' - 0"	1' - 6"	
10' - 0"	6' - 0"	1' - 4"	2' - 9"	1' - 1"	1' - 8"	1' - 4"	4' - 8"	1' - 9"	
11' - 0"	6' - 9"	1' - 6"	3' - 0"	1' - 3"	1' - 10"	1' - 6"	5' - 3"	2' - 0"	
WALL DESIGN CRITERIA									
BEARING	SLOPE TOP	SLOPE BOT	ACTIVE PRESSURE	PASSIVE PRESSURE	FRICITION ANGLE BASE	SLOPE OF BACK OF WALL	SURCHARGE		
Q_a	β	β_1	Φ_a	Φ_p	δ	α	q		
1800 psf	5.7 deg	18.4 deg	30 deg	30 deg	17 deg	99.5 deg	0 psf		

RW2/1 ALT MASONRY WALL SCHEDULE

SCALE: N.T.S.

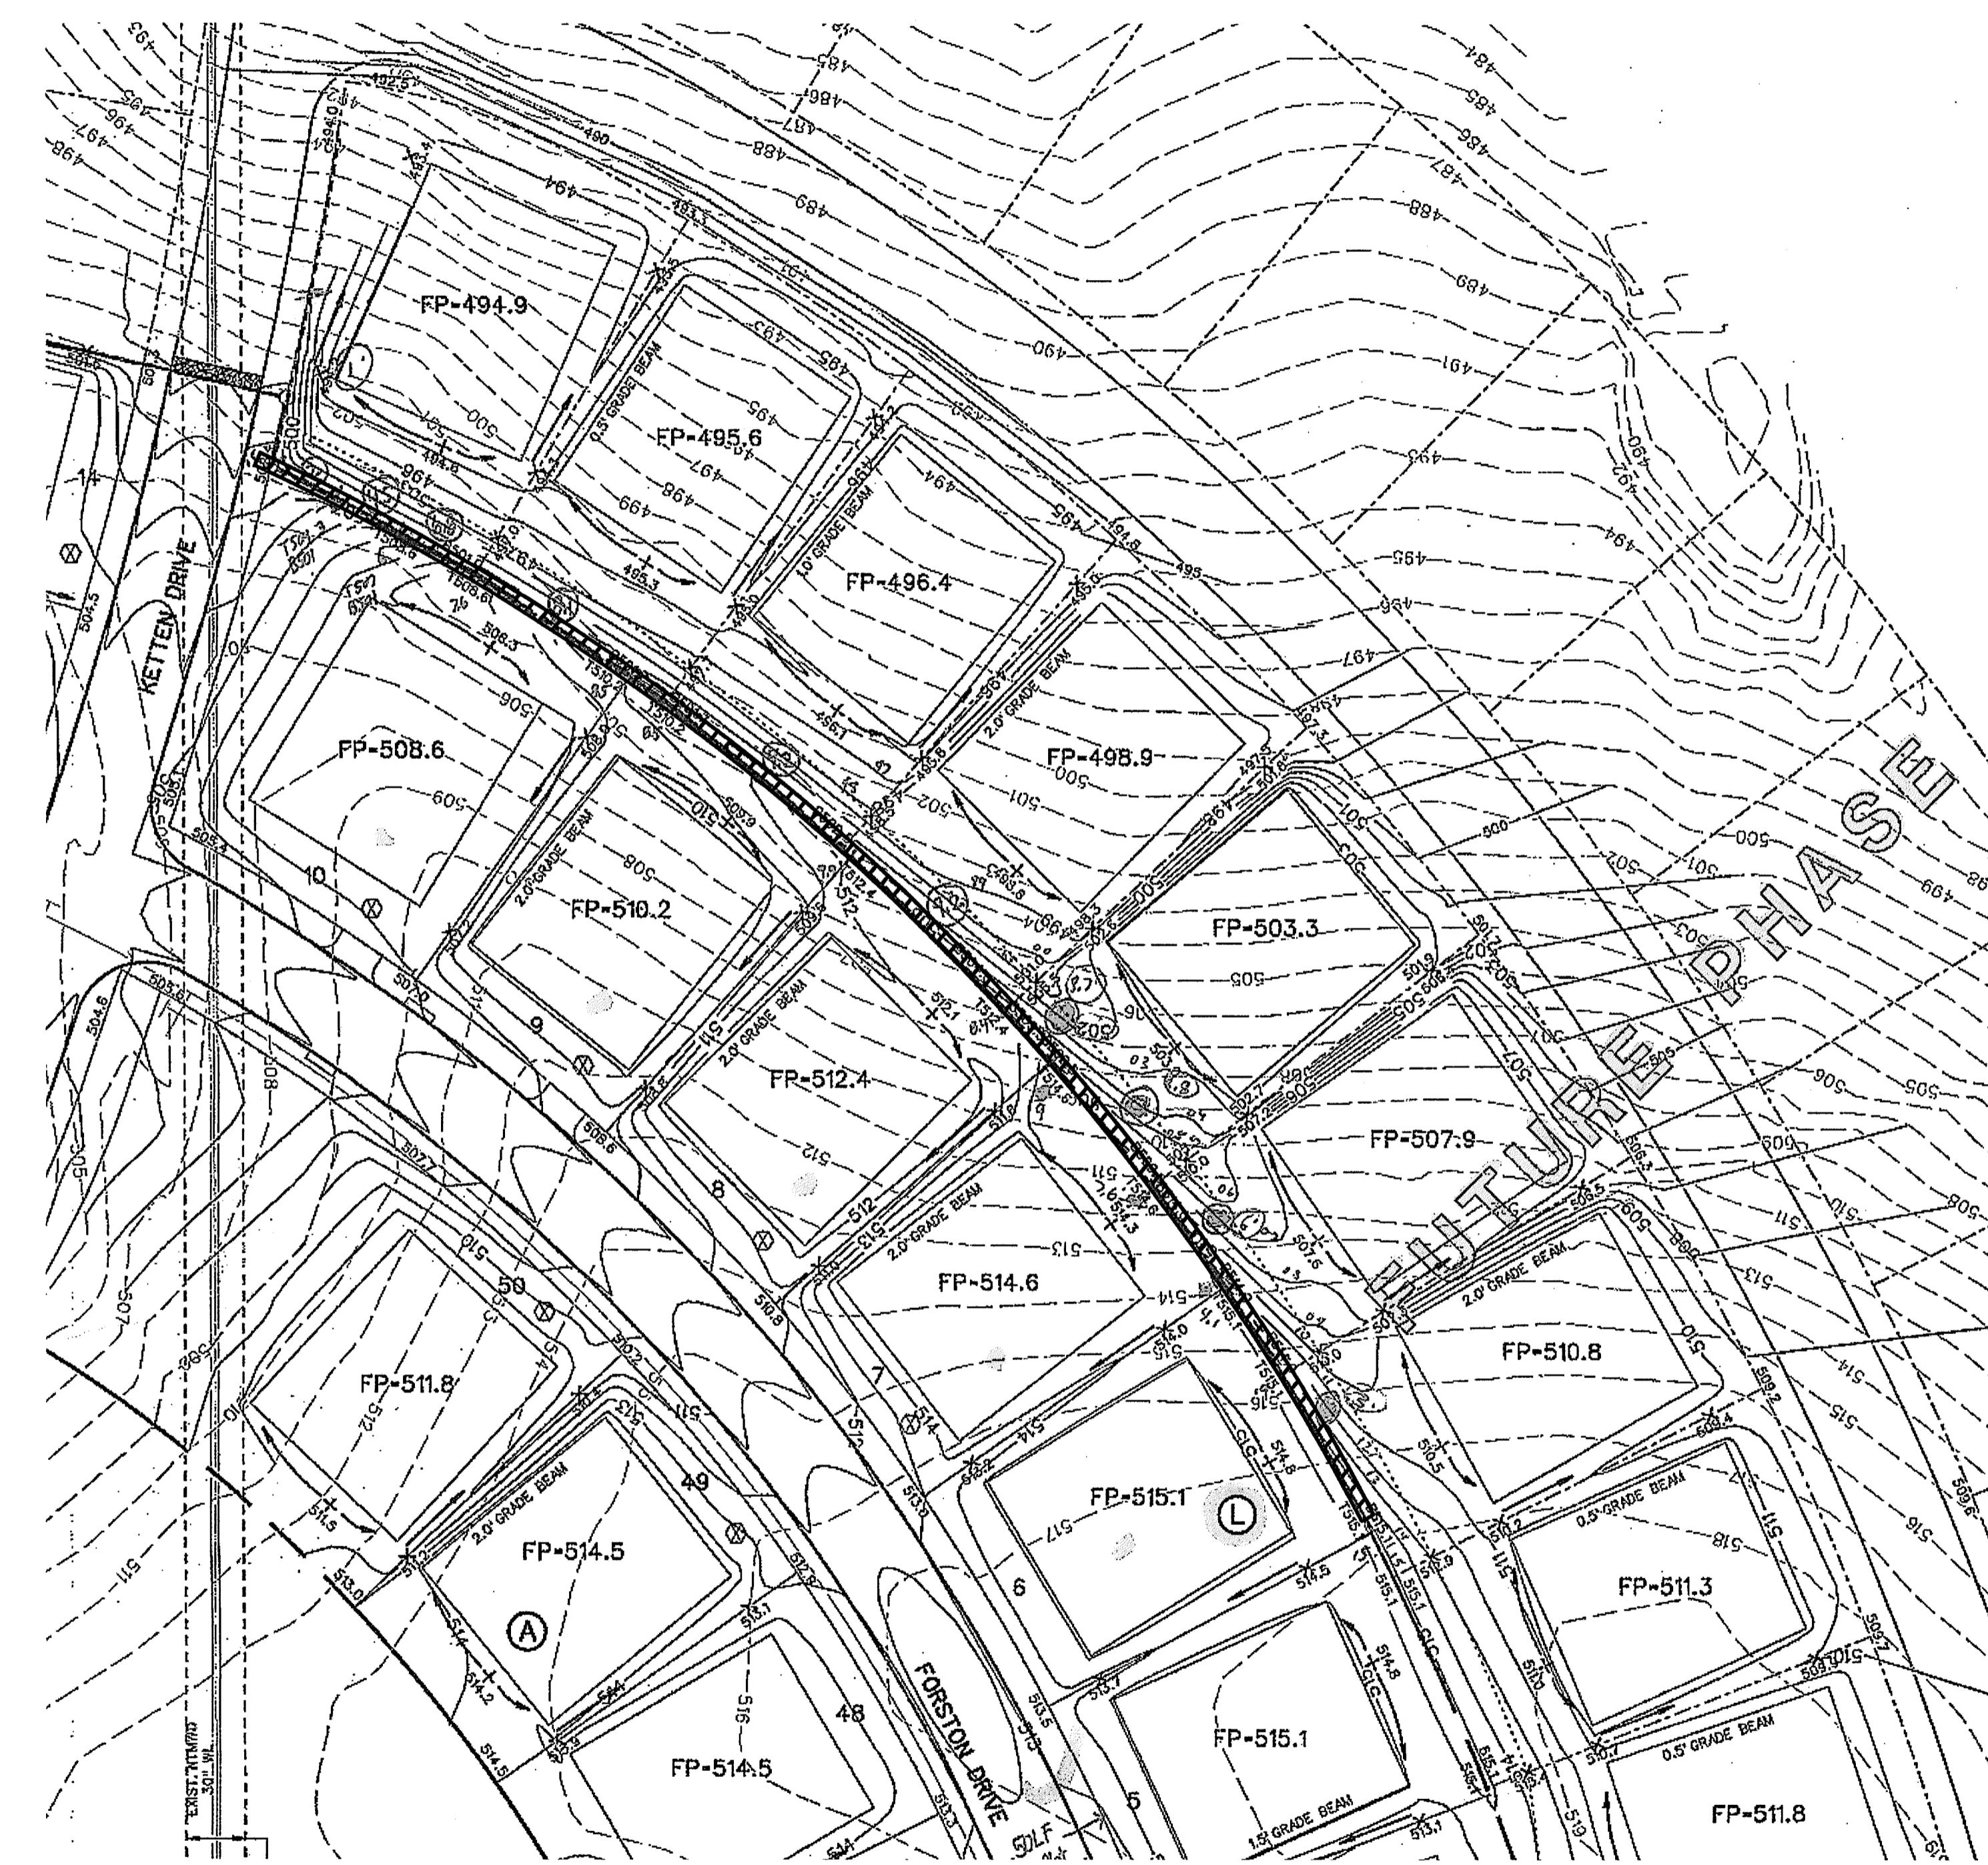



ALTERNATE WALL DESIGN FOR BLOCK L LOTS 6-10

ALT MASONRY WALL LOCATION

SCALE: N.T.S.

DirtSavers
2708 Chesapeake Court
Grapevine, TX 76051
Ph: 469.534.7446

BREEZY HILL PHASE V
MASONRY RETAINING WALLS
ROCKWALL, TEXAS
PLANO, TEXAS
RPM xCONSTRUCTION, LLC.

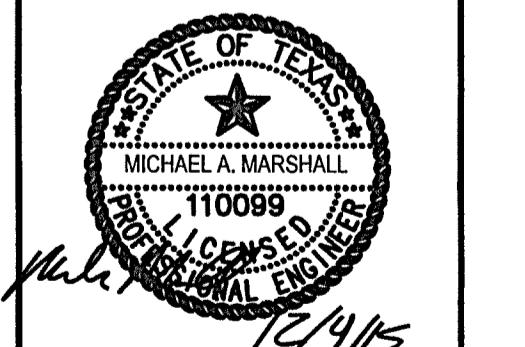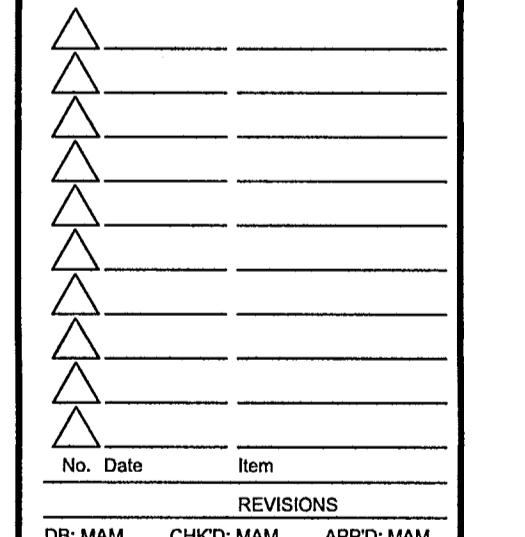

RETAINING WALL DETAILS AND NOTES

Project No. RW120415-1
Date 12.04.2015
Last Revision 12.04.2015

RW2