


DEVELOPMENT PLANS FOR BREEZY HILL PHASE III CITY OF ROCKWALL, TEXAS

INDEX


1	TITLE
2	PLAT
3	DRAINAGE AREA MAP
3A	OVERALL DRAINAGE AREA MAP
4	CALM CREST DRIVE
5	RAVENBANK DRIVE
6	CATTERICK DRIVE
7	FOXHALL DRIVE
8	LORION DRIVE
8A	EMERGENCY ACCESS AND TRAIL PLAN
9	WATER AND SANITARY SEWER PLAN
10	SANITARY SEWER PROFILES
11	SANITARY SEWER PROFILES
12	SANITARY SEWER PROFILES
13	STORM SEWER PLAN AND PROFILE LINES 'D-1' & 'D-2'
14	STORM SEWER PLAN AND PROFILE LINES 'D-3' & 'D-5'
15	STORM SEWER PLAN AND PROFILE LINE 'D-4'
16	STORM SEWER PLAN AND PROFILE LINE 'D-4'
17	GRADING PLAN
18	GRADING PLAN
19	EROSION CONTROL PLAN
20	STREET SIGN PLAN

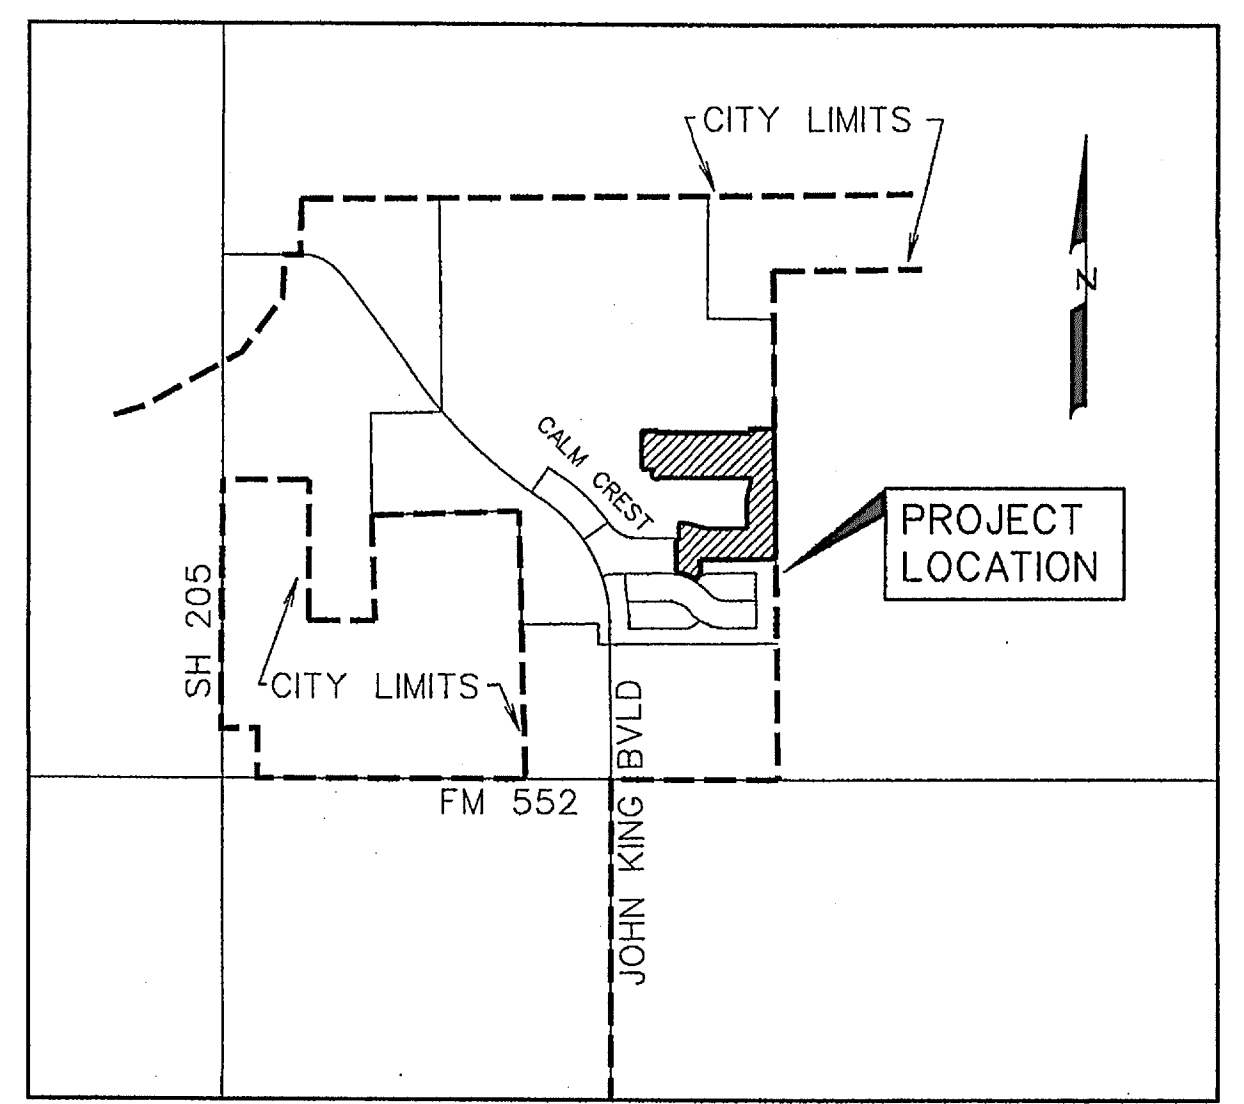

VICINITY MAP
NOT TO SCALE

PREPARED FOR
BH PHASE III SF, LTD.
8214 WESTCHESTER DRIVE, SUITE 710 DALLAS, TEXAS 75225

CORWIN ENGINEERING, INC. — CONSULTING ENGINEERS
200 W. BELMONT, SUITE E TBPE FIRM #5951 ALLEN, TEXAS 75013

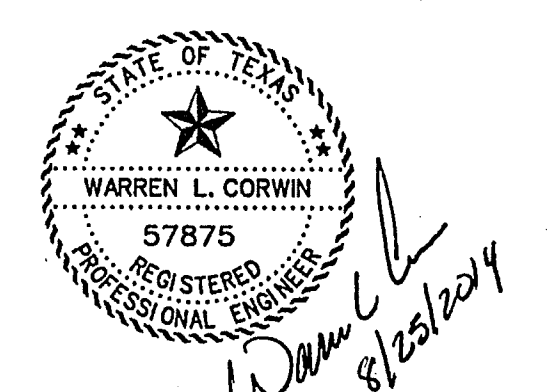

The seal appearing on this document was authorized by Warren L. Corwin, P.E. 57875, on August 25, 2014

AS-BUILT MARCH 2015
INFORMATION PROVIDED BY CONTRACTORS
(NOT FIELD VERIFIED)

NOTE:
CITY OF ROCKWALL STANDARDS
AND NCTCOG 3rd ADDITION STANDARDS
SHALL BE USED FOR REFERENCE.

NO.	CITY COMMENTS	5/30/14
	REVISIONS	DATE
1		