

RUNOFF COMPUTATIONS

#	Area (sf)	Area (acres)	Coefficient	CA	Tc (min)	Q(100) (in/hr)	Q(100) (cfs)
1	58892	1.35	0.50	0.68	10	9.80	6.6
2	13030	0.30	0.50	0.15	10	9.80	1.5
3	45009	1.03	0.50	0.82	10	9.80	5.1
4	20944	0.48	0.50	0.24	10	9.80	2.4
5	22400	0.51	0.50	0.26	10	9.80	2.5
6	80310	1.84	0.50	0.92	10	9.80	9.0
7	34218	0.79	0.50	0.39	10	9.80	3.8
8	72743	1.67	0.50	0.84	10	9.80	8.2
9	33911	0.78	0.50	0.39	10	9.80	3.8
10	72601	1.67	0.50	0.83	10	9.80	8.2
11	75839	1.74	0.50	0.87	10	9.80	8.6
12	26671	0.62	0.50	0.31	10	9.80	3.0
13	72907	1.68	0.50	0.84	10	9.80	8.2
14	72524	1.66	0.50	0.83	10	9.80	8.2
15	73485	1.69	0.50	0.84	10	9.80	8.3
16	73556	1.69	0.50	0.84	10	9.80	8.3
17	12854	0.30	0.50	0.15	10	9.80	1.4
18	20424	0.47	0.50	0.23	10	9.80	2.5
19	82760	1.90	0.50	0.95	10	9.80	9.3
20	98772	2.27	0.50	1.13	10	9.80	11.1
21	42055	0.97	0.50	0.48	10	9.80	4.7

INLET CALCULATIONS


No.	Inlet Location	Freq. (years)	Tc (min)	"I" (in/hr)	Coeff. "C"	"A" (acres)	Q (cfs)	Upstream (cfs)	Flow (cfs)	Capacity (cfs)	Slope (ft/100ft)	Crown Type	Length (ft)	Capacity (cfs)	Downstream Inlet (cfs)
1	21+00 Calm Crest	100	10	9.8	0.5	1.35	6.6	0.0	6.6	6.7	1.00%	6" pbl	10	STD.	7.0
2	21+00 Calm Crest	100	10	9.8	0.5	0.30	1.5	0.0	1.5	6.0	1.00%	6" pbl	10	STD.	7.0
3	25+25 Calm Crest	100	10	9.8	0.5	1.03	5.1	0.0	5.1	6.0	0.80%	6" pbl	10	STD.	7.4
4	27+43 Calm Crest	100	10	9.8	0.5	0.48	2.4	0.0	2.4	6.0	0.80%	6" pbl	10	STD.	7.4
5	27+57 Calm Crest	100	10	9.8	0.5	0.51	2.5	0.0	2.5	6.0	0.80%	6" pbl	10	STD.	7.4
6	2+00 Ravenbank	100	10	9.8	0.5	1.84	9.0	0.0	9.0	9.5	2.00%	6" pbl	10	STD.	6.5
7	4+17.64 Ravenbank	100	10	9.8	0.5	1.79	8.8	0.0	8.8	9.5	Low Pt	6" pbl	10	STD.	20.0
8	4+17.64 Ravenbank	100	10	9.8	0.5	0.67	3.2	2.5	10.7	9.5	Low Pt	6" pbl	10	STD.	20.0
9	10+50.52 Ravenbank	100	10	9.8	0.5	0.78	3.8	0.0	3.8	4.7	0.50%	6" pbl	10	STD.	7.8
10	5+24.92 Catterick	100	10	9.8	0.5	1.67	8.2	0.0	8.2	9.2	1.90%	6" pbl	10	STD.	6.5
11	0+60.50 Lorion	100	10	9.8	0.5	2.04	10.0	1.7	11.6	9.9	Low Pt	6" pbl	10	STD.	20.0
12	Lorin & Catterick	100	10	9.8	0.5	1.09	5.3	0.0	5.3	9.9	Low Pt	6" pbl	10	STD.	20.0
13	5+19.86 Foxhall	100	10	9.8	0.5	1.68	8.2	0.0	8.2	9.0	1.80%	6" pbl	10	STD.	6.7
14	5+23.44 Foxhall	100	10	9.8	0.5	1.66	8.2	0.0	8.2	9.0	1.80%	6" pbl	10	STD.	6.7
15	0+58.50 Foxhall	100	10	9.8	0.5	1.69	8.3	1.5	9.8	9.0	1.80%	6" pbl	15	STD.	10.6
16	0+58.50 Foxhall	100	10	9.8	0.5	1.69	8.3	1.5	9.8	10.4	2.40%	6" pbl	15	STD.	10.3

STORM SEWER CALCULATIONS

Upstream Station	Downstream Station	Distance (ft)	AREA NO.	Total Area (Acres)	Picked Up (Acres)	C	CA	Accumulated CA	Tc (Min)	Design Storm (in/hr)	Q (CFS)	S (ft)	Pipe Size (in)	Velocity (ft/s)	Head Loss (ft)	Flow Time (min)	Time at DIS (min)	Hydraulic Grade (ft)	Proposed Grade (ft)		
4+13.55	4+13.55	45.36	1	1.35	1.35	0.68	0.68	0.68	10.00	9.80	6.6	0.0048	18	3.7	0.21	0.21	10.21	525.53	525.32	528.92	
4+13.55	2+51.10	162.45	2	0.30	0.30	0.15	0.83	1.03	10.00	9.80	8.1	0.0055	18	4.6	0.33	0.59	10.59	525.13	525.01	528.90	
Line D3	5+84.60	4+51.02	135.00	3	1.03	1.03	0.50	0.52	10.00	9.80	5.1	0.0024	18	2.9	0.13	0.78	10.78	519.69	519.45	529.16	
Line D3	4+51.02	4+75.42	24.40	4	0.81	0.81	0.26	0.78	10.00	9.80	7.4	0.0053	18	4.3	0.29	0.10	10.10	519.13	518.97	528.14	
Line D3	4+75.42	4+75.42	0	4	0.40	0.40	0.50	0.24	1.02	10.00	9.80	10.0	0.0091	18	5.7	0.68	1.14	11.14	518.84	518.63	527.92
Line D3	3+78.24	1+49.29	208.95	NR	0.00	0.00	0.50	0.00	1.02	10.00	9.80	10.0	0.0091	18	5.7	0.68	1.14	11.14	518.20	518.20	526.90
Line D3	1+49.29	0+00.00	149.29	6	1.84	1.33	0.50	0.66	1.69	10.00	9.80	16.5	0.0093	24	8.2	0.42	0.54	16.54	515.31	515.35	524.02
Line D3	0+00.00	0+00.00	0	6	0.00	0.00	0.50	0.00	1.69	10.00	9.80	16.5	0.0093	24	8.2	0.42	0.54	16.54	515.31	515.35	524.02
Line D3	0+00.00	0+00.00	0	6	0.00	0.00	0.50	0.00	1.69	10.00	9.80	16.5	0.0093	24	8.2	0.42	0.54	16.54	515.31	515.35	524.02
Line D4	11+15.62	14+53.51	337.89	5	0.78	0.78	0.50	0.39	0.39	10.00	9.80	9.8	0.0012	18	2.2	0.08	0.47	10.47	508.64	508.56	532.35
Line D4	14+53.51	3+73.52	479.99	5	0.00	0.00	0.50	0.00	0.39	10.00	9.80	9.8	0.0012	18	2.2	0.08	0.34	10.34	508.48	508.48	532.60
Line D4	3+73.52	5+00.21	472.81	13-14	0.34	2.75	0.50	1.37	1.74	10.00	9.80	15.2	0.0059	24	6.5	0.47	1.43	11.43	507.45	507.45	531.79
Line D4	5+00.21	4+53.66	47.45	15-16	1.38	3.98	0.50	1.59	3.75	10.00	9.80	36.8	0.0086	30	7.5	0.87	1.10	11.10	504.20	504.30	531.59
Line D4	4+53.66	2+45.21	248.45	NR	0.00	0.00	0.50	0.00	2.25	10.00	9.80	36.8	0.0086	30	7.5	0.87	0.35	16.95	503.92	503.92	531.20
Line D4	2+45.21	1+59.29	51.90	11-12	2.04	2.97	0.50	1.34	5.89	10.00	9.80	45.9	0.0148	36	10.2	1.42	0.98	16.98	502.75	501.19	507.16
Line D4	1+59.29	1+21.20	32.09	13	0.00	0.00	0.50	0.00	5.89	10.00	9.80	45.9	0.0148	36	10.2	1.42	0.85	16.05	500.41	500.41	508.33
Line D4	1+21.20	0+01.28	79.92	12-18	1.09	1.55	0.50	0.78	5.87	10.00	9.80	57.5	0.0074	36	8.1	1.02	0.08	10.08	499.94	500.24	506.30
Line D5	5+83.20	0+00.00	83.20	12	1.67	1.33	0.50	0.66	0.66	10.00	9.80	6.5	0.0039	18	3.7	0.21	0.37	10.37	511.42	511.21	528.14

LEGEND

- PRE PRE-PROJECT 100-YR FLOOD PLAN ELEVATION
- POST POST-PROJECT 100-YR FLOOD PLAN ELEVATION
- FD FULLY DEVELOPED 100-YR FLOOD PLAN ELEVATION
- PROP. STORM SEWER
- PROP. CURB INLETS
- PROP. CONC. HEADWALL
- EXIST. STORM SEWER
- DRAINAGE AREA DIVIDE
- FLOW ARROW
- AC. Q DRAINAGE AREA NO.

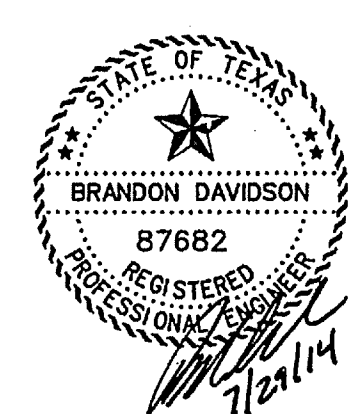

The seal appearing on this document was authorized by Brandon Davidson P.E. 87682, on July 29, 2014

CORWIN ENGINEERING, INC.
 200 W. BELMONT, SUITE E
 ALLEN, TEXAS 75013 (972)396-1200
 TBP# FIRM #5951

**DEVELOPMENT PLANS FOR
 BREEZY HILL
 PHASE III
 ROCKWALL, TEXAS**

DRAINAGE AREA MAP

DRAWN BY	DESIGNED BY	CHECKED BY	SHEET NO.
JOB NUMBER	DATE	SCALE	3 of 20
14023	JULY 2014	1"=100'	

AS-BUILT MARCH 2015
 INFORMATION PROVIDED BY CONTRACTORS
 (NOT FIELD VERIFIED)