


NOTE:
 THE CONTRACTOR SHALL CONTACT NTMWD ENGINEERING AT
 (972) 442-5405 AT LEAST 48 HOURS PRIOR TO PERFORMING ANY
 WORK IN THE VICINITY OF THE NTMWD FACILITIES.

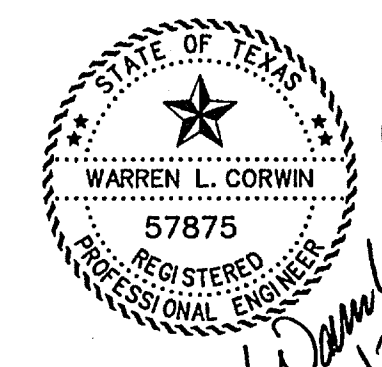

The seal appearing on
 this document was
 authorized by
 Warren L. Corwin,
 P.E. 57875, on
 July 29, 2014

CORWIN ENGINEERING, INC.
 200 W. BELMONT, SUITE E
 ALLEN, TEXAS 75013 (972)396-1200
 TBPE FIRM #5951

DEVELOPMENT PLANS FOR
**BREEZY HILL
 PHASE III**
 ROCKWALL, TEXAS

SANITARY SEWER PROFILES

AS-BUILT MARCH 2015
 INFORMATION PROVIDED BY CONTRACTORS
 (NOT FIELD VERIFIED)

DRAWN BY	DESIGNED BY	CHECKED BY	SHEET NO.
14023	JULY 2014	SCALE: HOR: 1"=40' VER: 1"=4'	10 OF 20