


**DRAINAGE BASIN ATTRIBUTES**

Basin #	Sq. Ft.	Acres	Sq. Mi.	Open Space	Single Family Lot Size			Weighted CN	Q100 (cfs)
					1/4 Acre	1/2 Acre	2 Acres+		
1	1087250	24.96	0.0390			1087250	91.29	169.7	
2	865643	19.87	0.0311			865643	91.29	149.0	
3	1565754	35.94	0.0562			1565754	91.29	245.2	
4	2047312	47.00	0.0734			2047312	91.29	338.9	
5 (Ex)	1631603	37.46	0.0585	1631603			90.20	243.6	
5 (Prop)	794944	18.25	0.0285	468806	326138		91.72	279.5	
6 (Ex)	1394802	32.02	0.0500	1394802			90.20	219.4	
6 (Prop)	1855127	42.59	0.0655	630629	734526	489962	90.37	233.9	
7 (Ex)	1432208	32.88	0.0514	1432208			90.20	250.8	
7 (Prop)	1466440	33.66	0.0526	821521	644919		91.37	237.1	
8 (Ex)	927004	21.28	0.0333	927004			90.20	137.3	
8 (Prop)	812369	18.65	0.0291	812369			90.20	157.7	

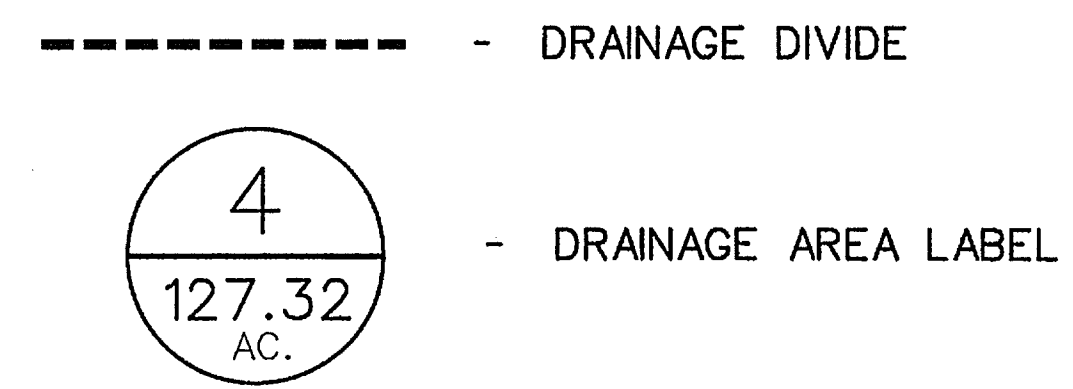

The seal appearing on this document was authorized by Brandon Davidson P.E. 87682, on July 29, 2014.

**CORWIN ENGINEERING, INC.**  
 200 W. BELMONT, SUITE E  
 ALLEN, TEXAS 75013 (972)396-1200  
 TBPE FIRM #5951

DEVELOPMENT PLANS FOR  
**BREEZY HILL  
 PHASE III**  
 ROCKWALL, TEXAS

OVERALL DRAINAGE AREA MAP

DRAWN BY	DESIGNED BY	CHECKED BY	SHEET NO.
JOB NUMBER	DATE	SCALE:	3A OF 20
14023	JULY 2014	1"=200'	

**AS-BUILT MARCH 2015**  
 INFORMATION PROVIDED BY CONTRACTORS  
 (NOT FIELD VERIFIED)