




SCALE: 1" = 50'

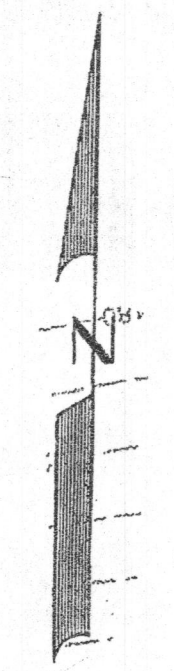

DATE	BY	NO. DATE	REVISION	BY
DES. 10-30-14	TJW			
DRN. 10-30-14	TJW			
CHK. 10-30-14	AMB			


FALKOFSKE ENGINEERING, INC.
 Structural Engineering Consultants
 Texas Registered Engineering Firm: # F-4038
 722 North Fielder Road
 Arlington, Texas 76012
 (817) 261-8300

The use of these plans, notes, specifications and drawings for any purpose other than that intended by the engineer is prohibited. No liability shall be assumed for any damage or injury resulting from the use of these plans, notes, specifications and drawings for any purpose other than that intended by the engineer. This document is the property of FALKOFSKE ENGINEERING, INC. and its use is restricted to the project and location specified herein.

SITE PLAN
 BREZY HILL - PHASE 4
 LIFE SPRINGS DRIVE AT JOHN KING BOULEVARD
 ROCKWALL, TEXAS
 RPM xCONSTRUCTION, LLC
 PLANO, TEXAS

RELEASED FOR CONSTRUCTION
 ALL RESPONSIBILITY FOR ADEQUACY OF DESIGN
 REMAINS WITH THE DESIGN ENGINEER. THE CITY
 OF ROCKWALL, IN REVIEWING AND RELEASING
 THESE PLANS FOR CONSTRUCTION, ASSUMES NO
 RESPONSIBILITY FOR ADEQUACY OR ACCURACY
 OF DESIGN.

11-17-14
 DATE

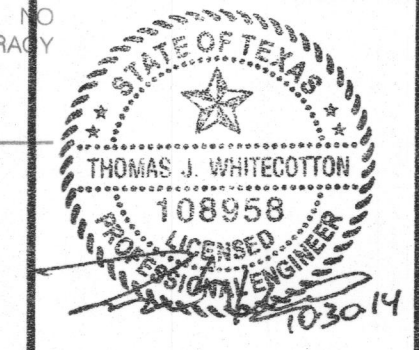

JOB NO. 285.14

SP1