


DEVELOPMENT PLANS FOR BREEZY HILL PHASE IV CITY OF ROCKWALL, TEXAS

INDEX

1	TITLE
2	PLAT
3	DRAINAGE AREA MAP
4	DRAINAGE CALCULATIONS
5	LIFE SPRING DRIVE
6	LIFE SPRING DRIVE & TURN LANE
7	SENEY DRIVE
8	LIMMERHILL DRIVE
9	KETTEN DRIVE
10	WATER AND SANITARY SEWER PLAN
10B	16" WATER LINE PROFILE
11	SANITARY SEWER PROFILES
12	SANITARY SEWER PROFILES
13	STORM SEWER PLAN AND PROFILE LINE 'D-1'
14	STORM SEWER PLAN AND PROFILE LINES 'D-1' & 'D-3'
15	STORM SEWER PLAN AND PROFILE LINE 'D-2'
16	GRADING PLAN
17	GRADING PLAN
18	EROSION CONTROL PLAN
19	SIGN AND LIGHT PLAN

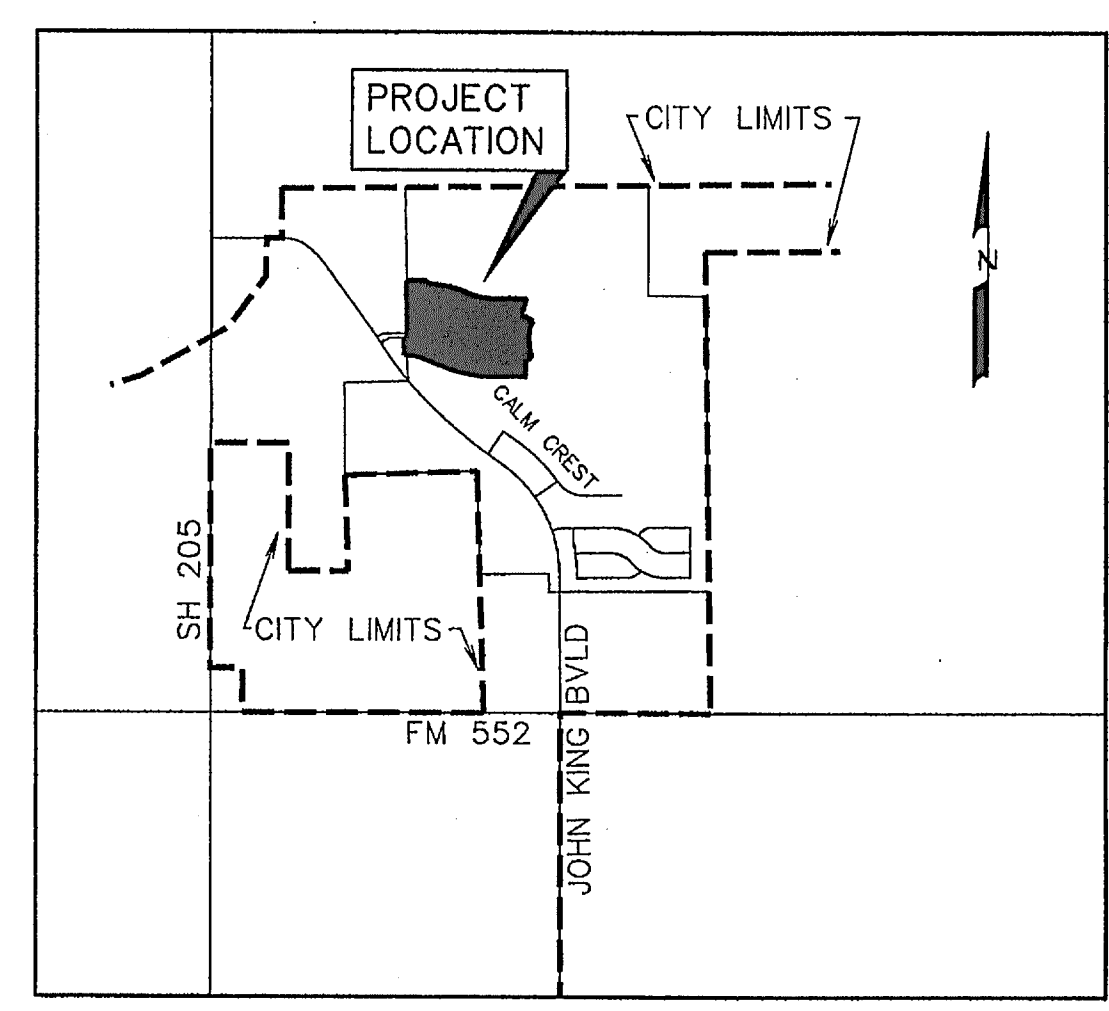

VICINITY MAP
NOT TO SCALE


PREPARED FOR
BH PHASE IV SF, LTD.
8214 WESTCHESTER DRIVE, SUITE 710 DALLAS, TEXAS 75225

CORWIN ENGINEERING, INC. — CONSULTING ENGINEERS

200 W. BELMONT, SUITE E

TBPE FIRM #5951

ALLEN, TEXAS 75013

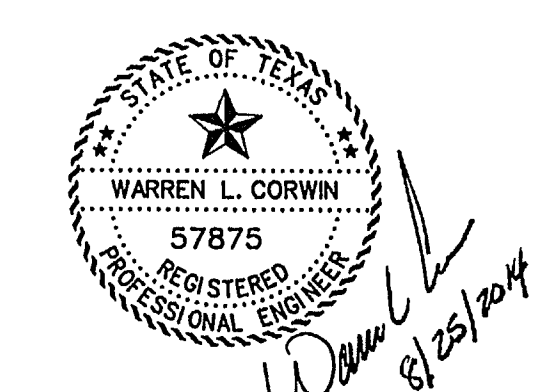

The seal appearing on this document was authorized by Warren L. Corwin, P.E. 57875, on August 25, 2014

AS-BUILT MARCH 2015
INFORMATION PROVIDED BY CONTRACTORS
(NOT FIELD VERIFIED)

NOTE:
CITY OF ROCKWALL STANDARDS
AND NCTCOG 3rd ADDITION STANDARDS
SHALL BE USED FOR REFERENCE.

2	CITY COMMENTS	6/13/14
1	CITY COMMENTS	5/30/14
NO.	REVISIONS	DATE