


**AS-BUILT MARCH 2015**  
 INFORMATION PROVIDED BY CONTRACTORS  
 (NOT FIELD VERIFIED)

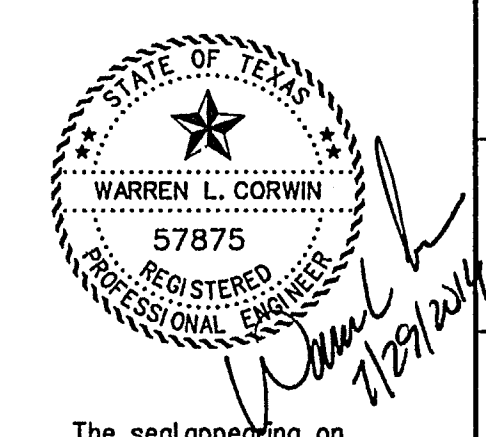

The seal appearing on this document was authorized by Warren L. Corwin, P.E. 57875, on July 29, 2014.

**CORWIN ENGINEERING, INC.**  
 200 W. BELMONT, SUITE E  
 ALLEN, TEXAS 75013 (972) 396-1200  
 TYPE FIRM #5951

DEVELOPMENT PLANS FOR  
**BREEZY HILL**  
 PHASE IV  
 ROCKWALL, TEXAS

16" WATER LINE PROFILE

DRAWN BY	DESIGNED BY	CHECKED BY	SHEET NO.
JOB NUMBER	DATE	SCALE: HOR: 1"=40' VER: 1"=4'	10B of 19
14025	JULY 2014		