


THE CHANNEL WILL BE REQUIRED TO BE CONSTRUCTED WITH BREEZY HILL PHASE 6 AND SEEDED AND ANCHORED CURLEX INSTALLED ALONG THE ENTIRE CHANNEL PRIOR TO BREEZY HILL PHASE 6 ACCEPTANCE. THE CONCRETE FLUME WILL BE PLACED WITH BREEZY HILL PHASE 8 CONSTRUCTION.

AS-BUILT AUGUST 2018  
INFORMATION PROVIDED  
BY CONTRACTORS  
(NOT FIELD VERIFIED)

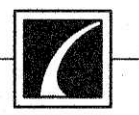

|   |             |                                  |           |
|---|-------------|----------------------------------|-----------|
|  <b>CORWIN ENGINEERING, INC.</b><br>200 W. BELMONT, SUITE E<br>ALLEN, TEXAS 75013 (972)396-1200<br>TBPE FIRM #5951 |             |                                  |           |
| DEVELOPMENT PLANS FOR<br><b>BREEZY HILL<br/>         PHASE VIII</b><br>ROCKWALL, TEXAS  |             |                                  |           |
| FLUME PLAN  |             |                                  |           |
| DRAWN BY  | DESIGNED BY | CHECKED BY                       | SHEET NO. |
| JOB NUMBER  | DATE        | SCALE: HOR: 1"=40'<br>VER: 1"=4' | 19        |
| 17039   | MARCH 2018  |                                  |           |