


DEVELOPMENT PLANS
FOR
BREEZY HILL
PHASE VII
CITY OF ROCKWALL, TEXAS

INDEX

- 1 TITLE
- 2 PLAT
- 3 DRAINAGE AREA MAP
- 4 DRAINAGE AREA MAP EXISTING CONDITIONS
- 5 CALM CREST DRIVE
- 6 WATER AND SANITARY SEWER PLAN
- 7 STORM SEWER PLAN AND PROFILE LINE 'D-1'
- 8 GRADING PLAN
- 9 STREET SIGN PLAN
- 10 EROSION CONTROL PLAN

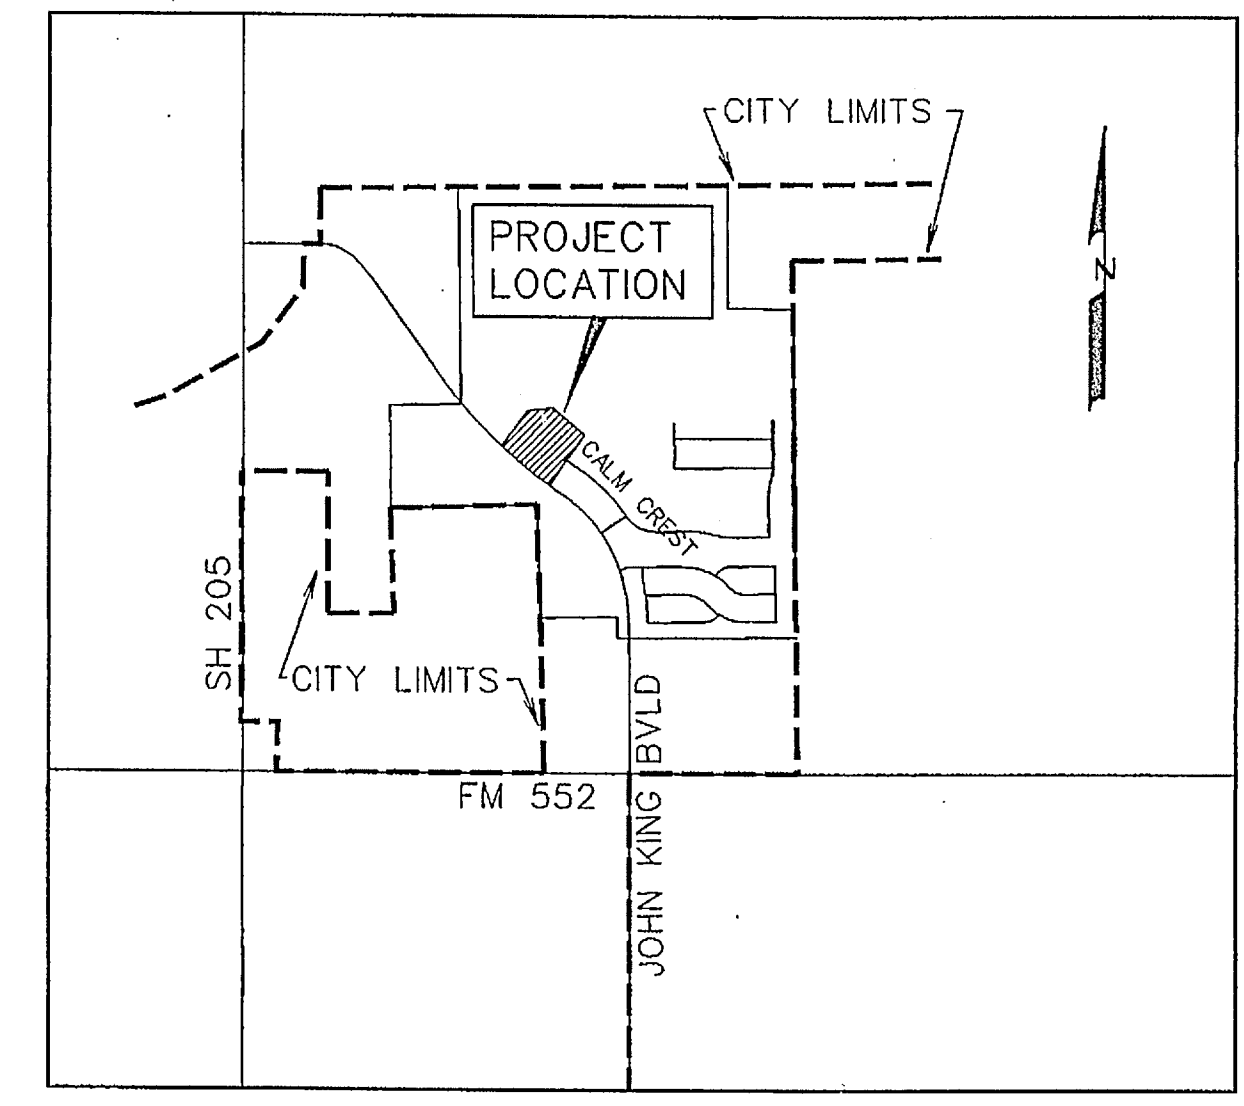

VICINITY MAP
NOT TO SCALE

PREPARED FOR
BH PHASE VISF, LTD.

8214 WESTCHESTER DRIVE, SUITE 710 DALLAS, TEXAS 75225


CORWIN ENGINEERING, INC. — CONSULTING ENGINEERS

200 W. BELMONT, SUITE E

TBPE FIRM #5951

ALLEN, TEXAS 75013

RELEASED FOR CONSTRUCTION
ALL RESPONSIBILITY FOR ADEQUACY OF DESIGN
REMAINS WITH THE DESIGN ENGINEER. THE CITY
OF ROCKWALL, IN REVIEWING AND RELEASING
PLANS FOR CONSTRUCTION, ASSUMES NO
RESPONSIBILITY FOR ADEQUACY OR ACCURACY
OF DESIGN.
CITY SW DATE 10-12-16

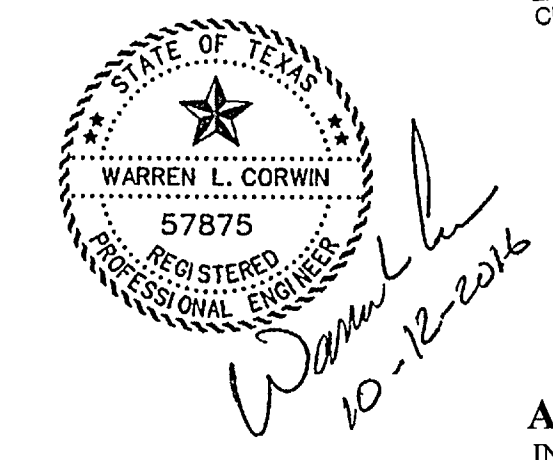

AS-BUILT JUNE 2017
INFORMATION PROVIDED BY
CONTRACTORS
(NOT FIELD VERIFIED)

NOTE:
CITY OF ROCKWALL STANDARDS
AND NCTCOG 3rd ADDITION STANDARDS
SHALL BE USED FOR REFERENCE.

NO.	REVISIONS	DATE