


# DEVELOPMENT PLANS FOR BREEZY HILL FORCE MAIN CITY OF ROCKWALL, TEXAS

## INDEX


1	TITLE
2	OVERALL MAP
3	FORCE MAIN STA 0+95 TO 13+00
4	FORCE MAIN STA 13+00 TO 24+00
5	FORCE MAIN STA 24+00 TO 36+00
6	FORCE MAIN STA 36+00 TO 48+00
7	FORCE MAIN STA 48+00 TO 60+00
8	FORCE MAIN STA 60+00 TO 72+00
9	FORCE MAIN STA 72+00 TO 83+00
10	FORCE MAIN STA 83+00 TO END, SANITARY SEWER LINE 'S-1'
LS-1	LIFT STATION SITE PLAN

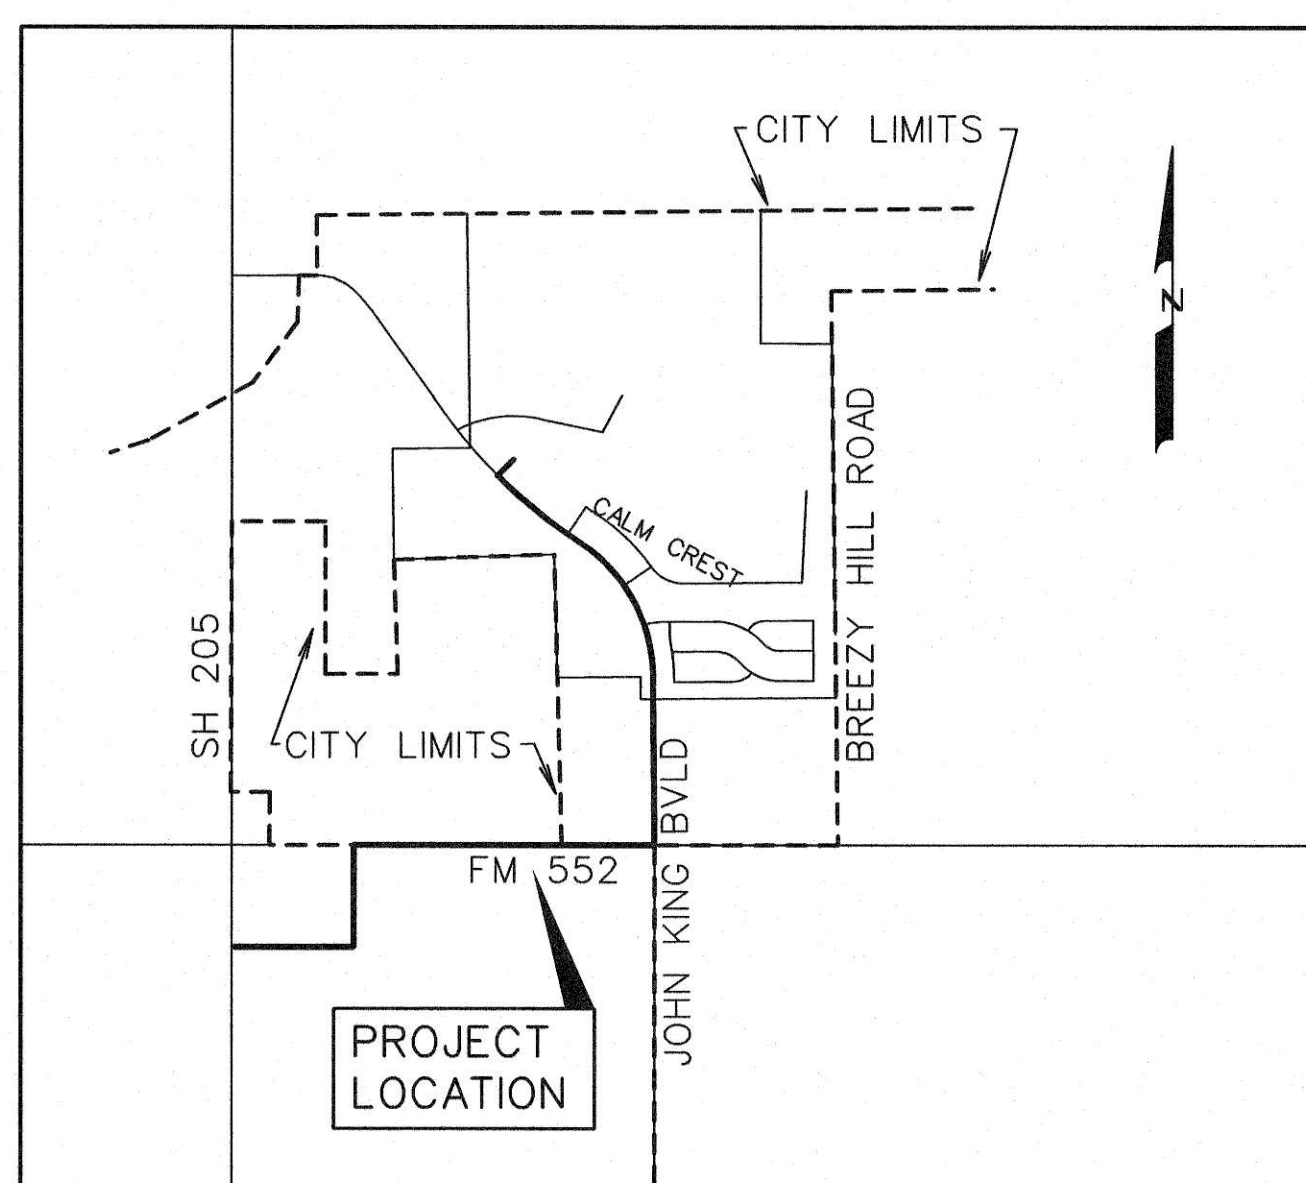

VICINITY MAP  
NOT TO SCALE

PREPARED FOR  
BH PHASE VISF, LTD.  
8214 WESTCHESTER DRIVE, SUITE 710 DALLAS, TEXAS 75225

**CORWIN ENGINEERING, INC. — CONSULTING ENGINEERS**  
200 W. BELMONT, SUITE E                      TBPE FIRM #5951                      ALLEN, TEXAS 75013

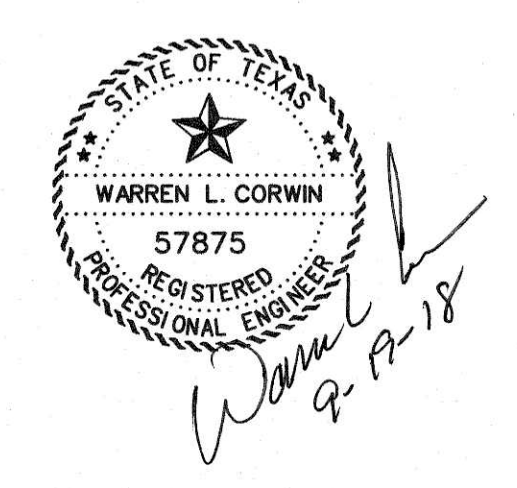

AS-BUILT SEPTEMBER 2018  
INFORMATION PROVIDED  
BY CONTRACTORS  
(NOT FIELD VERIFIED)

NOTE:  
CITY OF ROCKWALL STANDARDS  
AND NCTCOG 3rd ADDITION STANDARDS  
SHALL BE USED FOR REFERENCE.

NO.	REVISIONS	DATE