

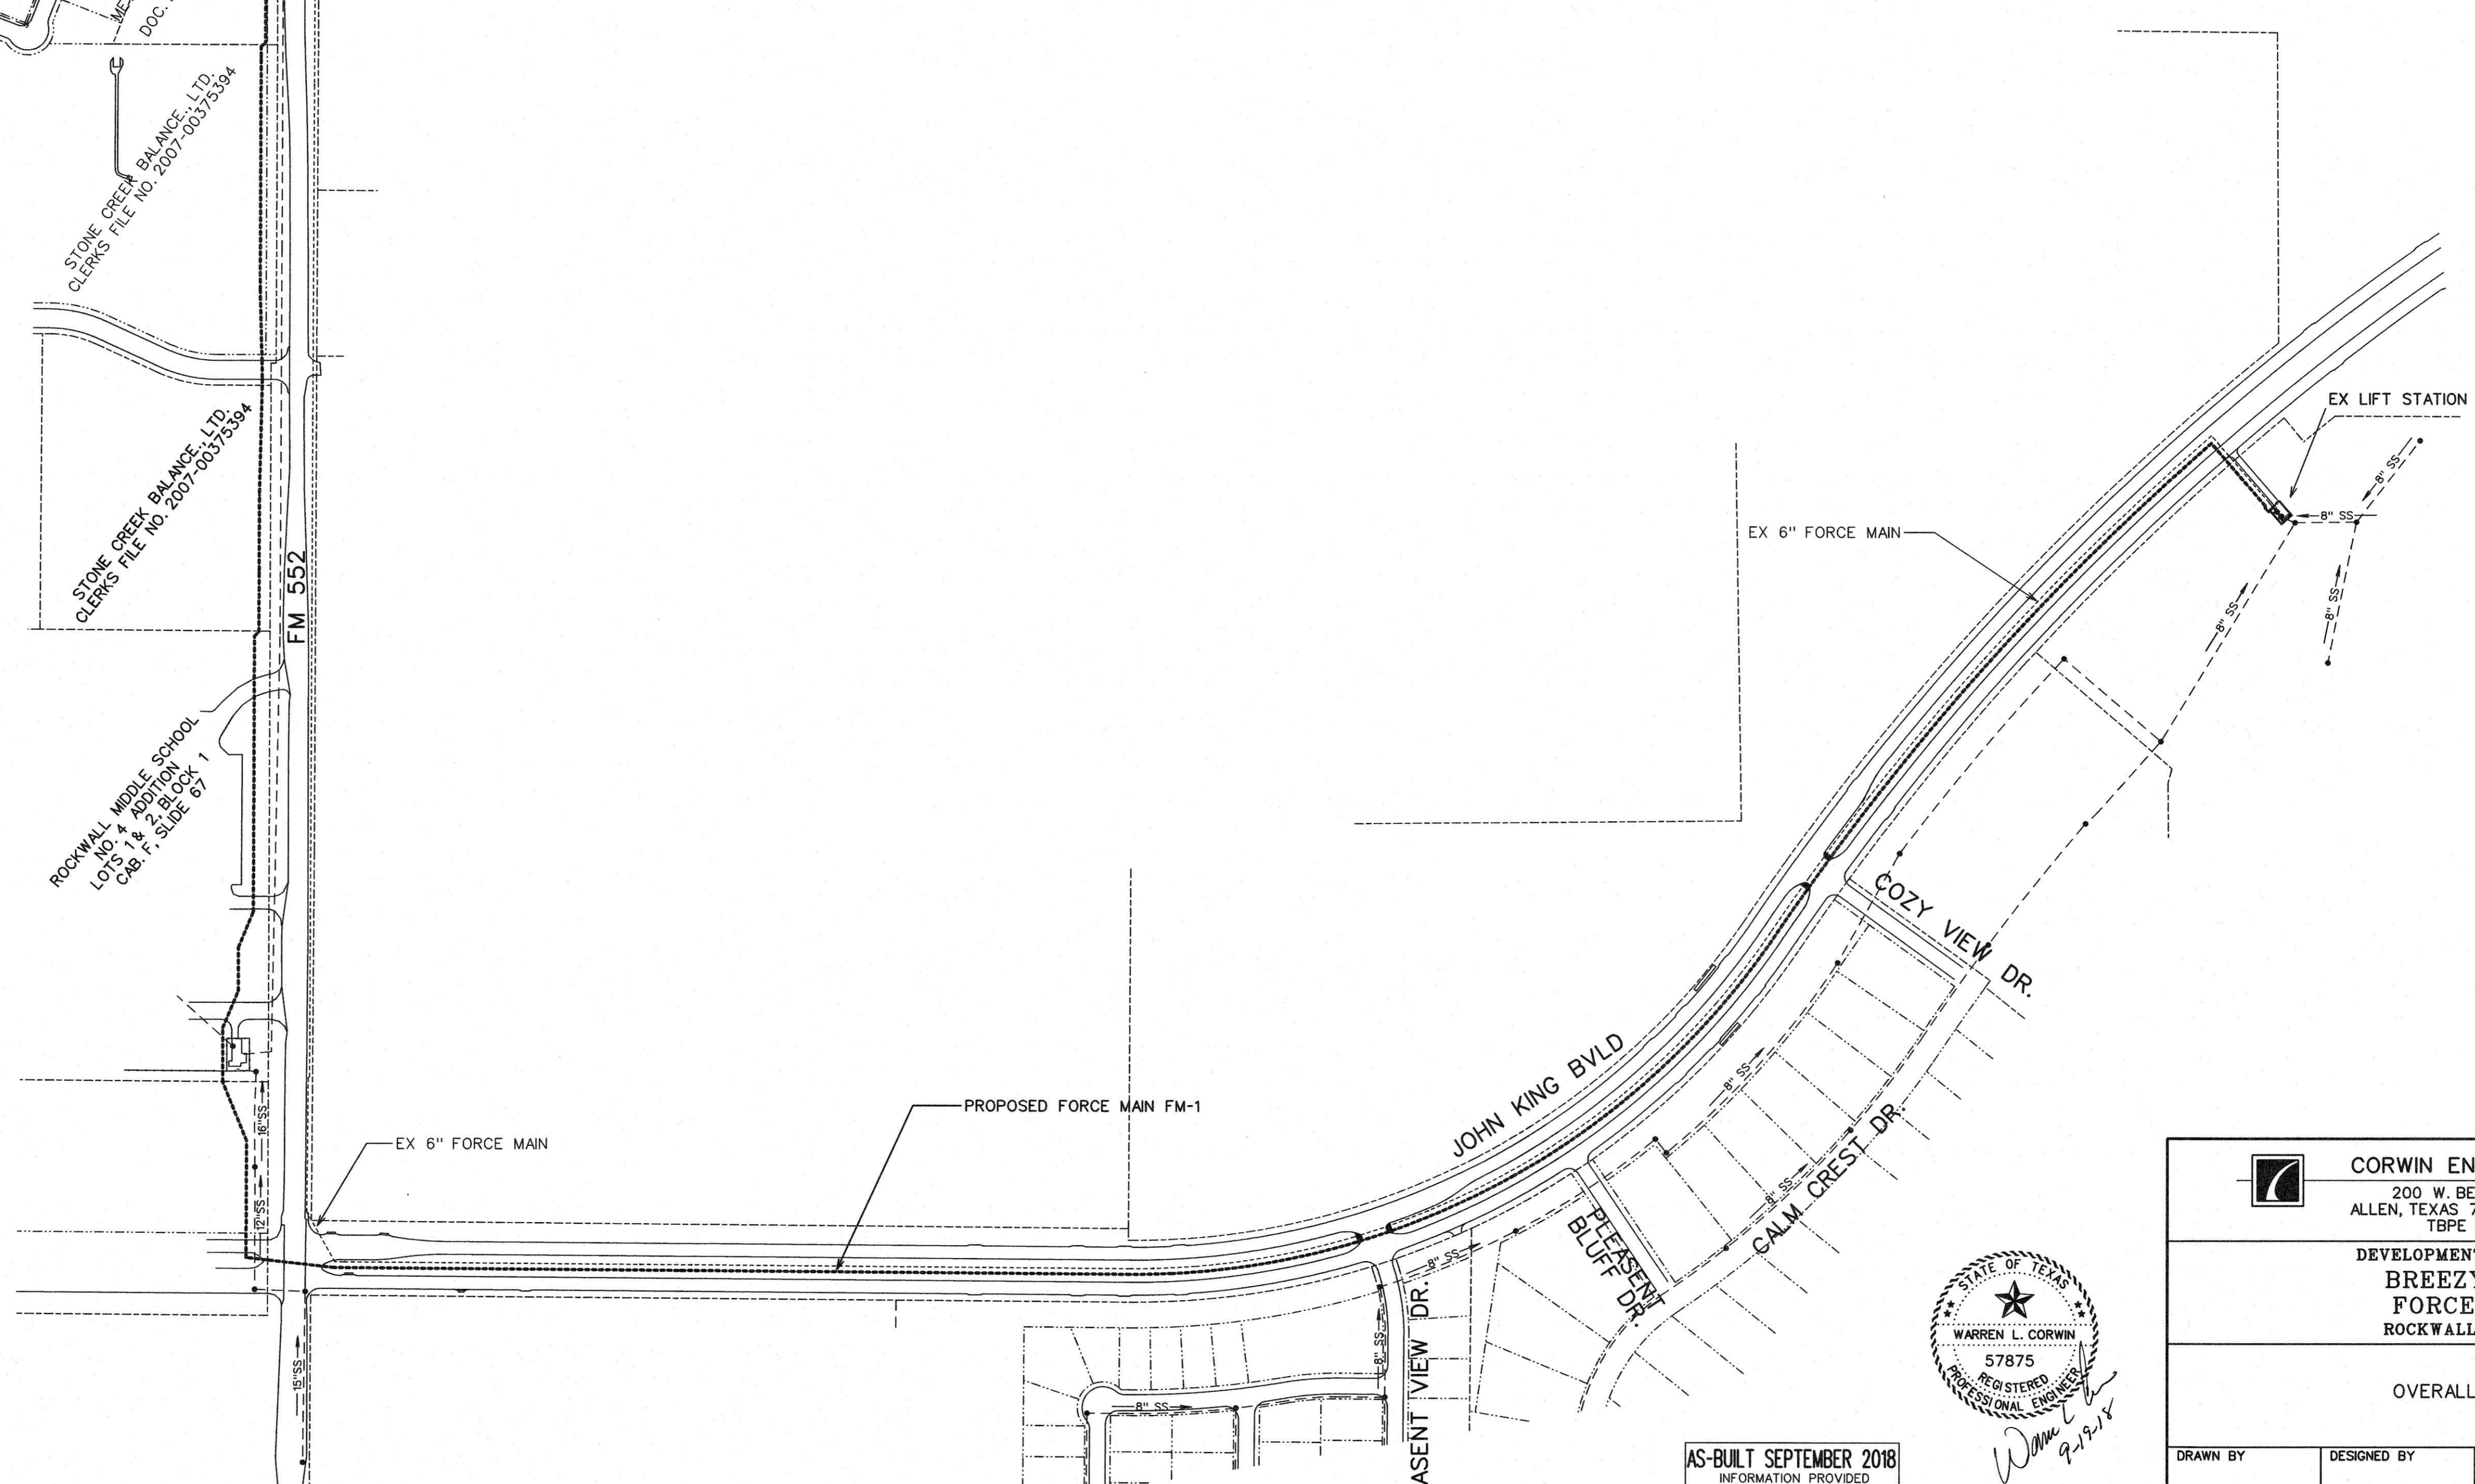


SCALE: 1" = 200'

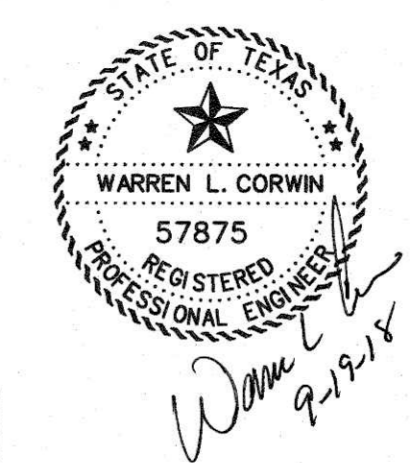

AS-BUILT SEPTEMBER 2018  
 INFORMATION PROVIDED  
 BY CONTRACTORS  
 (NOT FIELD VERIFIED)

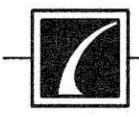

 <b>CORWIN ENGINEERING, INC.</b> 200 W. BELMONT, SUITE E ALLEN, TEXAS 75013 (972)396-1200 TBPE FIRM #5951			
DEVELOPMENT PLANS FOR <b>BREEZY HILL          FORCE MAIN</b> ROCKWALL, TEXAS			
OVERALL MAP			
DRAWN BY	DESIGNED BY	CHECKED BY	SHEET NO.
JOB NUMBER	DATE	SCALE:	2 of 10
16029	JULY 2016	1"=200'	