

CONSTRUCTION
OF
ECKERD DRUGSTORE
No. 2659R
ROCKWALL, TEXAS

FOR
CNL DEVELOPMENT
ORLANDO, FLORIDA


**RECORD
DRAWING**

INDEX OF DRAWINGS

SHEET No.	TITLE
1.	COVER SHEET & INDEX
2.	PLAT
2A.	PLAT DEDICATION
3.	GENERAL NOTES
4.	DIMENSION PLAN
5.	UTILITY PLAN
6.	GRADING PLAN
7.	DRAINAGE PLAN
8.	OFFSITE DRAINAGE PLAN
9.	EROSION CONTROL PLAN
10.	IRRIGATION PLAN
11.	LANDSCAPE EXHIBIT
12.	TREESCAPE EXHIBIT
13.	CROSS ACCESS DRIVE
14.	PAVING AND MISCELLANEOUS DETAILS
15.	RETAINING WALL AND MISCELLANEOUS DETAILS

SEPTEMBER 1997

JONES & CARTER, INC.
Consulting Engineers
12000 Ford Road, Suite 180 Dallas, Texas 75234 (972) 489-8880

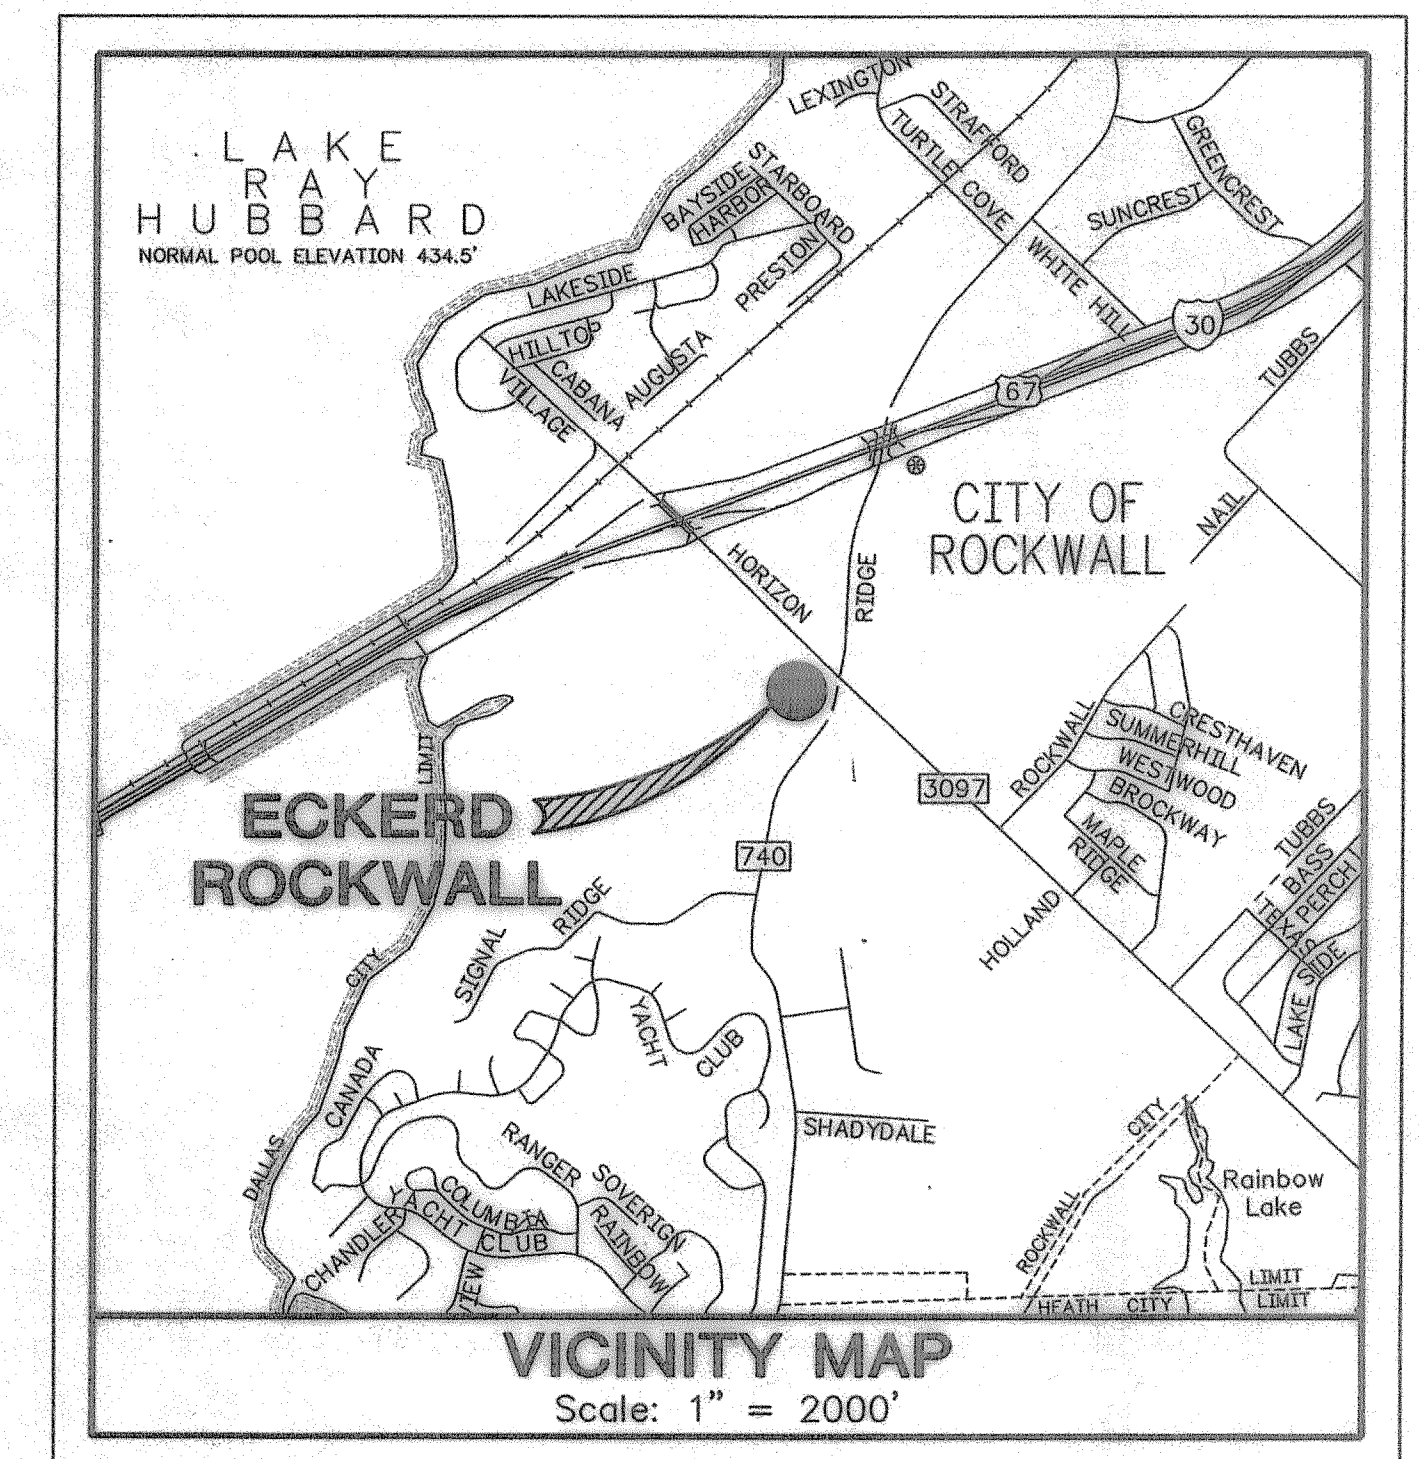

DALLAS MAPSCO : 33C-F



ECKERD DRUGSTORE No. 2659R - ROCKWALL, TEXAS - D0014-003

JONES & CARTER, INC.
Consulting Engineers
Dallas, Texas

SHEET No.
1
OF 15