



PROJECT BENCHMARK
 15" CUT IN THE CENTER OF A
 16.0' INLET ON THE NORTH
 SIDE OF HORIZON ROAD
 APPROX. 330' WEST OF THE
 INTERSECTION OF F.M. 740
 AND HORIZON ROAD
 ELEVATION = 557.58

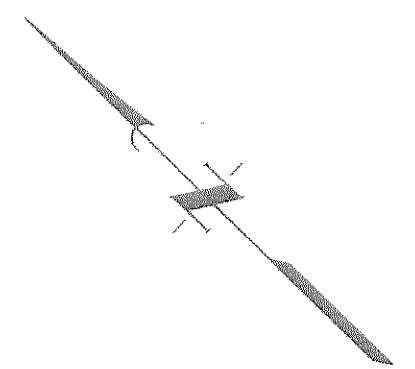

HORIZON ROAD
 (65' ROW)

Sawcut and Remove
 Exist Curb & Gutter
 Match Exist Grade

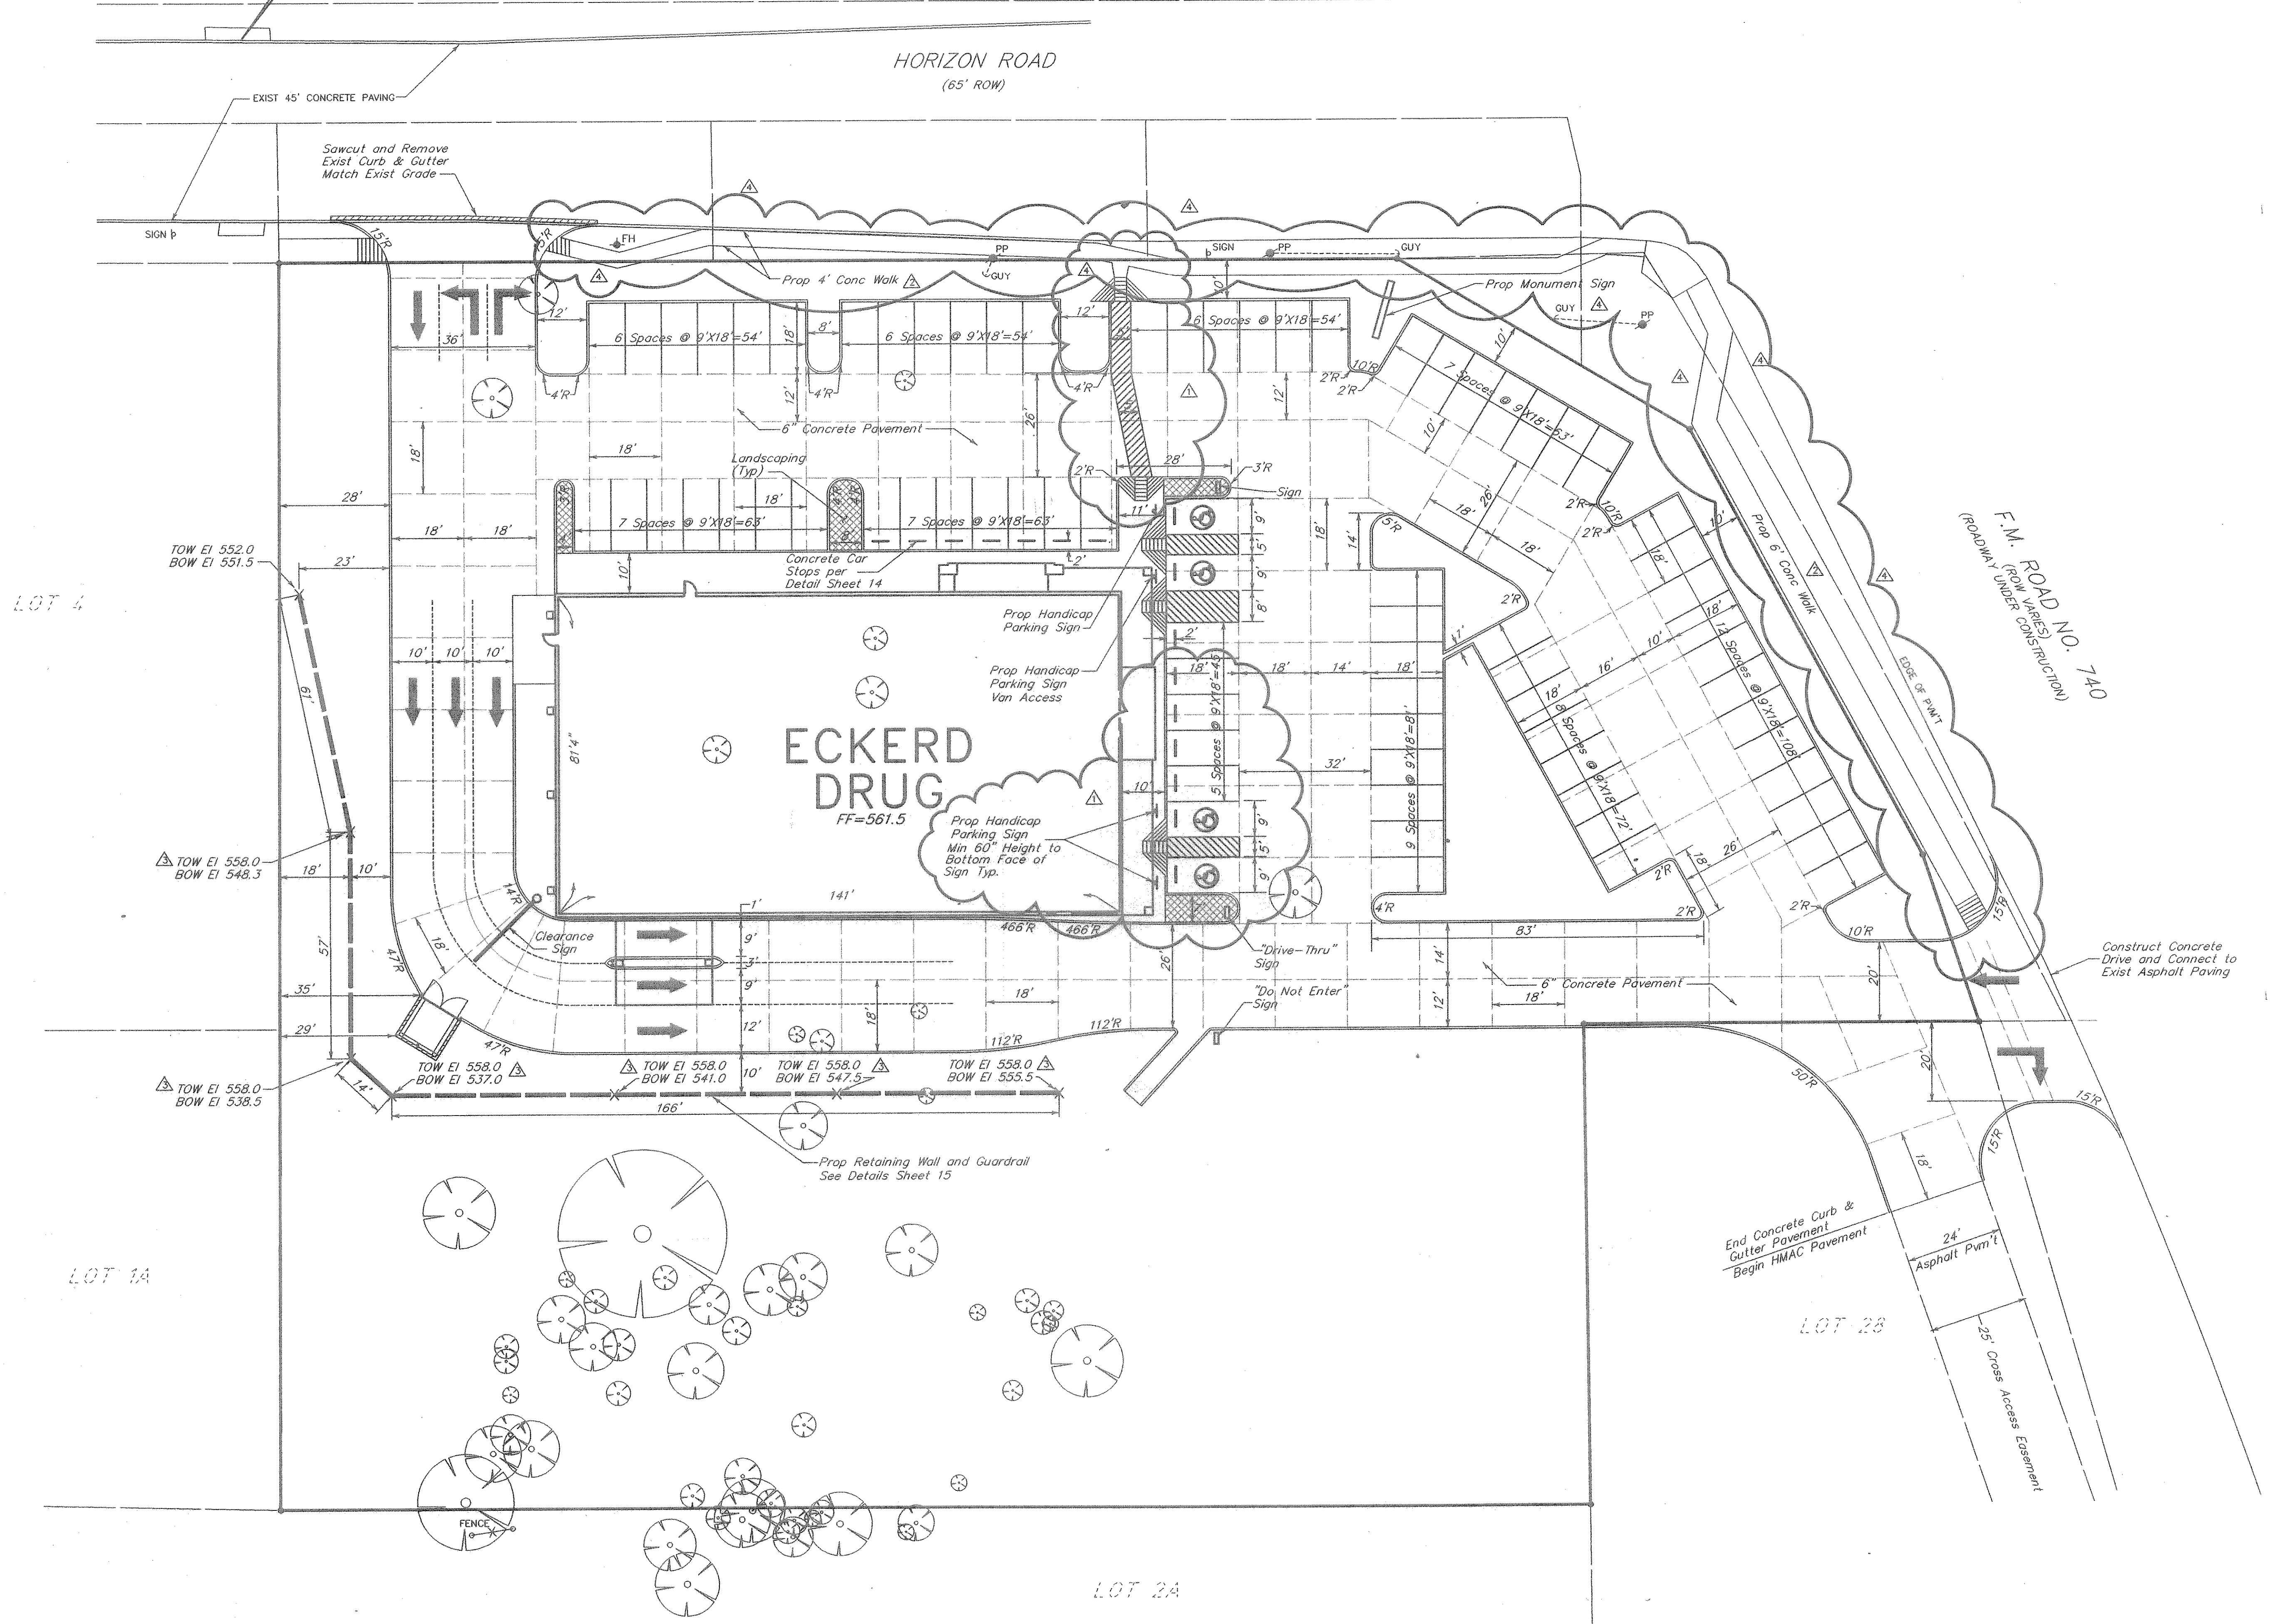

NOTE: MAXIMUM CROSS-SLOPE ON
 CONCRETE SIDEWALK NOT TO
 EXCEED 2%

**RECORD
 DRAWING**

NO.	DATE	REVISIONS	APP.
2/16/98		REVISED SIDEWALK WIDTH AND LOCATION	TMS
1/14/98		REVISED RETAINING WALL HEIGHT	TMS
10/16/97		REVISED SIDEWALK WIDTH	TMS
9/23/97		ADDED 2 HANDICAP PARKING SPACES	WR


CNL DEVELOPMENT
 ORLANDO, FLORIDA

ECKERD DRUGSTORE No. 2659R
 ROCKWALL, TEXAS

**DIMENSION CONTROL
 PLAN**

JONES & CARTER, INC.
 Consulting Engineers
 12000 Ford Rd., Suite 100 Dallas, Texas 75224 (972) 486-2880

SCALE: 1"=20' DGN. BY: BPW
 DATE: AUGUST 1997 DWN. BY: GSH
 JOB NO. D0014-003 DWG. NO. D0014-066

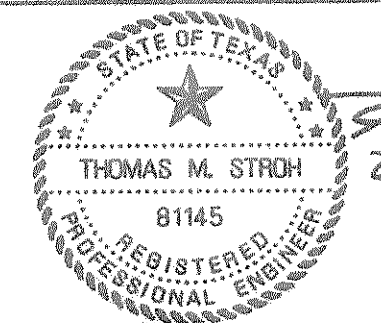

THOMAS M. STRUB
 2-16-98
 SHEET NO.
 4
 OF 15