

See Sheet 7 for Offsite
Drainage Calculations

See Sheet 7 for Onsite
Drainage Areas

**RECORD
DRAWING**

NO.	DATE	REVISIONS	APP.


CNL DEVELOPMENT
ORLANDO, FLORIDA

ECKERD DRUGSTORE No. 2659R
ROCKWALL, TEXAS

**OFFSITE DRAINAGE
PLAN**

JC JONES & CARTER, INC.
Consulting Engineers
12000 Ford Rd., Suite 180 Dallas, Texas 75224 (972) 488-2890

SCALE: 1"=60' DGN. BY: BPW
DATE: AUGUST 1997 DWN. BY: GSH
JOB NO. D0014-003 DWG. NO. D0014-072

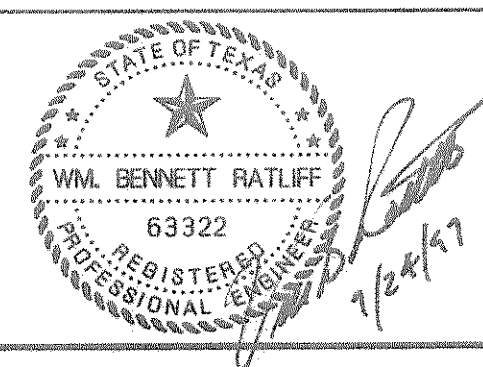

SHEET NO.
8
OF 15