



TYPICAL SECTION - VERSA-LOK REINFORCED RETAINING WALL

MODULAR CONCRETE UNIT
SCALE: NONE

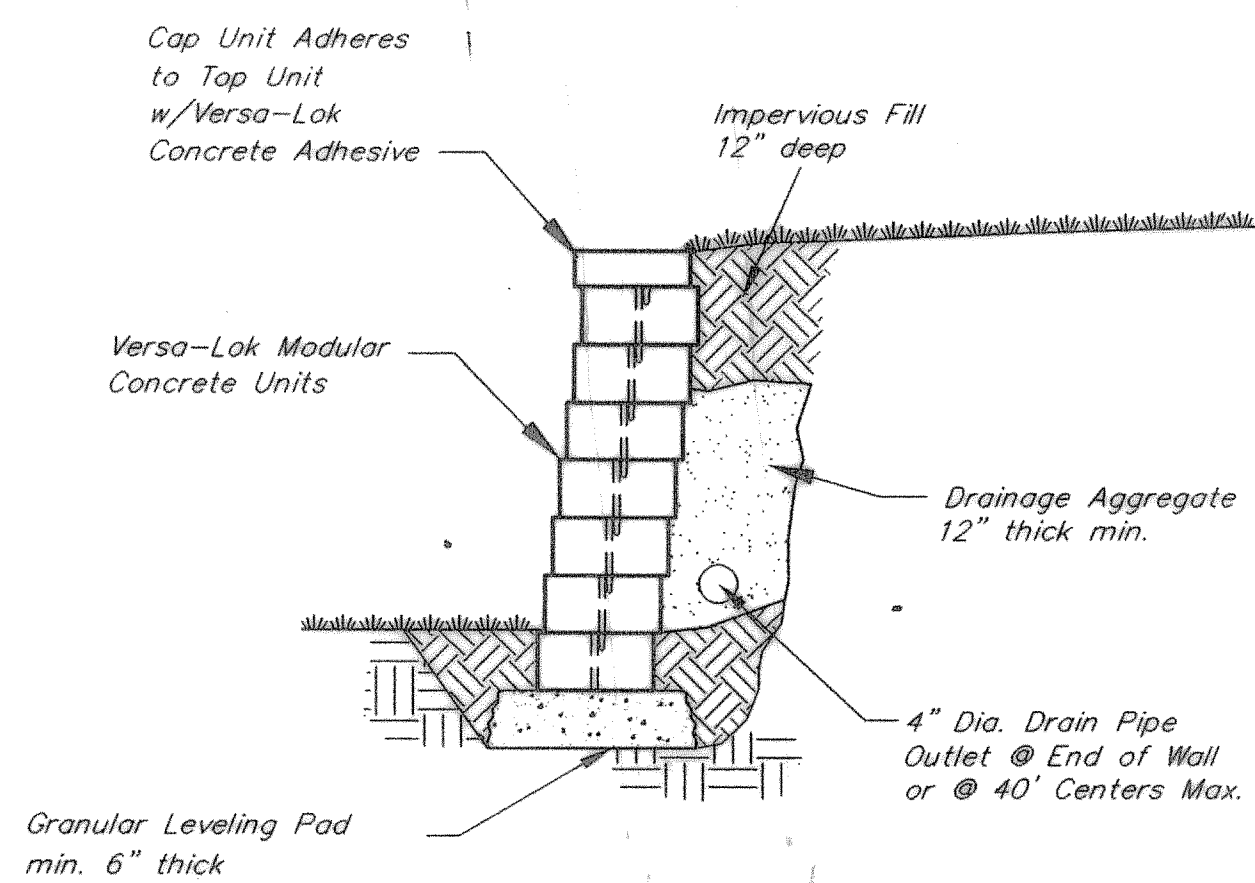




TYPICAL SECTION - VERSA-LOK UNREINFORCED RETAINING WALL

SCALE: NONE

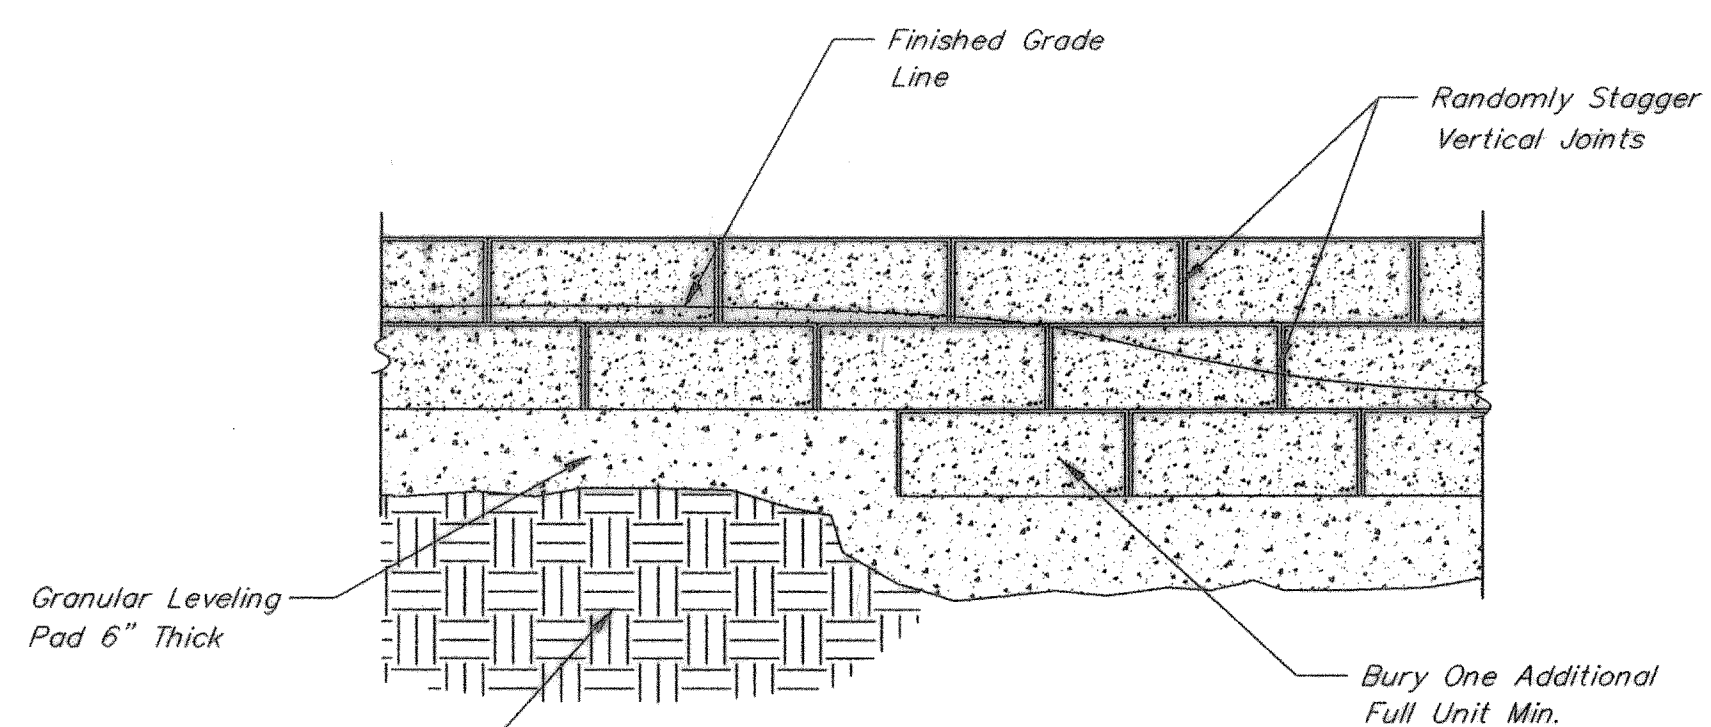

STEPPING BASE DETAIL

SCALE: NONE

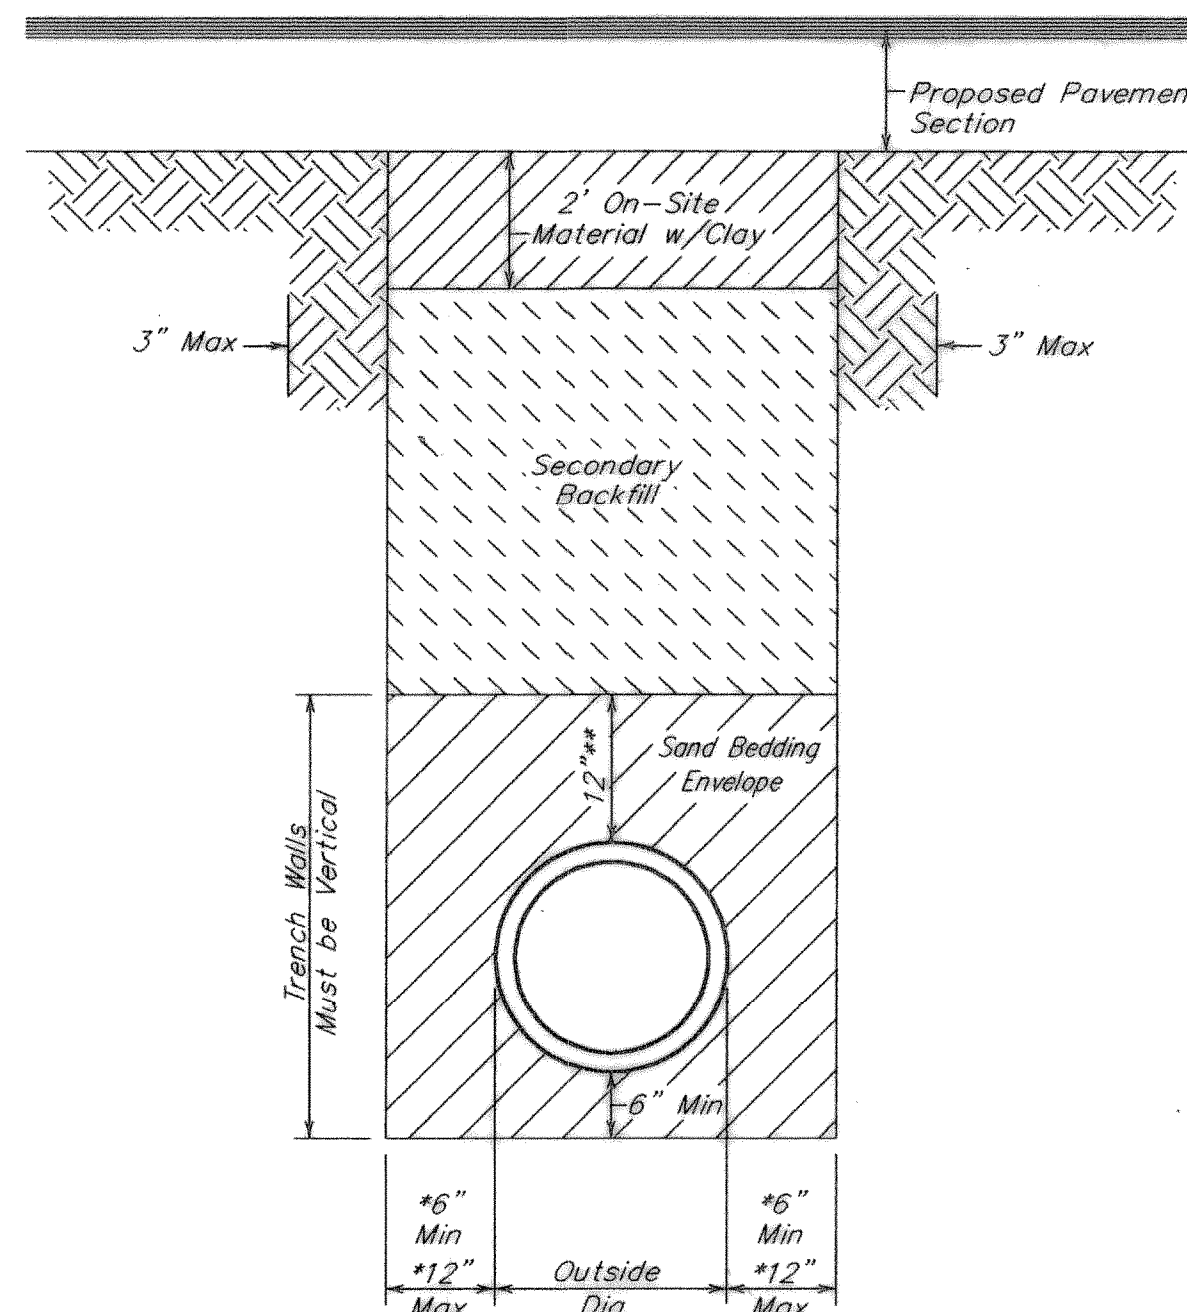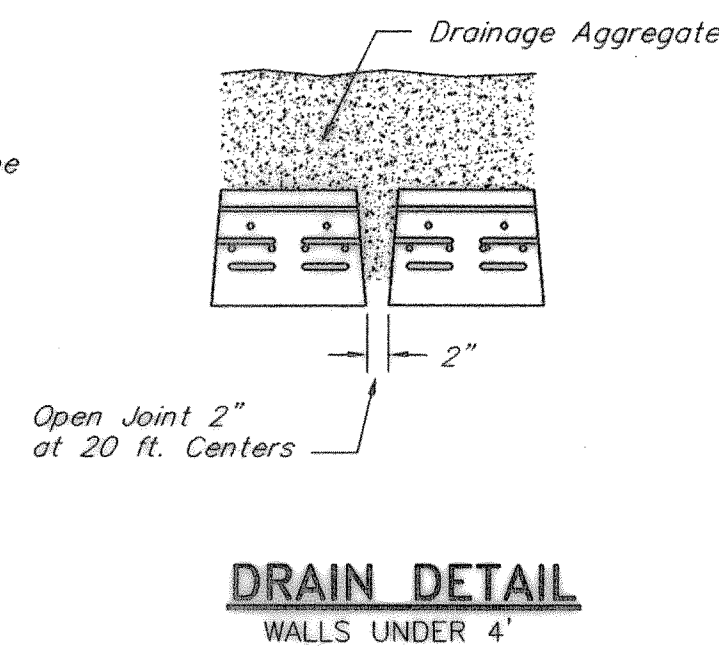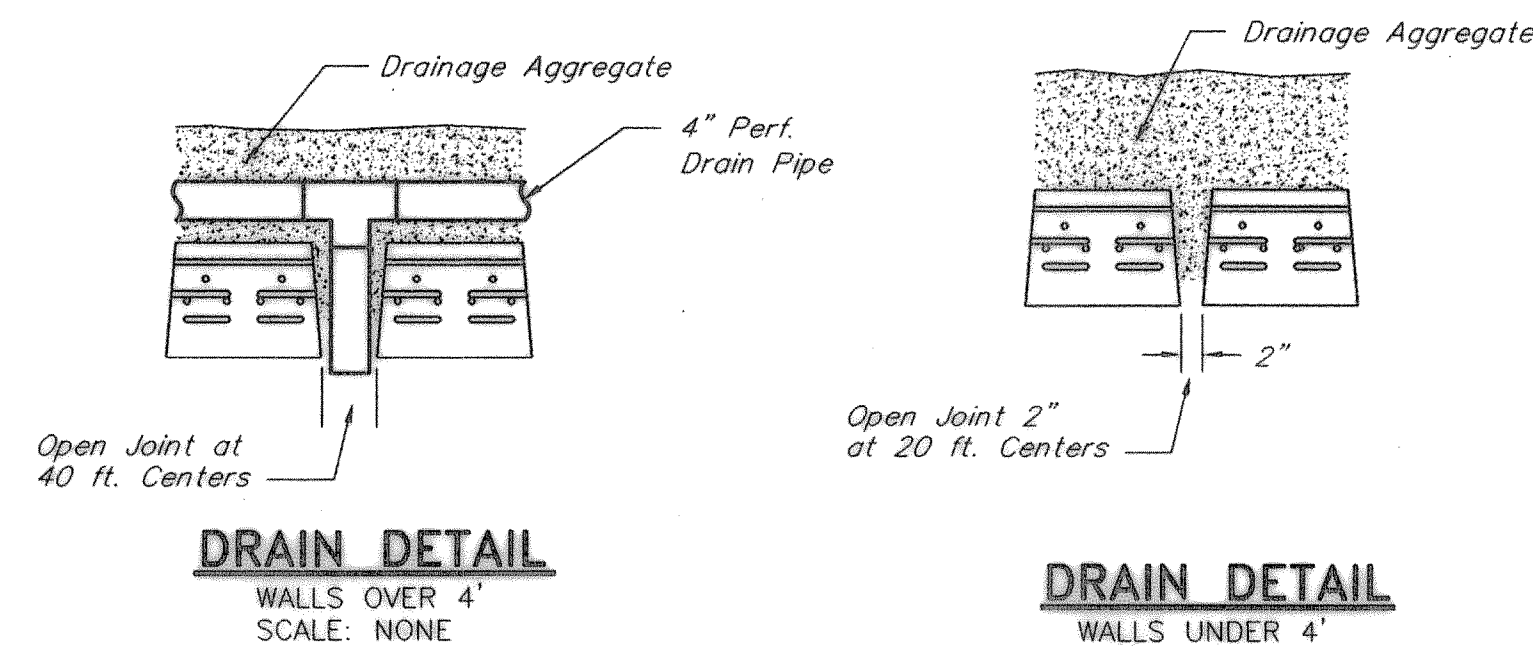


*NOTE : 6" MIN., 12" MAX. FOR WATER & WASTEWATER LINES.
12" FOR STORM WATER

**NOTE : FOR WATER & WASTEWATER LINES ONLY
BEDDING TO TOP OF PIPE FOR STORM SEWER


PIPE TRENCH DETAIL

N.T.S.

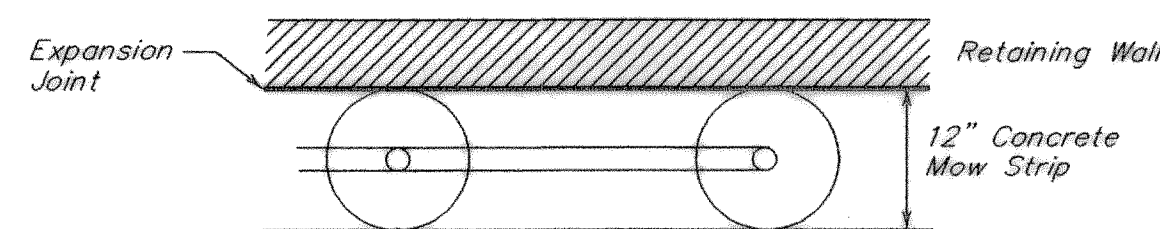


PLAN VIEW

N.T.S.

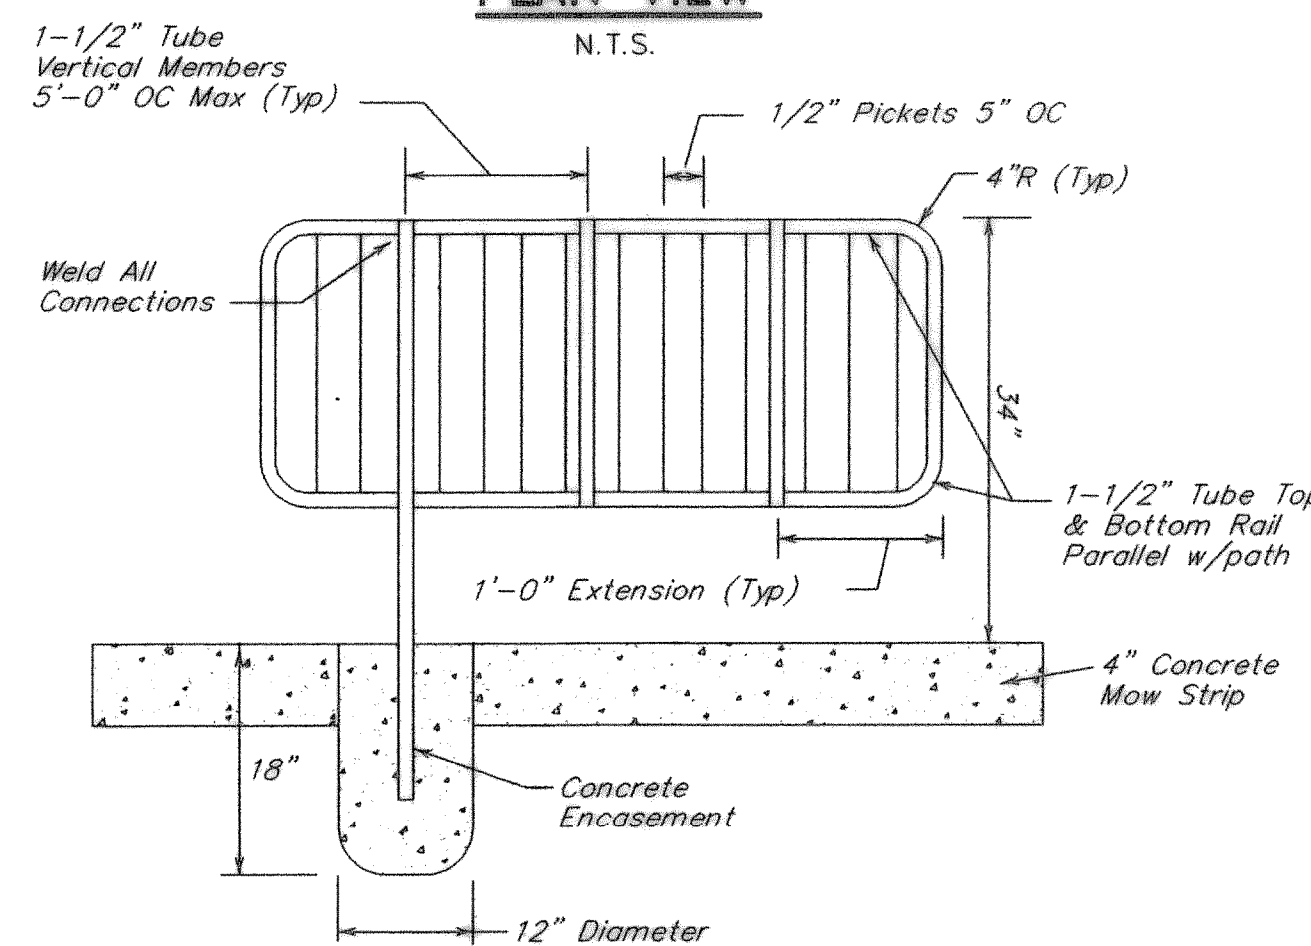


TYPICAL GUARDRAIL

N.T.S.

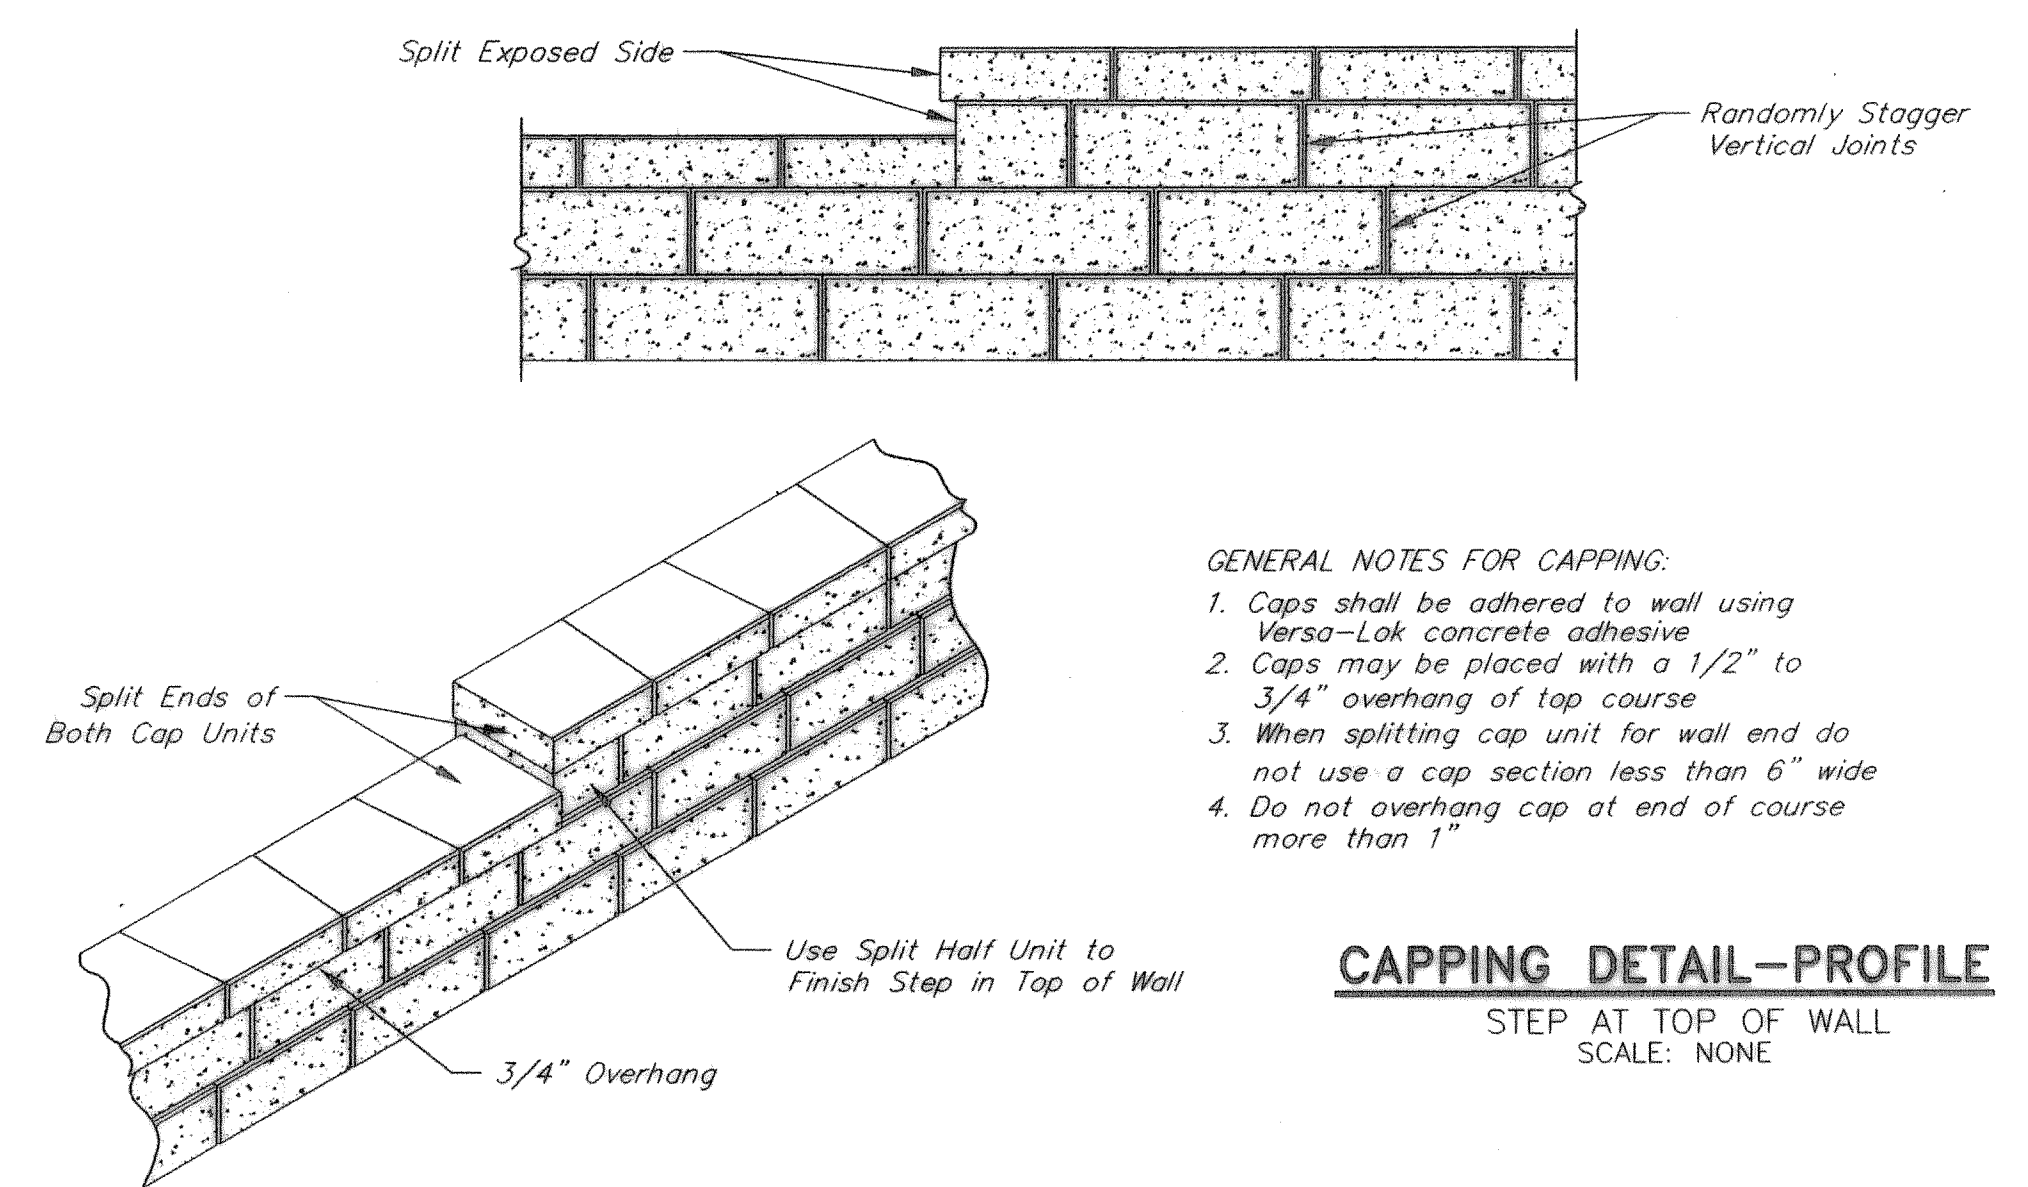


- GENERAL NOTES FOR CAPPING:
1. Caps shall be adhered to wall using Versa-Lok concrete adhesive
 2. Caps may be placed with a 1/2" to 3/4" overhang of top course
 3. When splitting cap unit for wall end do not use a cap section less than 6" wide
 4. Do not overhang cap at end of course more than 1"

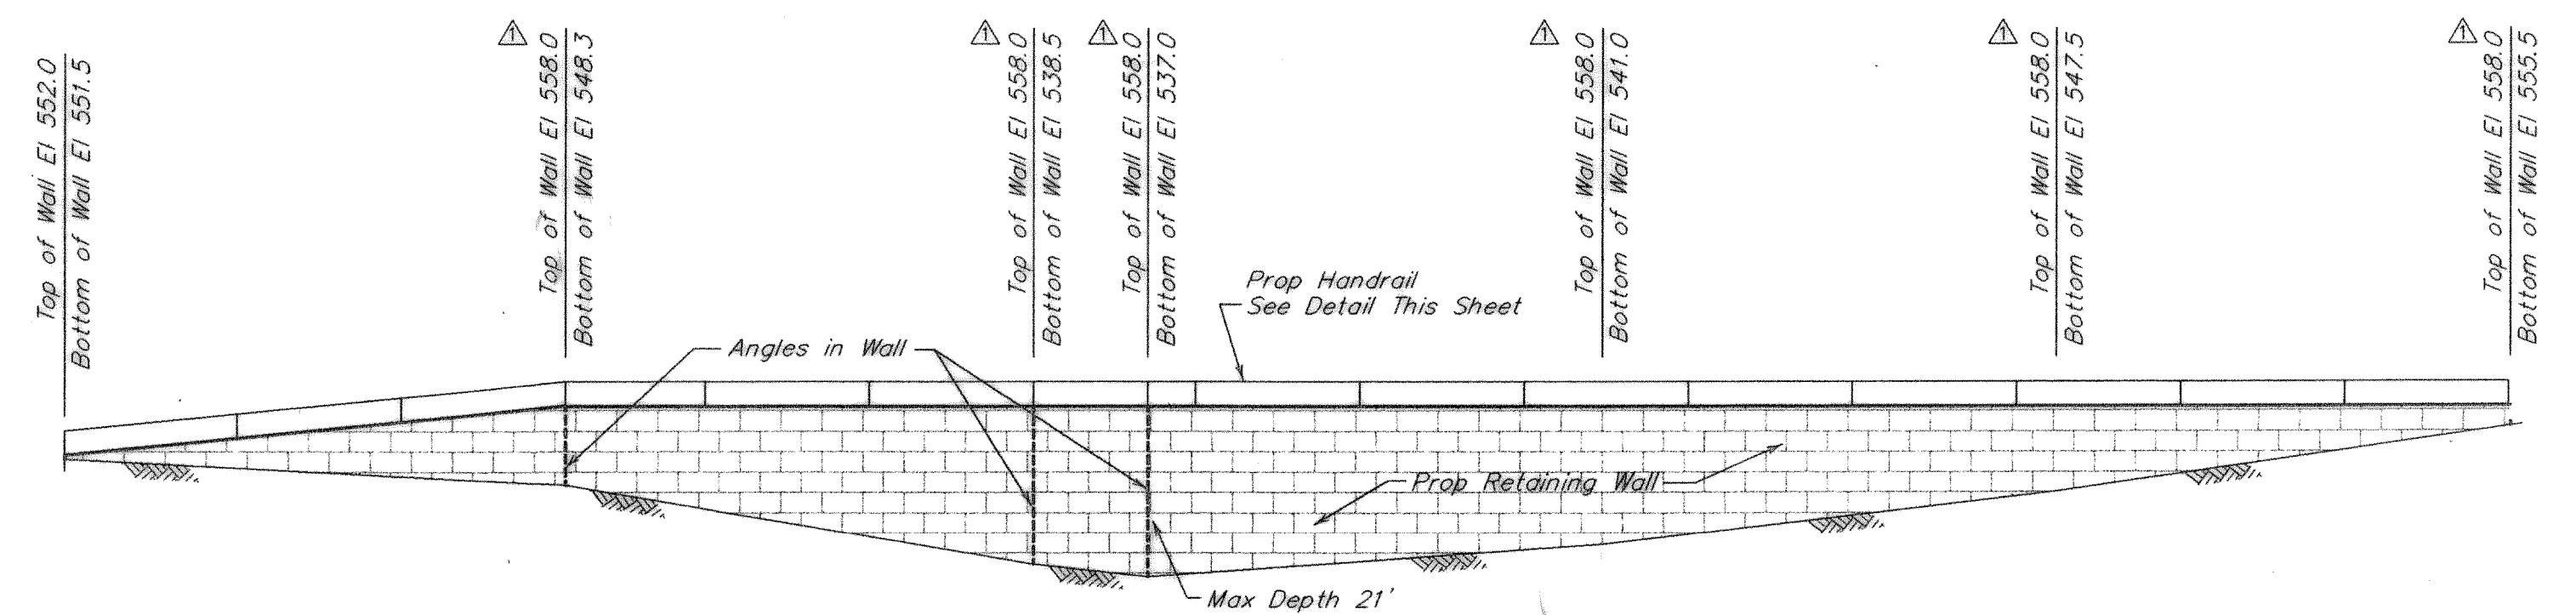


RETAINING WALL-PROFILE

SCALE 1"=20'

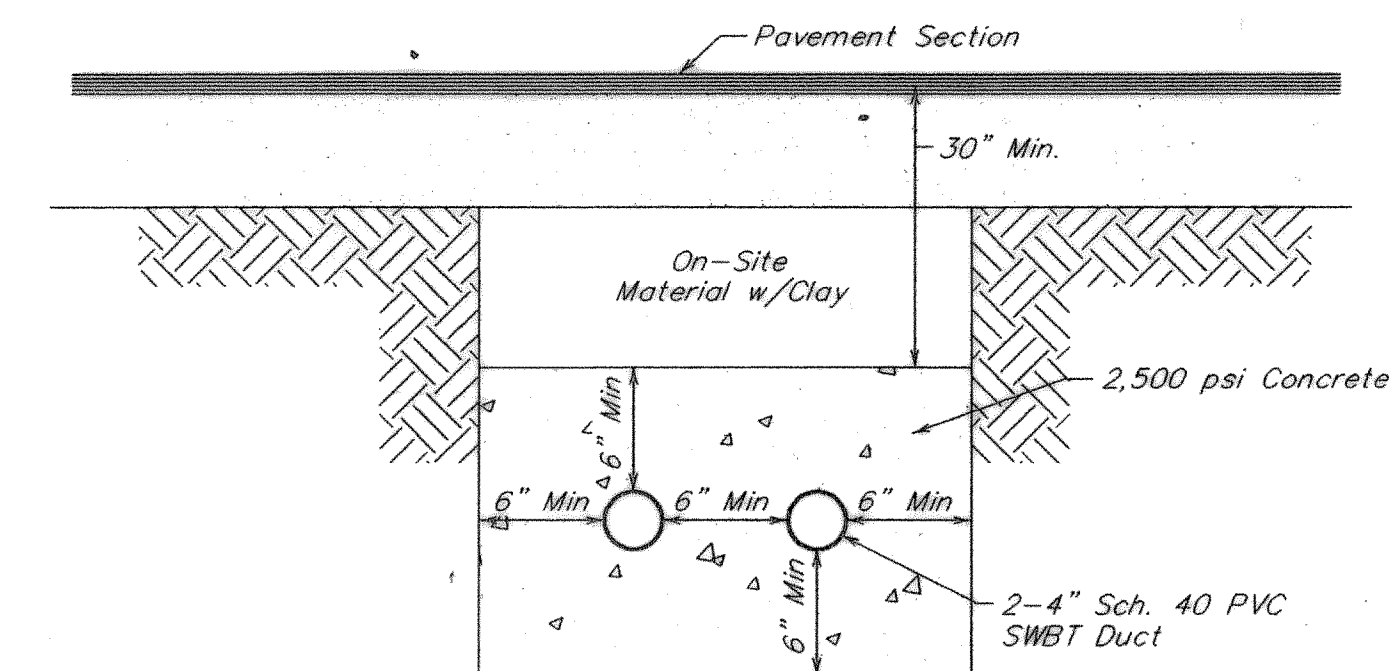

TELEPHONE TRENCH DETAIL

N.T.S.

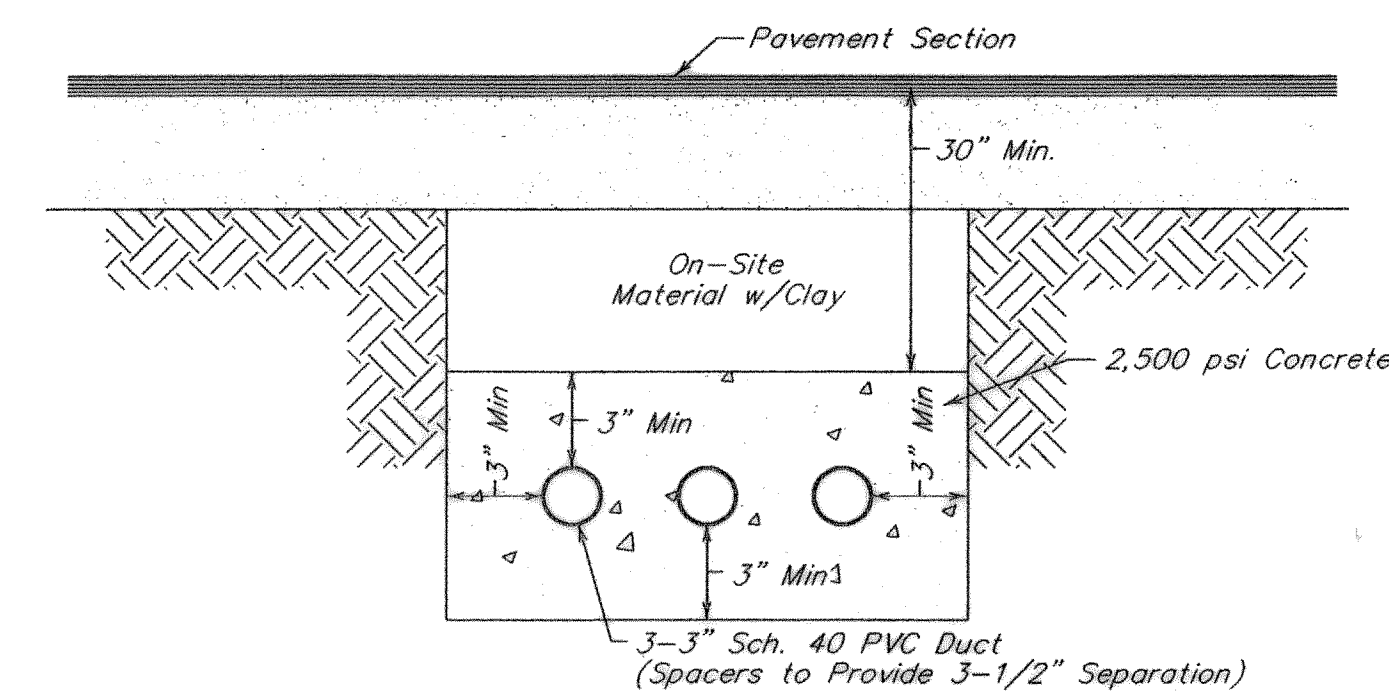

UNDERGROUND ELECTRIC TRENCH DETAIL

N.T.S.

RECORD DRAWING

NO.	DATE	REVISIONS	TMS APP.
1/14/98		REVISED RETAINING WALL HEIGHT	TMS

CNL DEVELOPMENT
ORLANDO, FLORIDA


ECKER DRUGSTORE NO. 2659R
ROCKWALL, TEXAS

**RETAINING WALL AND
MISCELLANEOUS DETAILS**

JC JONES & CARTER, INC.
Consulting Engineers

12000 Ford Rd., Suite 180 Dallas, Texas 75234 (972) 486-3800

SCALE: AS SHOWN DGN. BY: BPW
DATE: AUGUST 1997 DWN. BY: GSH
JOB NO. D0014-003 DWG. NO. D0014-075

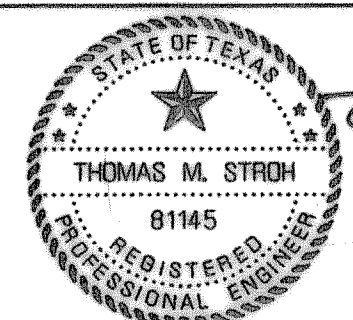

SHEET NO.
15
OF 15