


No.	Date	Revisions	App.
5/27/04		CONSTRUCTION RECORD	J.J.V.
11/16/03		CONSTRUCTION SET	J.J.V.
10/10/03		CITY COMMENTS	J.J.V.

TOMDEN ENGINEERING
12655 N CENTRAL EXPWY, SUITE 1016
DALLAS, TX 75243
972 386-6446 FAX 972 386-6400
tomden@aol.com

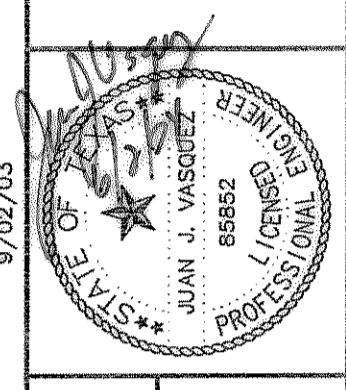

ECKERD - ROCKWALL, TEXAS

OWNER:
MAYS & COMPANY
5948 SHERRY LANE # 1570
DALLAS, TX 75225

ARCHITECT:
GENESIS DESIGN GROUP, INC.
2080 N. HIGHWAY 360, STE. 200
GRAND PRAIRIE, TX 75050

UTILITY PLAN

Scale: 1" = 30'
Designed by: J.J.V.
Drawn by: R.W.A./J.K.A.
Checked by: T.P.J.
/dwg/268-05/DC05UTL.dwg
Date: 05/27/04 10:28

CONSTRUCTION RECORDS
DATE: 6/14/04 BY: J.J.V.
THIS DRAWING INDICATES THE WORK COMPLETED PER INFORMATION SUPPLIED BY THE CONTRACTOR. ACTUAL ON THE GROUND SURVEY VERIFICATION WAS NOT PERFORMED EXCEPT AS SPECIFICALLY NOTED.