



DATE: 09/28/2018 10:58 AM
 PROJECT: 18-140-01
 DRAWN BY: J.A.H.
 CHECKED BY: S.R.H.
 DATE: 09/28/2018 10:58 AM

THE CONTRACTOR SHALL CONTACT
 DIG-TESS AT 1-800-344-8377 AND
 CITY SERVICE CENTER AT
 972-772-7730 FOR LINE LOCATES A
 MINIMUM OF 48 HOURS PRIOR TO THE
 COMMENCEMENT OF ANY
 CONSTRUCTION ACTIVITIES

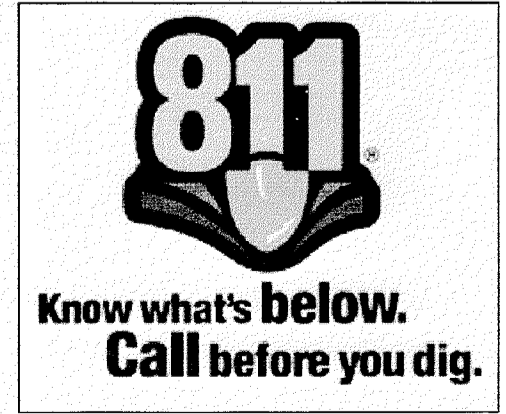


LEGEND			
I.R.F.	IRON ROD FOUND	⊗	POWER POLE
I.R.S.	IRON ROD SET	⊙	LIGHT POLE
"X"	CUT X IN CONCRETE	⊗	WATER VALVE
F.C.P.	FENCE CORNER POST	⊙SSMH	SANITARY SEWER MANHOLE
///	ASPHALT	•	FIRE HYDRANT
⊙	TELEPHONE MANHOLE	⊗WM	WATER METER

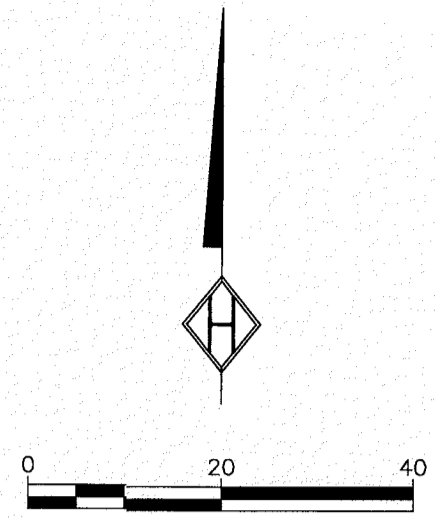


NOTE
 CONTRACTOR SHALL MAINTAIN ONE LANE OF TRAFFIC AT ALL TIMES. THE STREET SHALL BE PLATED EVERY NIGHT AND WEEKEND.

BENCHMARK INFORMATION
 TBM #1: ELEV. = 552.63
 "X" CUT LOCATED APPROXIMATELY 10 FEET EAST AND 37 FEET NORTH OF THE SOUTHEAST PROPERTY CORNER OF THE SUBJECT PROPERTY
 TBM #2: ELEV. = 558.79
 "X" CUT LOCATED APPROXIMATELY 16 FEET EAST AND 56 FEET SOUTH OF THE SOUTHWEST PROPERTY CORNER OF THE SUBJECT PROPERTY

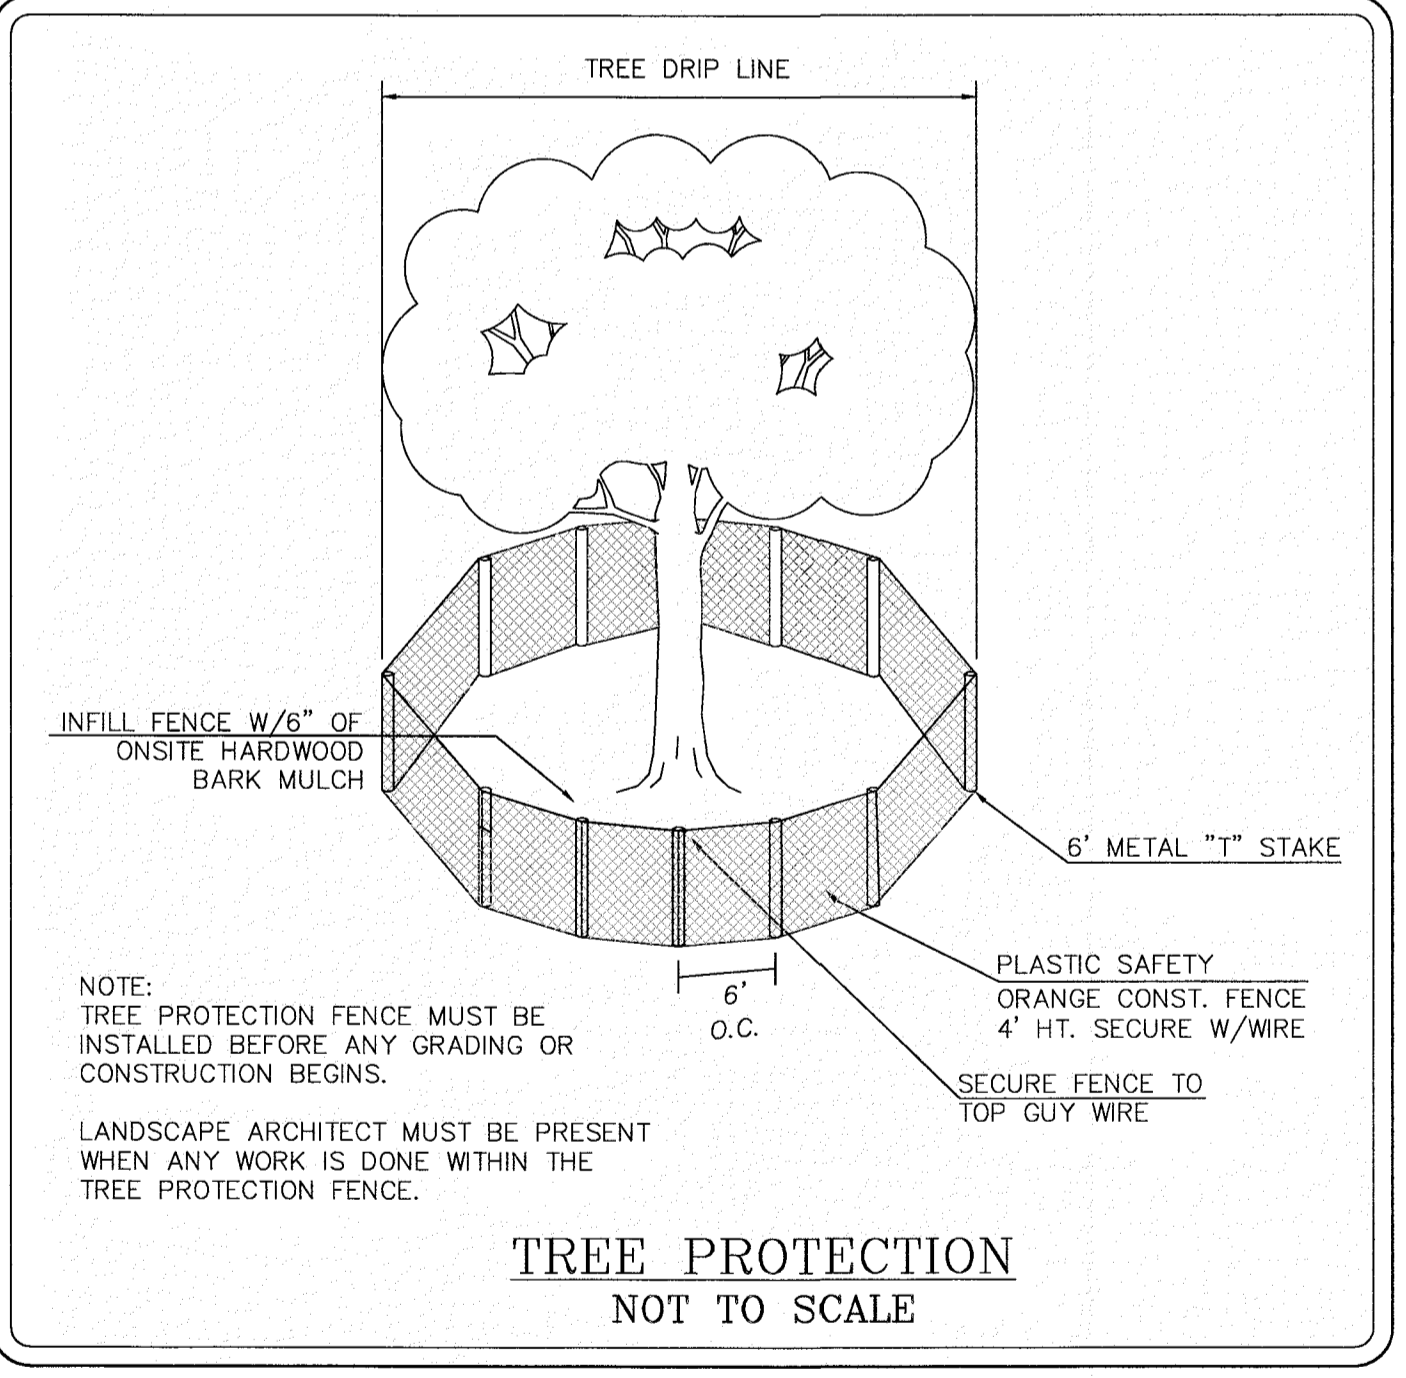


RECORD DRAWING
 The record drawing herein reflects to the best of the design engineer's knowledge, the approximate location of the constructed improvements using information based on surveying at the site and information provided by the contractor.
 Steven R. Homeyer, P.E. #86942
 Date: 7-20-20

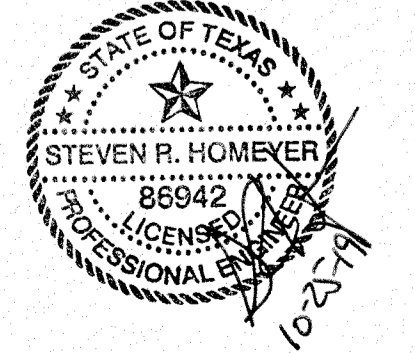

CASE NO. SP2019-017

HOMEYER ENGINEERING, INC.
 T&E FIRM REGISTRATION NO. F-84440
 P.O. BOX 294327 • LEWISVILLE, TEXAS • 75029
 972-906-9986 • TEL. 972-906-9987 • FAX
 WWW.HEI.US.COM

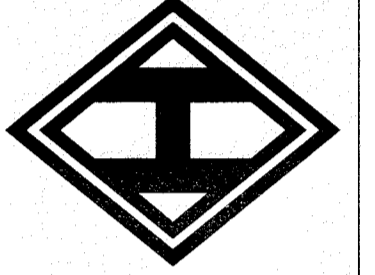

CANINE AND CO. RESORT
 1.21 ACRES
 CITY OF ROCKWALL
 ROCKWALL COUNTY, TEXAS

DEMOLITION PLAN

DRAWN: JAN
 DATE: 09/28/2018
 HEI #: 18-140

SHEET NO:
 C3