

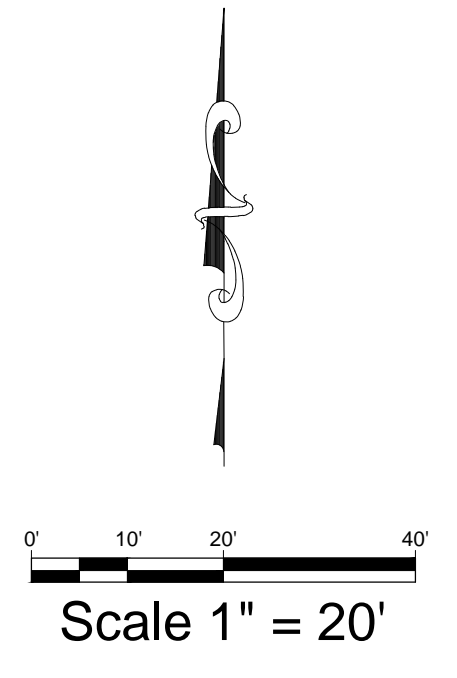


LOT 1
BLOCK D
ELLIS CENTRE, PHASE TWO,
DOC. NO. 2018-21421
O.P.R.R.C.T.

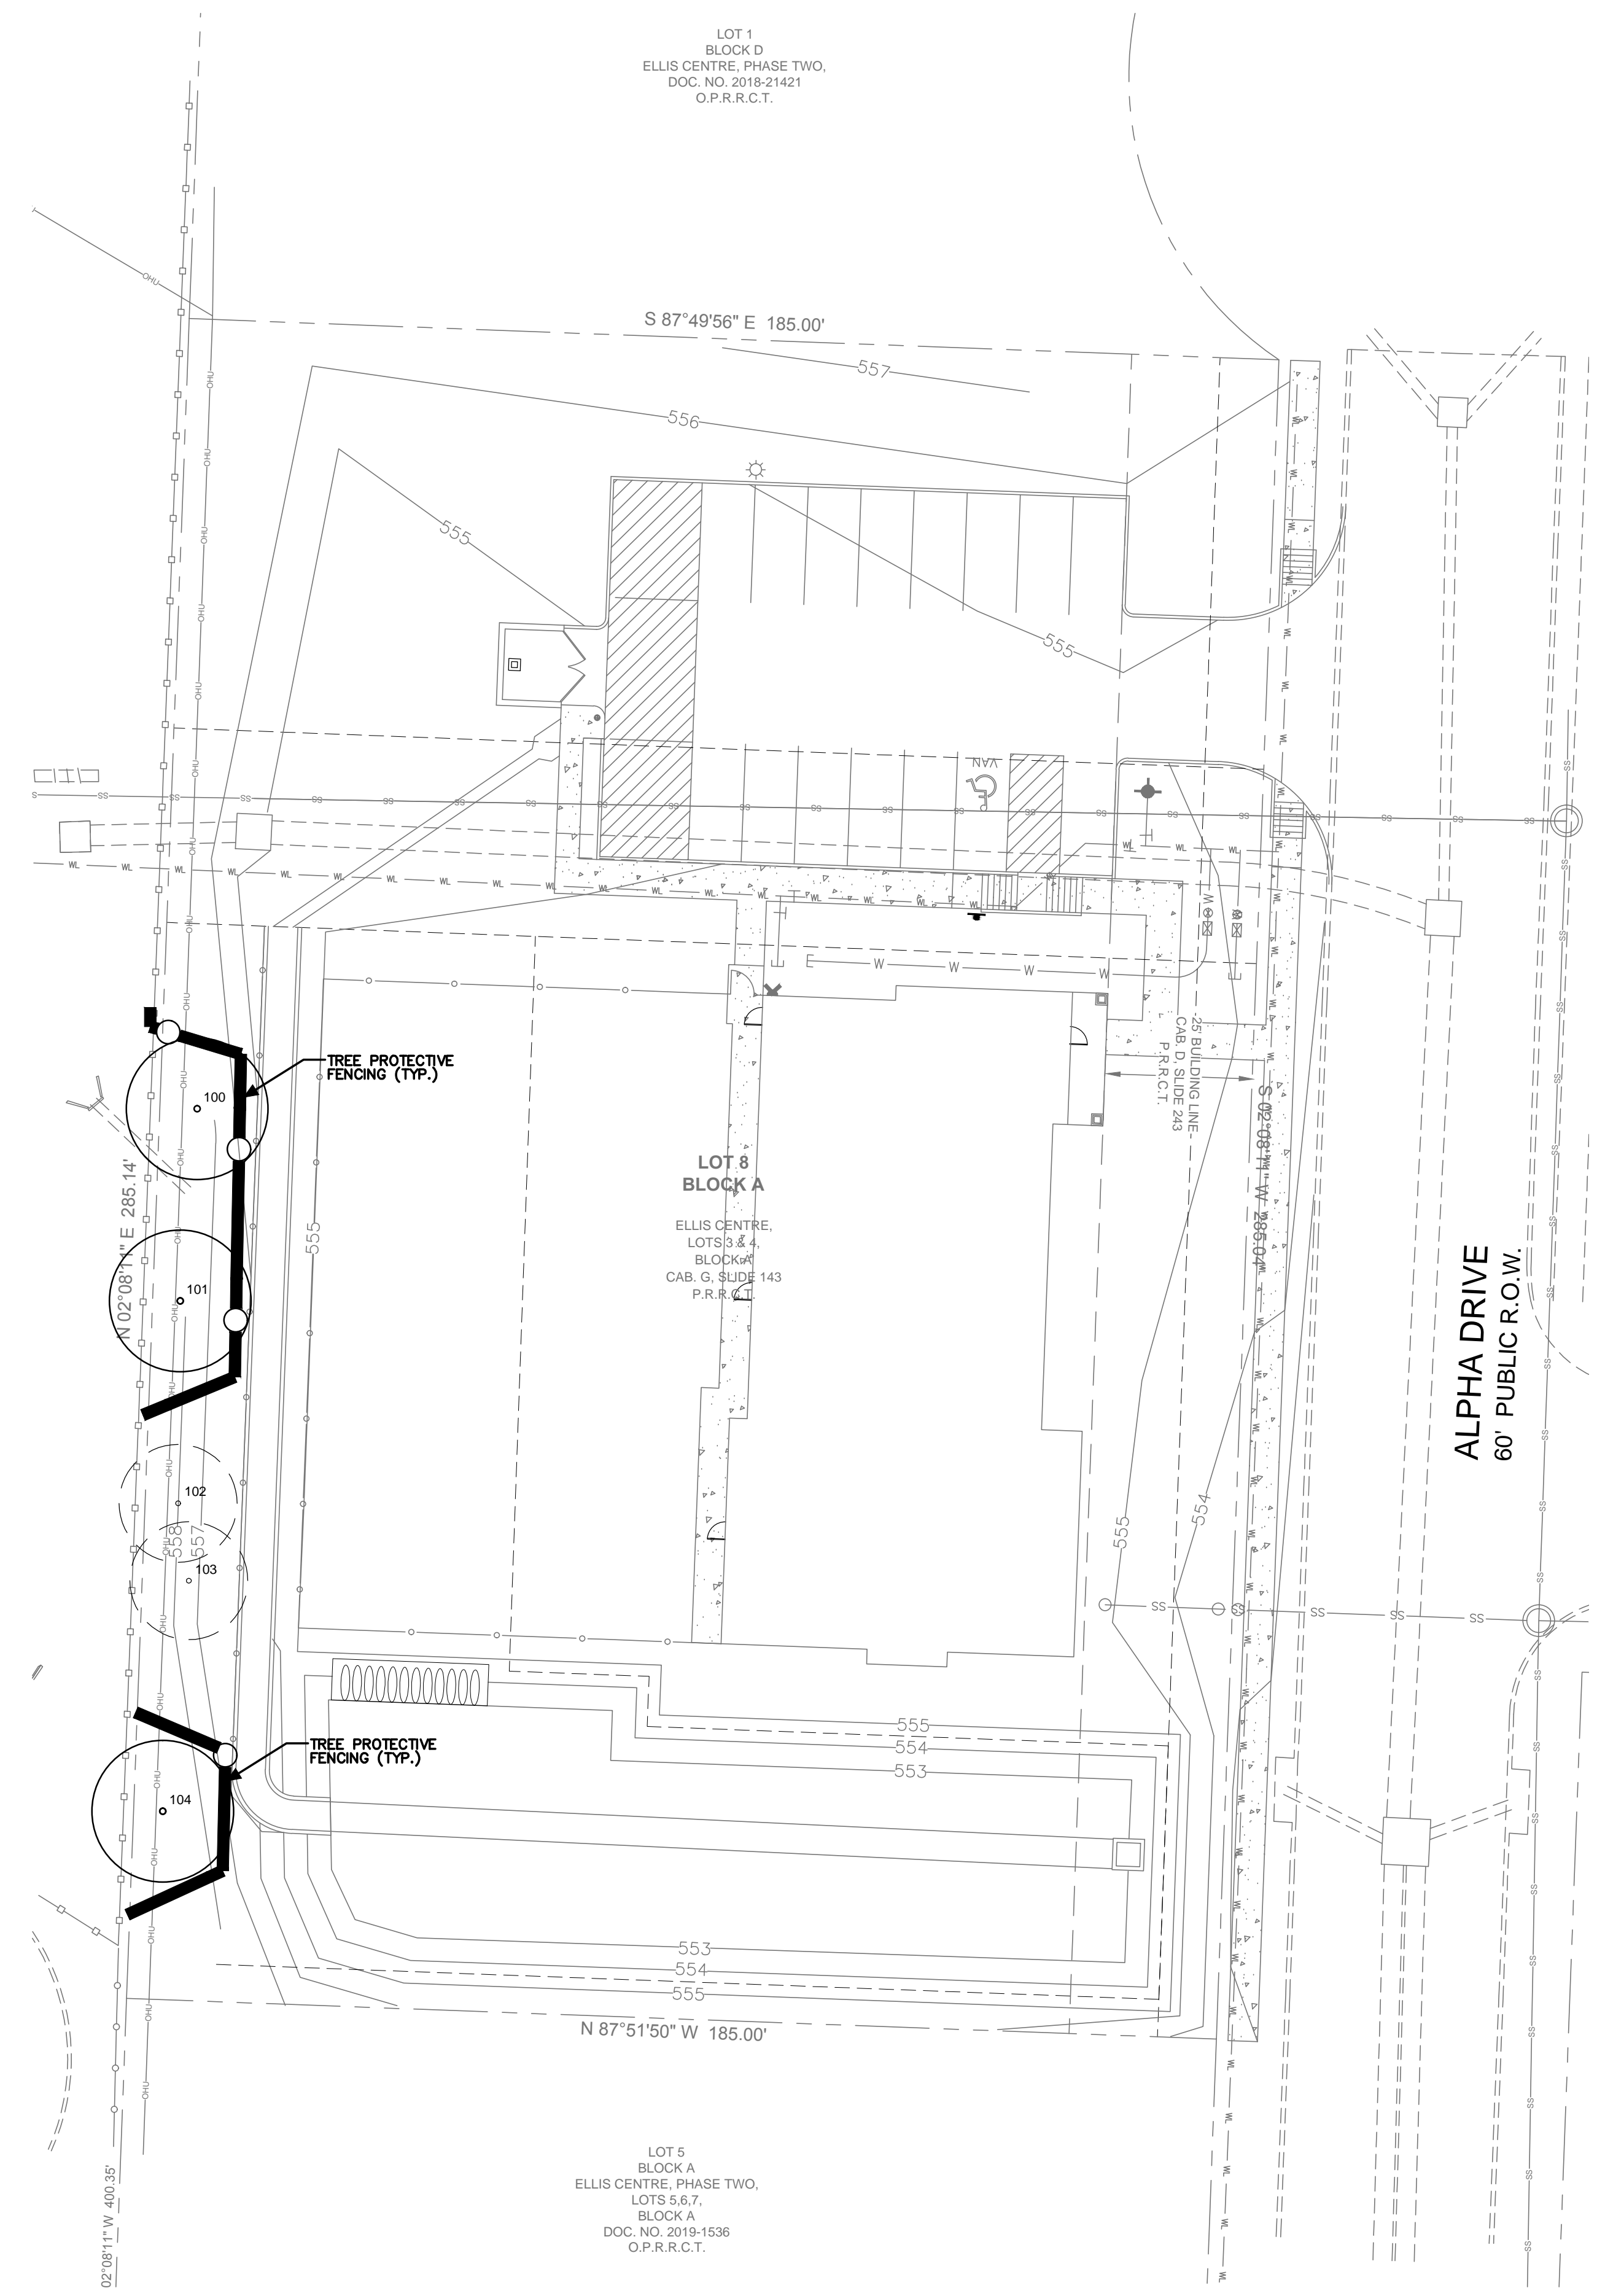


LEGEND

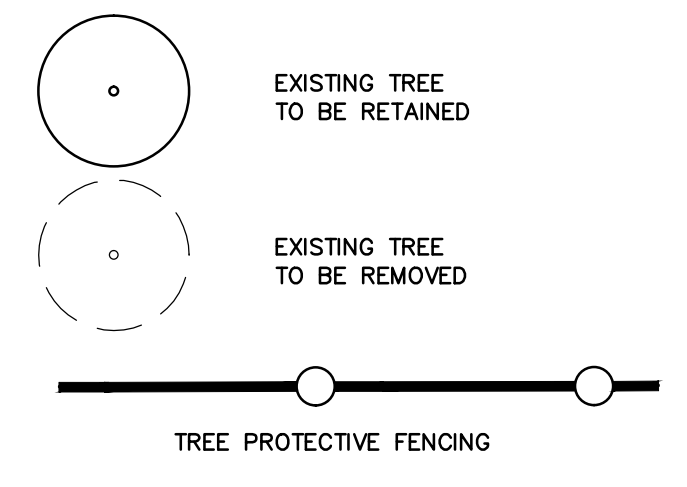

ID	SIZE/TYPE	REMOVED	MITIGATION
100	12" CEDAR	NO	NO
101	12" CEDAR	NO	NO
102	10" CEDAR	YES	NO
103	10" CEDAR	YES	NO
104	12" CEDAR	NO	NO

S:\Users\adamson\appdata\local\temp\cadd\project\1_16_2018\1_16_2018_11_11_5411.dwg 02/08/11 11:40:35 AM

HOMEYER
ENGINEERING, INC.
T.B.P.E. FIRM REGISTRATION NO. F-8440
P.O. BOX 294527 • LEWISVILLE, TEXAS • 75029
972-906-9985 PHONE • 972-906-9987 FAX
WWW.HEI.US.COM

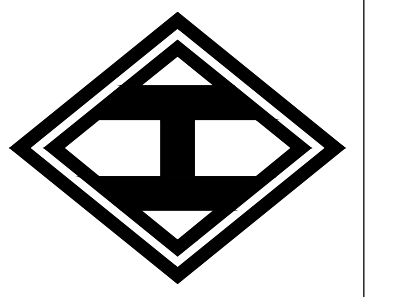

CANINE AND CO. RESORT
1.21 ACRES
CITY OF ROCKWALL
ROCKWALL COUNTY, TEXAS

EVERGREEN
DESIGN GROUP
(800) 680-6630
15305 Dallas Pkwy., Ste 300
Addison, TX 75001
www.EvergreenDesignGroup.com



DRAWN: JAN
DATE: 09/28/2018
HEI #: 18-140

SHEET NO:
TS-1