


CIVIL PLANS
CARENOW ROCKWALL
 LOT2, BLOCK A
 BRISCOE/HILLCREST ADDITION
 ROCKWALL, TEXAS

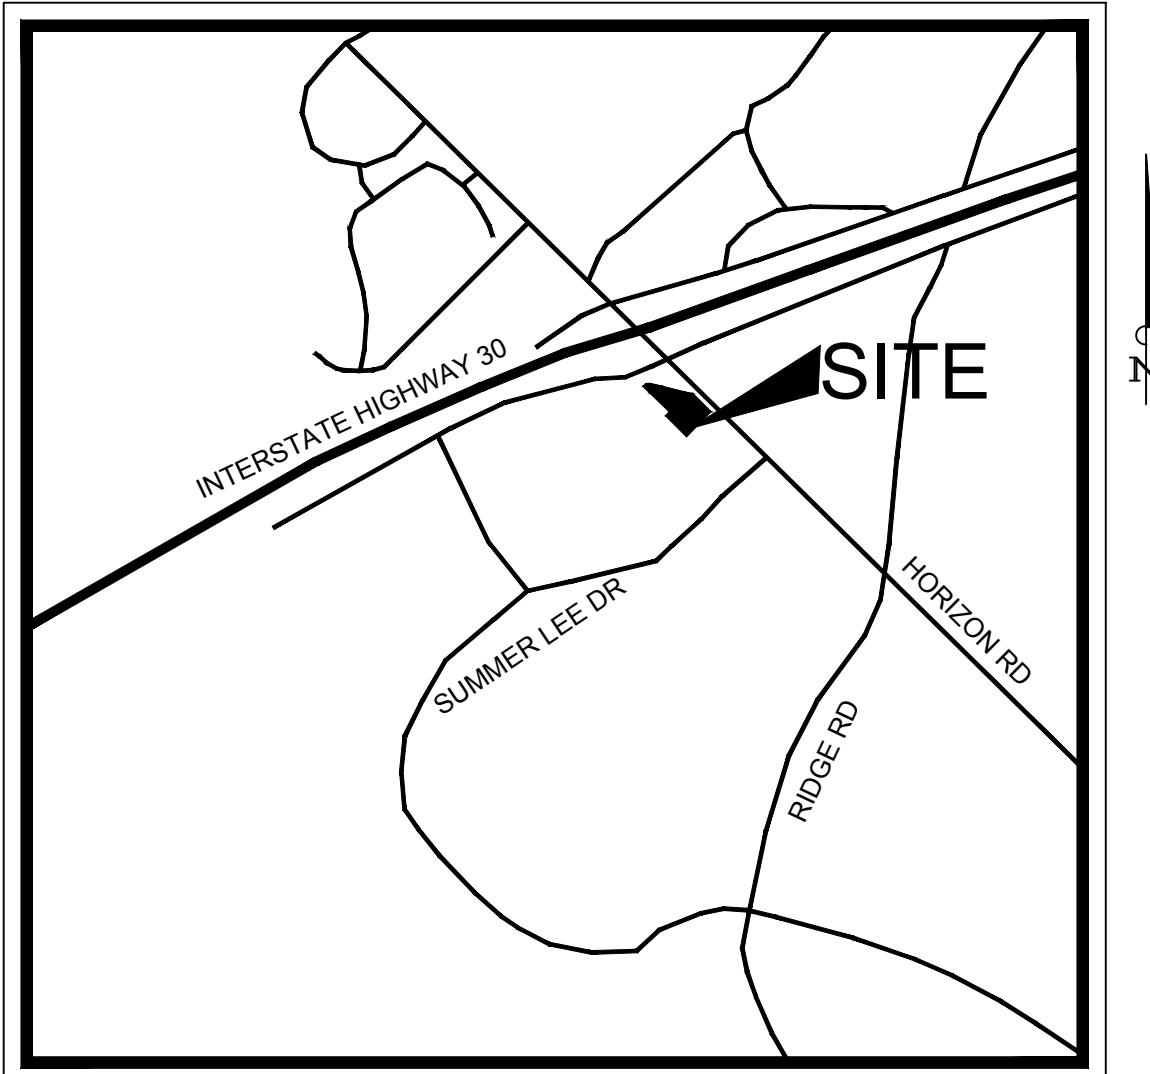

VICINITY MAP
 N.T.S.

MARCH 2017

SHEET LIST TABLE		
SHEET NUMBER	SHEET TITLE	REVISION DATE
C-0	COVER	3/3/2017
	REPLAT	
SP-1	CITY SITE PLAN	3/3/2017
C-1	GENERAL NOTES	3/3/2017
C-2	EROSION CONTROL PLAN	3/3/2017
C-3	EROSION CONTROL DETAILS	3/3/2017
C-4	DEMOLITION PLAN	3/3/2017
C-5	DIMENSION CONTROL & PAVING PLAN	3/3/2017
C-6	GRADING PLAN	3/3/2017
C-7	PINNACLE WAY PAVING PLAN & PROFILE	3/3/2017
C-8	PINNACLE WAY STREET LIGHT PLAN & SIGN PLAN	3/3/2017
C-9	EXISTING DRAINAGE AREA MAP	3/3/2017
C-10	PROPOSED DRAINAGE AREA MAP	3/3/2017
C-11	STORM DRAIN PLAN	3/3/2017
C-12	STORM DRAIN PROFILE & STORM DRAINAGE CALCULATIONS	3/3/2017
C-13	UTILITY PLAN	3/3/2017
C-14	SANITARY SEWER PROFILE	3/3/2017
C-15	CONSTRUCTION DETAILS (1 OF 2)	3/3/2017
C-16	CONSTRUCTION DETAILS (2 OF 2)	3/3/2017
L1.01	TREE PRESERVATION PLAN	8/23/2016
L2.01	LANDSCAPE PLAN	8/23/2016
L2.02	LANDSCAPE SPECIFICATIONS & DETAILS	8/23/2016
L3.01	IRRIGATION PLAN	8/23/2016
L3.02	IRRIGATION SPECIFICATIONS & DETAILS	8/23/2016
SHEET 1 OF 6	CARENOW MASONRY WALL, ROCKWALL TEXAS (COVER)	10/11/2017
SHEET 2 OF 6	CARENOW MASONRY WALL, ROCKWALL TEXAS (WALL LAYOUT)	10/11/2017
SHEET 3 OF 6	CARENOW MASONRY WALL, ROCKWALL TEXAS (WALL PROFILE)	10/11/2017
SHEET 4 OF 6	CARENOW MASONRY WALL, ROCKWALL TEXAS (WALL DETAILS)	10/11/2017
SHEET 5 OF 6	CARENOW MASONRY WALL, ROCKWALL TEXAS (WALL DETAILS)	10/11/2017
SHEET 6 OF 6	CARENOW MASONRY WALL, ROCKWALL TEXAS (WALL NOTES)	10/11/2017

PLAN SUBMITTAL LOG	
DESCRIPTION	SUBMITTAL DATE
1ST SUBMITTAL	8/24/2016
2ND SUBMITTAL	10/19/2016
3RD SUBMITTAL	12/13/2016
4TH SUBMITTAL	1/4/2017
ISSUE FOR CONSTRUCTION	2/10/2017
SUBMITTAL	3/3/2017
AS-BUILT SET	11/16/2017



This drawing has been revised to show those changes during the construction process reported by the contractor to ClayMoore Engineering, Inc. and considered to be significant. This drawing is not guaranteed to be "As Built" but is based on the information made available.
 By: *Mitt Ill* Date: 11/16/2017

STOP!
CALL BEFORE YOU DIG
 DIG TESS
 1-800-DIG-TESS
 (@ least 72 hours prior to digging)

ENGINEER

TEXAS REGISTRATION #14199
 1903 CENTRAL DR.
 SUITE #406
 BEDFORD, TX 76021
 PH. 817.281.0572
 FAX 817.281.0574
 CONTACT: CLAY CRISTY, PE
 EMAIL: CLAY@CLAYMOOREENG.COM