- 1. ALL MATERIAL AND CONSTRUCTION SHALL CONFORM TO THE CITY'S DESIGN STANDARDS AND THE MATERIAL AND CONSTRUCTION SHALL CONFORM TO THE "NORTH CENTRAL TEXAS COUNCIL OF GOVERNMENTS STANDARD
- SPECIFICATIONS FOR PUBLIC WORKS CONSTRUCTION" 3RD EDITION, AS AMENDED BY THE CITY OF ROCKWALL. 2. THE CONTRACTOR SHALL BE RESPONSIBLE TO FURNISH ALL MATERIALS AND LABOR TO CONSTRUCT THE FACILITY AS SHOWN AND DESCRIBED IN THE CONSTRUCTION DOCUMENTS IN ACCORDANCE WITH THE APPROPRIATE APPROVING

AUTHORITIES, SPECIFICATIONS AND REQUIREMENTS. ALL WORK REQUIRED BY THESE PLANS SHALL BE CONDUCTED IN

3. THE CONTRACTOR SHALL CONTACT ALL FRANCHISE UTILITY COMPANIES TO HAVE THEM LOCATE EXISTING UTILITIES PRIOR TO CONSTRUCTION. THE CONTRACTOR SHALL COORDINATE THE EXACT LOCATION AND DEPTH OF ALL FRANCHISE UTILITY SERVICES AND ANY REQUIRED RELOCATION AND/OR EXTENSIONS. SERVICES SHOWN ON THE PLANS, IF ANY, ARE CONCEPTUAL

CONFORMANCE WITH CURRENT SAFETY CODES AND STANDARDS WITH JURISDICTION OVER THIS PROJECT.

- 4. THE CONTRACTOR SHALL PROTECT ALL PUBLIC AND PRIVATE UTILITIES IN THE CONSTRUCTION OF THIS PROJECT. ALL MANHOLES, CLEANOUTS, VALVE BOXES, POWER POLES, SIGNS, FIRE HYDRANTS, ETC., MUST BE ADJUSTED TO PROPER GRADE BY THE CONTRACTOR PRIOR TO AND AFTER PLACING OF PERMANENT PAVING. UTILITIES MUST BE MAINTAINED TO PROPER LINE AND GRADE DURING CONSTRUCTION OF THE PAVING FOR THIS PROJECT.
- 5. BRACING OF UTILITY POLES MAY BE REQUIRED BY UTILITY COMPANIES WHEN TRENCHING OR EXCAVATION IS IN CLOSE PROXIMITY TO THE POLES. THE COST OF BRACING POLES WILL BE BORNE BY THE CONTRACTOR. THERE IS NO SEPARATE PAY ITEM FOR THIS WORK. THE COST IS INCIDENTAL TO THE VARIOUS PAY ITEMS FOR INSTALLATION OF
- 6. THE LOCATIONS, ELEVATIONS, AND DIMENSIONS OF EXISTING UTILITIES SHOWN ON THE PLANS WERE OBTAINED FROM AVAILABLE RECORDS AND ARE CONSIDERED APPROXIMATE. IT SHALL BE THE CONTRACTOR'S RESPONSIBILITY TO VERIFY LOCATIONS, ELEVATIONS, AND DIMENSIONS OF ADJACENT AND/OR CONFLICTING UTILITIES SUFFICIENTLY IN ADVANCE OF CONSTRUCTION IN ORDER THAT ADJUSTMENTS CAN BE MADE TO PROVIDE ADEQUATE CLEARANCES. THE CONTRACTOR SHALL PRESERVE AND PROTECT PUBLIC UTILITIES AT ALL TIMES DURING CONSTRUCTION. ANY DAMAGE TO UTILITIES RESULTING FROM CONTRACTOR'S OPERATIONS SHALL BE RESTORED AT THE CONTRACTOR'S EXPENSE. THE ENGINEER SHALL BE NOTIFIED WHEN PROPOSED FACILITY GRADES CONFLICT WITH EXISTING UTILITY
- 7. THE CONTRACTOR SHALL IMMEDIATELY REPAIR OR REPLACE ANY PHYSICAL DAMAGE TO PRIVATE PROPERTY, INCLUDING, BUT NOT LIMITED TO FENCES, WALLS, PAVEMENT, GRASS, TREES, AND LAWN SPRINKLER AND IRRIGATION SYSTEMS AT NO COST TO THE OWNER. THIS WORK SHALL BE SUBSIDIARY TO THE CONTRACT (UNLESS OTHERWISE NOTED) AND IS NOT A SEPARATE PAY ITEM.
- 8. THE CONTRACTOR SHALL REMOVE SURPLUS MATERIAL FROM THE PROJECT AREA. THIS WORK SHALL BE SUBSIDIARY TO THE CONTRACT AND IS NOT A SEPARATE PAY ITEM.
- 9. THE CONTRACTOR SHALL BE RESPONSIBLE FOR OBTAINING ALL NECESSARY PERMITS PRIOR TO CONSTRUCTION.
- 10. THE CONTRACTOR SHALL HAVE AVAILABLE AT THE JOB SITE AT ALL TIMES A COPY OF THE CONTRACT DOCUMENTS INCLUDING PLANS, SPECIFICATIONS, AND SPECIAL CONDITIONS, COPIES OF ANY REQUIRED CONSTRUCTION PERMITS, EROSION CONTROL PLANS, SWPPP AND INSPECTION REPORTS.
- 11. ANY DISCREPANCIES ON THE DRAWINGS SHALL BE IMMEDIATELY BROUGHT TO THE ATTENTION OF THE ARCHITECT AND ENGINEER BEFORE COMMENCING WORK. NO FIELD CHANGES OR DEVIATIONS FROM DESIGN SHALL BE MADE WITHOUT PRIOR APPROVAL OF THE OWNER AND NOTIFICATION TO THE ENGINEER. NO CONSIDERATION WILL BE GIVEN TO CHANGE ORDERS FOR WHICH THE OWNER AND ENGINEER WERE NOT CONTACTED PRIOR TO CONSTRUCTION OF THE AFFECTED ITEM.
- 12. ALL COPIES OF COMPACTION, CONCRETE AND OTHER REQUIRED TEST RESULTS SHALL BE SENT TO THE ARCHITECT, CIVIL ENGINEER, CONTRACTOR, CITY INSPECTOR, AND OWNER DIRECTLY FROM THE TESTING AGENCY
- 13. ALL NECESSARY INSPECTIONS AND/OR CERTIFICATIONS REQUIRED BY CODES, JURISDICTIONAL AGENCIES AND/OR UTILITY SERVICE COMPANIES SHALL BE OBTAINED BY THE CONTRACTOR PRIOR TO BUILDING POSSESSION AND THE FINAL CONNECTION OF SERVICES.
- 14. CONTRACTOR SHALL VERIFY BENCHMARKS AND DATUM PRIOR TO COMMENCING CONSTRUCTION OR STAKING OF
- 15. CONTRACTOR SHALL THOROUGHLY CHECK COORDINATION OF CIVIL, LANDSCAPE, MEP, ARCHITECTURAL, AND OTHER PLANS PRIOR TO COMMENCING CONSTRUCTION. OWNER AND ENGINEER SHALL BE NOTIFIED OF ANY DISCREPANCY PRIOR TO COMMENCING WITH CONSTRUCTION.
- 16. ALL HORIZONTAL DIMENSIONS GIVEN ARE TO FACE OF CURB AND TO PIPE CENTERLINES UNLESS OTHERWISE NOTED
- 17. THE CONTRACTOR IS RESPONSIBLE FOR COORDINATING RELOCATION AND INSTALLATION OF FRANCHISE UTILITIES NECESSARY FOR ON AND OFF SITE CONSTRUCTION. PAYMENT FOR RELOCATION AND INSTALLATION WILL BE
- NEGOTIATED ONCE IDENTIFIED. 18. ALL CUT OR FILL SLOPES SHALL BE 3:1 OR FLATTER UNLESS OTHERWISE SHOWN.

OPERATIONS, AT LEAST 48 HOURS PRIOR TO COMMENCEMENT OF WORK.

- 19. THE CONTRACTOR SHALL BE RESPONSIBLE FOR THE CONTROL OF DUST AND DIRT RISING AND SCATTERING IN THE AIR DURING CONSTRUCTION AND SHALL PROVIDE WATER SPRINKLING OR OTHER SUITABLE METHODS OF CONTROL. THE CONTRACTOR SHALL COMPLY WITH ALL GOVERNING REGULATIONS PERTAINING TO ENVIRONMENTAL
- 20.UPON COMPLETION OF CONSTRUCTION, THE CONTRACTOR SHALL PROVIDE THE CIVIL ENGINEER A COPY OF RECORD DRAWINGS IDENTIFYING ALL DEVIATIONS OR VARIATIONS FROM THE ORIGINAL PLANS.
- 21.CONTRACTOR SHALL GIVE NOTICE TO ALL AFFECTED PARTIES AND ALL AUTHORIZED INSPECTORS, SUPERINTENDENTS, OR PERSONS IN CHARGE OF PRIVATE AND PUBLIC UTILITIES OR RAILROADS AFFECTED BY HIS
- 22.ALL "RECORD" DIMENSIONS SHALL CONFORM TO THE DESIGN DIMENSIONS PLUS OR MINUS 0.02 FEET. ALL "RECORD"
- SLOPES SHALL CONFORM TO THE DESIGNED SLOPES PLUS OR MINUS 0.005 FOOT/FOOT. 23. CONTRACTOR SHALL CONTACT CITY BUILDING OFFICIAL TO LEARN OF ANY UNUSUAL CONSTRUCTION SEQUENCING REQUIREMENTS THAT THE CITY MAY REQUIRE. THE CONTRACTOR IS CAUTIONED THAT THIS AND PERHAPS OTHER SUCH REQUIREMENTS MAY EXIST AND IT IS THE CONTRACTOR'S RESPONSIBILITY TO INVESTIGATE AND COMPLY WITH

PAVING AND STRIPING NOTES

- 1. THE REINFORCED PORTLAND CEMENT CONCRETE SHOULD HAVE A MINIMUM 28 DAY COMPRESSIVE STRENGTH OF 3.600 PSI (6.5 SACK MIX) AT 28 DAYS FOR STANDARD DUTY CONCRETE AND 3.600 PSI (6.5 SACK MIX) FOR HEAVY DUTY CONCRETE AND DUMPSTER AREAS, AND A MINIMUM REINFORCING OF #3 BARS @ 24" O.C.E.W. AND SHALL STRICTLY ADHERE TO DETAILS INCLUDED IN THIS SET. A BASE SUB-GRADE PER THE GEOTECHNICAL REPORT IS REQUIRED BENEATH ALL PAVING.
- TESTING OF MATERIALS REQUIRED FOR THE CONSTRUCTION OF THE PAVING IMPROVEMENTS SHALL BE PERFORMED BY AN AGENCY, APPROVED BY THE OWNER, FOR TESTING MATERIALS. PROCUREMENT OF THE TESTING LABORATORY AND THE PAYMENT OF SUCH TESTING SERVICES SHALL BE MADE BY THE OWNER. IT SHALL BE THE CONTRACTOR'S RESPONSIBILITY TO ENSURE, BY THE STANDARD TESTING PROCEDURES, THAT THE WORK CONSTRUCTED MEETS THE REQUIREMENTS OF THE CITY AND PROJECT SPECIFICATIONS.
- 3. ALL SIGNS, PAVEMENT MARKINGS, AND OTHER TRAFFIC CONTROL DEVICES SHALL CONFORM TO THE "TEXAS MANUAL ON UNIFORM TRAFFIC CONTROL DEVICES".
- 4. THE CONTRACTOR SHALL REVIEW LOCATION OF ALL TRAFFIC CONTROL DEVICES WITH THE OWNER PRIOR TO
- INSTALLATION. 5. SEE M.E.P. PLANS FOR LOCATION OF PROPOSED SLEEVING AND CONDUITS.
- 6. ALL HANDICAP RAMPING, STRIPING, AND PAVEMENT MARKINGS SHALL CONFORM TO THE MOST RECENT VERSION OF THE AMERICANS WITH DISABILITIES ACT OF 1994 AND THE TEXAS ARCHITECTURAL BARRIERS ACT OF 1994, AND ALL
- 7. CONTRACTOR SHALL SUBMIT A PAVEMENT JOINTING PLAN TO THE ENGINEER AND OWNER PRIOR TO THE BEGINNING
- OF ANY CONCRETE PAVING WORK. 8. ANY EXISTING CONCRETE OR ASPHALT SHOWN TO BE REMOVED SHALL BE PROPERLY DISPOSED OF BY THE
- CONTRACTOR OFF SITE. THIS WORK SHALL BE SUBSIDIARY TO THE CONTRACT AND IS NOT A SEPARATE PAY ITEM. 9. CONSTRUCTION JOINTS SHALL BE REQUIRED AT INTERRUPTIONS OF PAVING OPERATIONS SUCH AS THOSE OCCURRING AT THE END OF THE DAY OR DUE TO WEATHER OR EQUIPMENT BREAKDOWN. PLACE AT LONGITUDINAL
- CONSTRUCTION OR ISOLATION JOINT LOCATIONS. 10. CONTRACTOR TO INSTALL CONSTRUCTION JOINTS IN CONCRETE PAVEMENT AT ALL PC'S AND AS CONVENIENT TO PHASING OF POURS. CONCRETE PAVEMENT TO BE CONSTRUCTED WITH ISOLATION JOINTS AROUND THE PERIMETER
- OF ANY BLOCK OUT IN PAVEMENT AND SAWED DUMMY JOINTS EVERY 12' IN BOTH DIRECTIONS. 11. ALL JOINTS ARE TO CONTINUE THROUGH THE CURB.
- 12. RADIAL JOINTS SHALL BE NO SHORTER THAN 24".
- 13. ALL CONSTRUCTION JOINTS SHALL BE SAWED, CLEANED OF DEBRIS, BLOWN DRY AND IMMEDIATELY SEALED WITH HOT POURED RUBBER JOINT SEALING COMPOUND.

STORM SEWER NOTES

- 1. CONTRACTOR SHALL FIELD VERIFY THE VERTICAL AND HORIZONTAL LOCATIONS OF ALL EXISTING UTILITIES PRIOR TO START OF CONSTRUCTION. THE CONTRACTOR SHALL NOTIFY THE ENGINEER AND CONSTRUCTION MANAGER IMMEDIATELY IF A CONFLICT IS DISCOVERED.
- 2. CONTRACTOR SHALL VERIFY AND COORDINATE ALL DIMENSIONS SHOWN, INCLUDING THE HORIZONTAL AND VERTICAL LOCATION OF CURB INLETS, GRATE INLETS, AND ALL UTILITIES CROSSING THE STORM SEWER. FLOW LINES AND RIMS OF PROPOSED INLETS SHALL BE VERIFIED WITH THE PROPOSED GRADE PRIOR TO CONSTRUCTION.
- 3. THE END OF ALL STORM SEWER LATERALS THAT CONNECT TO WORK BY PLUMBER SHALL BE TIGHTLY PLUGGED OR CAPPED AND MARKED 5.0 FEET OUTSIDE THE BUILDING UNTIL FINAL CONNECTIONS ARE MADE BY PLUMBING
- 4. THE SITE UTILITY CONTRACTOR SHALL PROVIDE ALL MATERIALS AND APPURTENANCES NECESSARY FOR COMPLETE INSTALLATION OF THE STORM SEWER.
- 5. CONTRACTOR IS RESPONSIBLE FOR OBTAINING ALL CONSTRUCTION PERMITS.
- 6. THE GENERAL CONTRACTOR AND ALL SUBCONTRACTORS SHALL VERIFY THE SUITABILITY OF ALL EXISTING AND PROPOSED SITE CONDITIONS INCLUDING GRADES AND DIMENSIONS BEFORE COMMENCEMENT OF CONSTRUCTION. THE ENGINEER SHALL BE NOTIFIED IMMEDIATELY OF ANY DISCREPANCIES.
- 7. EXISTING MANHOLE TOPS AND ALL OTHER DRAINAGE FACILITIES SHALL BE ADJUSTED AS REQUIRED TO MATCH FINAL GRADES AS SHOWN ON GRADING PLAN. NO SEPARATE PAY ITEM.
- 8. ALL RCP SHALL BE CLASS 3.

STORM SEWER DISCHARGE AUTHORIZATION

- 1. IF THE TOTAL DISTURBED AREA EXCEEDS ONE (1) ACRE A NOTICE OF INTENT (N.O.I.) SHALL BE SUBMITTED BY THE CONTRACTOR TO THE TCEQ NO LESS THAN 48 HOURS PRIOR TO COMMENCEMENT OF CONSTRUCTION ACTIVITIES.
- 2. ALL CONTRACTORS AND SUBCONTRACTORS PROVIDING SERVICES RELATED TO THE SWPPP SHALL SIGN A CONTRACTOR CERTIFICATION STATEMENT ACKNOWLEDGING THEIR RESPONSIBILITIES AS SPECIFIED IN THE SWPPP. 3. A COPY OF THE SWPPP, INCLUDING CONTRACTOR CERTIFICATIONS AND ANY REVISIONS, SHALL BE SUBMITTED TO THE
- CITY AND FILED WITH THE CONSTRUCTION PLANS, AND SHALL BE RETAINED ON-SITE DURING CONSTRUCTION. 4. A NOTICE OF TERMINATION (N.O.T.) SHALL BE SUBMITTED TO THE TCEQ BY THE CONTRACTOR WHEN THE SITE HAS 100% OF THE DISTURBED AREAS STABILIZED AND THE SITE NO LONGER HAS STORM WATER DISCHARGES ASSOCIATED

WITH INDUSTRIAL ACTIVITIES (CONSTRUCTION), OR THE N.O.T. PERMITTEE OR CO-PERMITTEE NO LONGER HOLDS OPERATIONAL CONTROL OF THE CONSTRUCTION.

- 1. EXISTING UTILITY DATA IS PROVIDED FOR INFORMATION ONLY. ALTHOUGH THIS DATA IS SHOWN AS ACCURATELY AS POSSIBLE, THE CONTRACTOR IS CAUTIONED THAT THE DEVELOPER AND THE ENGINEER NEITHER ASSUMES NOR IMPLIES ANY RESPONSIBILITY FOR THE ACCURACY OF THIS DATA.
- 2. THE CONTRACTOR IS TO VERIFY LOCATION AND ELEVATION OF EXISTING UTILITIES PRIOR TO CONSTRUCTION.
- 3. HORIZONTAL AND VERTICAL BLOCKING FOR WATER LINES HAS BEEN OMITTED FOR CLARITY. HOWEVER, BLOCKING SHALL BE CONSTRUCTED IN ACCORDANCE WITH CITY STANDARDS AND SPECIFICATIONS.
- 4. TRENCHES WHICH LAY OUTSIDE EXISTING OR FUTURE PAVEMENTS SHALL BE BACK FILLED ABOVE THE TOP OF THE EMBEDMENT WITH TYPE 'C' BACKFILL MATERIALS. WHEN TYPE 'C' BACKFILL MATERIAL IS NOT SUITABLE AND AT THE DIRECTION OF THE ENGINEER TYPE 'B' MATERIAL SHALL BE USED. ALL BACKFILL MATERIAL SHALL BE COMPACTED TO A MINIMUM OF 95% PROCTOR DENSITY BY MEANS OF SHEEPS FOOT ROLLER OR TAMPING IN TRENCH AREA ONLY. TRENCHES WHICH CROSS UNDER EXISTING OR FUTURE PAVEMENT SHALL BE BACK FILLED PER FIGURE 'A' WITH 95% PROCTOR STANDARD DENSITY OF -2, +4 OF OPTIMUM MOISTURE CONTENT.
- 5. TOP OF WATER LINES SHALL BE A MINIMUM OF 48" BELOW TOP OF CURB EXCEPT WHERE SHOWN OTHERWISE IN
- 6. FIRE HYDRANTS SHALL BE A MINIMUM 3' BEHIND THE FACE OF THE CURB UNLESS OTHERWISE DIRECTED BY THE CITY. FIRE HYDRANTS AND VALVES AS SHOWN ON THESE PLANS ARE SYMBOLIC ONLY.
- 7. CORPORATION STOPS SHALL BE TESTED FOR FULL FLOW WHEN THE SYSTEM IS PRESSURE TESTED.
- 8. ALL NEW WATER MAINS SHALL BE FULLY PURGED.
- 9. ALL 6", 8", 10" & 12" WATER MAINS SHALL BE PVC AWWA C900, DR-14. ALL WATER MAINS USING POLY-WRAPPED DUCTILE IRON PIPE SHALL BE CLASS 51.
- 10.FITTINGS SHALL BE DUCTILE IRON AND MECHANICAL JOINT TYPE, WITH "COR-BLUE" BOLTS AND SHALL BE CLASS 250. 11. CONTRACTOR TO INSTALL BLUE EMS DISKS ON THE WATER LINE AT EVERY CHANGE IN DIRECTION, VALVE, FIRE HYDRANT, SERVICE CONNECTION AT MAIN, AND 250'

SANITARY SEWER NOTES

- 1. EXISTING UTILITY DATA IS PROVIDED FOR INFORMATION ONLY. ALTHOUGH THIS DATA IS SHOWN AS ACCURATELY AS POSSIBLE. THE CONTRACTOR IS CAUTIONED THAT THE DEVELOPER AND THE ENGINEER NEITHER ASSUMES NOR IMPLIES ANY RESPONSIBILITY FOR THE ACCURACY OF THIS DATA.
- 2. THE CONTRACTOR IS TO VERIFY LOCATION AND ELEVATION OF EXISTING UTILITIES PRIOR TO CONSTRUCTION
- 3. TRENCHES WHICH LIE OUTSIDE EXISTING PAVEMENTS SHALL BE BACKFILLED ABOVE THE TOP OF THE EMBEDMENT WITH TYPE "C" BACKFILL MATERIAL. WHEN TYPE "C" BACKFILL MATERIAL IS NOT SUITABLE AND AT THE DIRECTION OF THE ENGINEER, TYPE "B" MATERIAL SHALL BE USED. ALL BACKFILL MATERIAL SHALL BE COMPACTED TO A MINIMUM OF 95% OF THE MAXIMUM DRY DENSITY BY MEANS OF SHEEPS FOOT ROLLER OR TAMPING IN TRENCH AREA ONLY. TRENCHES THAT CROSS UNDER EXISTING OR FUTURE PAVEMENT SHALL BE BACKFILLED AND COMPACTED TO A MINIMUM OF 95% OF THE MAXIMUM DRY DENSITY WITH MOISTURE CONTENT-2 AND +4% OF OPTIMUM MOISTURE
- 4. TYPICAL LOCATION OF SANITARY SEWER PIPE SHALL BE A MINIMUM OF 4'-0" BELOW TOP OF CURB EXCEPT WHERE
- SHOWN OTHERWISE IN THESE PLANS. 5. ALL FLEXIBLE SANITARY SEWER MAINS SHALL BE TESTED WITH STANDARD 5% DEFLECTION MANDREL.
- 6. ALL SANITARY SEWER LINES SHALL BE CAPPED WITH AN APPROPRIATE CAP AT THE END OF EACH WORKDAY
- 7. WHEN EXISTING GRADES ARE LOWER THAN PROPOSED MAINS, THE FILL AREA OVER THE PIPE SHALL BE FILLED AND COMPACTED TO A MINIMUM OF 95% OF THE MAXIMUM DRY DENSITY TO THE PROPOSED FINISHED GRADE PRIOR TO INSTALLING ANY MAIN.
- 8. ALL SANITARY SEWER SERVICES SHALL BE CONSTRUCTED OF SDR-35 PIPE FOR 10' OR LESS, SDR-26 FOR 10' AND
- 9. CONTRACTOR TO INSTALL GREEN SMS DISKS ON THE SANITARY SEWER AT EVERY CHANGE IN DIRECTION, MANHOLE, CLEANOUT, AND SERVICE CONNECTION AT MAIN.

TRAFFIC CONTROL NOTES


- 1. CONTRACTOR SHALL PROVIDE A SIGNED AND SEALED TRAFFIC CONTROL PLANS TO THE OWNER, AT LEAST 48 HOURS PRIOR TO CONSTRUCTION ACTIVITY.
- 2. ALL TRAFFIC CONTROL MEASURES SHALL BE INSTALLED AND MAINTAINED IN ACCORDANCE WITH THE TEXAS MANUAL ON UNIFORM TRAFFIC CONTROL DEVICES (TMUTCD), LATEST VERSION.
- 3. THE CONTRACTOR SHALL COVER EXISTING SIGNS AND OBLITERATE EXISTING PAVEMENT MARKINGS THAT CONFLICT
- WITH THE INTENT OF THESE TRAFFIC CONTROL PLANS TO AVOID CONFUSION TO THE TRAVELING PUBLIC. 4. THE CONTRACTOR SHALL UNCOVER EXISTING SIGNS AND REPLACE PAVEMENT MARKINGS IN-KIND AS ORIGINALLY
- CONFIGURED AT THE END OF CONSTRUCTION OPERATIONS AND PRIOR TO FINAL ACCEPTANCE BY THE OWNER. 5. ALL TEMPORARY SIGNS, BARRICADES, WARNING LIGHTS AND OTHER MISCELLANEOUS TRAFFIC CONTROL MEASURES SHALL BE REMOVED AND ORIGINAL TRAFFIC CONTROL MEASURES REPLACED AT THE END OF THE CONTRACTOR'S CONSTRUCTION OPERATIONS.

EROSION CONTROL NOTES

- 1. THE CONTRACTOR SHALL COMPLY WITH ALL FEDERAL, STATE, AND LOCAL EROSION, CONSERVATION, AND SILTATION ORDINANCES. THE CONTRACTOR SHALL USE SEDIMENT FILTERS OR OTHER MEASURES APPROVED BY THE ENGINEER AND CONSTRUCTION MANAGER TO PREVENT SILT AND CONSTRUCTION DEBRIS FROM CLOGGING STORM SEWER PIPES OR PROPOSED OR EXISTING INLETS, OR FROM BEING TRANSPORTED TO ADJACENT PROPERTIES AND STREET RIGHT-OF-WAYS. ALL EROSION CONTROL DEVICES SHALL BE INSTALLED PRIOR TO SITE DISTURBANCE AND SHALL REMAIN IN PLACE UNTIL FINAL GRADING AND PAVING IS COMPLETE AND PERMANENT SOIL STABILIZATION IS ACHIEVED. 2. CONSTRUCTION OPERATIONS SHALL BE MANAGED SO THAT AS MUCH OF THE SITE AS POSSIBLE IS LEFT COVERED
- WITH EXISTING TOPSOIL AND VEGETATION. 3. ALL SLOPES AND AREAS DISTURBED BY CONSTRUCTION SHALL BE GRADED SMOOTH. THE AREAS SHALL THEN BE SEEDED (OR SODDED), IRRIGATED, AND MAINTAINED UNTIL PERMANENT STAND OF GRASS IS ACHIEVED WITH A
- MINIMUM OF 75% COVERAGE. UNLESS OTHERWISE NOTED, PRIVATE LAWN AREAS AND PARKWAYS IN FRONT OF PRIVATE LAWN AREAS DISTURBED BY CONSTRUCTION SHALL BE REPLACED WITH BLOCK SOD SIMILAR TO THAT EXISTING. NO CITY ACCEPTANCE OF THE PROJECT UNTIL 75%-80% OF ALL DISTURBED AREAS TO HAVE A MINIMUM OF 1" STAND OF GRASS (NOT WINTER RYE)
- 4. CONTRACTOR SHALL CONSTRUCT A STABILIZED CONSTRUCTION ENTRANCE AT ALL PRIMARY POINTS OF ACCESS. CONTRACTOR IS RESPONSIBLE FOR ENSURING THAT ALL CONSTRUCTION TRAFFIC UTILIZES THE STABILIZED ENTRANCE AT ALL TIMES FOR INGRESS/EGRESS TO THE SITE.
- 5. CONSTRUCTION ENTRANCE:
 - MINIMUM SIZE STONE: 6"-4" INCHES DIAMETER. NO CRUSHED CONCRETE ALLOWED
 - THICKNESS: NOT LESS THAN 12"-INCHES
 - LENGTH: AS SHOWN ON PLAN 50' MIN
 - WIDTH: NOT LESS THAN FULL WIDTH OF ALL POINTS OF INGRESS AND EGRESS 20' MIN.
 - MAINTENANCE REQUIREMENTS: AS NECESSARY TO PREVENT TRACKING OR FLOWING MUD INTO PUBLIC RIGHT-OF-WAY OR PARKING AREAS.
- 6. SITE ENTRY AND EXIT LOCATIONS SHALL BE MAINTAINED IN A CONDITION WHICH SHALL PREVENT TRACKING OR FLOWING OF SEDIMENT ONTO PUBLIC ROADWAYS. ALL SEDIMENT SPILLED, DROPPED, WASHED OR TRACKED ON A PUBLIC ROADWAY SHALL BE REMOVED IMMEDIATELY. WHEN WASHING IS REQUIRED TO REMOVE SEDIMENT PRIOR TO ENTRANCE TO A PUBLIC ROADWAY, IT SHALL BE DONE ON AN AREA STABILIZED WITH CRUSHED STONE WHICH DRAINS INTO AN APPROVED SEDIMENT BASIN. ALL FINES IMPOSED FOR TRACKING ONTO PUBLIC ROADS SHALL BE PAID BY THE
- 7. CONTRACTOR IS RESPONSIBLE FOR PROPER MAINTENANCE OF THE REQUIRED EROSION CONTROL DEVICES THROUGHOUT THE ENTIRE CONSTRUCTION PROCESS. EROSION CONTROLS SHALL BE REPAIRED OR REPLACED AS INSPECTION DEEMS NECESSARY, OR AS DIRECTED BY THE OWNER'S REPRESENTATIVE. ACCUMULATED SILT IN ANY EROSION CONTROL DEVICE SHALL BE REMOVED AND SHALL BE DISTRIBUTED ON SITE IN A MANNER NOT CONTRIBUTING TO ADDITIONAL SILTATION. THE CONTRACTOR IS RESPONSIBLE FOR RE-ESTABLISHING ANY EROSION CONTROL DEVICE WHICH IS DISTURBED.
- 8. THE CONTRACTOR SHALL MAINTAIN ADEQUATE SITE DRAINAGE DURING ALL PHASES OF CONSTRUCTION. THE CONTRACTOR SHALL USE FILTER BARRIER (OR OTHER METHOD APPROVED BY THE ENGINEER AND CITY) AS REQUIRED TO PREVENT ADVERSE OFF SITE IMPACTS OR STORM WATER QUALITY FROM SILT AND CONSTRUCTION DEBRIS FLOWING ONTO ADJACENT PROPERTIES AS REQUIRED BY THE CITY.
- 9. BEFORE ANY EARTHWORK IS DONE, THE CONTRACTOR SHALL STAKE OUT AND MARK THE LIMITS OF CONSTRUCTION AND OTHER ITEMS ESTABLISHED BY THE PLANS. THE CONTRACTOR SHALL PROTECT AND PRESERVE CONTROL POINTS AT ALL TIMES DURING THE COURSE OF THE PROJECT. THE GRADING CONTRACTOR SHALL PROVIDE ALL NECESSARY ENGINEERING AND SURVEYING FOR LINE AND GRADE CONTROL POINTS RELATED TO EARTHWORK.
- 10. CONTRACTOR STAGING AREA TO BE AGREED UPON BY OWNER PRIOR TO BEGINNING CONSTRUCTION.
- 11. THE CONTRACTOR MUST REVIEW AND MAINTAIN A COPY OF THE STORM WATER POLLUTION PREVENTION PLAN WITH ALL CONDITIONS, ATTACHMENTS, EXHIBITS, AND PERMIT MODIFICATIONS IN GOOD CONDITION AT THE CONSTRUCTION SITE. THE COMPLETE PERMIT MUST BE AVAILABLE FOR REVIEW UPON REQUEST BY THE T.C.E.Q. OR THE GOVERNING

- 1. IF A GRADING PERMIT IS REQUIRED FROM THE CITY PRIOR TO STARTING CONSTRUCTION, CONTRACTOR IS RESPONSIBLE FOR OBTAINING PERMIT AND PAYING ALL ASSOCIATED FEES.
- 2. CONTRACTOR SHALL FIELD VERIFY HORIZONTAL AND VERTICAL LOCATION OF ALL EXISTING UTILITIES PRIOR TO CONSTRUCTION. CONTRACTOR IS RESPONSIBLE FOR PROTECTING EXISTING UTILITIES (SHOWN OR NOT SHOWN) WITHIN SCOPE OF CONSTRUCTION. IF ANY EXISTING UTILITIES ARE DAMAGED, THE CONTRACTOR SHALL REPLACE THEM AT HIS OWN EXPENSE.
- 3. ALL SPOT ELEVATIONS SHOWN ARE TO TOP OF PAVING SURFACE OR FINISHED EARTH GRADE UNLESS NOTED OTHERWISE.
- 4. CONTRACTOR TO ENSURE POSITIVE DRAINAGE FROM THE EXISTING AND PROPOSED BUILDINGS AND NO PONDING IN PAVED AREAS. CONTRACTOR ADJUSTMENTS TO SPOT GRADES TO MAINTAIN POSITIVE DRAINAGE IS ALLOWED WITH THE PRIOR APPROVAL OF THE ENGINEER. CONTRACTOR SHALL CONTACT THE ENGINEER PRIOR TO PAVING IF ANY AREAS OF POOR DRAINAGE ARE ENCOUNTERED.
- 5. THE CONTRACTOR SHALL PROTECT ALL MANHOLE COVERS, VALVE COVERS, VAULT LIDS, FIRE HYDRANTS, POWER POLES, GUY WIRES, AND TELEPHONE BOXES WHICH ARE TO REMAIN IN PLACE AND UNDISTURBED DURING CONSTRUCTION.
- 6. ALL EXISTING CONCRETE PAVING, CHANNEL IMPROVEMENTS, SIDEWALK, STRUCTURES AND CURB DEMOLITION SHALL BE REMOVED IN THEIR ENTIRETY AND DISPOSED OF BY THE CONTRACTOR, OFFSITE UNLESS OTHERWISE DIRECTED BY THE OWNER OR ENGINEER.
- 7. ALL CLEARING, GRADING, COMPACTION AND SUBGRADE PREPARATION SHALL BE IN ACCORDANCE TO THE GEOTECHNICAL REPORT.
- 8. GRADING CONTRACTOR TO COORDINATE WITH THE FRANCHISE UTILITY COMPANIES FOR ANY REQUIRED UTILITY ADJUSTMENTS AND/OR RELOCATIONS. 9. THE CONTRACTOR SHALL CALCULATE HIS OWN EARTHWORK QUANTITIES AND USE TO DETERMINE HIS BID
- ACCORDINGLY. 10.BEFORE PLACING PAVEMENT, CONTRACTOR SHALL VERIFY THAT SUITABLE HANDICAPPED ROUTES (PER A.D.A. & T.A.S) EXIST TO AND FROM EVERY DOOR. IN NO CASE SHALL HANDICAP RAMP SLOPES EXCEED 1 VERTICAL TO 12
- HORIZONTAL. IN NO CASE SHALL SIDEWALK CROSS SLOPES EXCEED 2.0 PERCENT. IN NO CASE SHALL LONGITUDINAL SIDEWALK SLOPES EXCEED 5.0 PERCENT. CONTRACTOR SHALL CONTACT ENGINEER PRIOR TO PAVING IF ANY EXCESSIVE SLOPES ARE ENCOUNTERED. NO CONTRACTOR CHANGE ORDERS WILL BE ACCEPTED FOR A.D.A. AND T.A.S. COMPLIANCE ISSUES.
- 11. ALL FILL IS TO BE COMPACTED TO 95% STD. DENSITY USING A SHEEP'S FOOT ROLLER.

This drawing has been revised to show those changes during the construction process reported by the contractor to ClayMoore Engineering, Inc. and considered to be significant. This drawing is not guaranteed to be "As Built" but is based on the information made available. Date: 11/16/2017

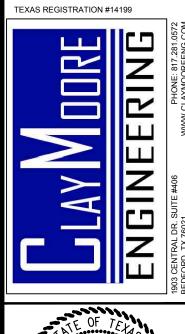

CLAY CRISTY 109800

> BL ST П Ć \bigcirc \leftarrow \bigcirc \neg

CHECKED: SHEET