
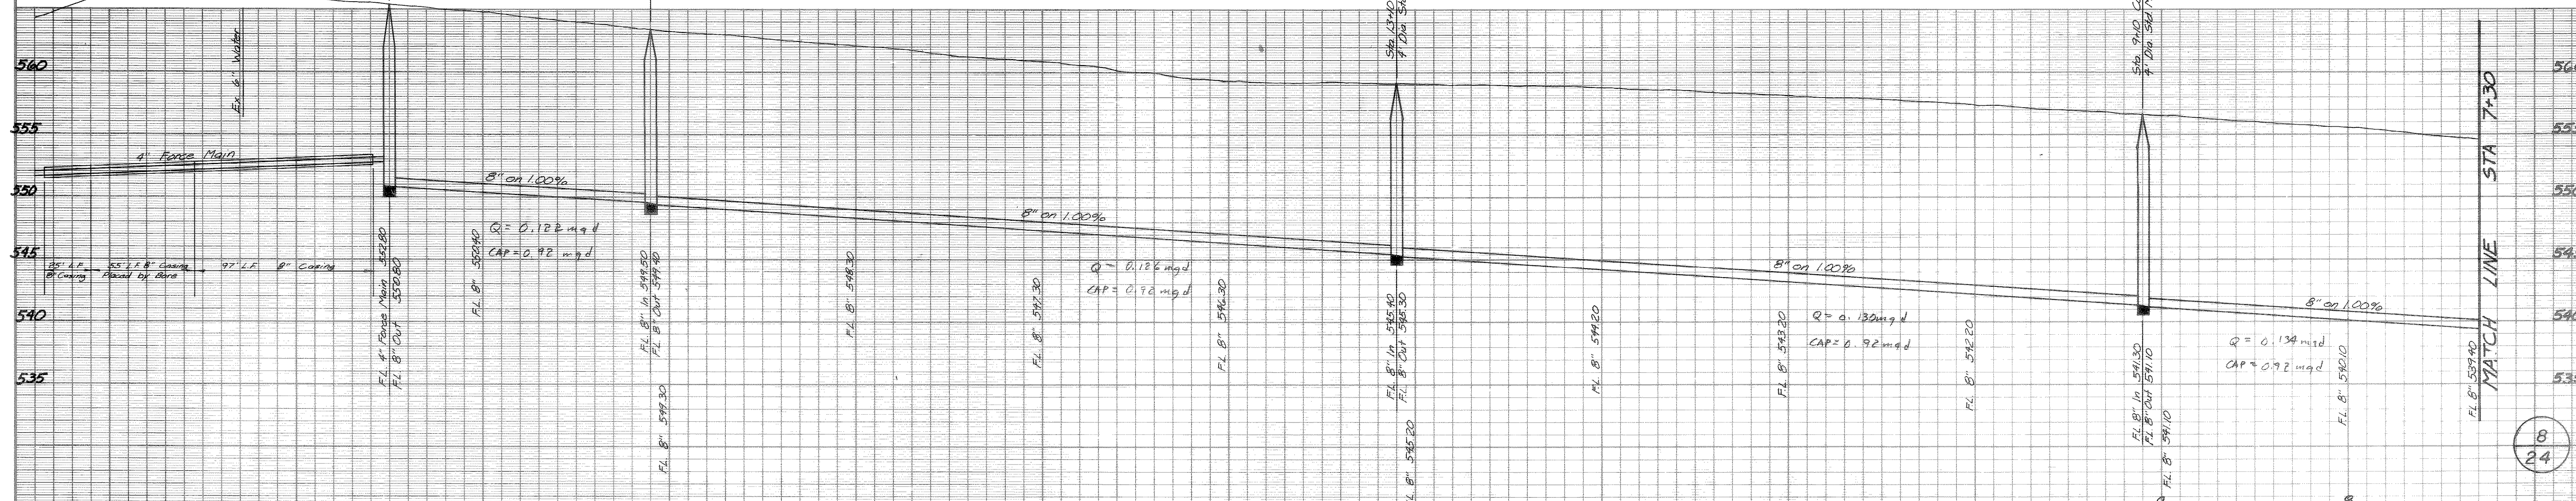
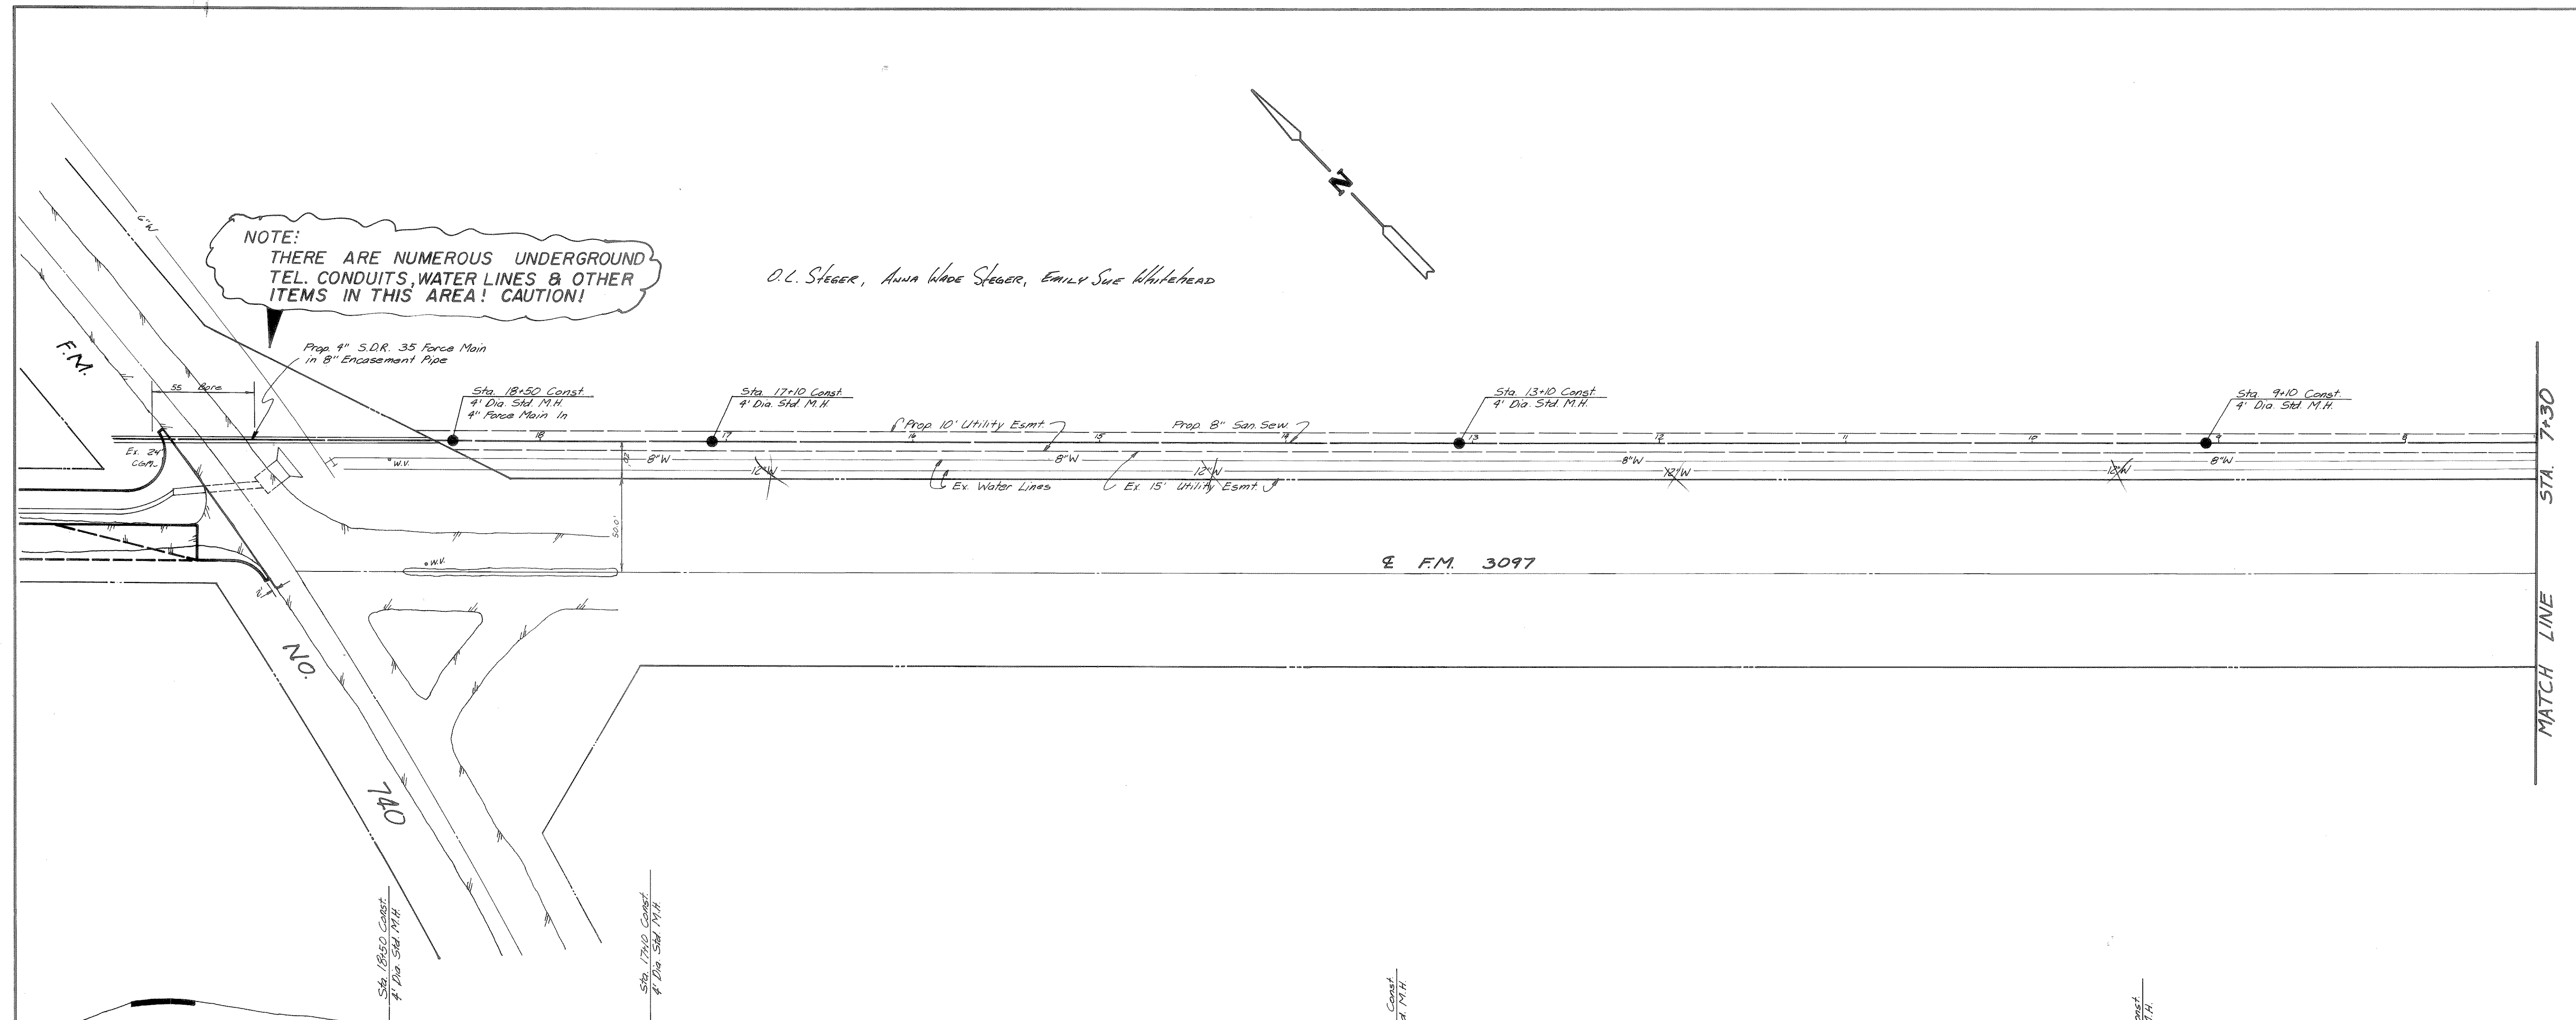


NOTE:
THERE ARE NUMEROUS UNDERGROUND
TEL. CONDUITS, WATER LINES & OTHER
ITEMS IN THIS AREA! CAUTION!

O.L. STEGER, ANNA WADE STEGER, EMILY SUE WHITEHEAD

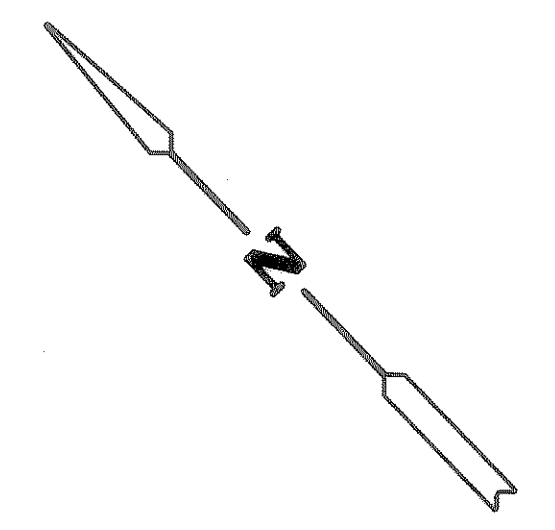

AS BUILT

HAROLD L. EVANS
CONSULTING ENGINEER
2331 GUS THOMASSON RD. SUITE 102
DALLAS, TEXAS 75228
PHONE (214) 328-8133

OFFSITE SANITARY SEWER
CARLISLE PLAZA ADDITION
CITY OF ROCKWALL
ROCKWALL COUNTY, TEXAS

SCALE: 1" = 40' H., 1" = 6' V.
DATE: 5-30-84
JOB NO.: 83107

