


NOTE:
 ALL SANITARY SEWER LINES ARE PVC
 SEE SPECIFICATIONS.

AS BUILT

Revised 11-26-84: Add Ln. "D" shorten Line "C"
 Revised 8-16-84
 Revised 7-18-84 Ln. "A" 12'-9" FM

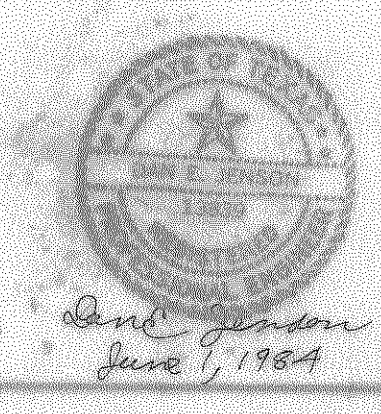

HAROLD L. EVANS
 CONSULTING ENGINEER
 2351 GUS THOMASSON RD., SUITE 102
 DALLAS, TEXAS 75228
 PHONE (214) 328-8133

SCALE	DATE	JOB NO.
1" = 40' H. 1" = 6' V.	5-30-84	83107

SANITARY SEWER PROFILES
 CARLISLE PLAZA ADDITION
 CITY OF ROCKWALL
 ROCKWALL COUNTY, TEXAS