


NOTES  
 1 INLET TOPS Follow grade of drives  
 & may Not be level, End to End.

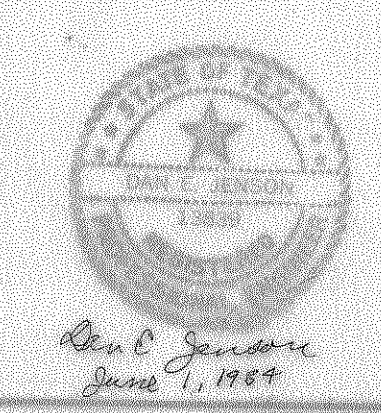

Revised 2-15-84 Grades Line "C"  
 Revised 12-4-84 ~ GRADES and/or STAIRWAYS  
 ON LINES "A" Thru "G"  
 Revised 11-23-84 Revised Line "A"  
 Revised 8-16-84 Revised 9/10/84 Added Note #1.  
 Revised 9-7-91 Added B' roof Drums To Line "A"  
 Revised 7-27-84 Remove "A", "B" & "C" + ADD NEW "A"  
 Revised 7/18/84 Change Inlet Elevations

**HAROLD L. EVANS**  
 CONSULTING ENGINEER  
 2331 GUS THOMASSON RD. SUITE 102  
 DALLAS, TEXAS 75228  
 PHONE (214) 328-6133

SCALE	DATE	JOB NO.
1" = 40' H. 1" = 20'	5-30-84	83107

AS BUILT

5  
24

**STORM SEWER PROFILES**  
 CARLISLE PLAZA ADDITION  
 CITY OF ROCKWALL  
 ROCKWALL COUNTY, TEXAS