


CONSTRUCTION PLANS FOR CARMEL CAR WASH CITY OF ROCKWALL ROCKWALL COUNTY, TEXAS

MAY 2016

As Built 7/13/17

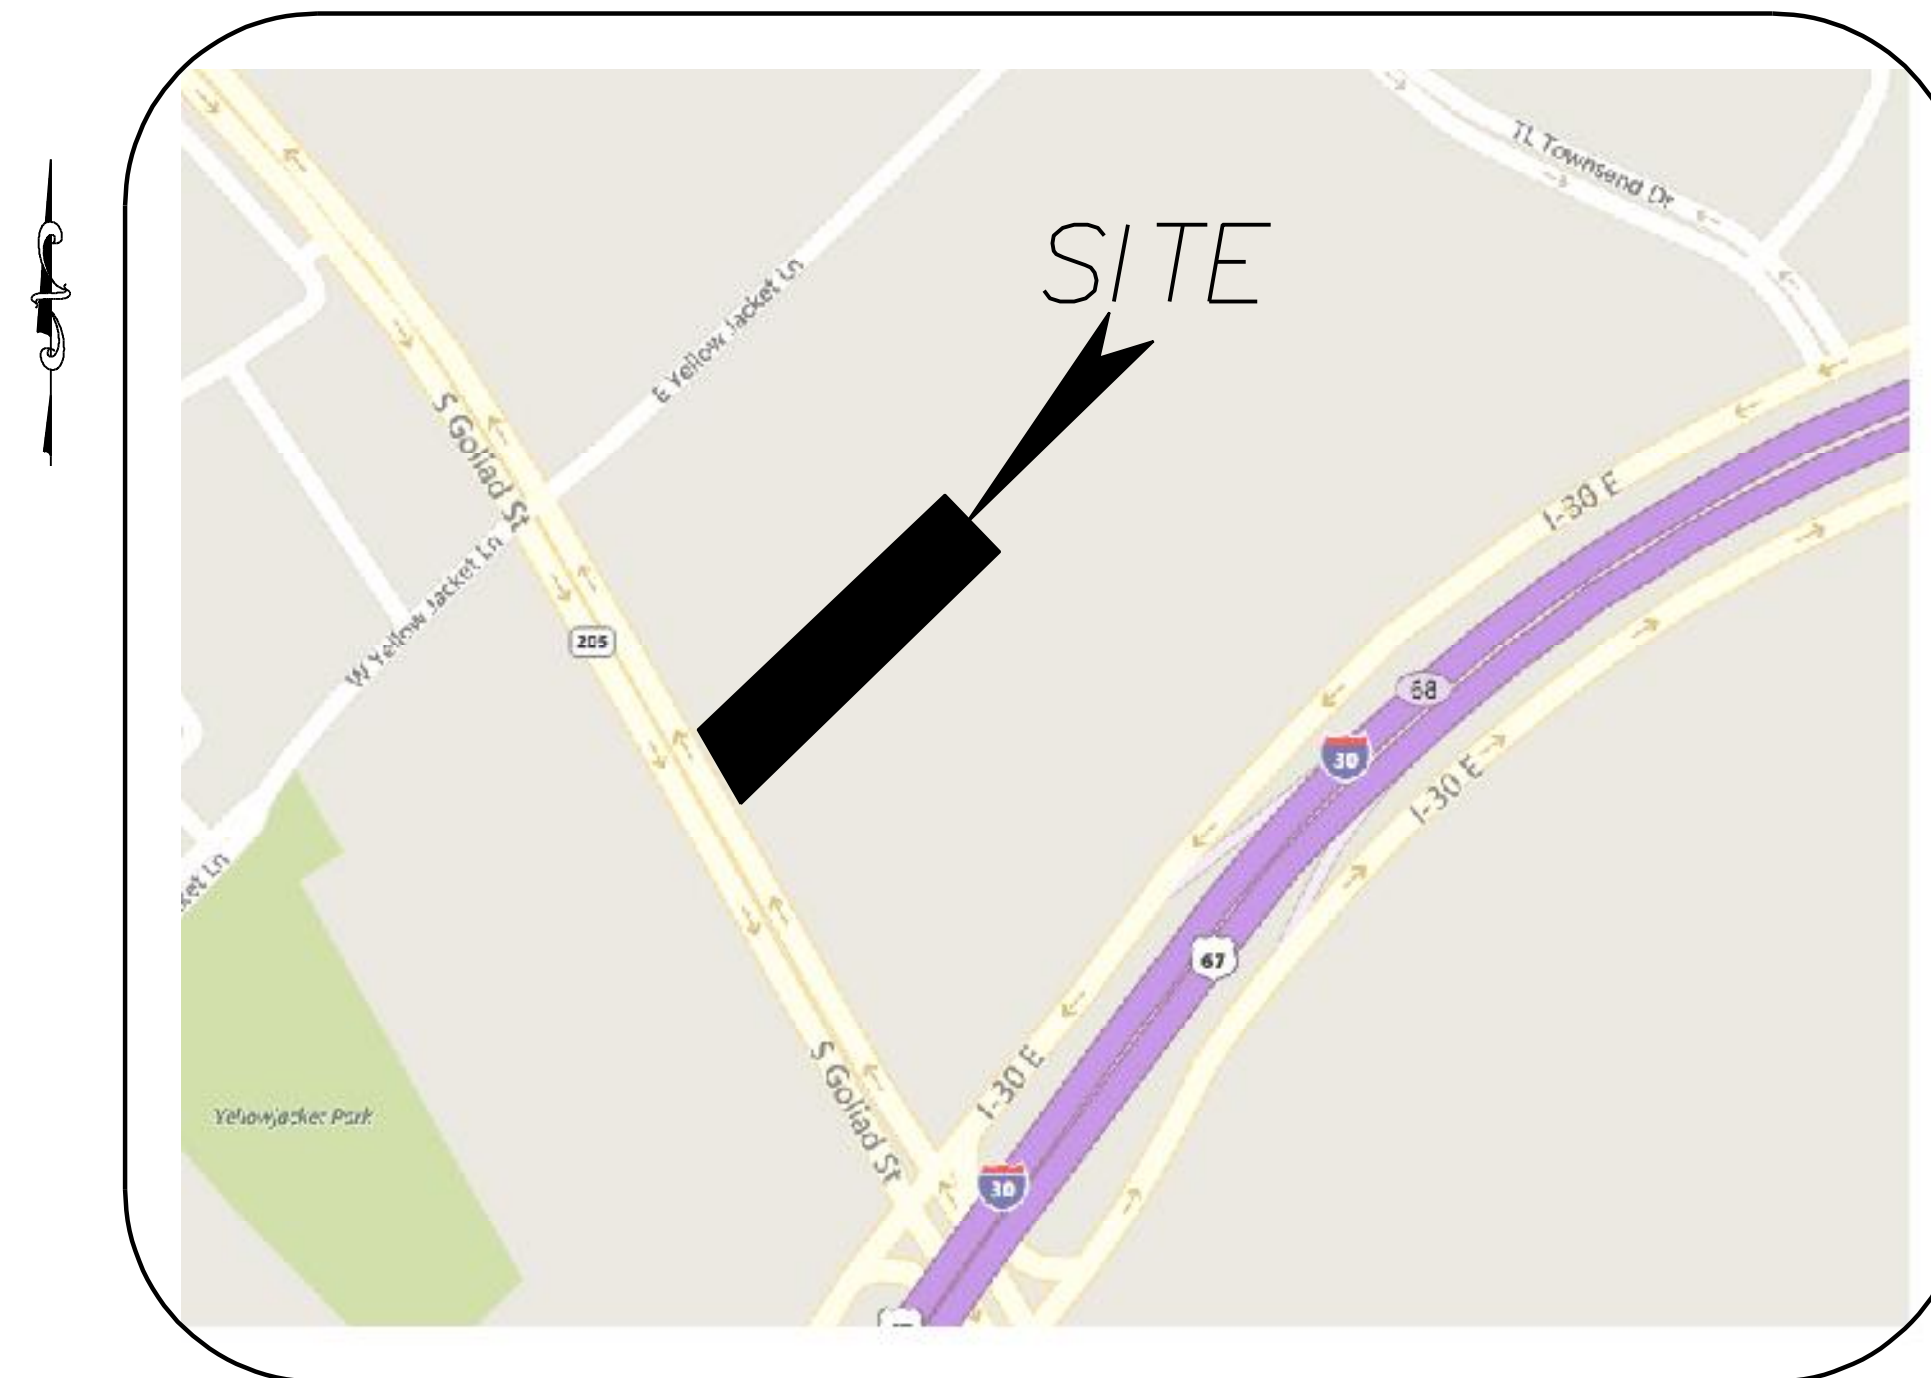

LOCATION MAP
(N.T.S.)

ENGINEER:



**HAMILTON
DUFFY, PC**
CONSULTING
TEXAS REGISTRATION NO. F-005260
CIVIL & ENVIRONMENTAL ENGINEERS - PLANNERS - CONSTRUCTION MANAGERS
8241 MID-CITIES BLVD. - NORTH RICHLAND HILLS, TEXAS 76182-4712
PHONE (817) 268-0408 FAX (817) 284-8408

INDEX OF SHEETS	
SHEET	DESCRIPTIONS
CIVIL ENGINEERING PLANS	
	PLAT
	SITE PLAN
C1.00	DEMOLITION PLAN
C1.01	PRE-DEVELOPED DRAINAGE AREA MAP
C1.01A	POST-DEVELOPED DRAINAGE AREA MAP
C1.01B	DETENTION POND PLAN CALCULATIONS
C1.02	PAVING PLAN
C1.02A	PAVING DETAILS
C1.03	GRADING PLAN
C1.03A	STORM DRAIN PLAN AND PROFILE
C1.04	UTILITY PLAN
C1.05	EROSION CONTROL PLAN
L-1.0	LANDSCAPE PLAN
L-2.0	LANDSCAPE DETAILS

**AS-BUILT
DRAWINGS**
THIS DOES NOT IMPLY A GROUND SURVEY.
THESE DOCUMENTS WERE PREPARED FROM
ORIGINAL DESIGN DRAWINGS AND CONSTRUCTION
MODIFICATIONS NOTED BY CONTRACTOR.
KEITH M. HAMILTON 87384
PE-NO. DATE
7-13-17



8-30-16