


HORIZ. 1" = 40'  
VERT. 1" = 4'

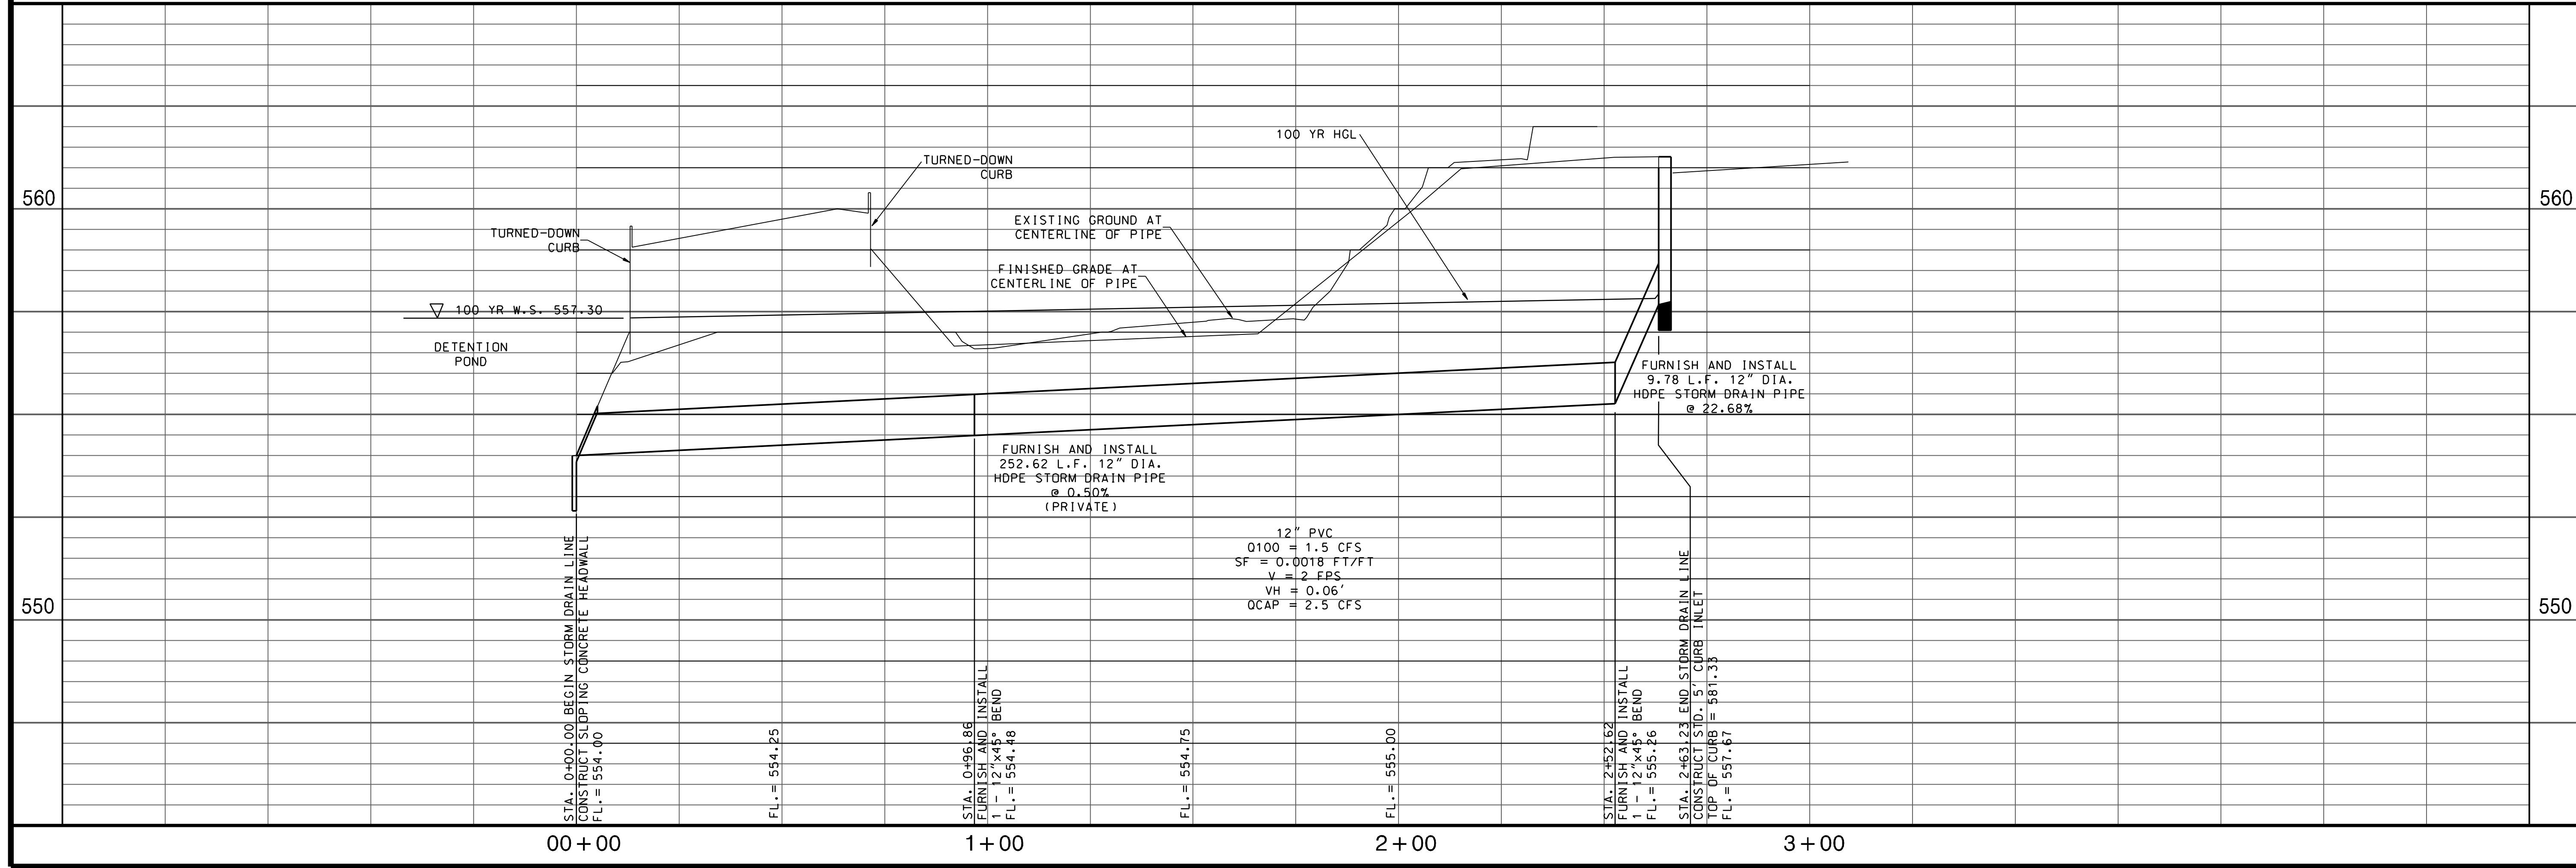

**A-BUILT**  
DRAWINGS  
THIS DOES NOT IMPLY A GROUND SURVEY.  
THESE DOCUMENTS WERE PREPARED FROM  
ORIGINAL DESIGN DRAWINGS AND CONSTRUCTION  
MODIFICATIONS NOTED BY CONTRACTOR.  
KEITH M. HAMILTON, P.E. DATE  
7-13-17

NO.	REVISION	DATE	BY	DATE	JOB
		7/13/2017	K.M.H.		048-019
			J.B.E.		
			K.M.H.		

TEXAS REGISTRATION NO. F-05260

SHEET  
C1.03A

**SITE CONSTRUCTION PLANS**  
CARMEL CAR WASH  
2003 SOUTH GOLIAD STREET  
CITY OF ROCKWALL, TEXAS  
**STORM DRAIN PLAN AND PROFILE**