

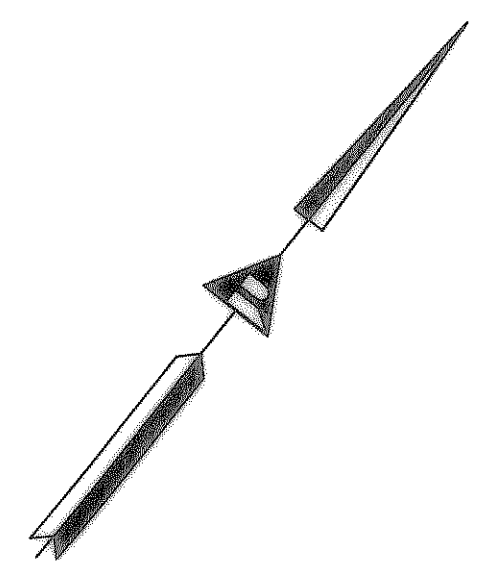
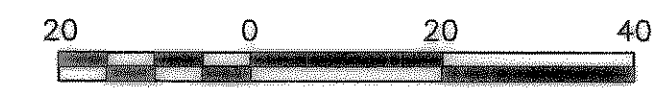
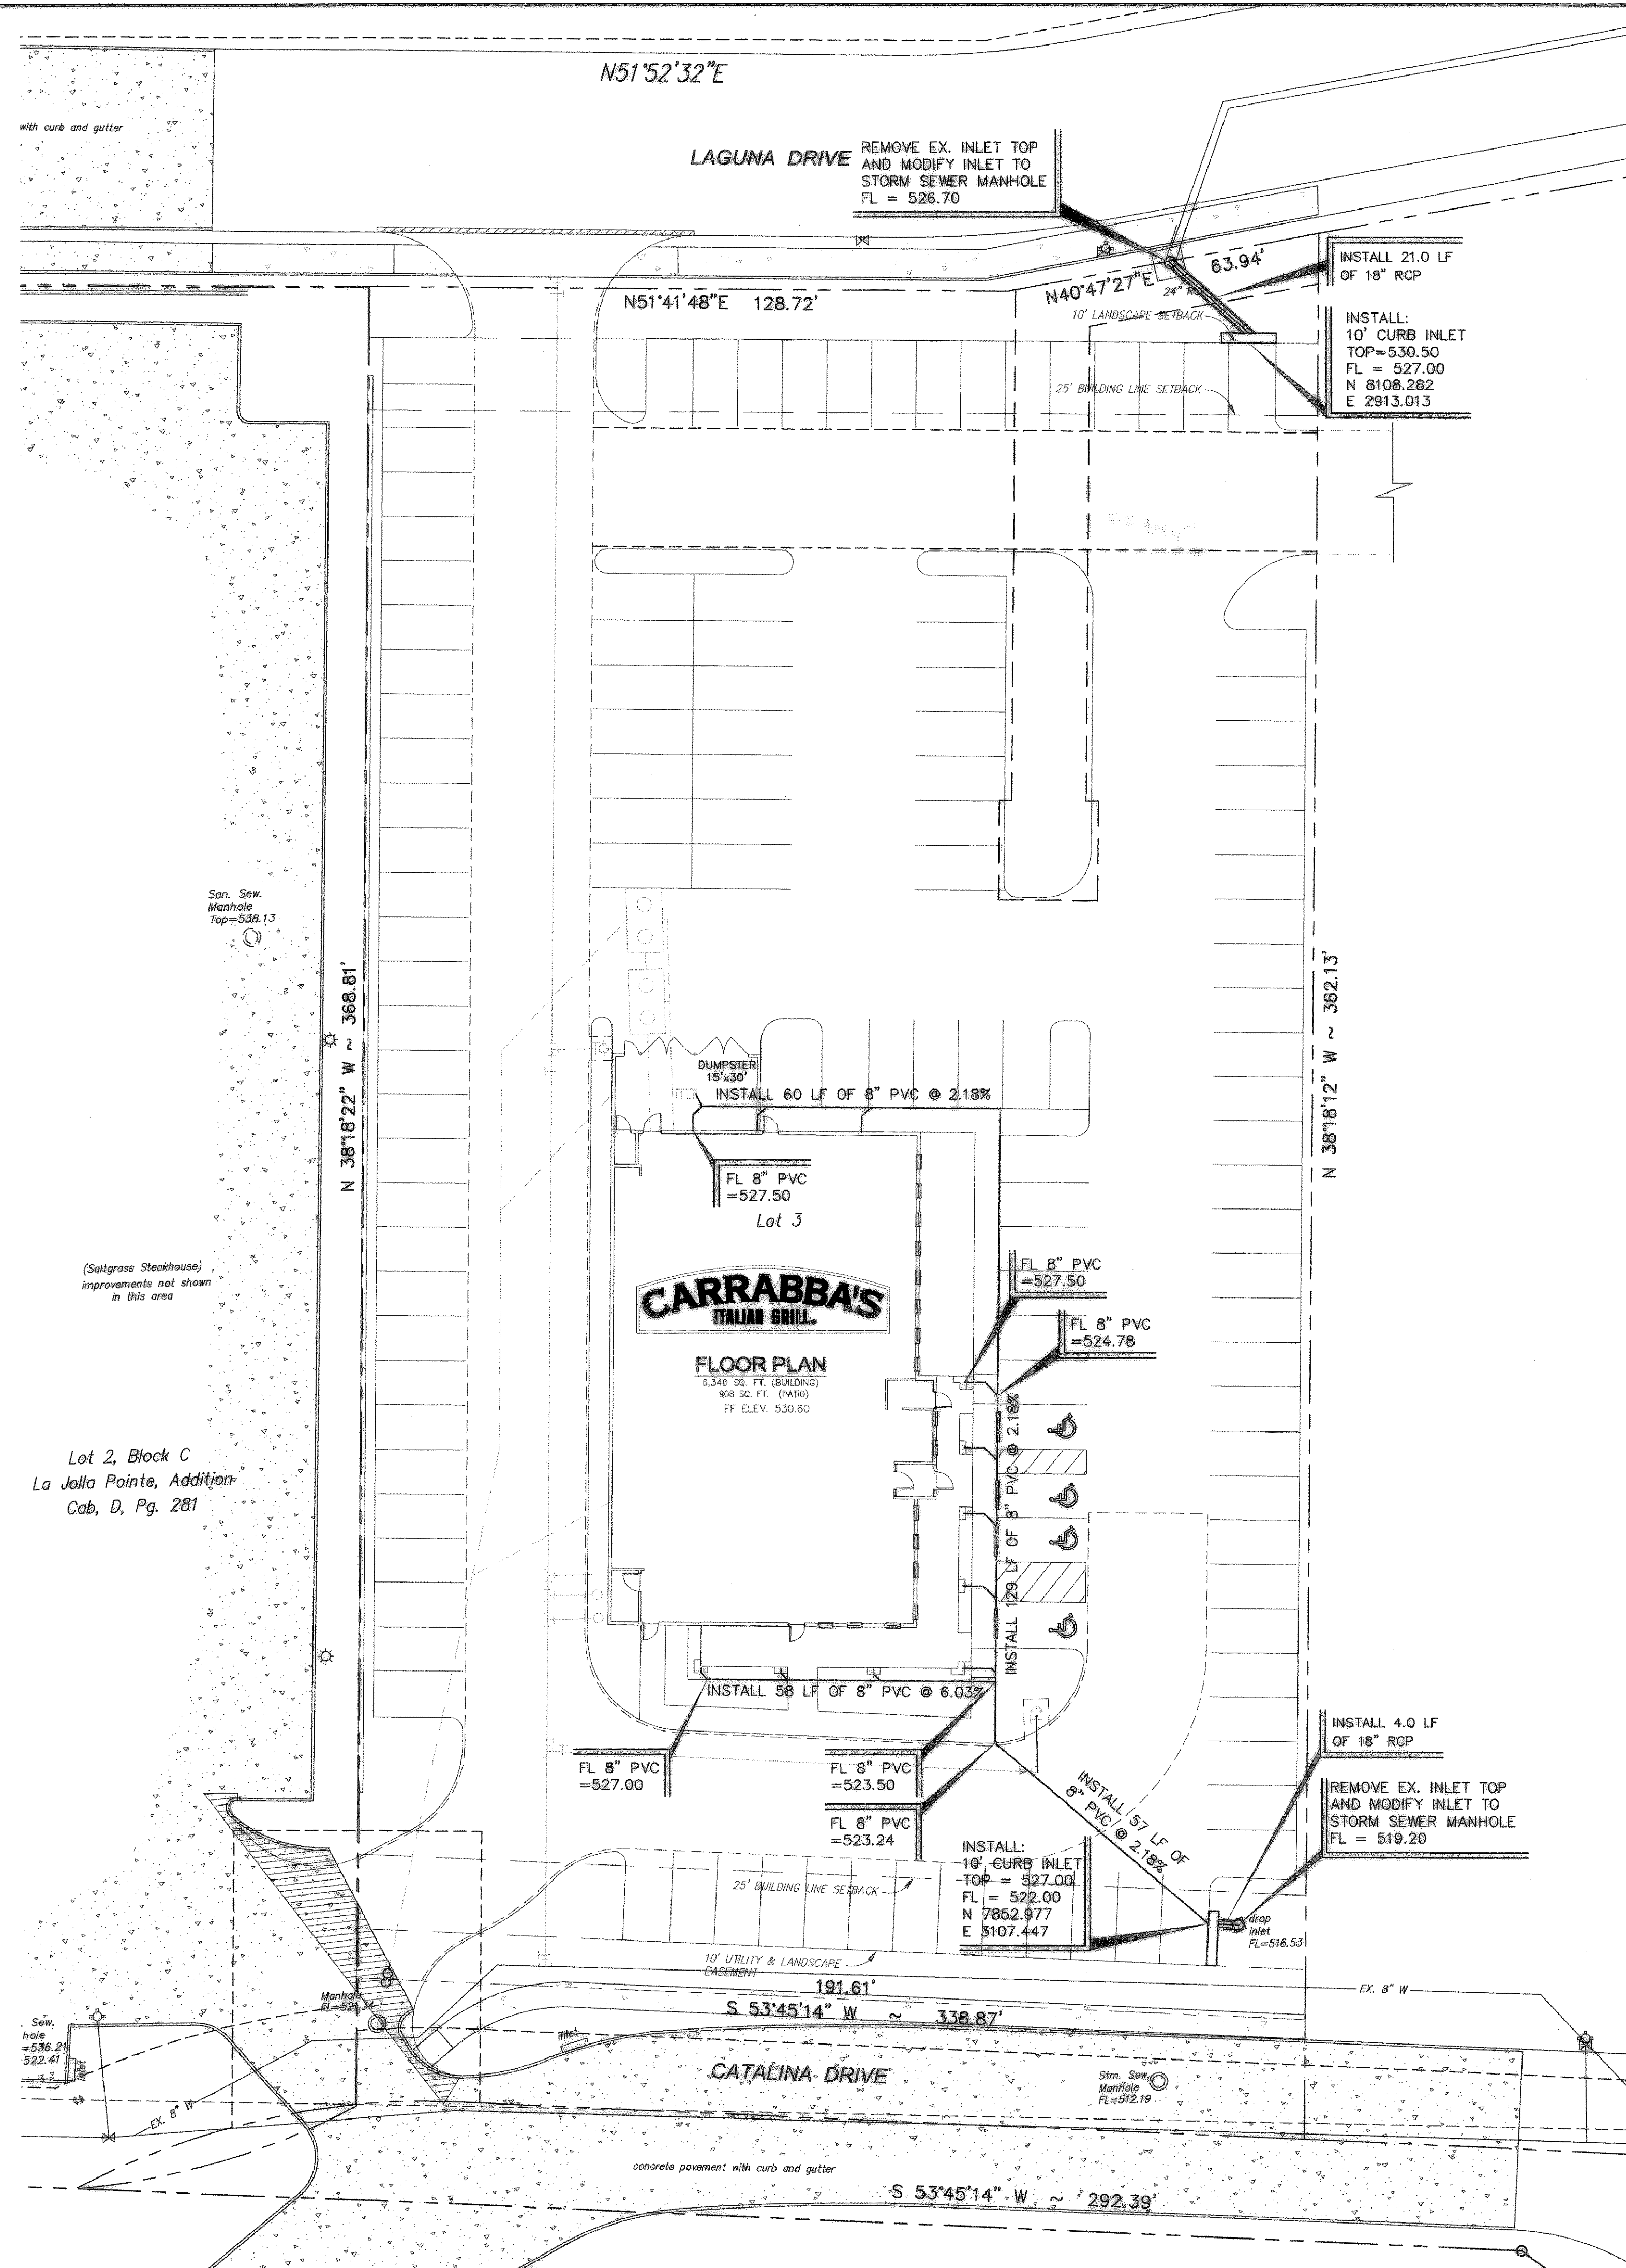


10:\user\piper\031-001 Carrabba's\031-001.dwg, 12/11/03 9:20:32 AM, 1:20

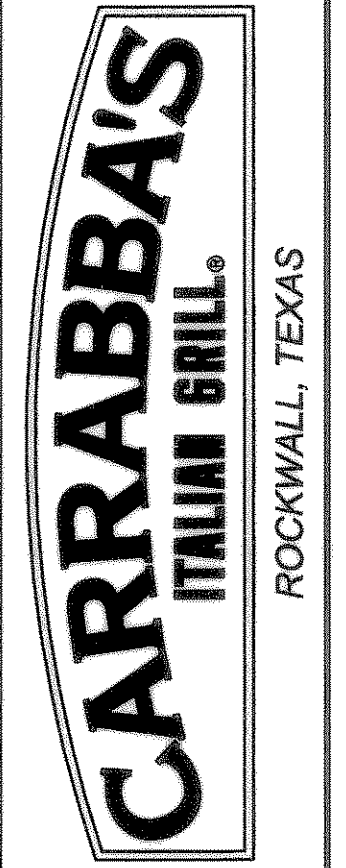

No.	Date	Revisions	App.

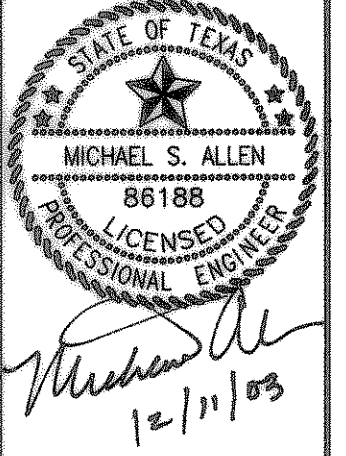

STORM SEWER PLAN

RECORD DRAWINGS
AS PROVIDED BY:
WILSON BARNES
CONSTRUCTION
Michael S. Allen
MICHAEL S. ALLEN, P.E.
DATE: 6/11/04

Scale: 1" = 20'
Designed by: MSA
Drawn by: SDT
Checked by: MSA
Date: December 11, 2003
Project No. 031-001

SHEET
C-6
OF 6