


CIVIL CONSTRUCTION PLANS

FOR



IN THE

CITY OF ROCKWALL, ROCKWALL COUNTY, TEXAS

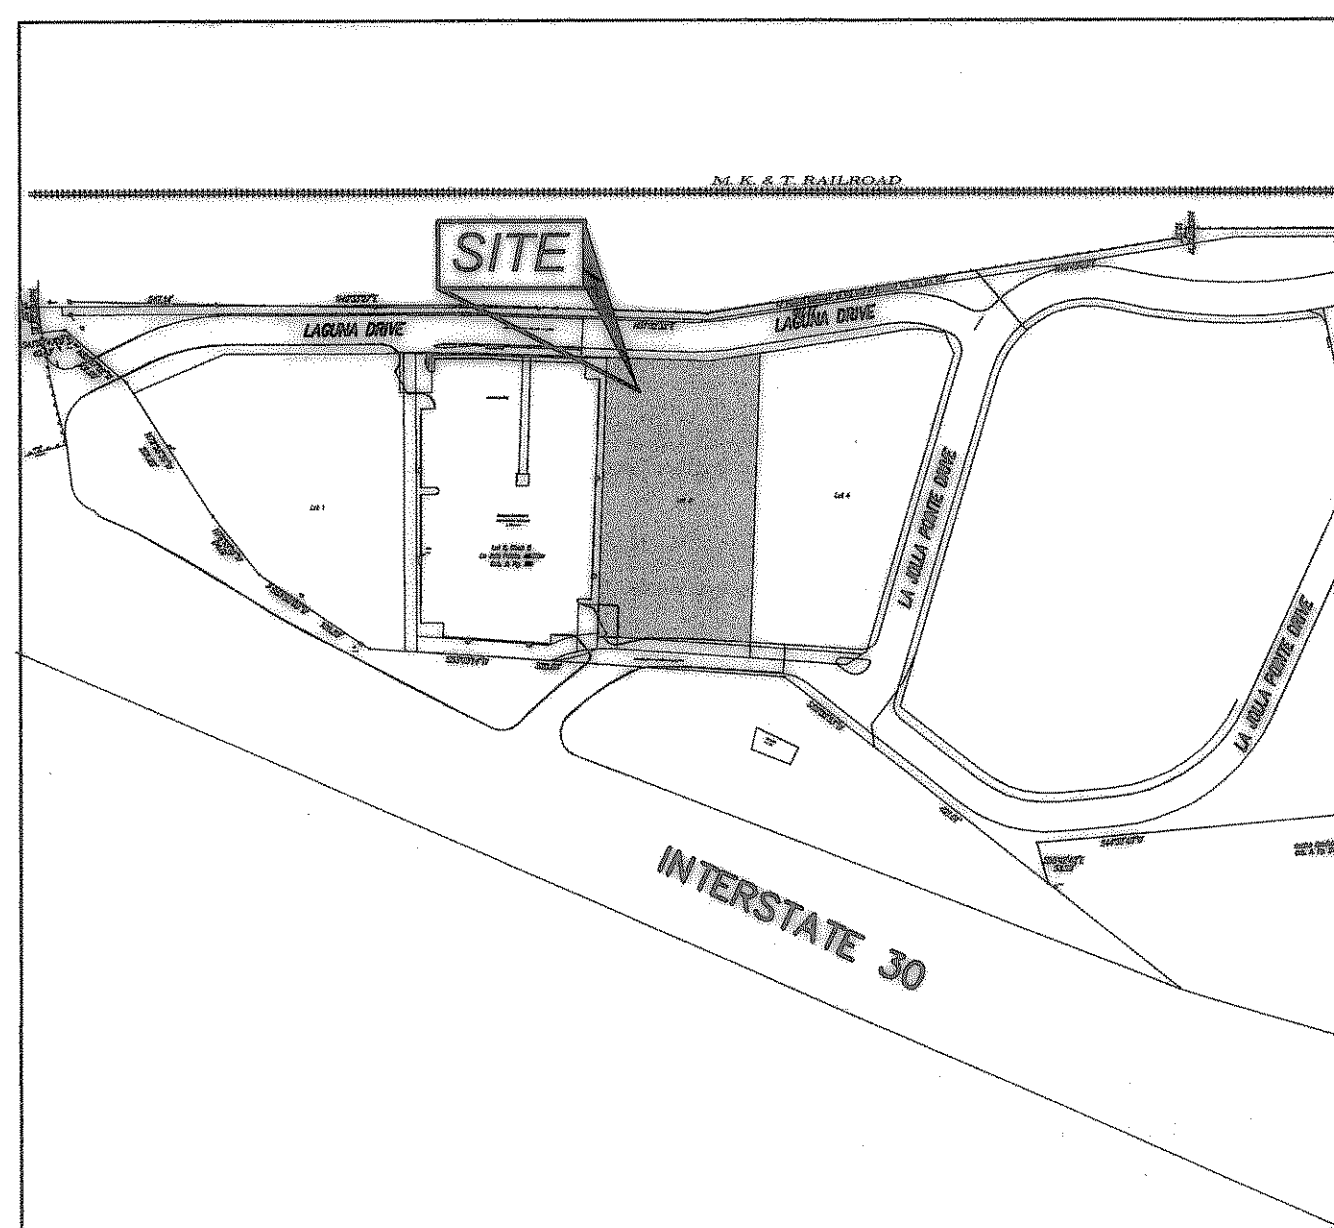

VICINITY MAP
N.T.S.

INDEX OF SHEETS

SHEET NO.	DESCRIPTION
	COVER SHEET
	REPLAT
	SITE PLAN
C-1	GENERAL NOTES
C-2	DIMENSION CONTROL AND PAVING PLAN
C-3	GRADING AND EROSION CONTROL PLAN
C-4	WATER AND SANITARY SEWER PLAN
C-5	DRAINAGE AREA MAP
C-6	STORM SEWER PLAN
LP-1	LANDSCAPE PLAN

PREPARED FOR:

Mr. Eric Hartman
Carrabba's Italian Grill, Inc.
2202 North Westshore Blvd., Fifth Floor
Tampa, Florida 33607
ph. (813) 282-1225
fax (813) 282-9195

PREPARED BY:

Allen & Ridinger
Consulting, Inc.
109 W. Main Street
Lewisville, Texas 75057
Tel. No. (972) 353-8000
Fax No. (972) 353-8011

DECEMBER 2003

RECORD DRAWINGS
AS PROVIDED BY:
WILSON BARNES
CONSTRUCTION
Michael S. Allen
MICHAEL S. ALLEN, P.E.
DATE: 6/11/04



Michael S. Allen
12/11/03