

PAVING LEGEND

	6" DEPTH 3600 psi CONCRETE OVER 6" SCARIFIED SUBGRADE OR AS REQUIRED BY GEOTECHNICAL REPORT.
	5" DEPTH 3000 psi CONCRETE OVER 6" SCARIFIED SUBGRADE OR AS REQUIRED BY GEOTECHNICAL REPORT.
	PAVEMENT TO BE REMOVED

NOTES:

- ALL RADII ARE 2.50' UNLESS NOTED OTHERWISE.
- ALL DIMENSIONS ARE TO THE BACK OF CURB.
- TOTAL PARKING:**
 5 HANDICAP SPACES
 116 SPACES
 121 TOTAL SPACES



NOTES:

- ALL HANDICAPP RAMP SHALL BE TEXTURED AS PER ADA REGULATIONS.

RECORD DRAWINGS AS PROVIDED BY:
 WILSON BARNES CONSTRUCTION

Michael S. Allen
 MICHAEL S. ALLEN, P.E.
 DATE: 6/11/04

No.	Date	Revisions	App.
1/2/04		REVISIONS DUE TO HANDICAPP REVIEW	

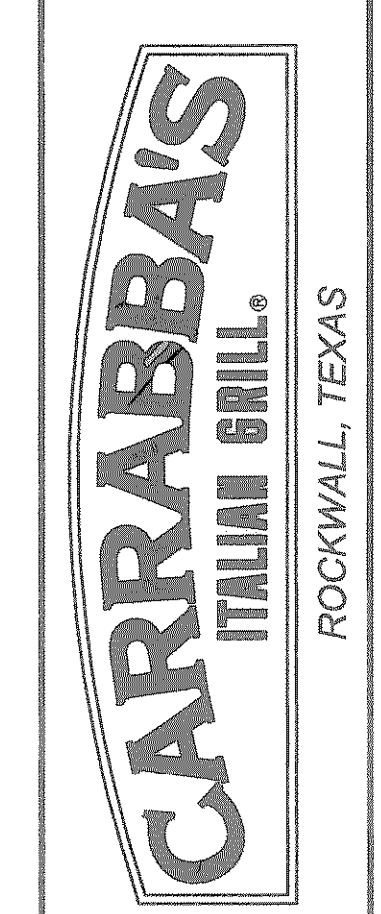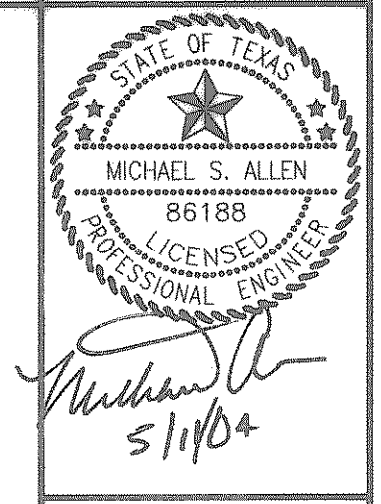

DIMENSION CONTROL & PAVING PLAN

Scale: 1" = 20'	Designed by: MSA	Drawn by: SDT	Checked by: MSA	Date: December 31, 2003	Project No. 031-001
SHEET C-2					OF 6

I:\data\projects\031-001_Carrabba's\03-Dim-ctrl.dwg, 5/11/2004 9:20:30 AM, C:\p1m\apj