



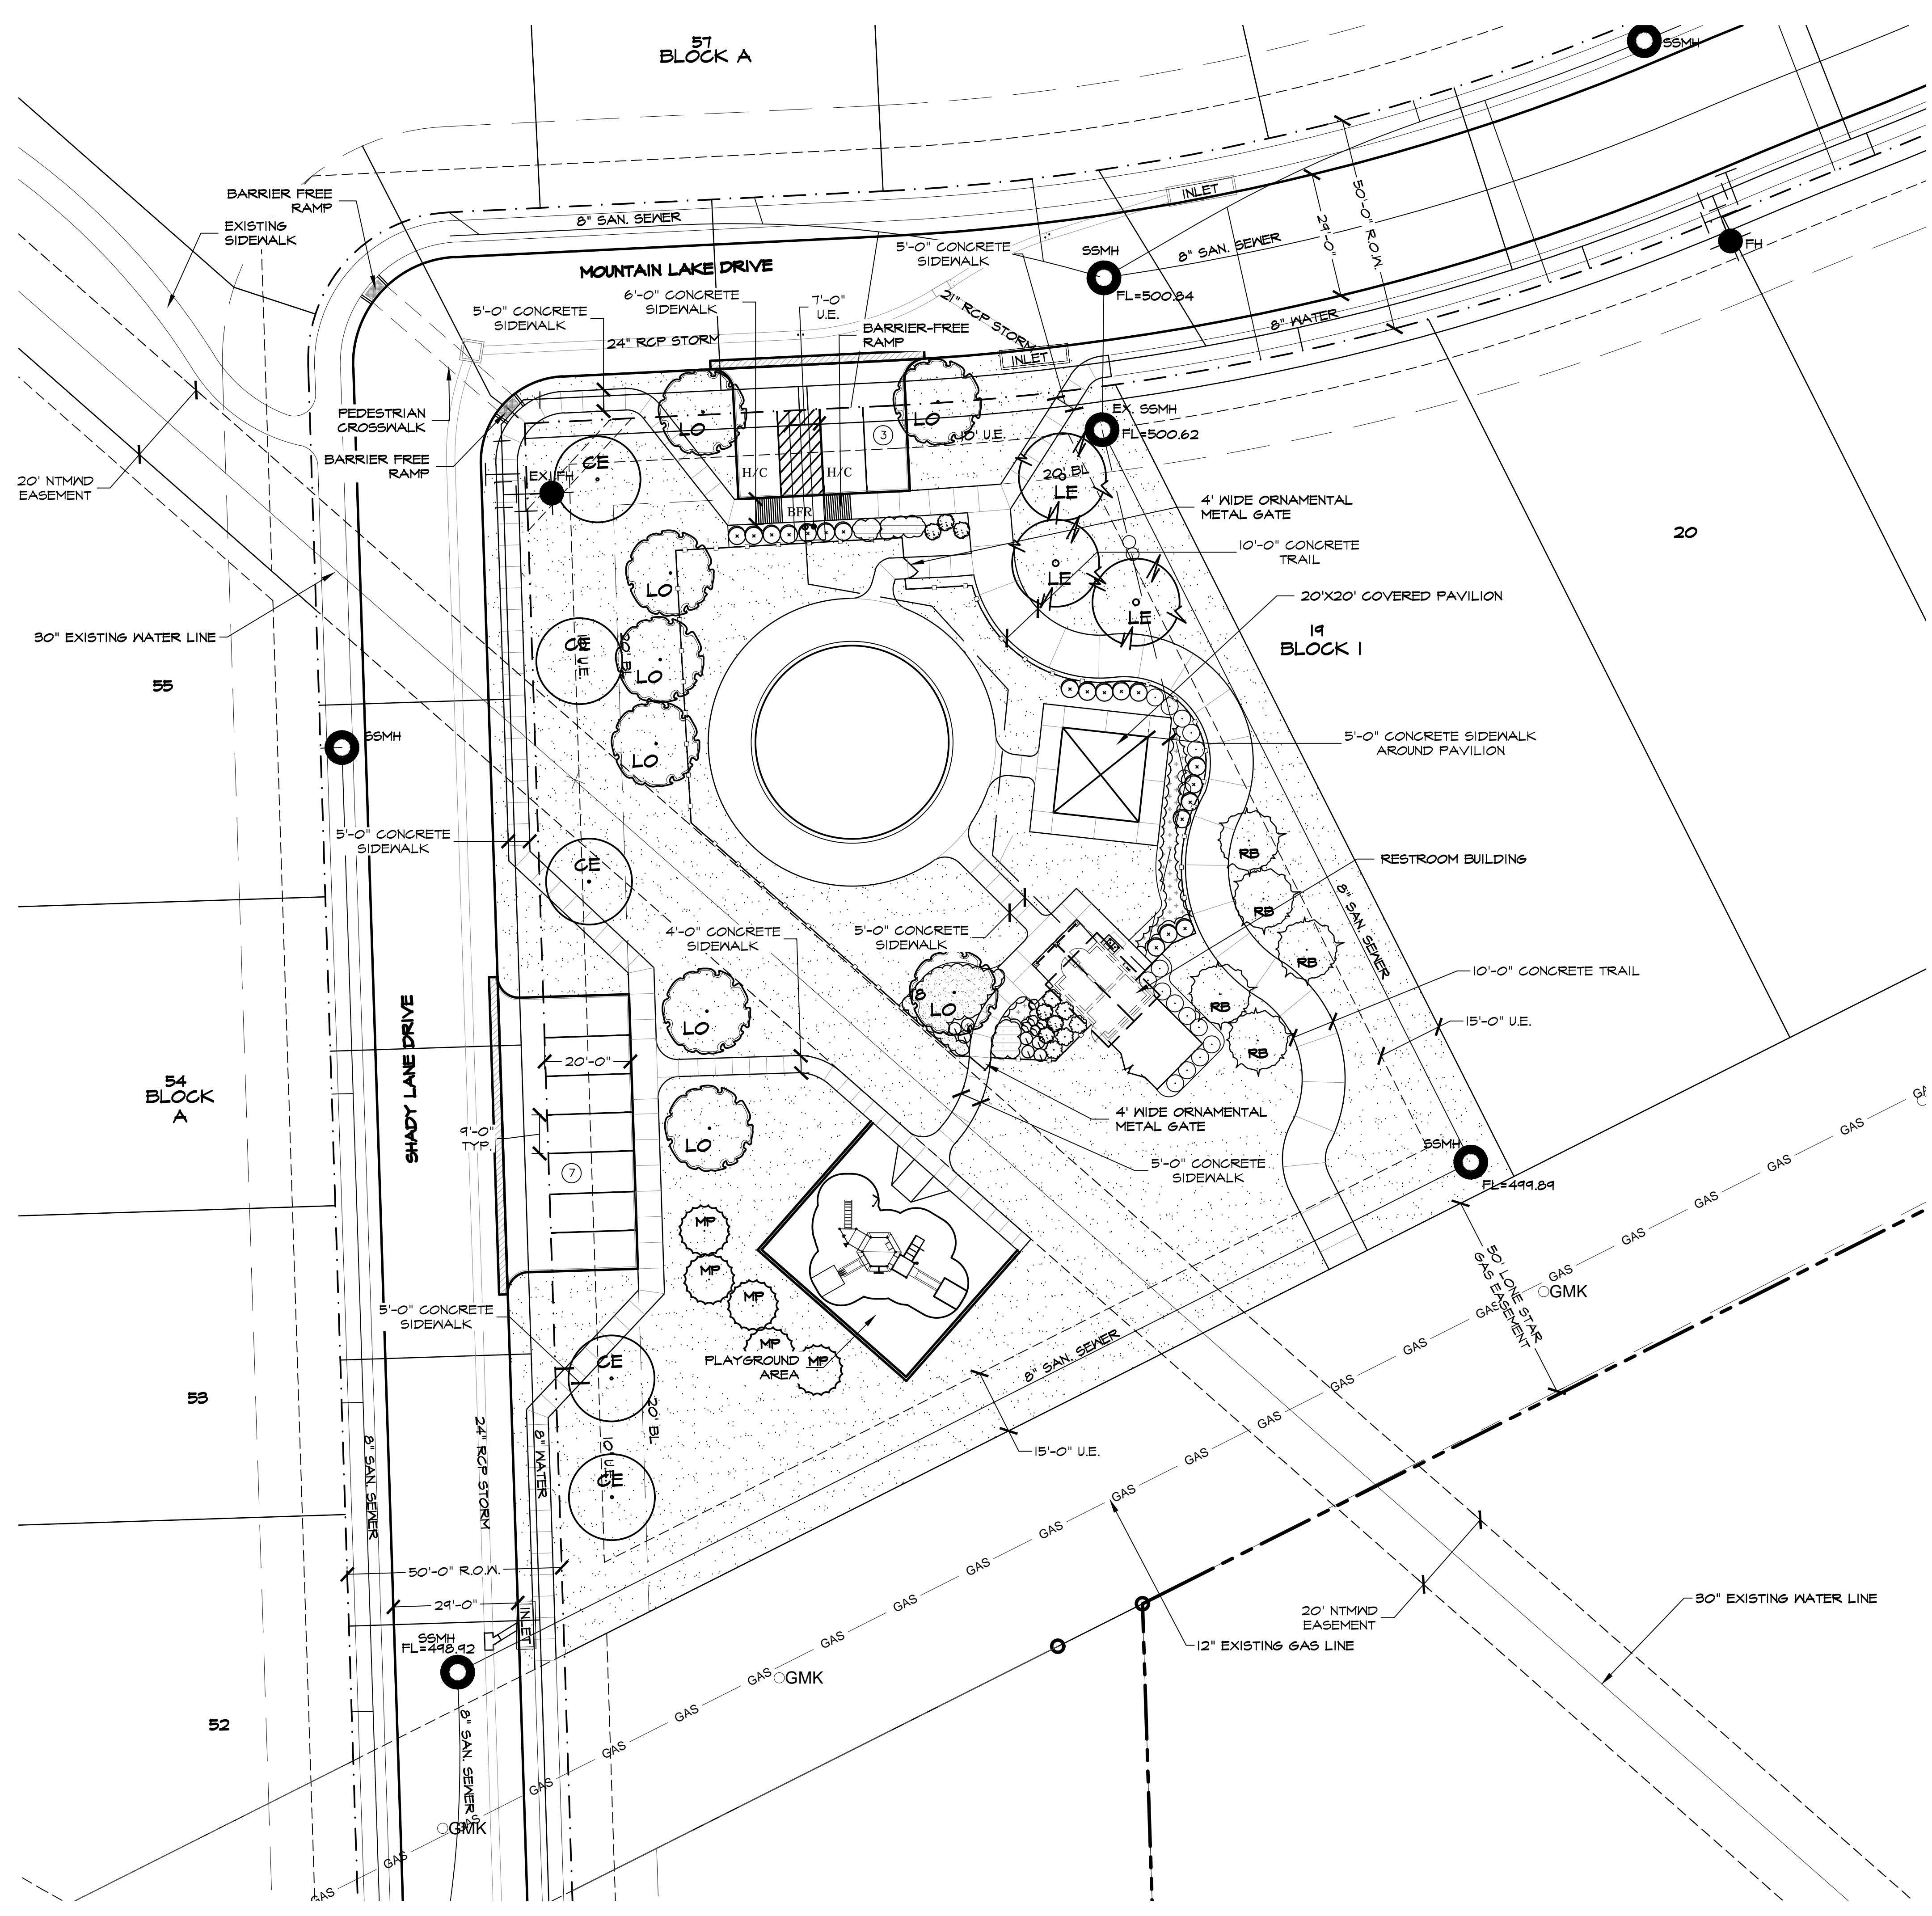
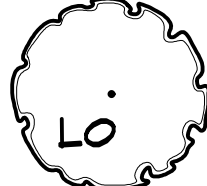
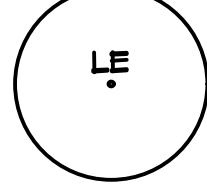
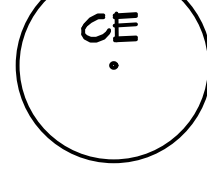
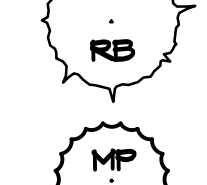
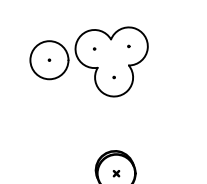


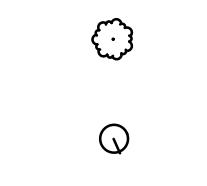

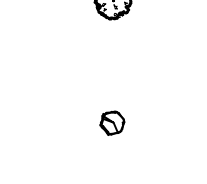

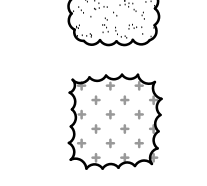

Drawing: S:\Projects\HOR004\DWG\As-Built\Plans\HOR004 - LS AsBuilt Plans 1-19-2017.dwg Saved By: Station5 Save Time: 1/19/2017 3:47 PM  
 Plotted by: ##### Plot Date: 1/19/2017 3:48 PM

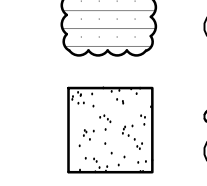


**LANDSCAPE LEGEND**


-  LIVE OAK / QUERCUS VIRGINIANA (3" CALIPER)
-  LACEBARK ELM / ULMUS PARVIFOLIA (3" CALIPER)
-  CEDAR ELM / ULMUS CRASSIFOLIA (3" CALIPER)
-  TEXAS REDBUD / CERCIS CANADENSIS VAR. TEXENSIS (2" CALIPER)
-  MEXICAN PLUM / PRUNUS MEXICANA (2" CALIPER)
-  DWARF BURFORD HOLLY / ILEX CORNUTA 'DWARF BURFORD' (7 GALLON)
-  'PURPLE DIAMOND' LOROPETALUM / LOROPETALUM CHINENSE 'PURPLE DIAMOND' (7 GALLON)
-  TEXAS SAGE / LEUCOPHYLLUM FRUTESCENS (7 GALLON)
-  BLACK KNIGHT BUTTERFLY BUSH / BUDDLEJA DAVIDII 'BLACK KNIGHT' (3 GALLON)
-  'ANTHONY WATERER' SPIREA / SPIREA X BUMALDA 'ANTHONY WATERER' (5 GALLON)
-  INDIAN HAWTHORN 'SNOW' / RAPHIOLEPIS INDICA 'SNOW WHITE' (3 GALLON)
-  WEEPING LOVE GRASS / ERAGROSTIS CURVULA (1 GALLON; PLANTS SPACED AT 18" O.C.)
-  BLUE RUG JUNIPER / JUNIPERUS HORIZONTALIS (3 GALLON; PLANTS SPACED AT 36" O.C.)
-  ANNUAL COLOR TO BE SELECTED BY OWNER (4" POT; PLANTS SPACED 8" O.C.)
-  COMMON BERMUDA HYDROMULCH (MINIMUM 100% COVERAGE @ 10% DENSITY)

**RECORD DRAWINGS (JANUARY 19, 2017)**  
 NOTE: THE INTENT OF THE OWNER AND LANDSCAPE ARCHITECT WAS TO CONSTRUCT THE IMPROVEMENTS ACCORDING TO THESE PLANS AS APPROVED BY THE CITY OF ROCKWALL. THE LINES AND GRADES WERE SET ON THE GROUND FOR CONSTRUCTION ACCORDING TO SAID PLANS. WE ARE NOT AWARE OF ANY CHANGES OR REVISIONS TO THESE PLANS DURING CONSTRUCTION EXCEPT AS NOTED ON THE PLANS. THE INFORMATION PROVIDED IS BASED ON SURVEYING OF THE SITE AND INFORMATION PROVIDED BY THE CONTRACTOR.

**STUDIO 13 DESIGN GROUP**  
 Studio 13 Design Group, PLLC.  
 386 W. Main Street  
 Lewisville, Texas 75057  
 469-635-1900  
 TBAE Firm #BR643

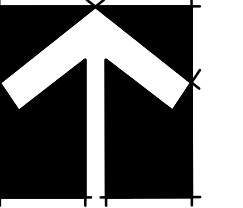NORTH

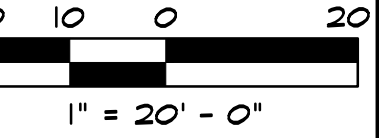

1" = 20' - 0"

Bar is one inch on original drawing. If not one inch on this sheet, adjust scale as necessary.

**LANDSCAPE AND SCREENING**  
 Landscape Plans  
 Caruth Lakes, Ph. 8B Amenity Center  
 City of Rockwall, Rockwall County, Texas

#	DATE	BY	PLAN REVIEW REVISIONS
1	04/21/2015	AEW	Redlines per City Comments
2	06/29/2015	AEW	Redlines per City Comments
3	09-14-2015	LWR	Issued for construction (PreCon September 14, 2015)

PROJECT  
**HOR004**  
 SHEET  
**LS1**

**AS-BUILT PLANS**