
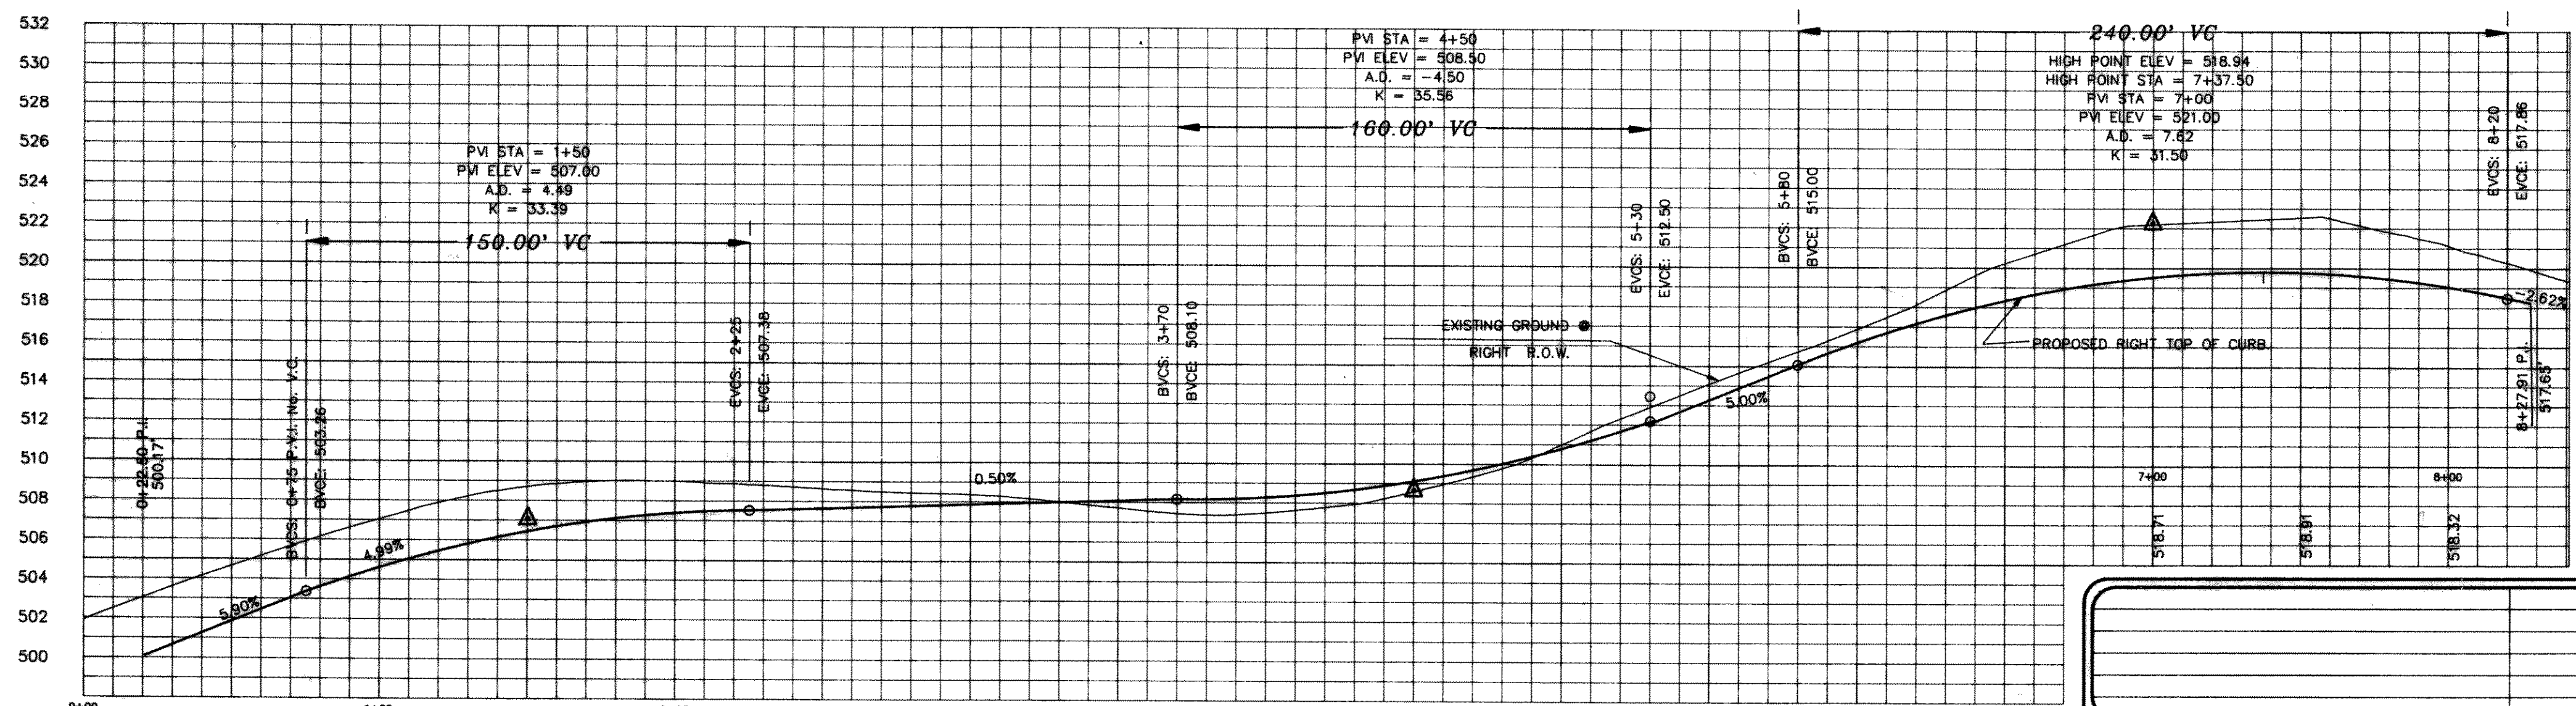


CURVE	RADIUS	LENGTH	TANGENT	CHORD	DELTA
C12	1088.14'	197.88'	99.21'	197.60'	10°25'09"
C13	1158.00'	280.94'	141.16'	280.25'	13°54'01"
C14	175.00'	66.59'	44.20'	65.71'	28°21'03"

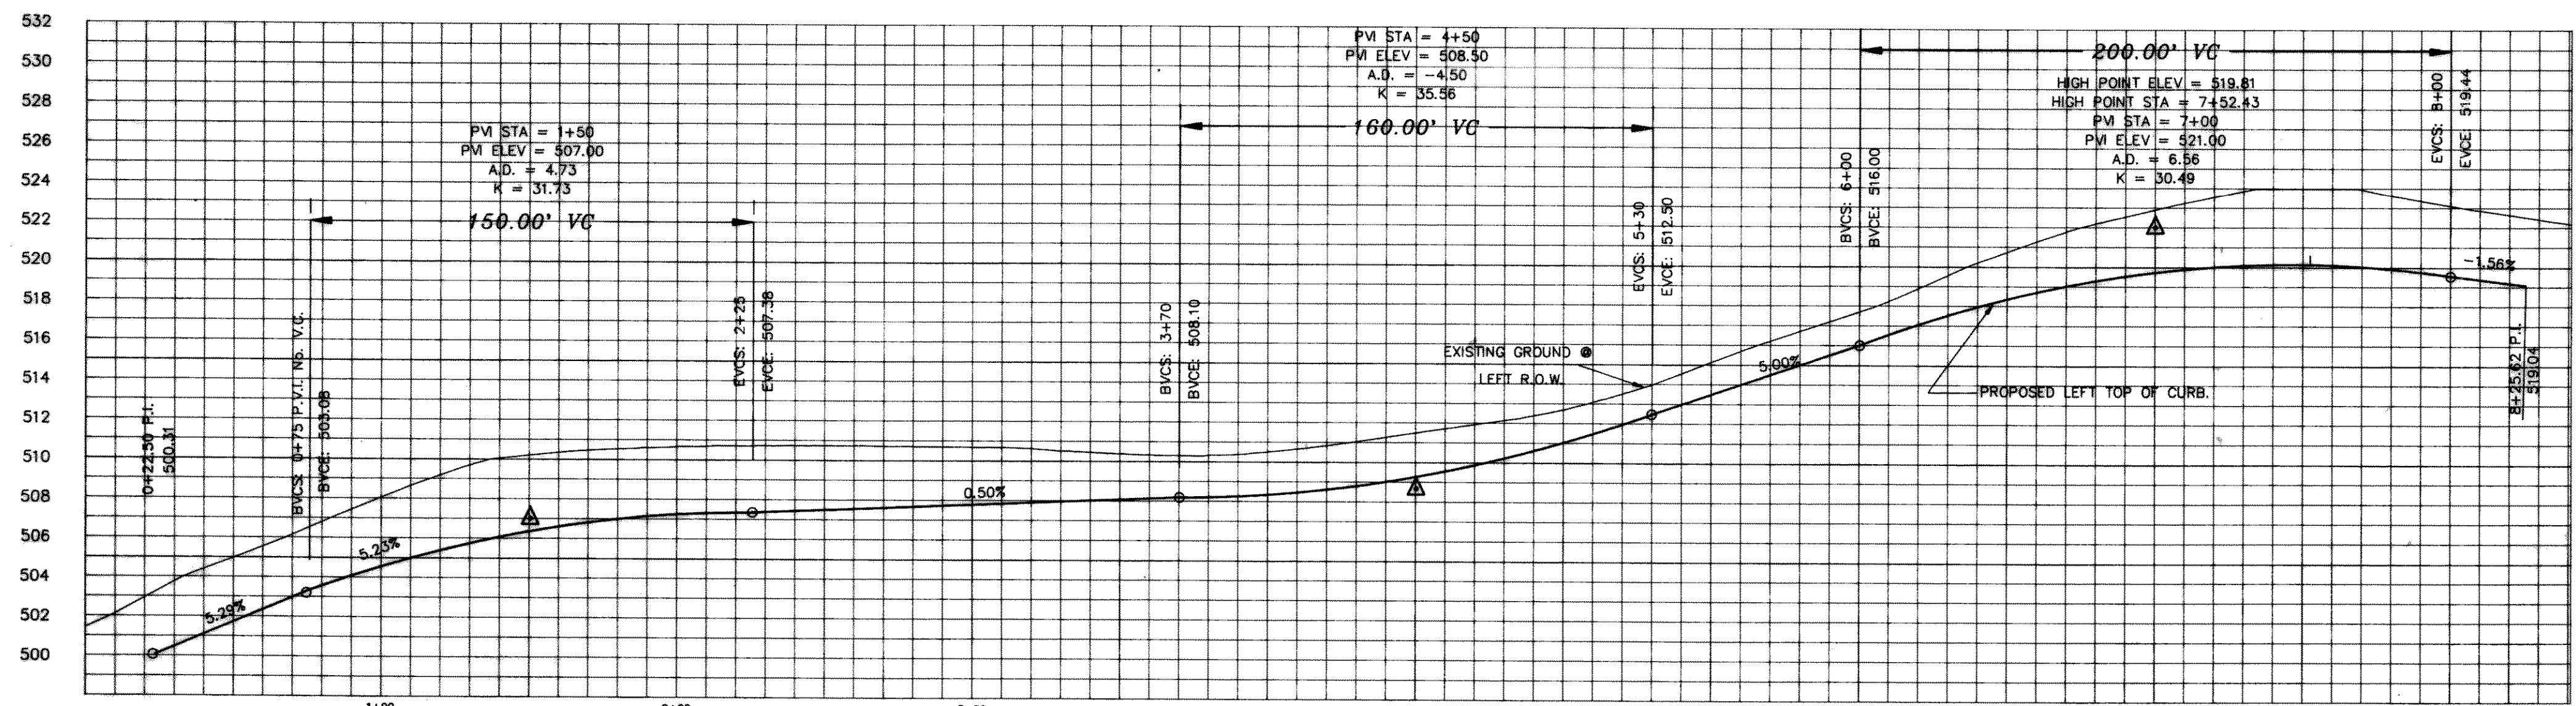

B.M.
 SQUARE ON N. END OF HWY. ON EAST
 SIDE OF ST. HWY. NO. 205, 170' ±
 SOUTH OF CENTERLINE OF CARUTH LANE.
 ELEVATION = 482.40

B.M.
 NORTHEAST TOP OF CURB AT NORTH END
 OF FANNIN STREET, 545' ± EAST OF
 SOUTHEAST ADDITION CORNER.
 ELEVATION = 518.18

AS BUILT
H.L.E.
 2-94

REVISION DESCRIPTION	DATE	SCALE	DESIGN	DRAWN
	3/25/94	1" = 40' HOR. 1" = 6' VERT.	R.L.E.	K.R.B.

HAROLD L. EVANS CONSULTING ENGINEER P.O. BOX 28355 2331 CUS THOMASSON ROAD, SUITE 102 DALLAS, TEXAS 75228, (214) 328-8133		PAVING PLAN CARUTH LAKE PHASE ONE WHISPERING GLEN CITY OF ROCKWALL	SHEET NO. 6 OF 11 JOB NO. 9322
--	--	---	--