


B.M.
 SQUARE ON N. END OF HDWL ON EAST
 SIDE OF ST. HWY. NO. 205, 170' ±
 SOUTH OF CENTERLINE OF CARUTH LANE.
 ELEVATION = 482.40

B.M.
 NORTHEAST TOP OF CURB AT NORTH END
 OF FANNIN STREET, 545' ± EAST OF
 SOUTHEAST CORNER.
 ELEVATION = 518.18

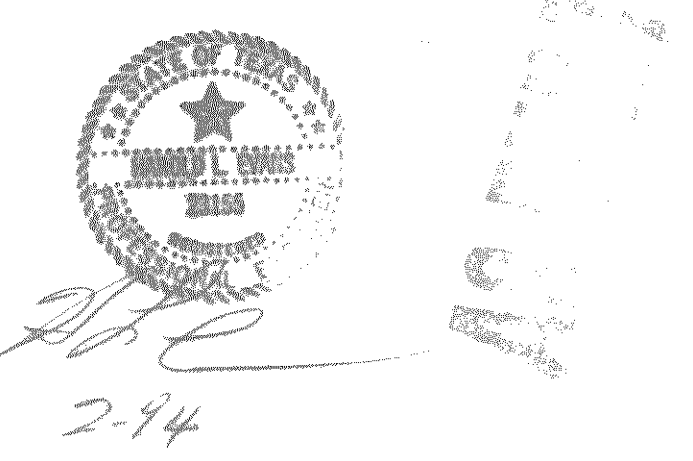

HAROLD L. EVANS CONSULTING ENGINEER P.O. BOX 28363 DALLAS, TEXAS 75228 (214) 328-8133		STORM SEWER PLAN CARUTH LAKE PHASE ONE CITY OF ROCKWALL ROCKWALL COUNTY, TEXAS		SHEET NO. 10 / 11	
REVISION DESCRIPTION	DATE FEB. 17, 1984	SCALE 1" = 40' 1" = 6'	DESIGN H.L.E.	DRAWN K.E.B.	JOB NO. 9322