



**A** TYPICAL TUBULAR STEEL SECTION  
SCALE: 1/2"=1'-0"


ALL BRICK WALLS WILL BE BUILT IN THE FIELD. NO PRE-CAST WALLS WILL BE USED.

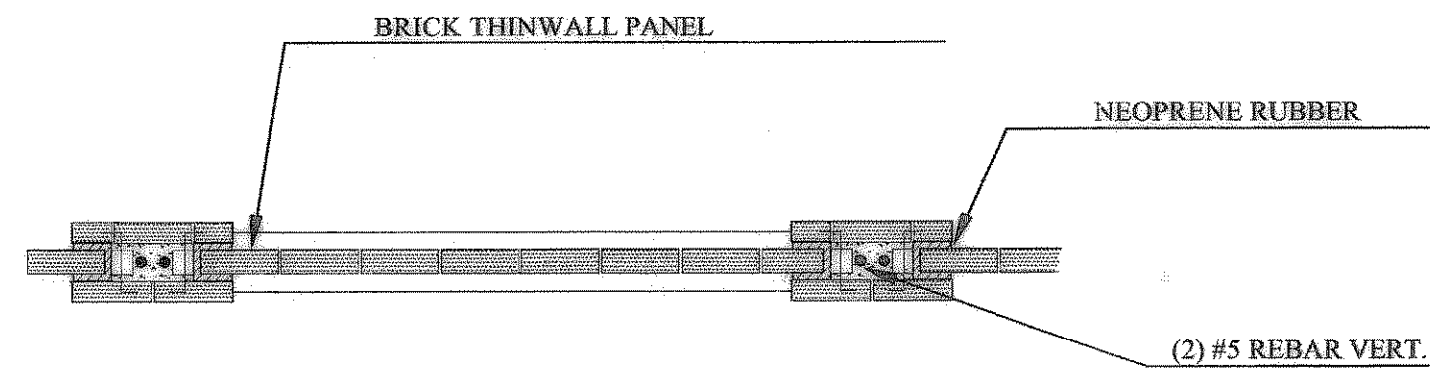


**E** THINWALL SECTION  
SCALE: 1/2"=1'-0"

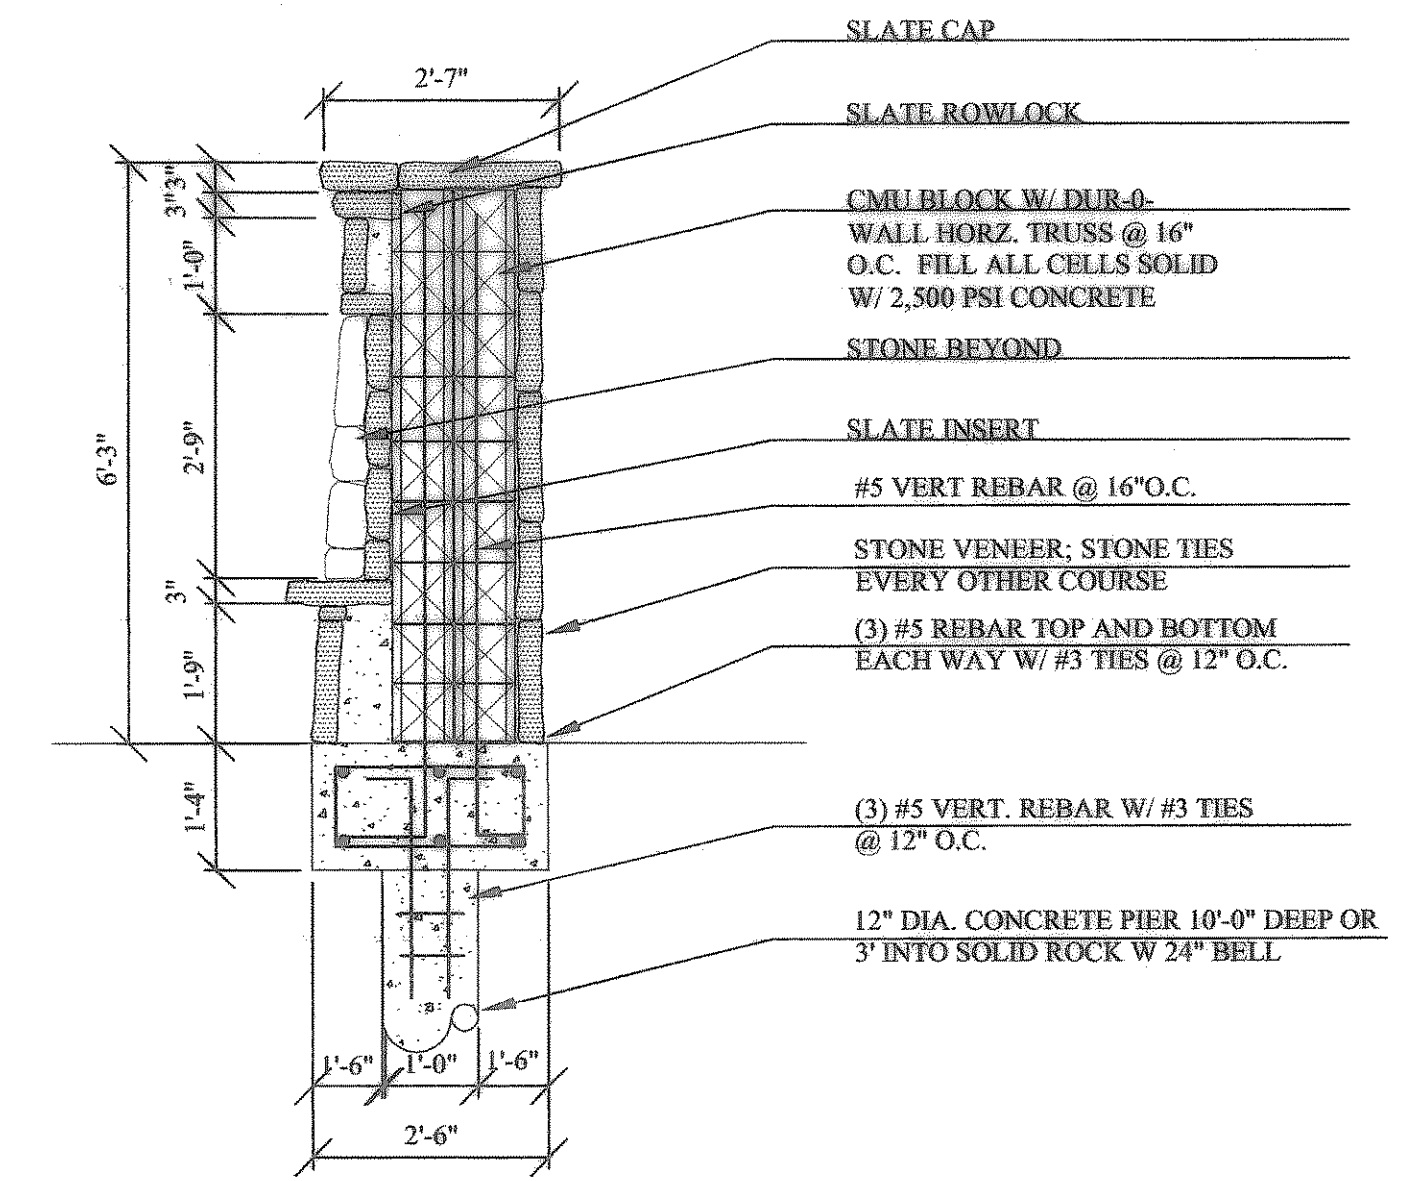


**H** ENHANCED COLUMN SECTION  
SCALE: 1/2"=1'-0"

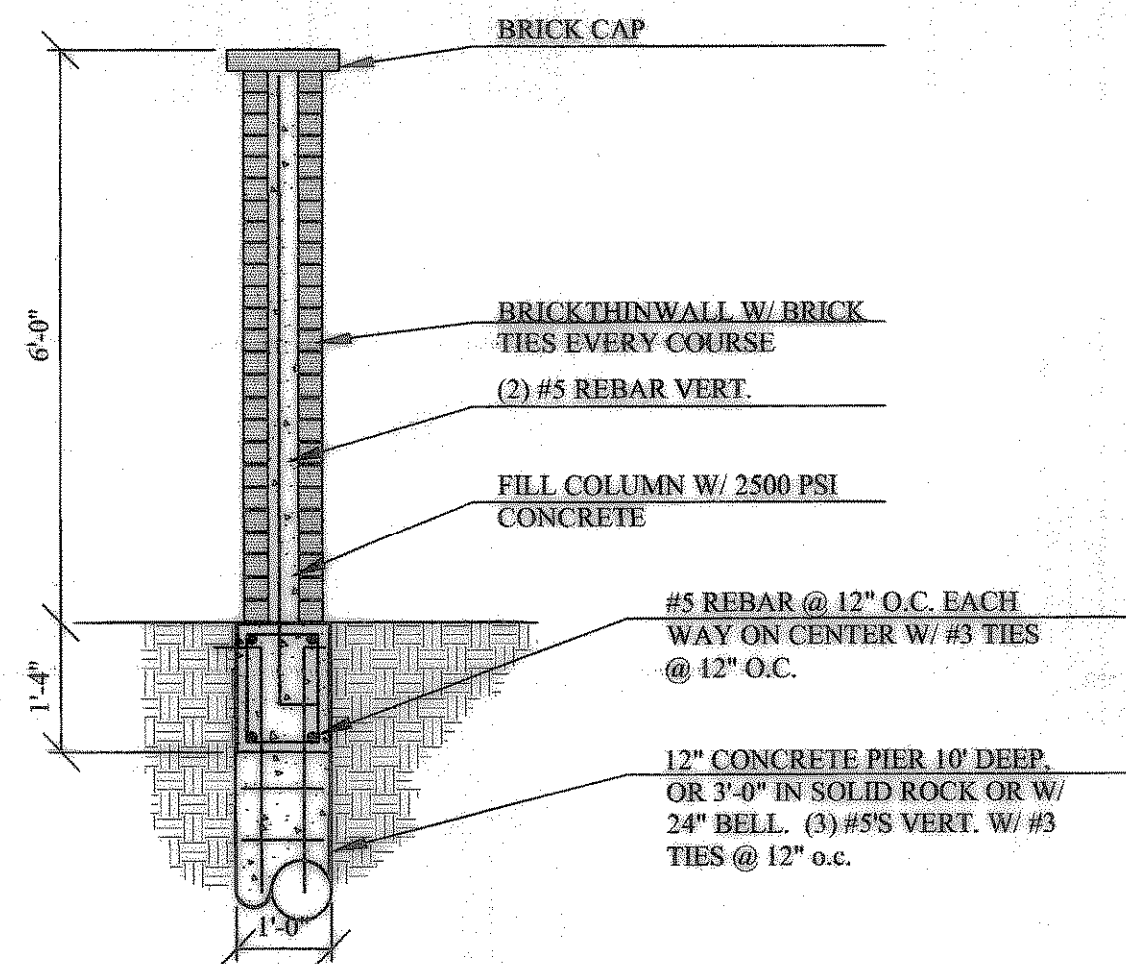


**B** THINWALL COLUMN SECTION  
SCALE: 1/2"=1'-0"

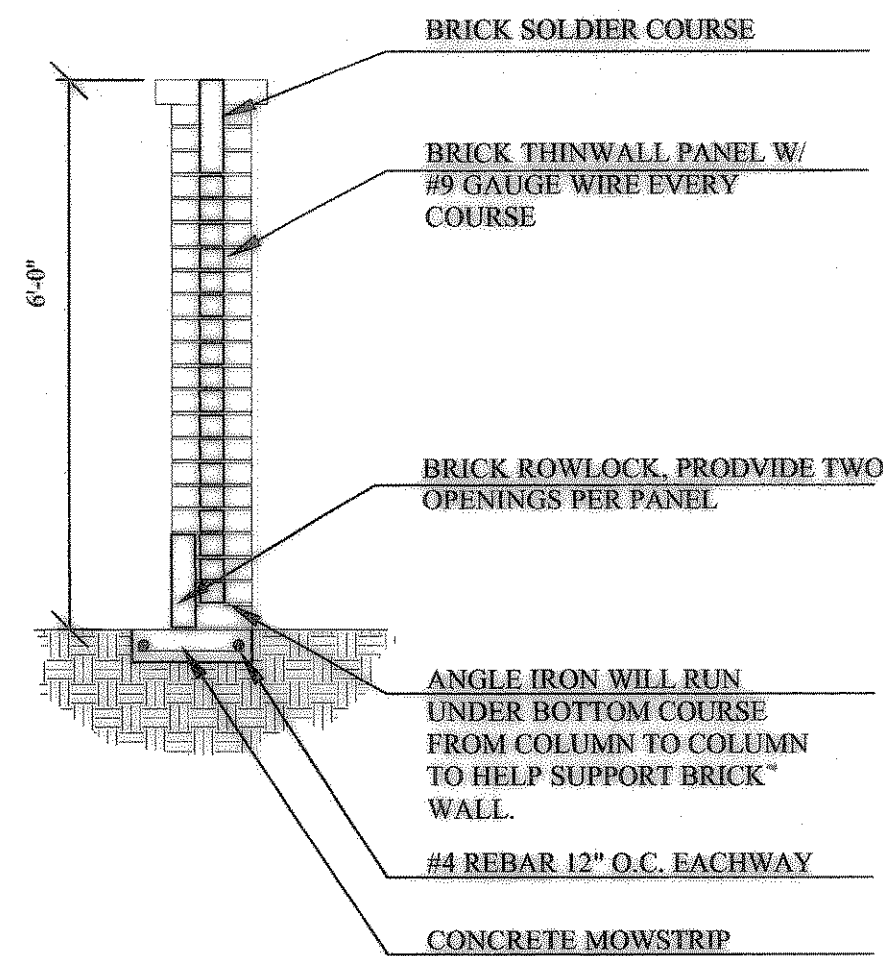


**C** THINWALL SECTION  
SCALE: 1/2"=1'-0"

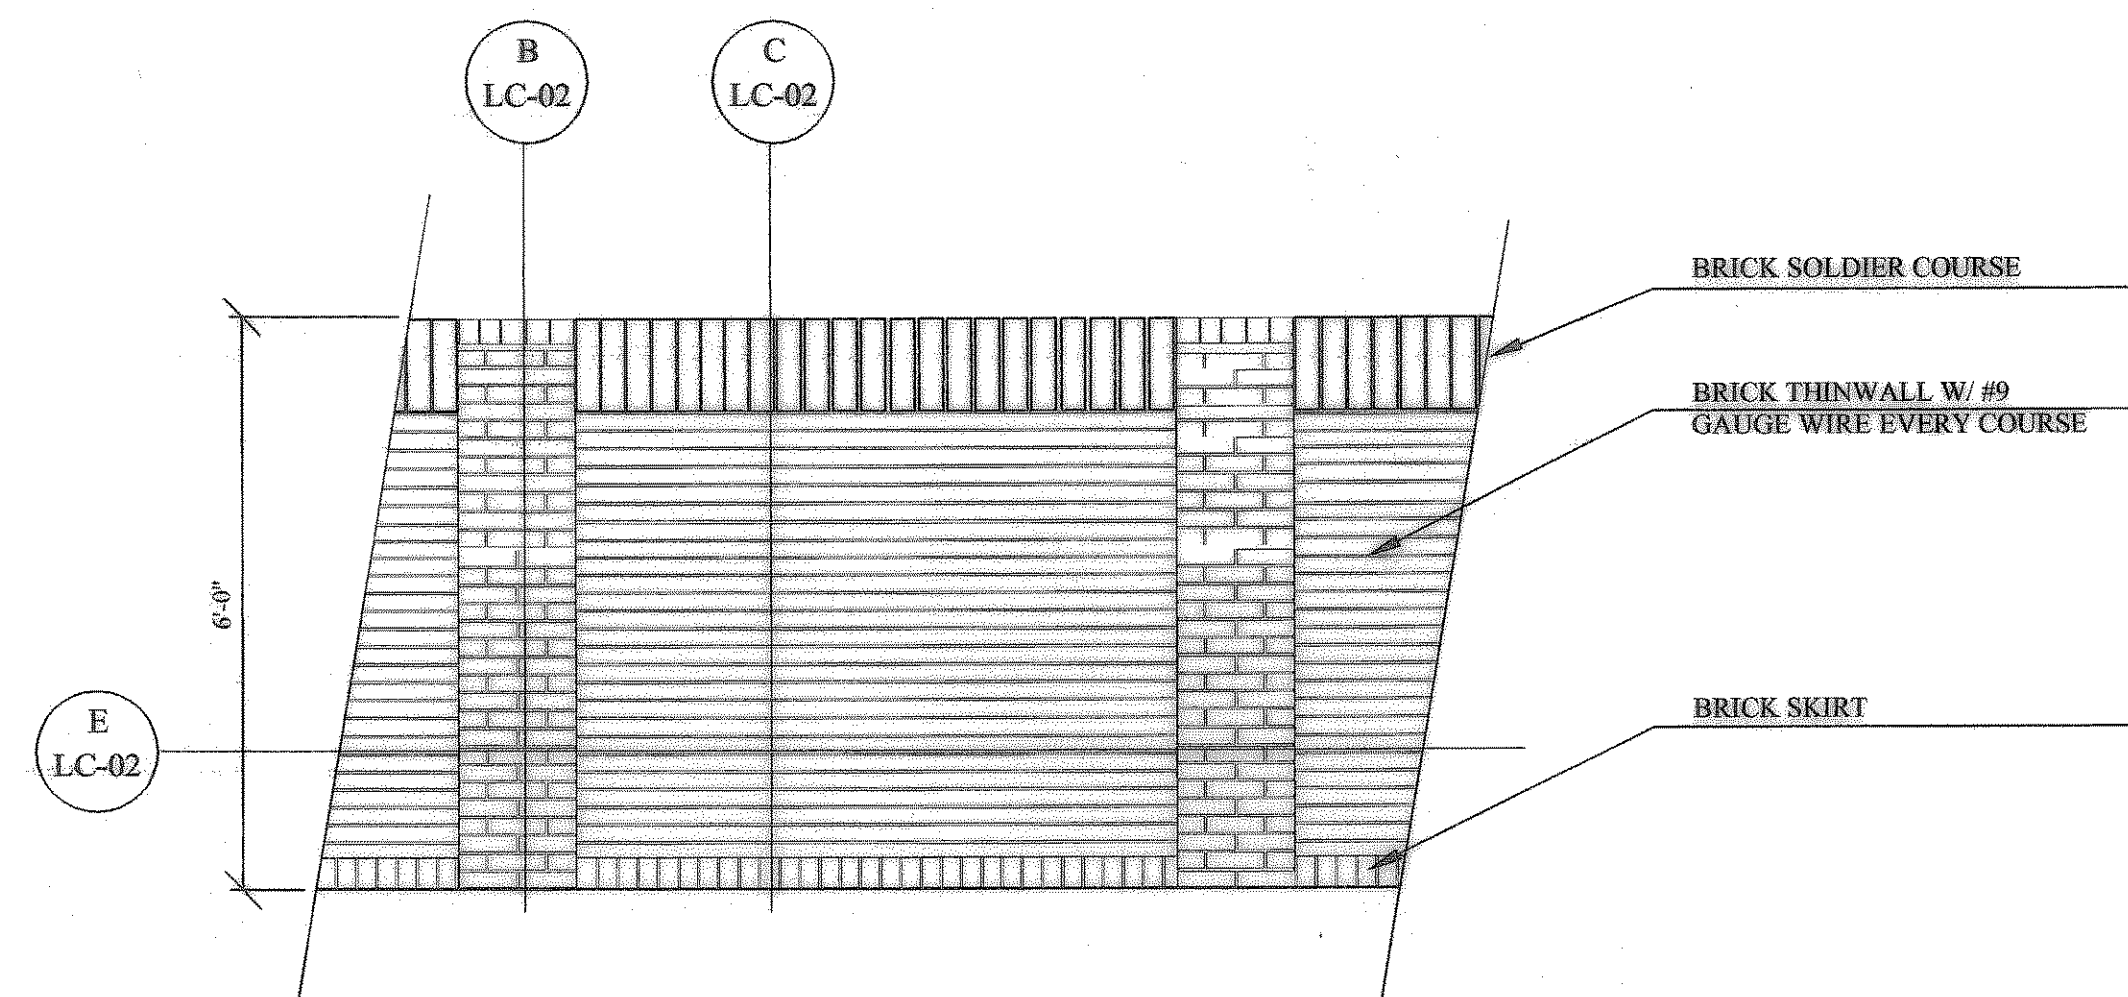


**D** THINWALL ELEVATION  
SCALE: 1/2"=1'-0"

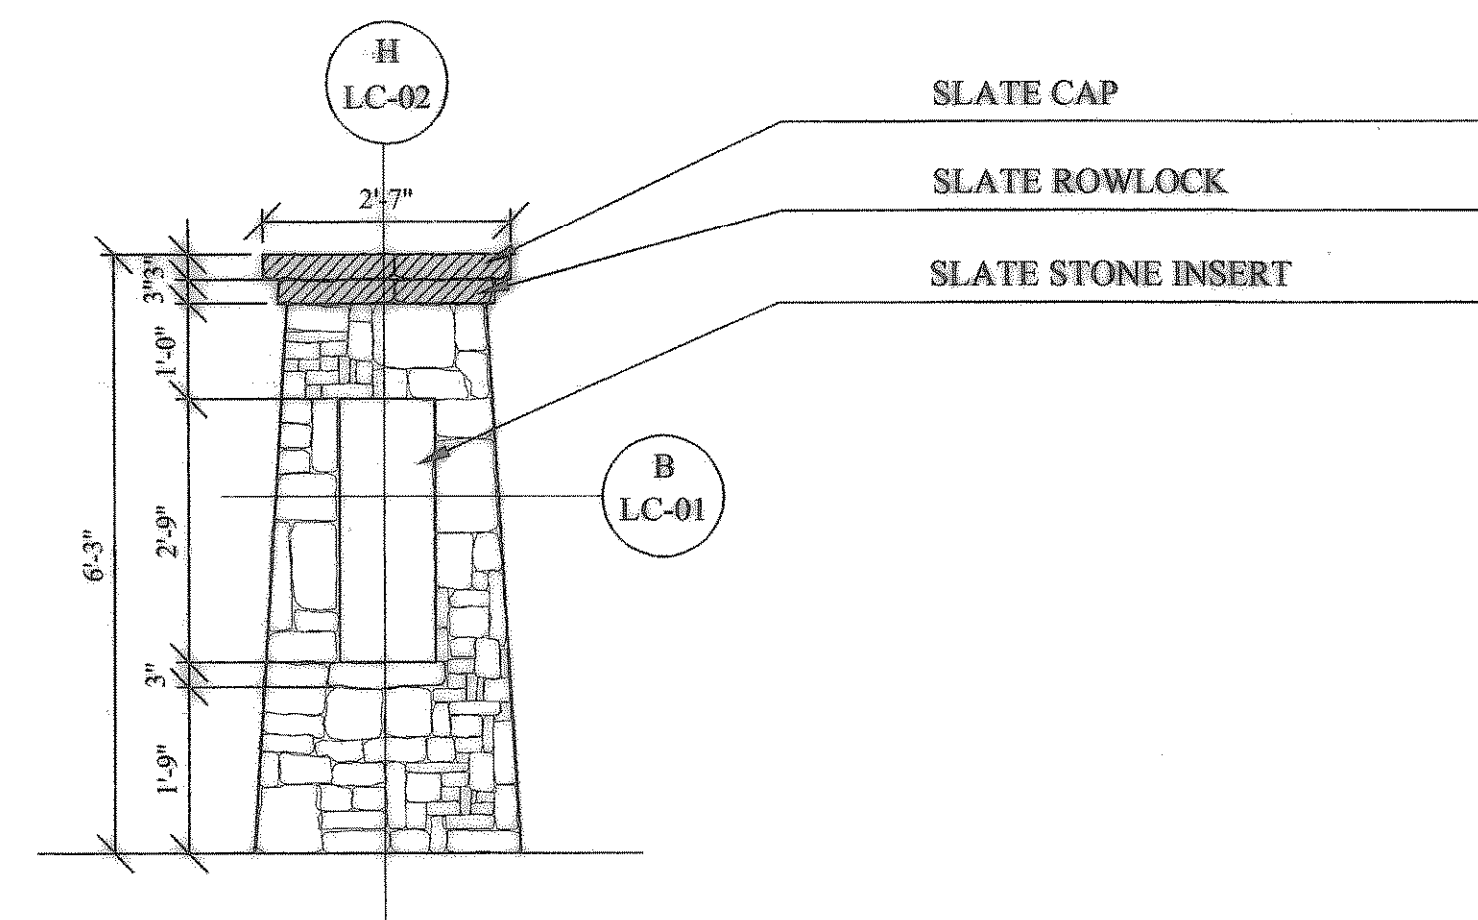

**G** ENHANCED COLUMN ELEVATION  
SCALE: 1/2"=1'-0"

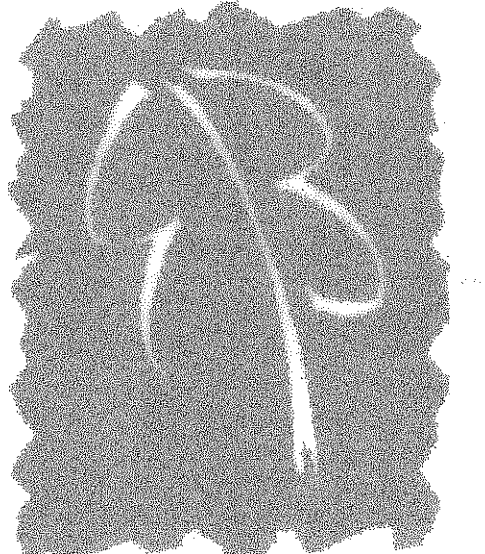

Ironwood Design Group  
of Texas  
302 Brookside Drive  
Grapevine, Texas 76051  
Office: (817) 329-7643  
Fax: (817) 488-5833

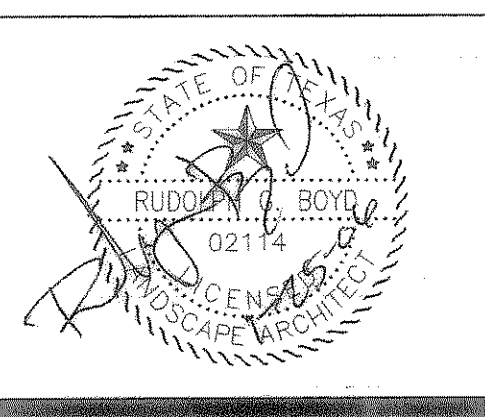

Caruth Lakes  
Phase I  
Rockwall, Texas

PROJECT NUMBER
DRAWN BY:
CHECKED BY: RGB
DATE PREPARED 08-05-03
DATE REVISED 12-10-03 04-24-04 08-01-05 10-10-05

Sheet Title  
Construction  
Details

Sheet Number  
LC-02