
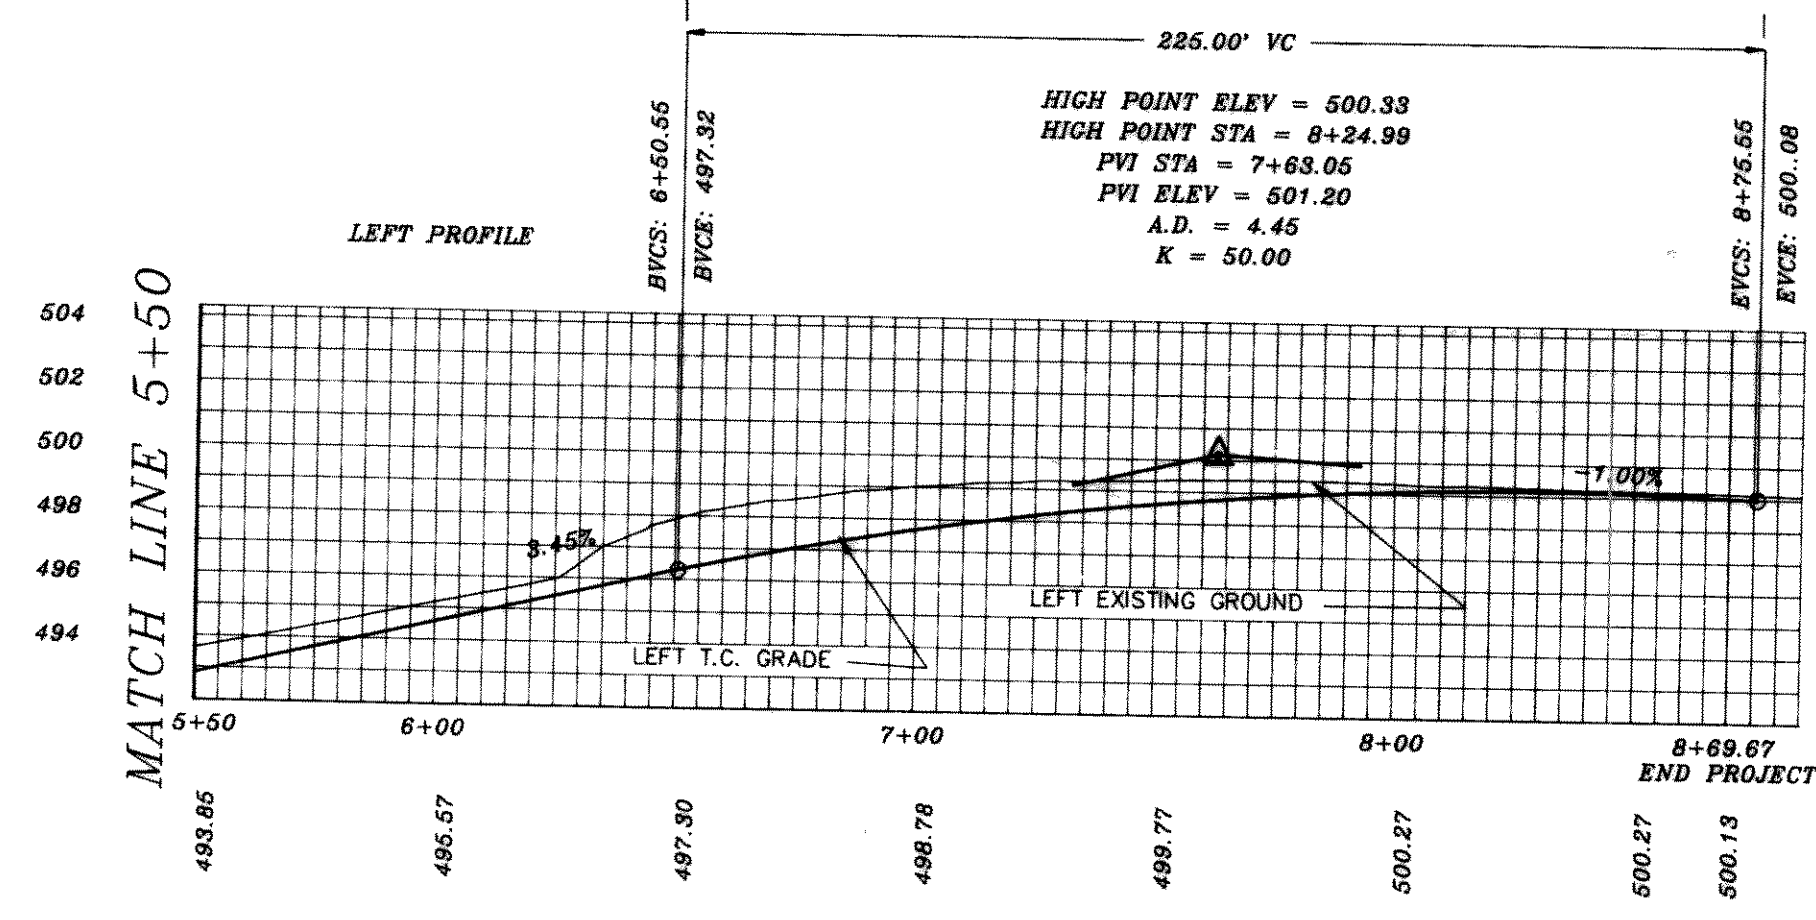
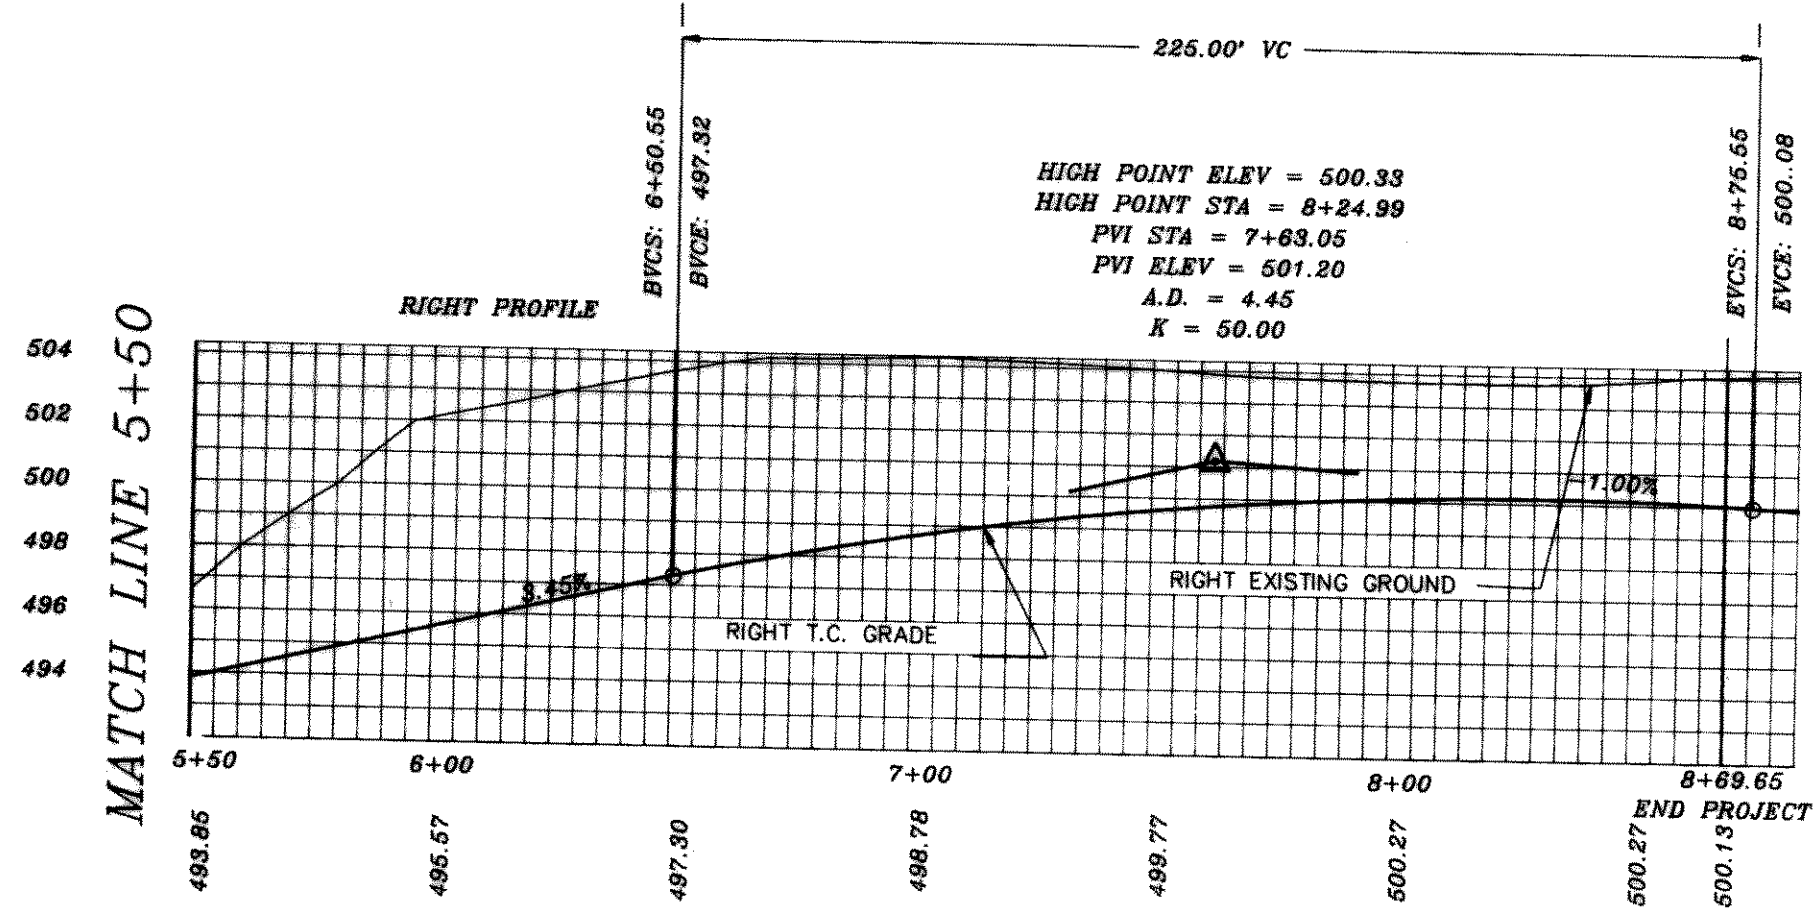


CURVE	RADIUS	LENGTH	TANGENT	CHORD	BEARING	DELTA
C10	1040.00'	35.93'	17.97'	35.93'	N87°39'46" W	01°58'46"
C11	1040.00'	283.73'	142.75'	282.85'	S87°21'55" W	16°37'52"

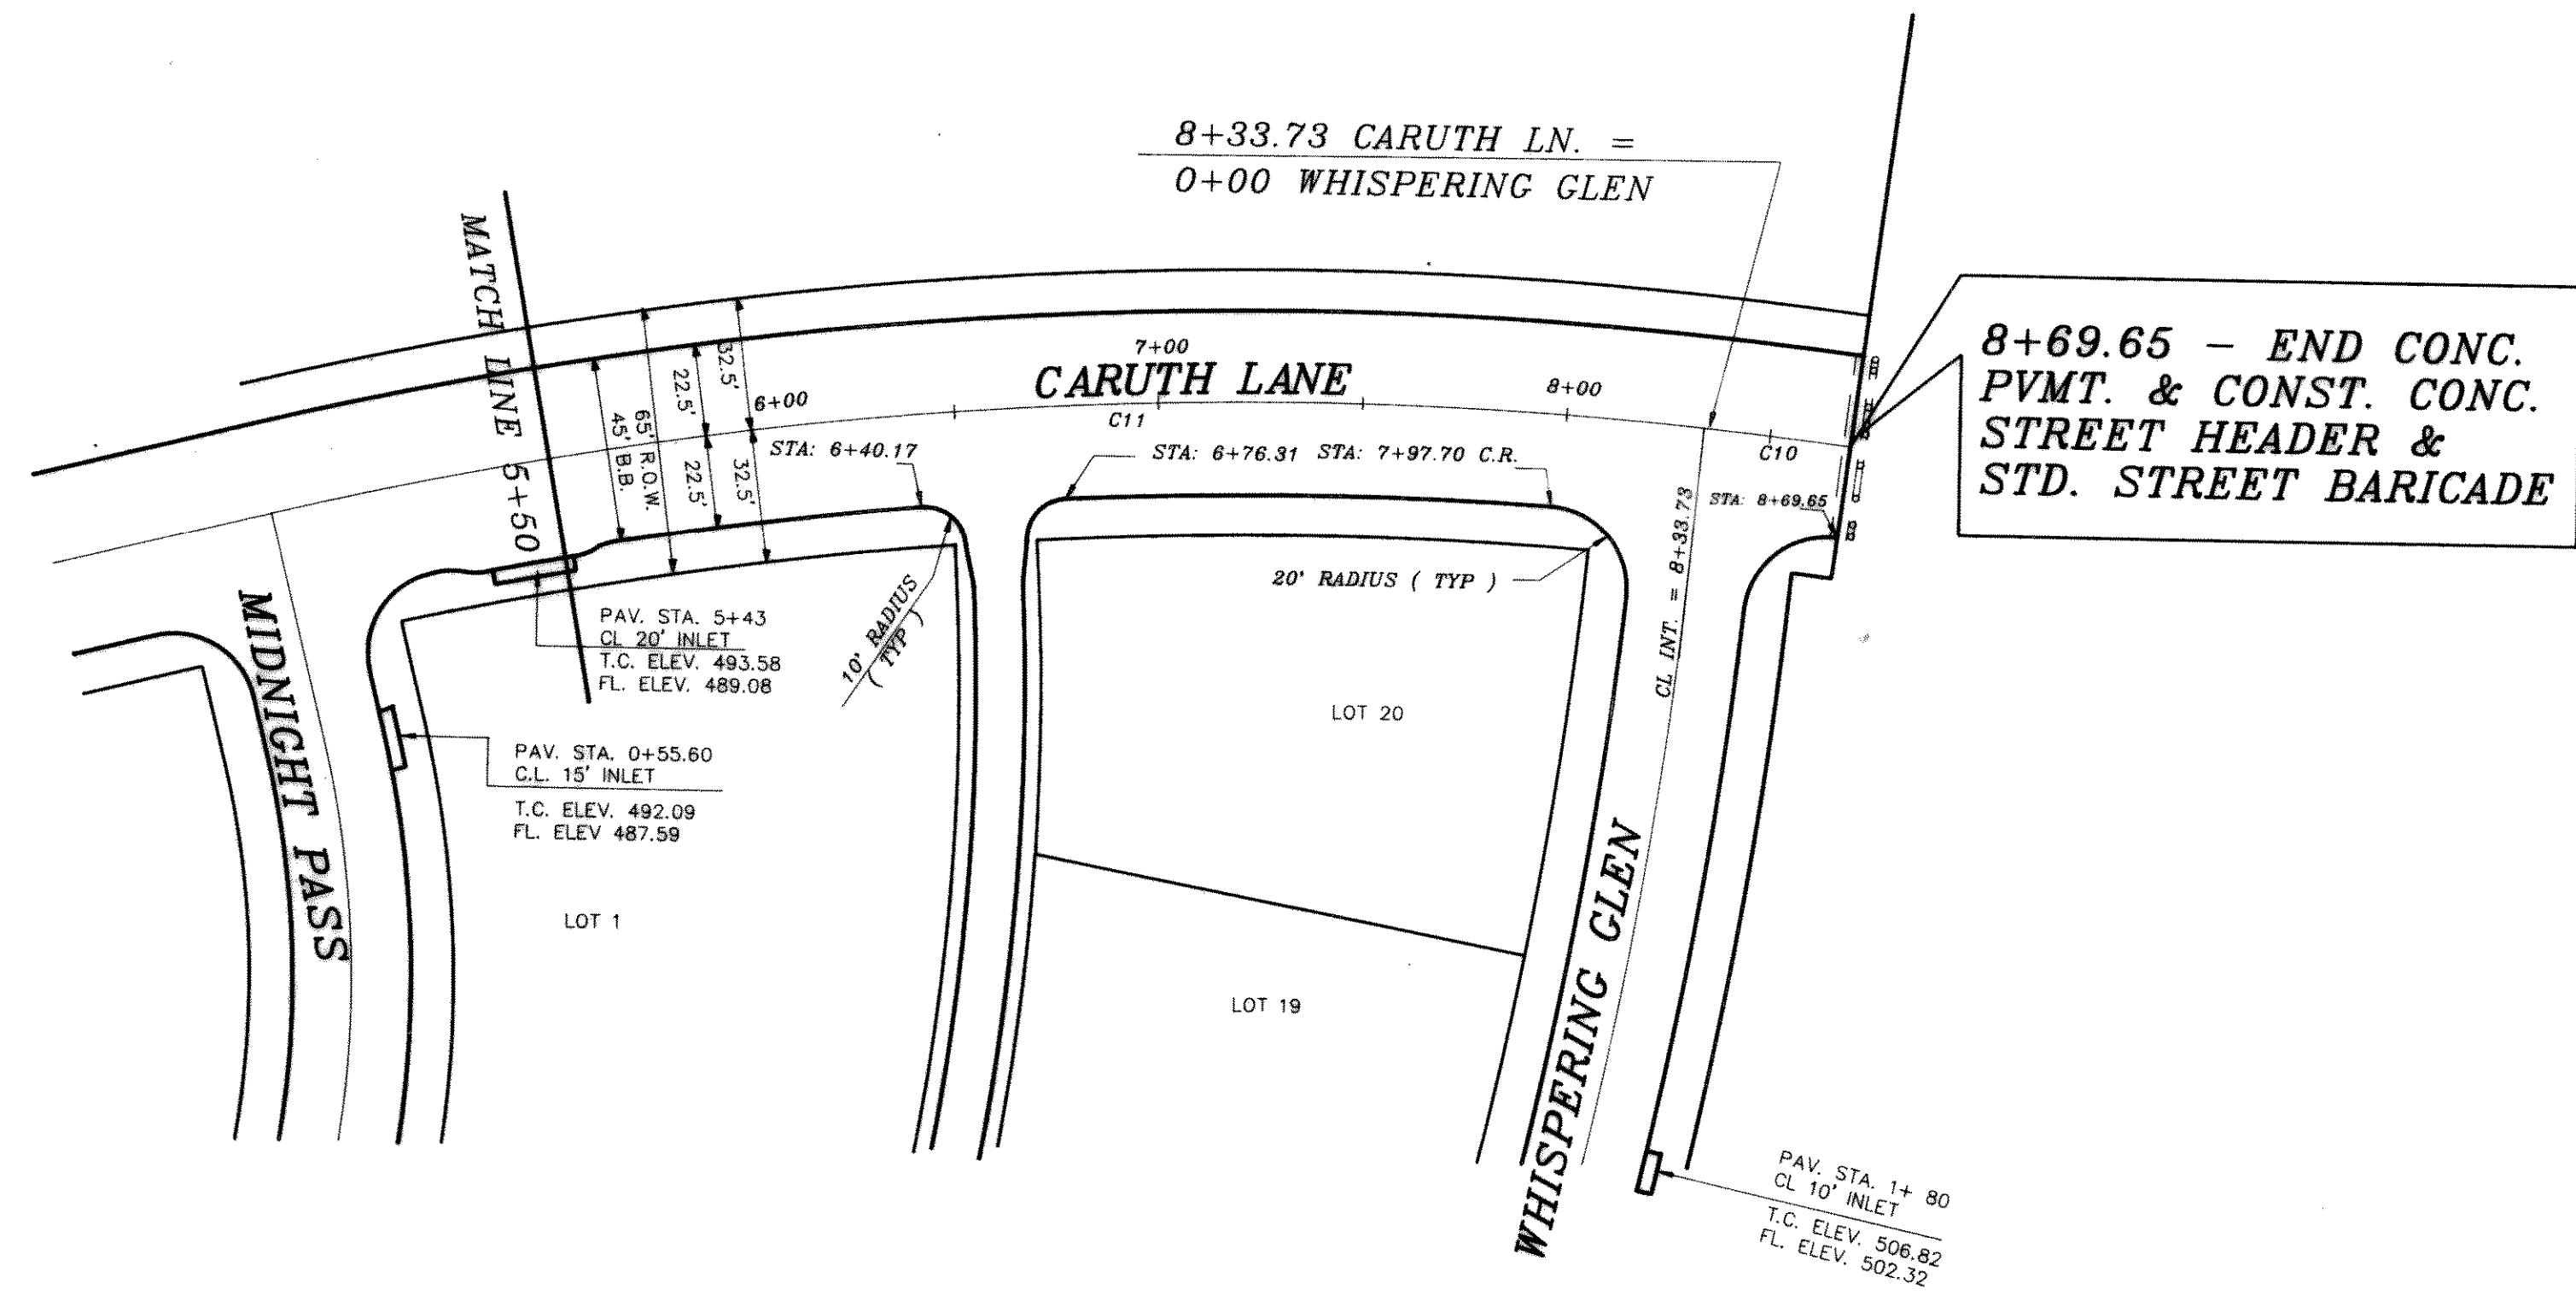

B.M.
SQUARE ON N. END OF HDW. ON EAST
SIDE OF ST. HWY. NO. 205, 170' +/-
SOUTH OF CENTERLINE OF CARUTH LANE.
ELEVATION = 482.40

B.M.
NORTHEAST TOP OF CURB AT NORTH END
OF FANNIN STREET, 545' +/- EAST OF
SOUTHEAST ADDITION CORNER.
ELEVATION = 518.18

AS BUILT

REVISION DESCRIPTION		DATE	SCALE	DESIGN	DRAWN
		3/22/94	1" = 40' HOR. 1" = 6' VERT.	H.L.E.	K.B.R.
HAROLD L. EVANS CONSULTING ENGINEER P.O. BOX 28355 2331 GUS THOMASSON ROAD, SUITE 102 DALLAS, TEXAS 75228, (214) 328-8133					
PAVING PLAN CARUTH LAKE PHASE ONE CARUTH LANE CITY OF ROCKWALL					
SHEET NO. 4					11
JOB NO. 9322					