


CURVE	RADIUS	LENGTH	TANGENT	CHORD	DELTA
C5	45.00'	24.31'	12.46'	24.02'	30°57'25"
C6	45.00'	101.67'	95.31'	81.38'	122°26'59"
C7	569.56'	298.34'	104.24'	205.28'	20°09'13"
C8	1304.00'	386.90'	194.88'	385.49'	17°00'00"

B.M.
 SQUARE ON N. END OF HOWL ON . EAST
 SIDE OF ST. HWY. NO. 205, 170' ±
 SOUTH OF CENTERLINE OF CARUTH LANE.
 ELEVATION = 482.40

B.M.
 NORTHEAST TOP OF CURB AT NORTH END
 OF FANNIN STREET, 545' ± EAST OF
 SOUTHEAST ADDITION CORNER.
 ELEVATION = 518.18

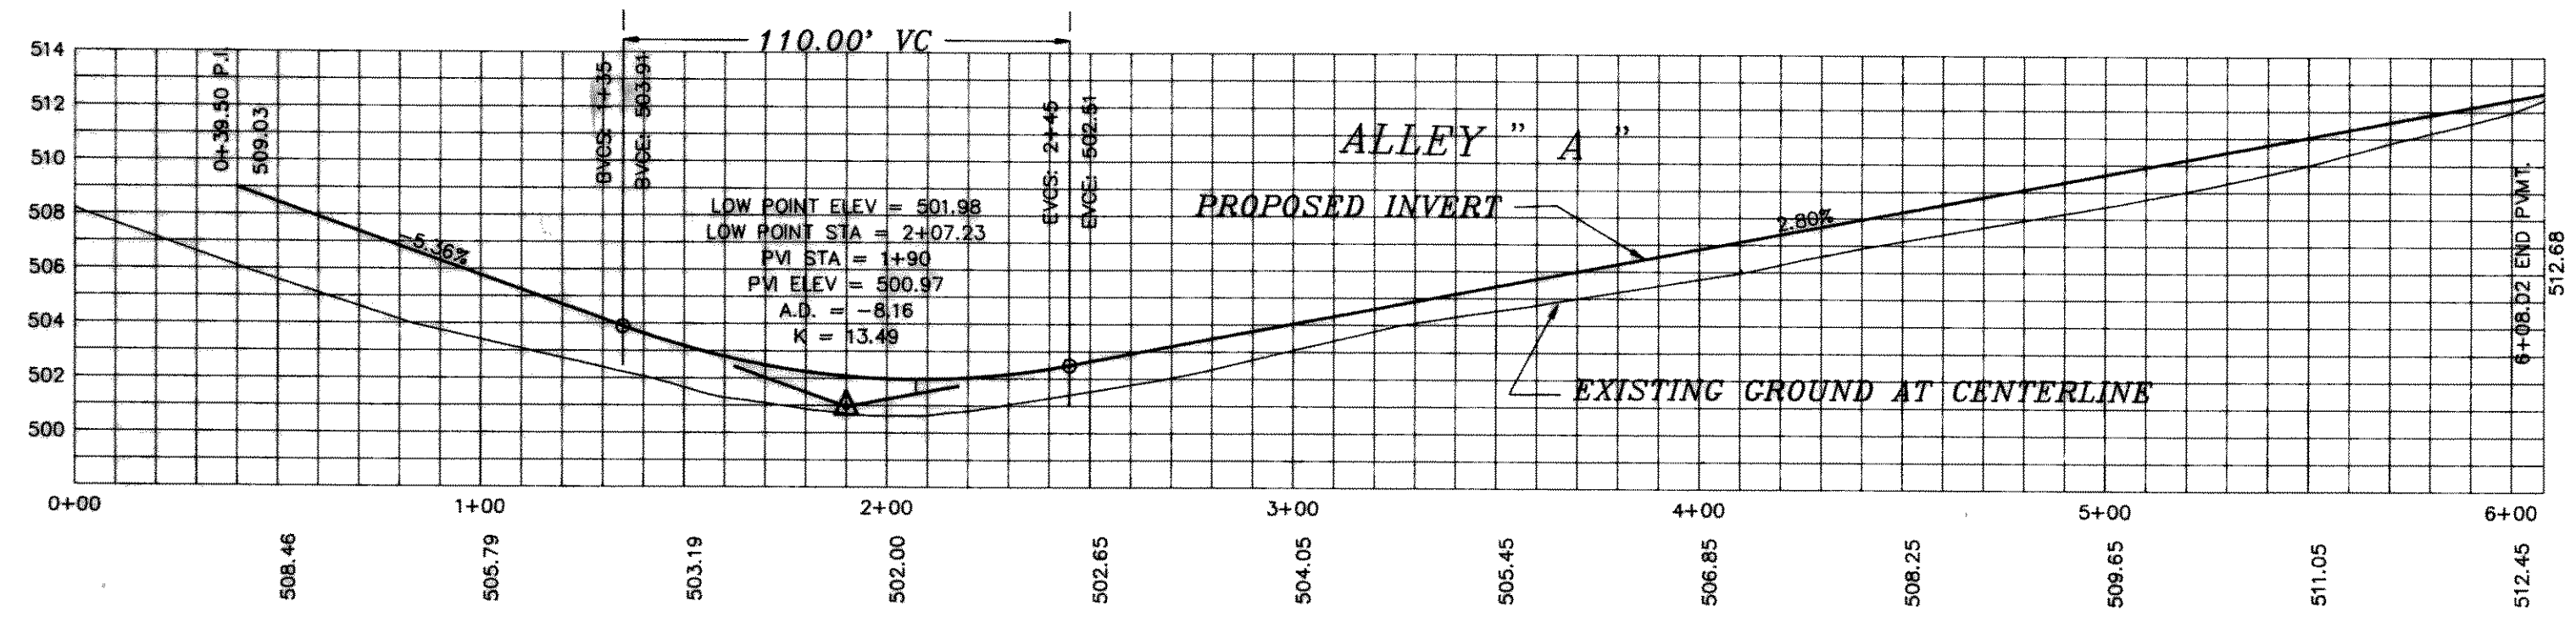

AS BUILT

HAROLD L. EVANS CONSULTING ENGINEER P.O. BOX 28956 2331 GUS THOMASSON ROAD, SUITE 102 DALLAS, TEXAS 75228. (214) 328-8133		SHEET NO. 7 11	
PAVING PLANS CARUTH LAKE PHASE ONE ALLEYS CITY OF ROCKWALL		JOB NO. 9322	
REVISION DESCRIPTION	DATE 3/22/94	SCALE 1" = 40' HOR. 1" = 6' VERT.	DESIGN H.L.E.
		DRAWN K.E.B.	