


CARUTH LAKE PHASE TWO

CITY OF ROCKWALL, ROCKWALL COUNTY, TEXAS

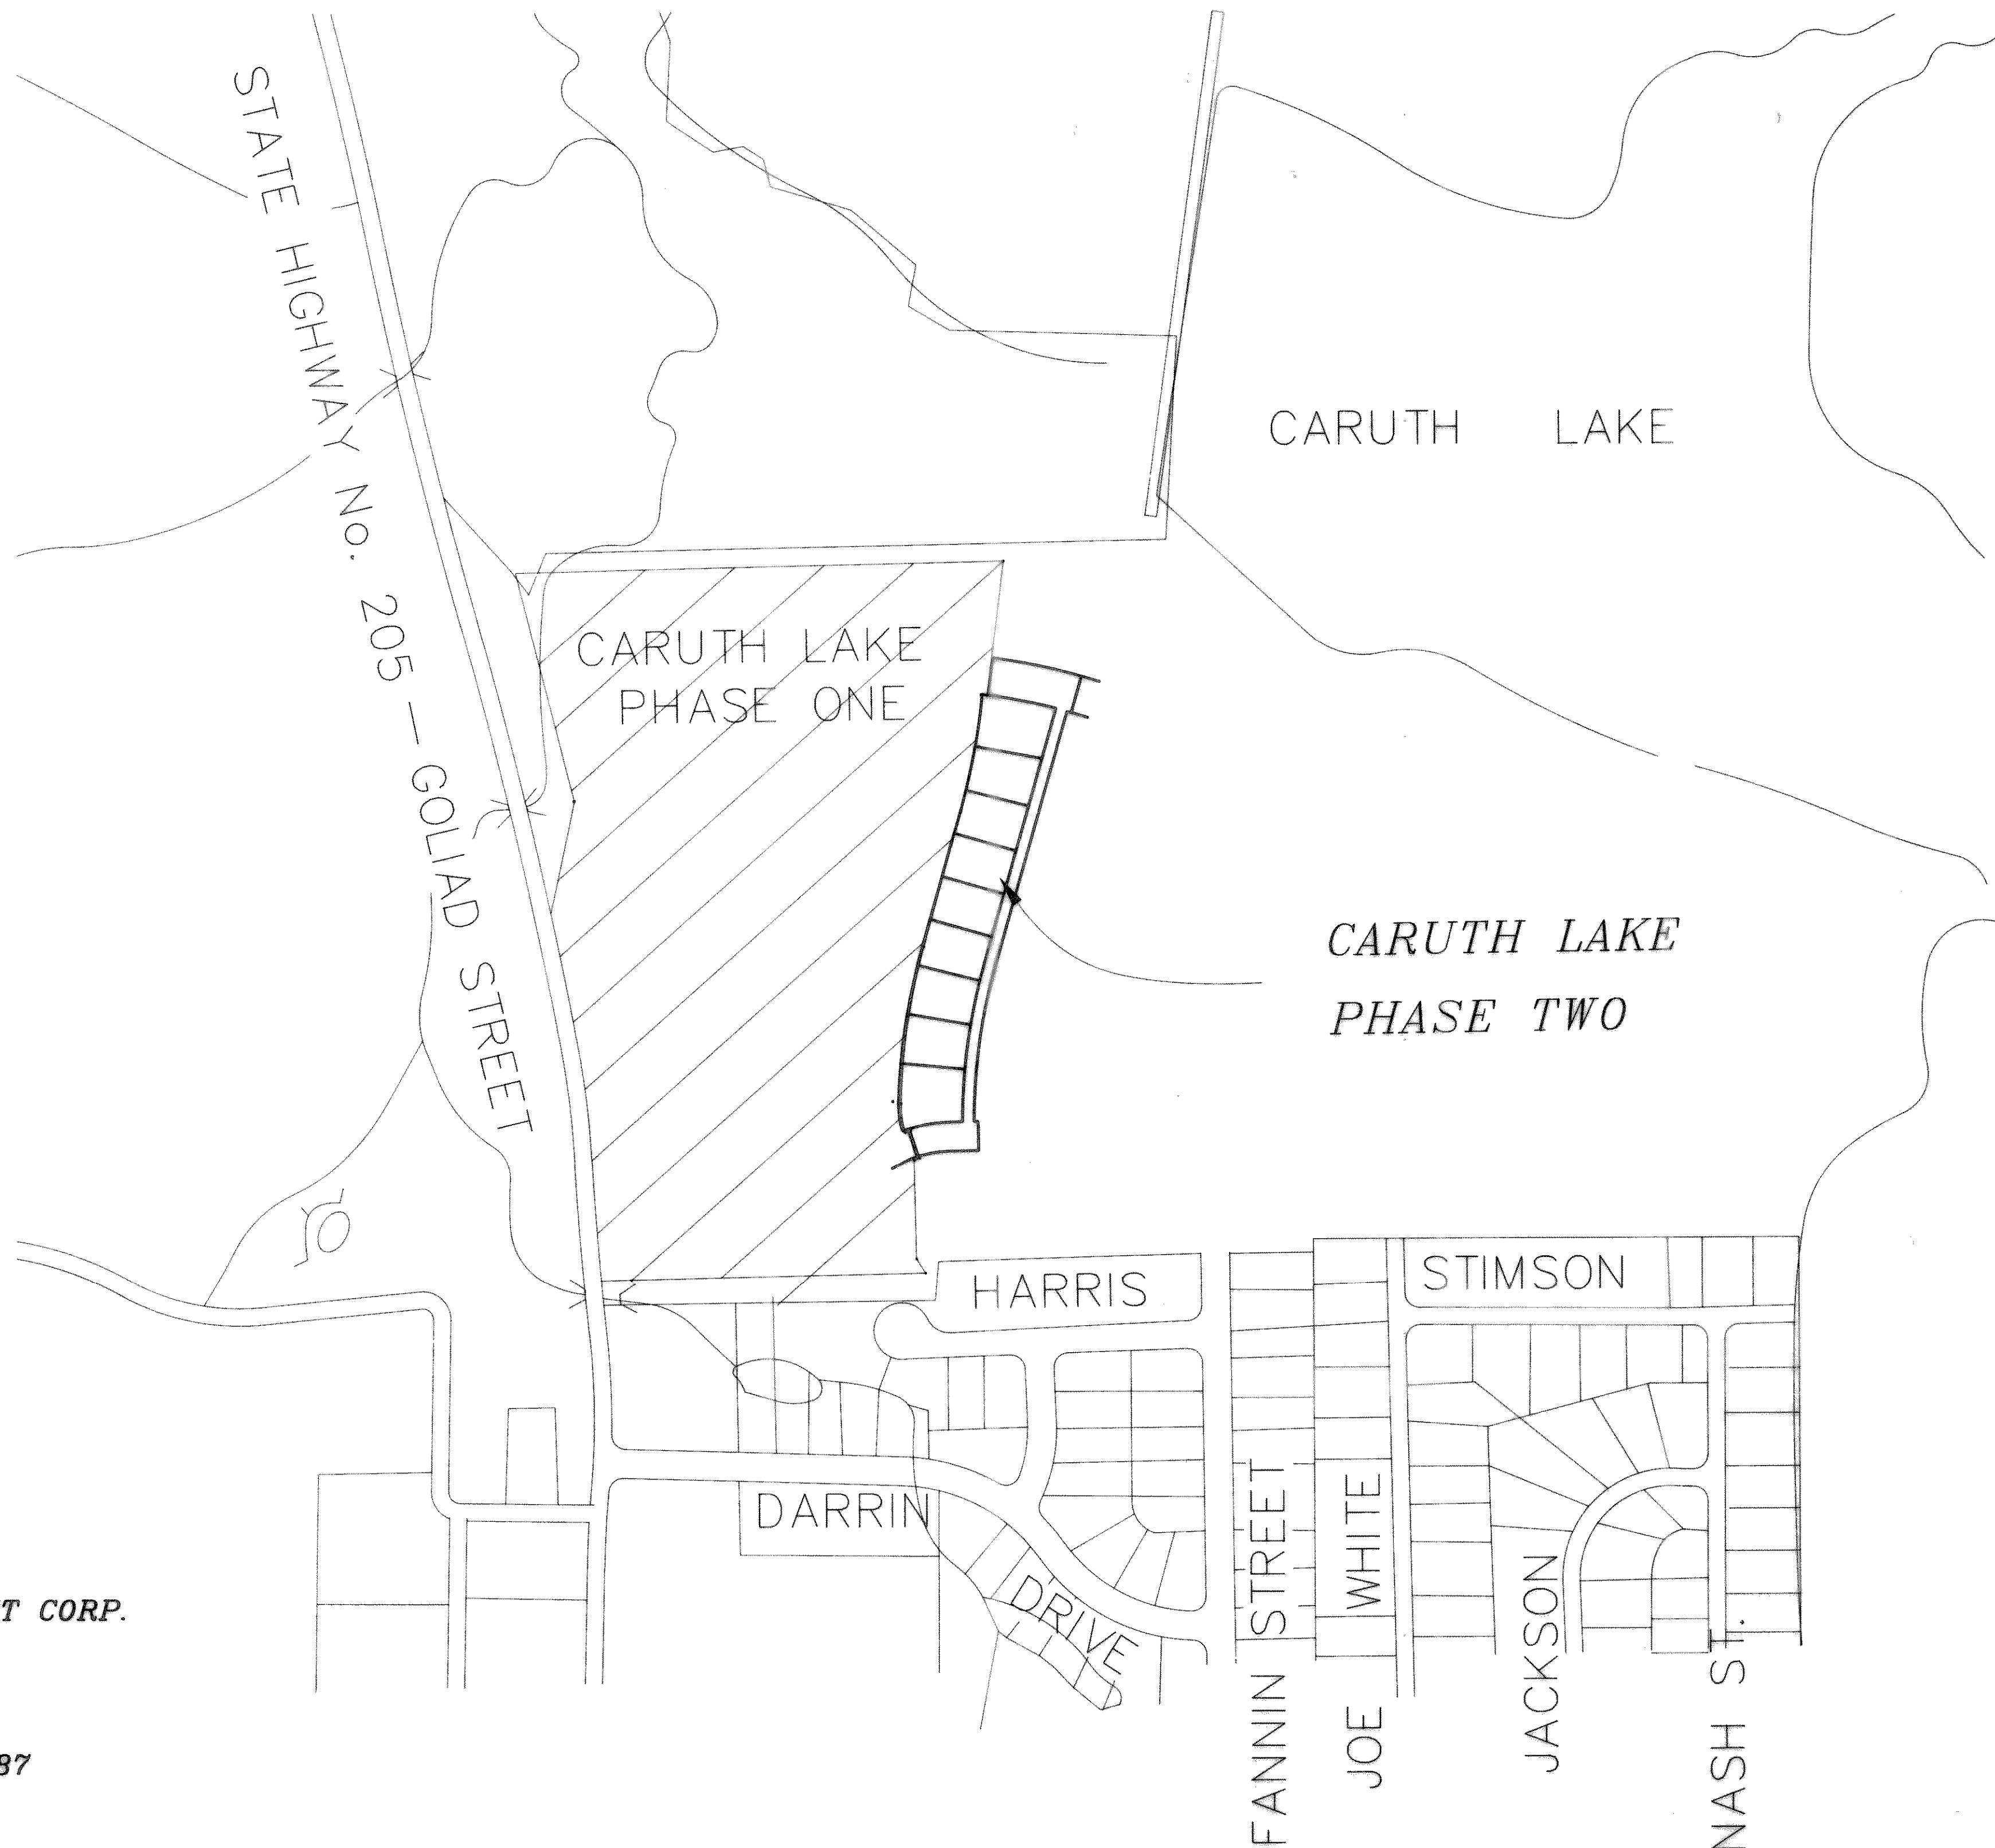


GENERAL NOTES

1. EXCAVATED MATERIAL SHALL BE PLACED AS DIRECTED BY THE OWNER.
2. ALL FILL AREAS IN STREET RIGHT - OF - WAYS TO BE DENSITY CONTROLLED AND COMPACTED TO 95% DENSITY AT OPTIMUM MOISTURE CONTENT.
3. NO TREES SHALL BE CUT EXCEPT ON THE SPECIFIC AUTHORITY OF THE ENGINEER.
4. CONSTRUCTION SHALL MEET THE REQUIREMENTS OF THE LATEST REVISION OF THE "STANDARD SPECIFICATIONS FOR CONSTRUCTION", CITY OF ROCKWALL.
5. PAVEMENT THICKNESS SHALL BE AS FOLLOWS:
 RESIDENTIAL STREETS = 6" THICK, 3500 P.S.I. CONCRETE
 COLLECTOR STREET = 6" THICK, 3500 P.S.I. CONCRETE
 ARTERIAL STREETS = 8" THICK, 3500 P.S.I. CONCRETE
6. IT SHALL BE THE RESPONSIBILITY OF THE CONTRACTOR TO LOCATE AND VERIFY ALL EXISTING UTILITIES PRIOR TO THE BEGINNING OF CONSTRUCTION TO INSURE NO CONFLICT BETWEEN ALL UTILITY LINES.
7. WHERE WATER PIPELINES EITHER CROSS OR OTHERWISE COME WITHIN 9 FEET OF A SANITARY SEWER PIPELINE THE SEWER PIPELINE SHALL BE EITHER CAST IRON OR PVC PIPE WITH A MINIMUM WORKING PRESSURE CLASS OF 150 PSI.
8. ALL WATER SERVICES TO BE 1" INSTALLED TO THE CENTER OF EACH LOT WITH SEWER LATERALS 10' DOWNSTREAM. WATER SERVICES SHALL BE PE 200 PSI SDR 9 WITH METAL INSERTS.
9. CONDUITS FOR S. W. BELL AND BETA CABLE T.V. SHALL HAVE 30" OF COVER AND SHALL EXTEND 2 FEET BEYOND FUTURE PAVING.
10. ALL FITTINGS SHALL BE BRASS COMPRESSION.
11. RESILIENT SEATED GATE VALVES ONLY WILL BE ALLOWED.
12. BLUE MARKER E. M. S. #1252 SHALL BE PLACED UNDER EACH CORPORATION STOP
13. GREEN MARKER E. M. S. #1253 SHALL BE PLACED UNDER EACH SEWER SERVICE AND AT EACH MANHOLE AT A DEPTH NOT TO EXCEED 5 FEET.

T.U. ELECTRIC COMPANY GENERAL NOTES

1. CONTRACTOR TO INSTALL ALL CONDUIT AS SHOWN ON PRINT.
2. T.U. ELECTRIC COMPANY TO FURNISH CONDUIT AND CABLE MARKERS.
3. DEVELOPER TO INSTALL 1 (ONE) CABLE MARKER AT EACH END OF CONDUIT.
4. EACH CONDUIT MUST BE BURIED A MINIMUM OF 40" DEEP (AFTER LAND IS BROUGHT TO FINAL GRADE AND EXTEND 2 FEET BEYOND FUTURE PAVING) .
5. EACH CONDUIT MUST BE INSPECTED BY THE DISTRIBUTION DEPARTMENT BEFORE BACKFILLING IN TRENCH. ROBERT GAYLOR 487-2351.
6. EACH CONDUIT MUST HAVE A PULL WIRE INSTALLED AND BE CAPPED AT BOTH ENDS.

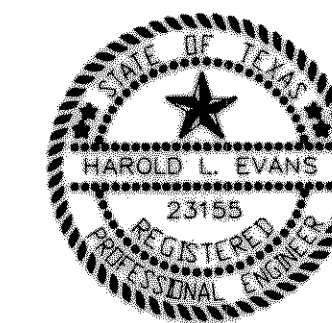

HAROLD L. EVANS, CONSULTING ENGINEER

P.O. BOX 28355

DALLAS, TEXAS 75228

(214) 328-8133

OWNER :

CARUTH LAKE DEVELOPEMENT CORP.

P.O. BOX 369

ROCKWALL, TEXAS 75087

(214) 771-5238