


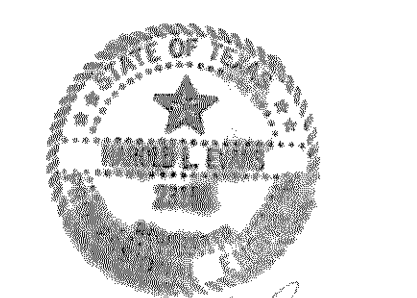

B.M.
 SQUARE ON N. END OF HDW. ON E. EAST
 SIDE OF ST. HWY. NO. 205, 170' +-
 SOUTH OF CENTERLINE OF CARUTH LANE.
 ELEVATION = 482.40

B.M.
 NORTHEAST TOP OF CURB AT NORTH END
 OF FANNIN STREET, 545' +- EAST OF
 SOUTHEAST ADDITION CORNER.
 ELEVATION = 518.18


 Harold L. Evans
 11-8-94

HAROLD L. EVANS CONSULTING ENGINEER P.O. BOX 28355 2331 GUS THOMASSON ROAD, SUITE 102 DALLAS, TEXAS 75228. (214) 328-8133				SHEET NO. 7	
				JOB NO. 9322	
REVISION DESCRIPTION		DATE 7/8/94	SCALE 1" = 40'	DESIGN H.L.E.	DRAWN K.E.B.
GRADING PLAN BLOCK C CARUTH LAKE PHASE TWO CITY OF ROCKWALL					