

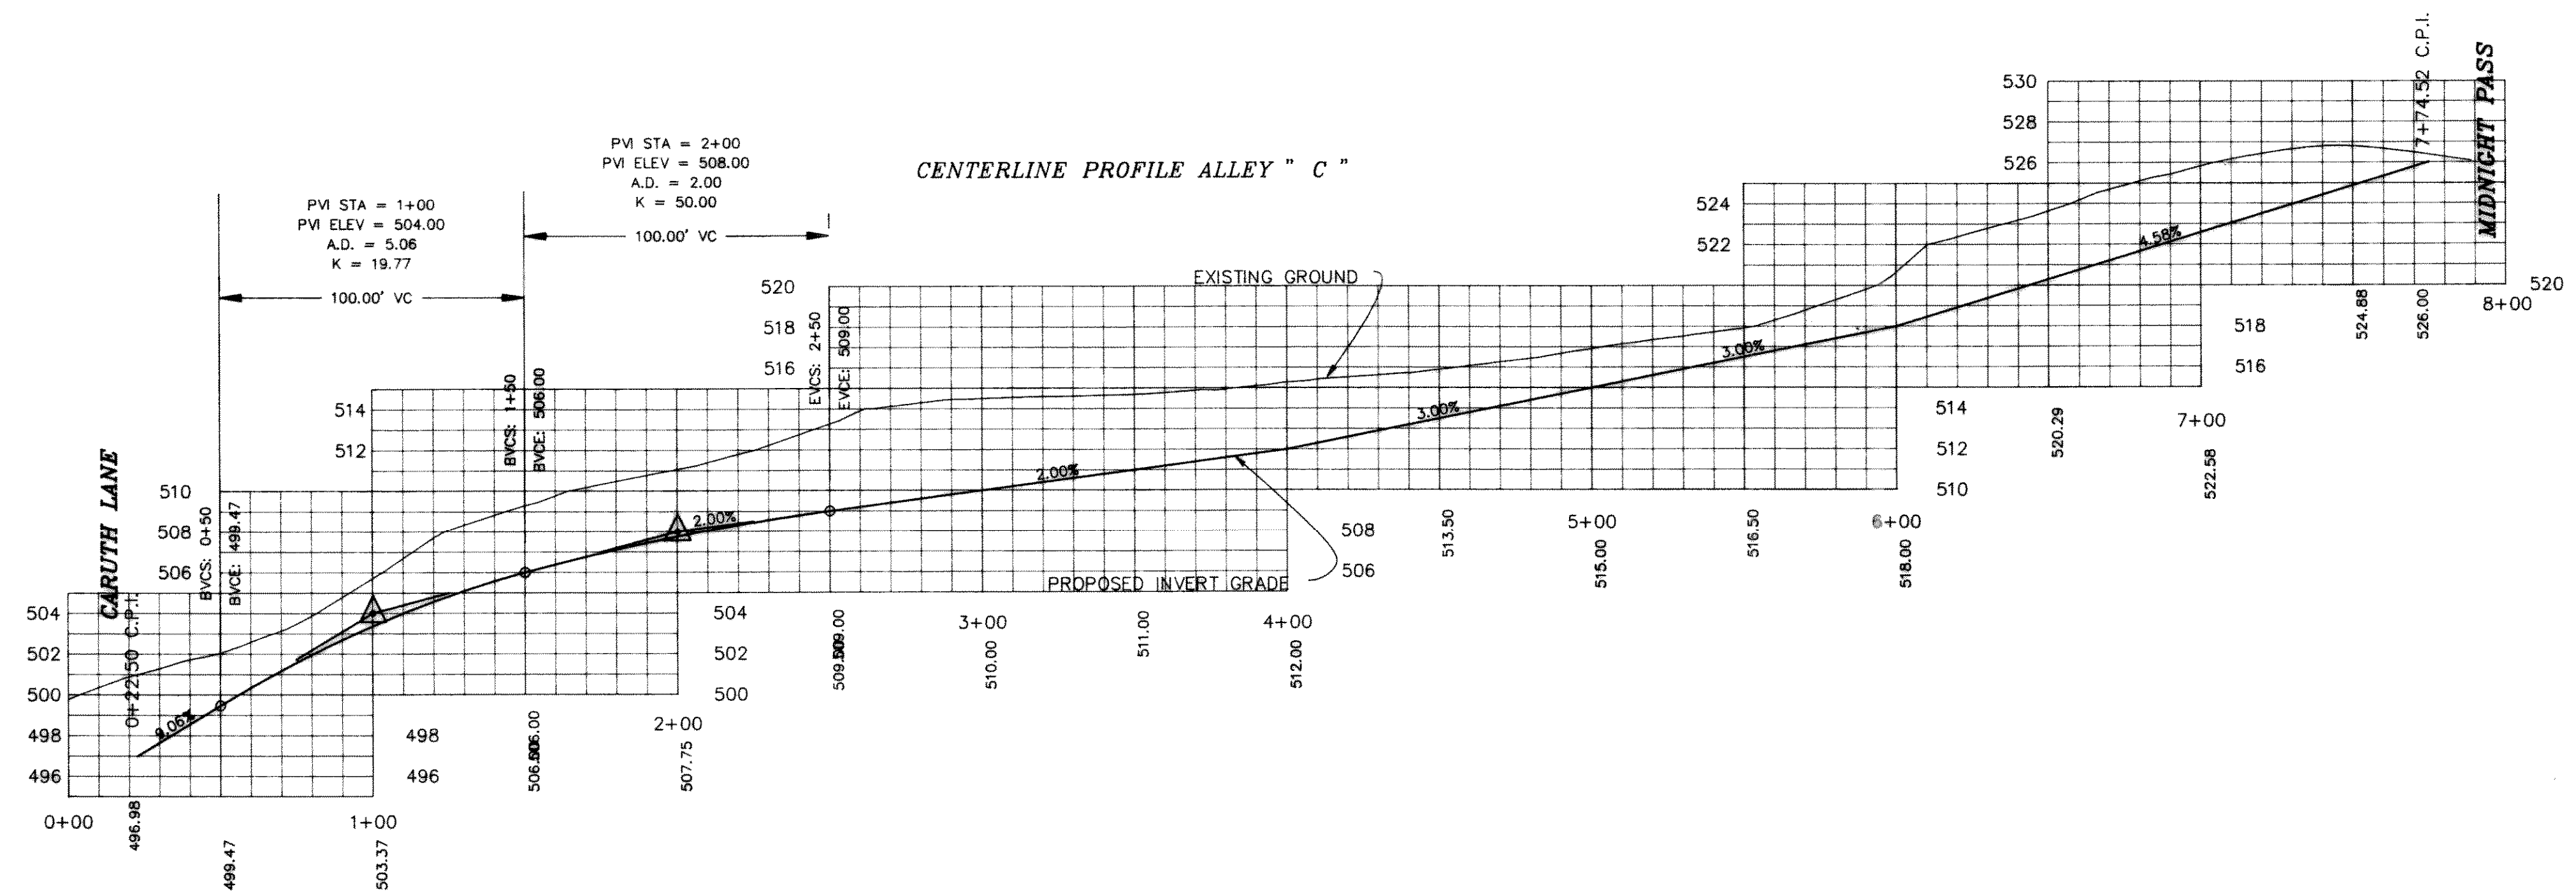


CURVE	RADIUS	LENGTH	TANGENT	CHORD	BEARING	DELTA
C3	1011.99'	304.08'	153.19'	302.93'	S82°47'46" E	17°12'57"

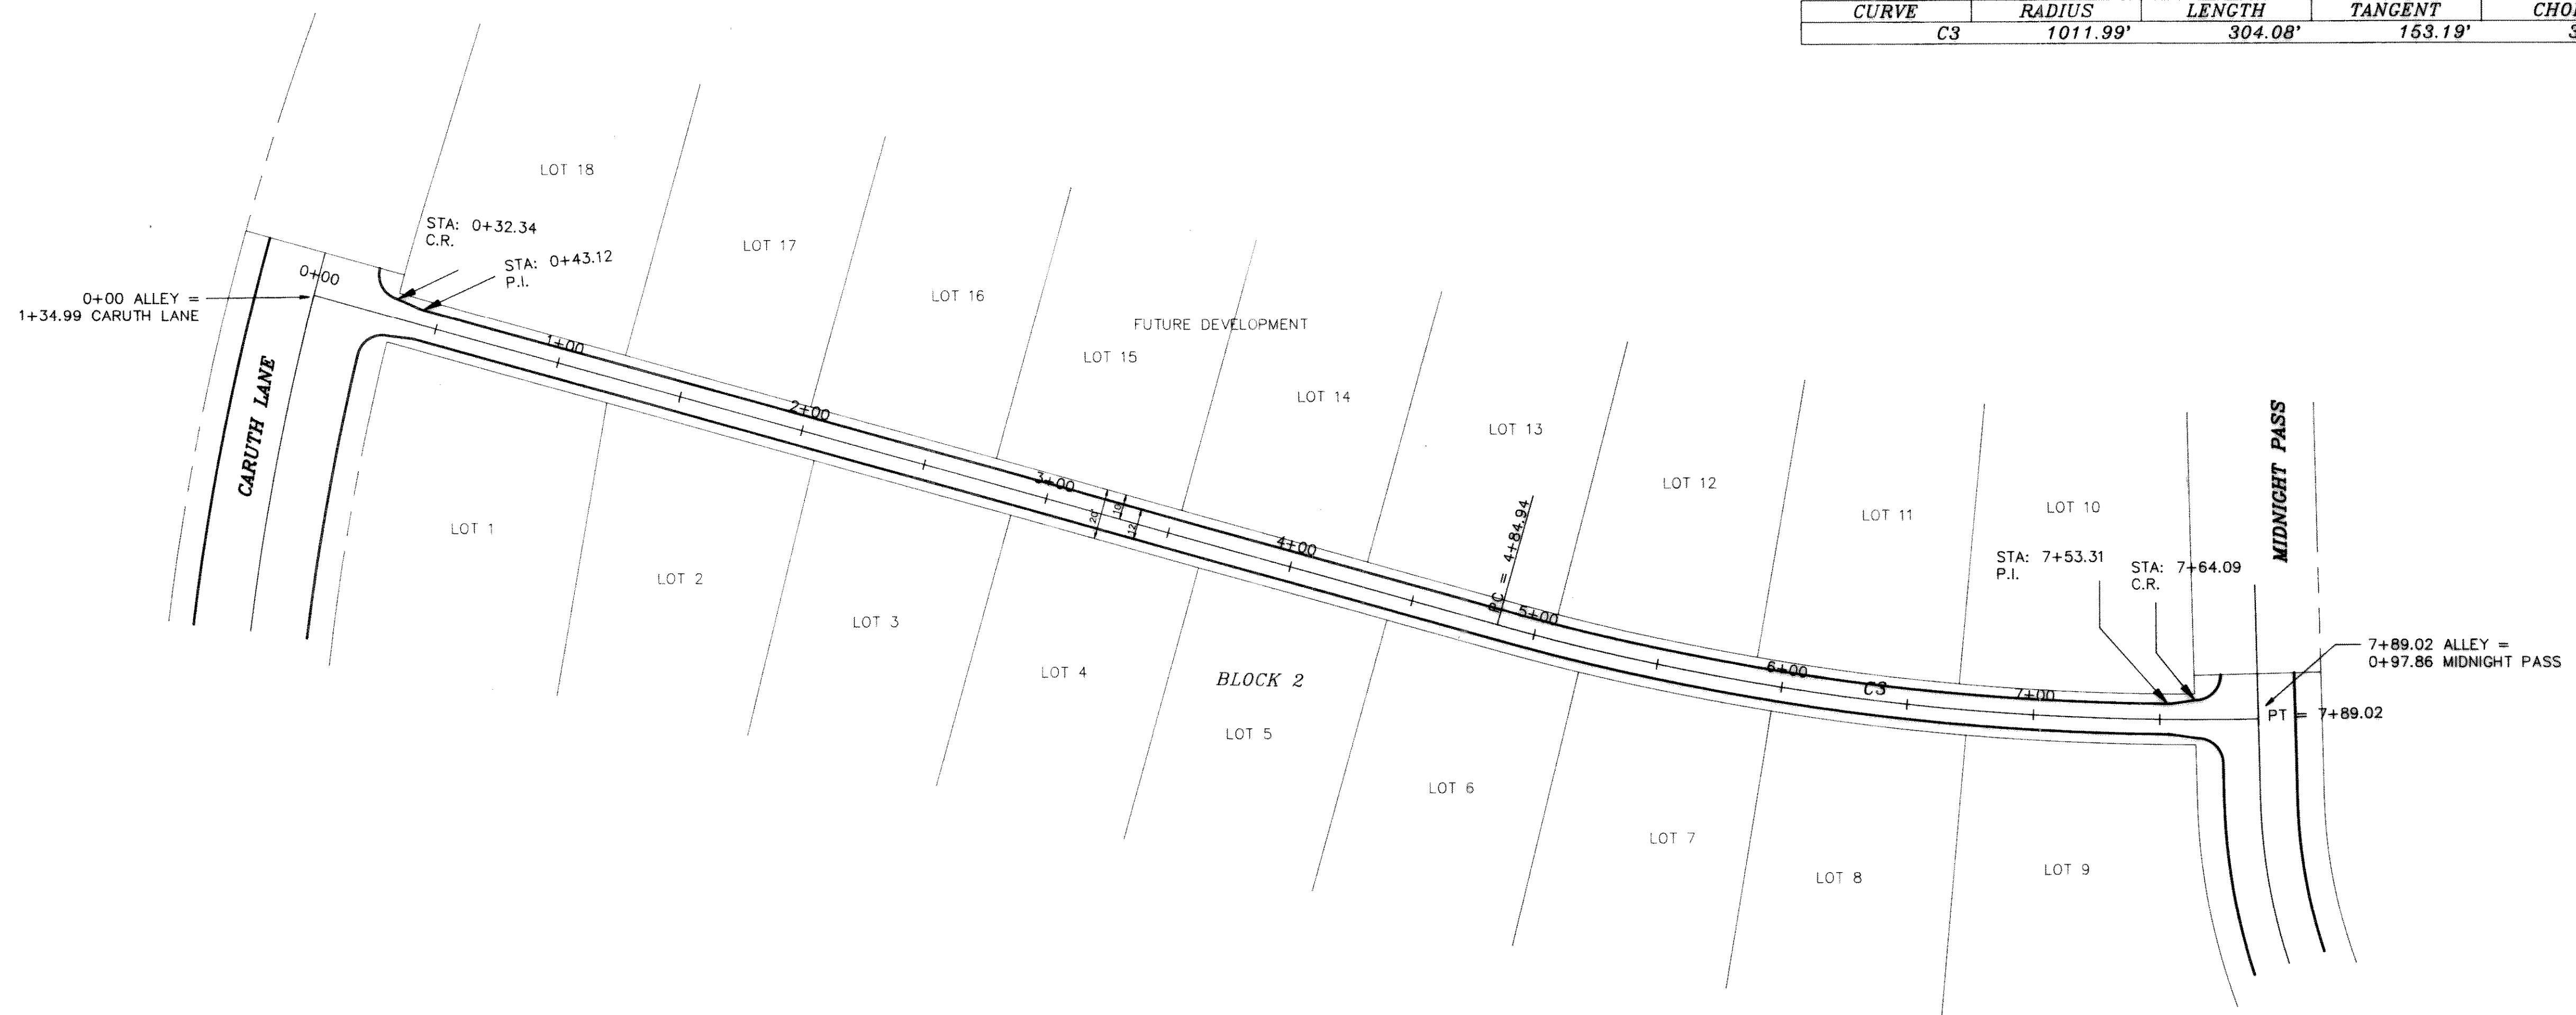

B.M.
 SQUARE ON N. END OF HDWL ON E. SIDE OF ST. HWY. NO. 205, 170' ± SOUTH OF CENTERLINE OF CARUTH LANE.
 ELEVATION = 482.40

B.M.
 NORTHEAST TOP OF CURB AT NORTH END OF FANNIN STREET, 545' ± EAST OF SOUTHEAST ADDITION CORNER.
 ELEVATION = 518.18

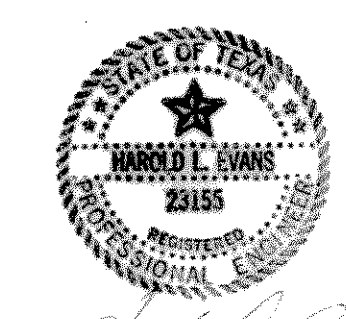

Handwritten signature and date: 11-8-84

REVISION DESCRIPTION _____ _____ _____		DATE 7/8/84	SCALE 1" = 40' 1" = 8'	DESIGN H.L.E.	DRAWN K.E.B.	HAROLD L. EVANS CONSULTING ENGINEER P.O. BOX 28355 2331 GUS THOMASSON ROAD, SUITE 102 DALLAS, TEXAS 75228. (214) 328-8133	SHEET NO. 4 / 7	PAVING PLAN ALLEY C CARUTH LAKE PHASE TWO CITY OF ROCKWALL	JOB NO. 9322
---	--	----------------	------------------------------	------------------	-----------------	---	--------------------	---	-----------------