
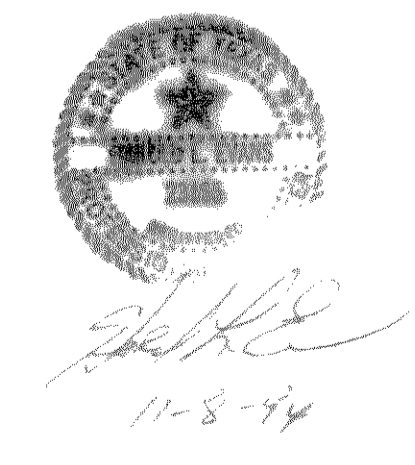
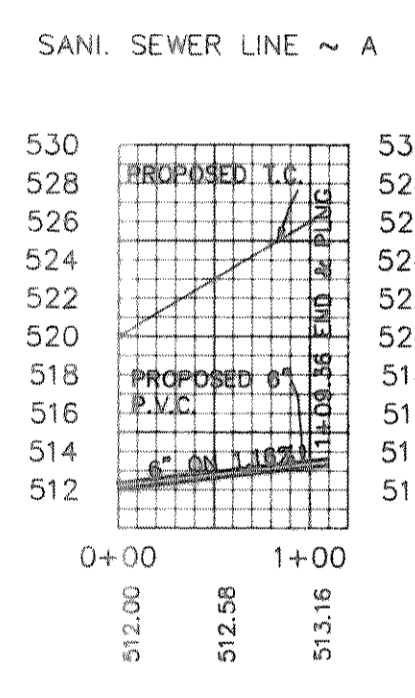
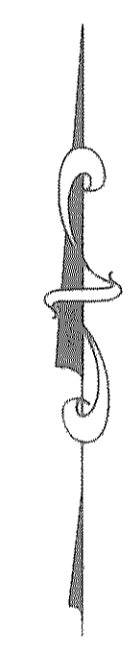
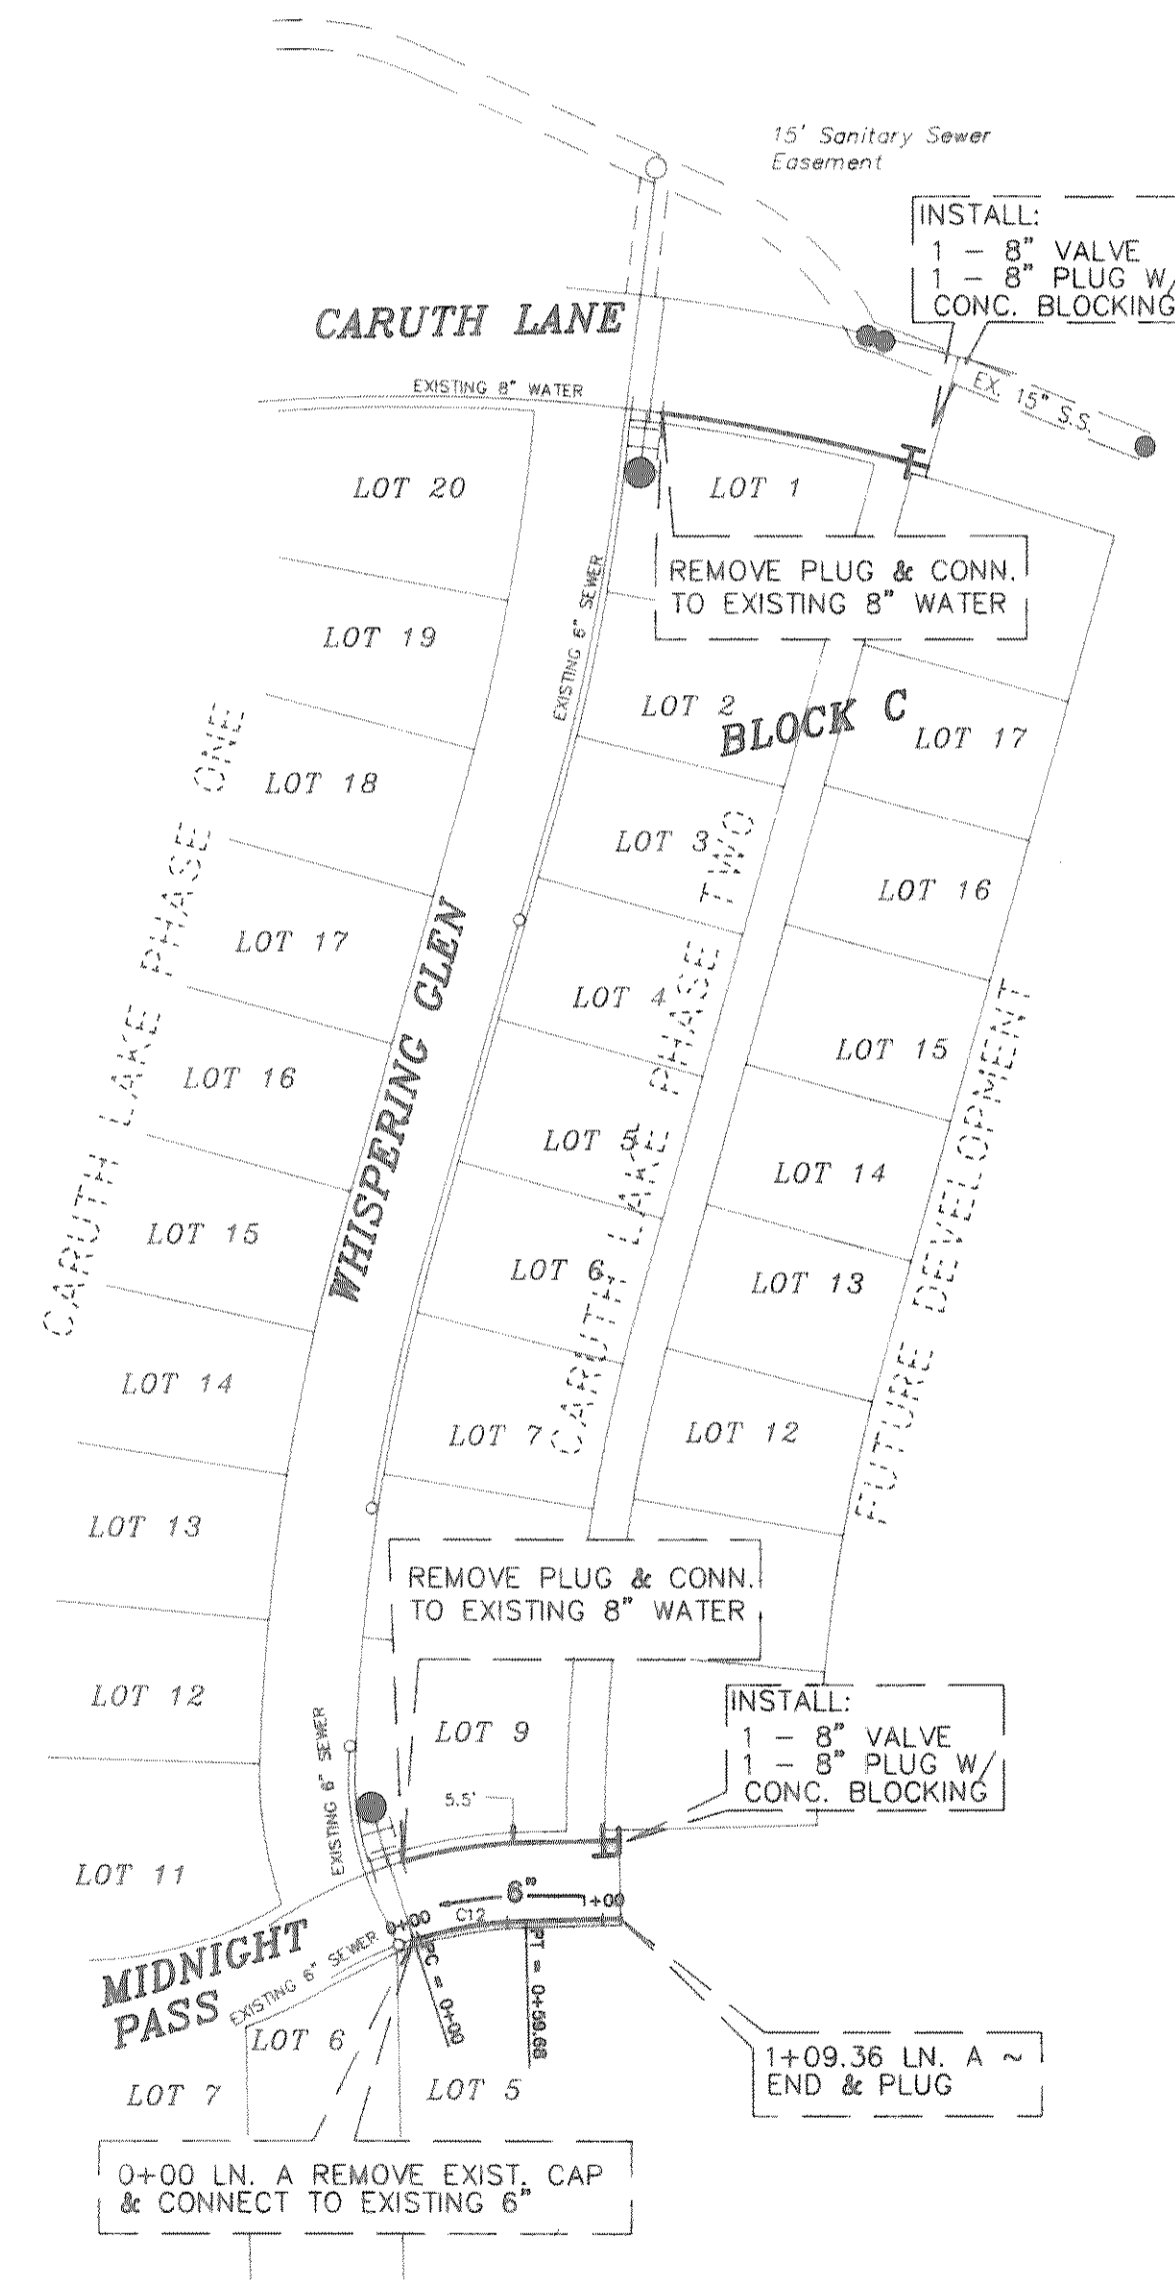


CURVE	RADIUS	LENGTH	TANGENT	CHORD	BEARING	DELTA
C12	203.50'	59.68'	30.06'	59.47'	S80°11'52"W	16°48'15"

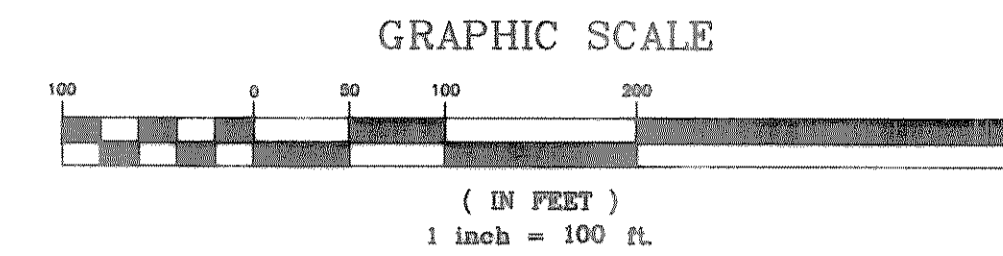

B.M.
 SQUARE ON N. END OF HDWL ON E. EAST
 SIDE OF ST. HWY. NO. 205, 170' ±
 SOUTH OF CENTERLINE OF CARUTH LANE.
 ELEVATION = 482.40

B.M.
 NORTHEAST TOP OF CURB AT NORTH END
 OF FANNIN STREET, 545' ± - EAST OF
 SOUTHEAST ADDITION CORNER.
 ELEVATION = 518.18

REVISION DESCRIPTION	DATE	SCALE	DESIGN	DRAWN	SHEET NO. 5 7
	11/2/94	1" = 100' 1" = 6'	H.L.E.	K.E.B.	
HAROLD L. EVANS CONSULTING ENGINEER P.O. BOX 28365 2331 GUS THOMASSON ROAD, SUITE 102 DALLAS, TEXAS 75228, (214) 328-8133				WATER & SEWER PLAN LINE ~ A CARUTH LAKE PHASE TWO CITY OF ROCKWALL	
JOB NO. 9322					