

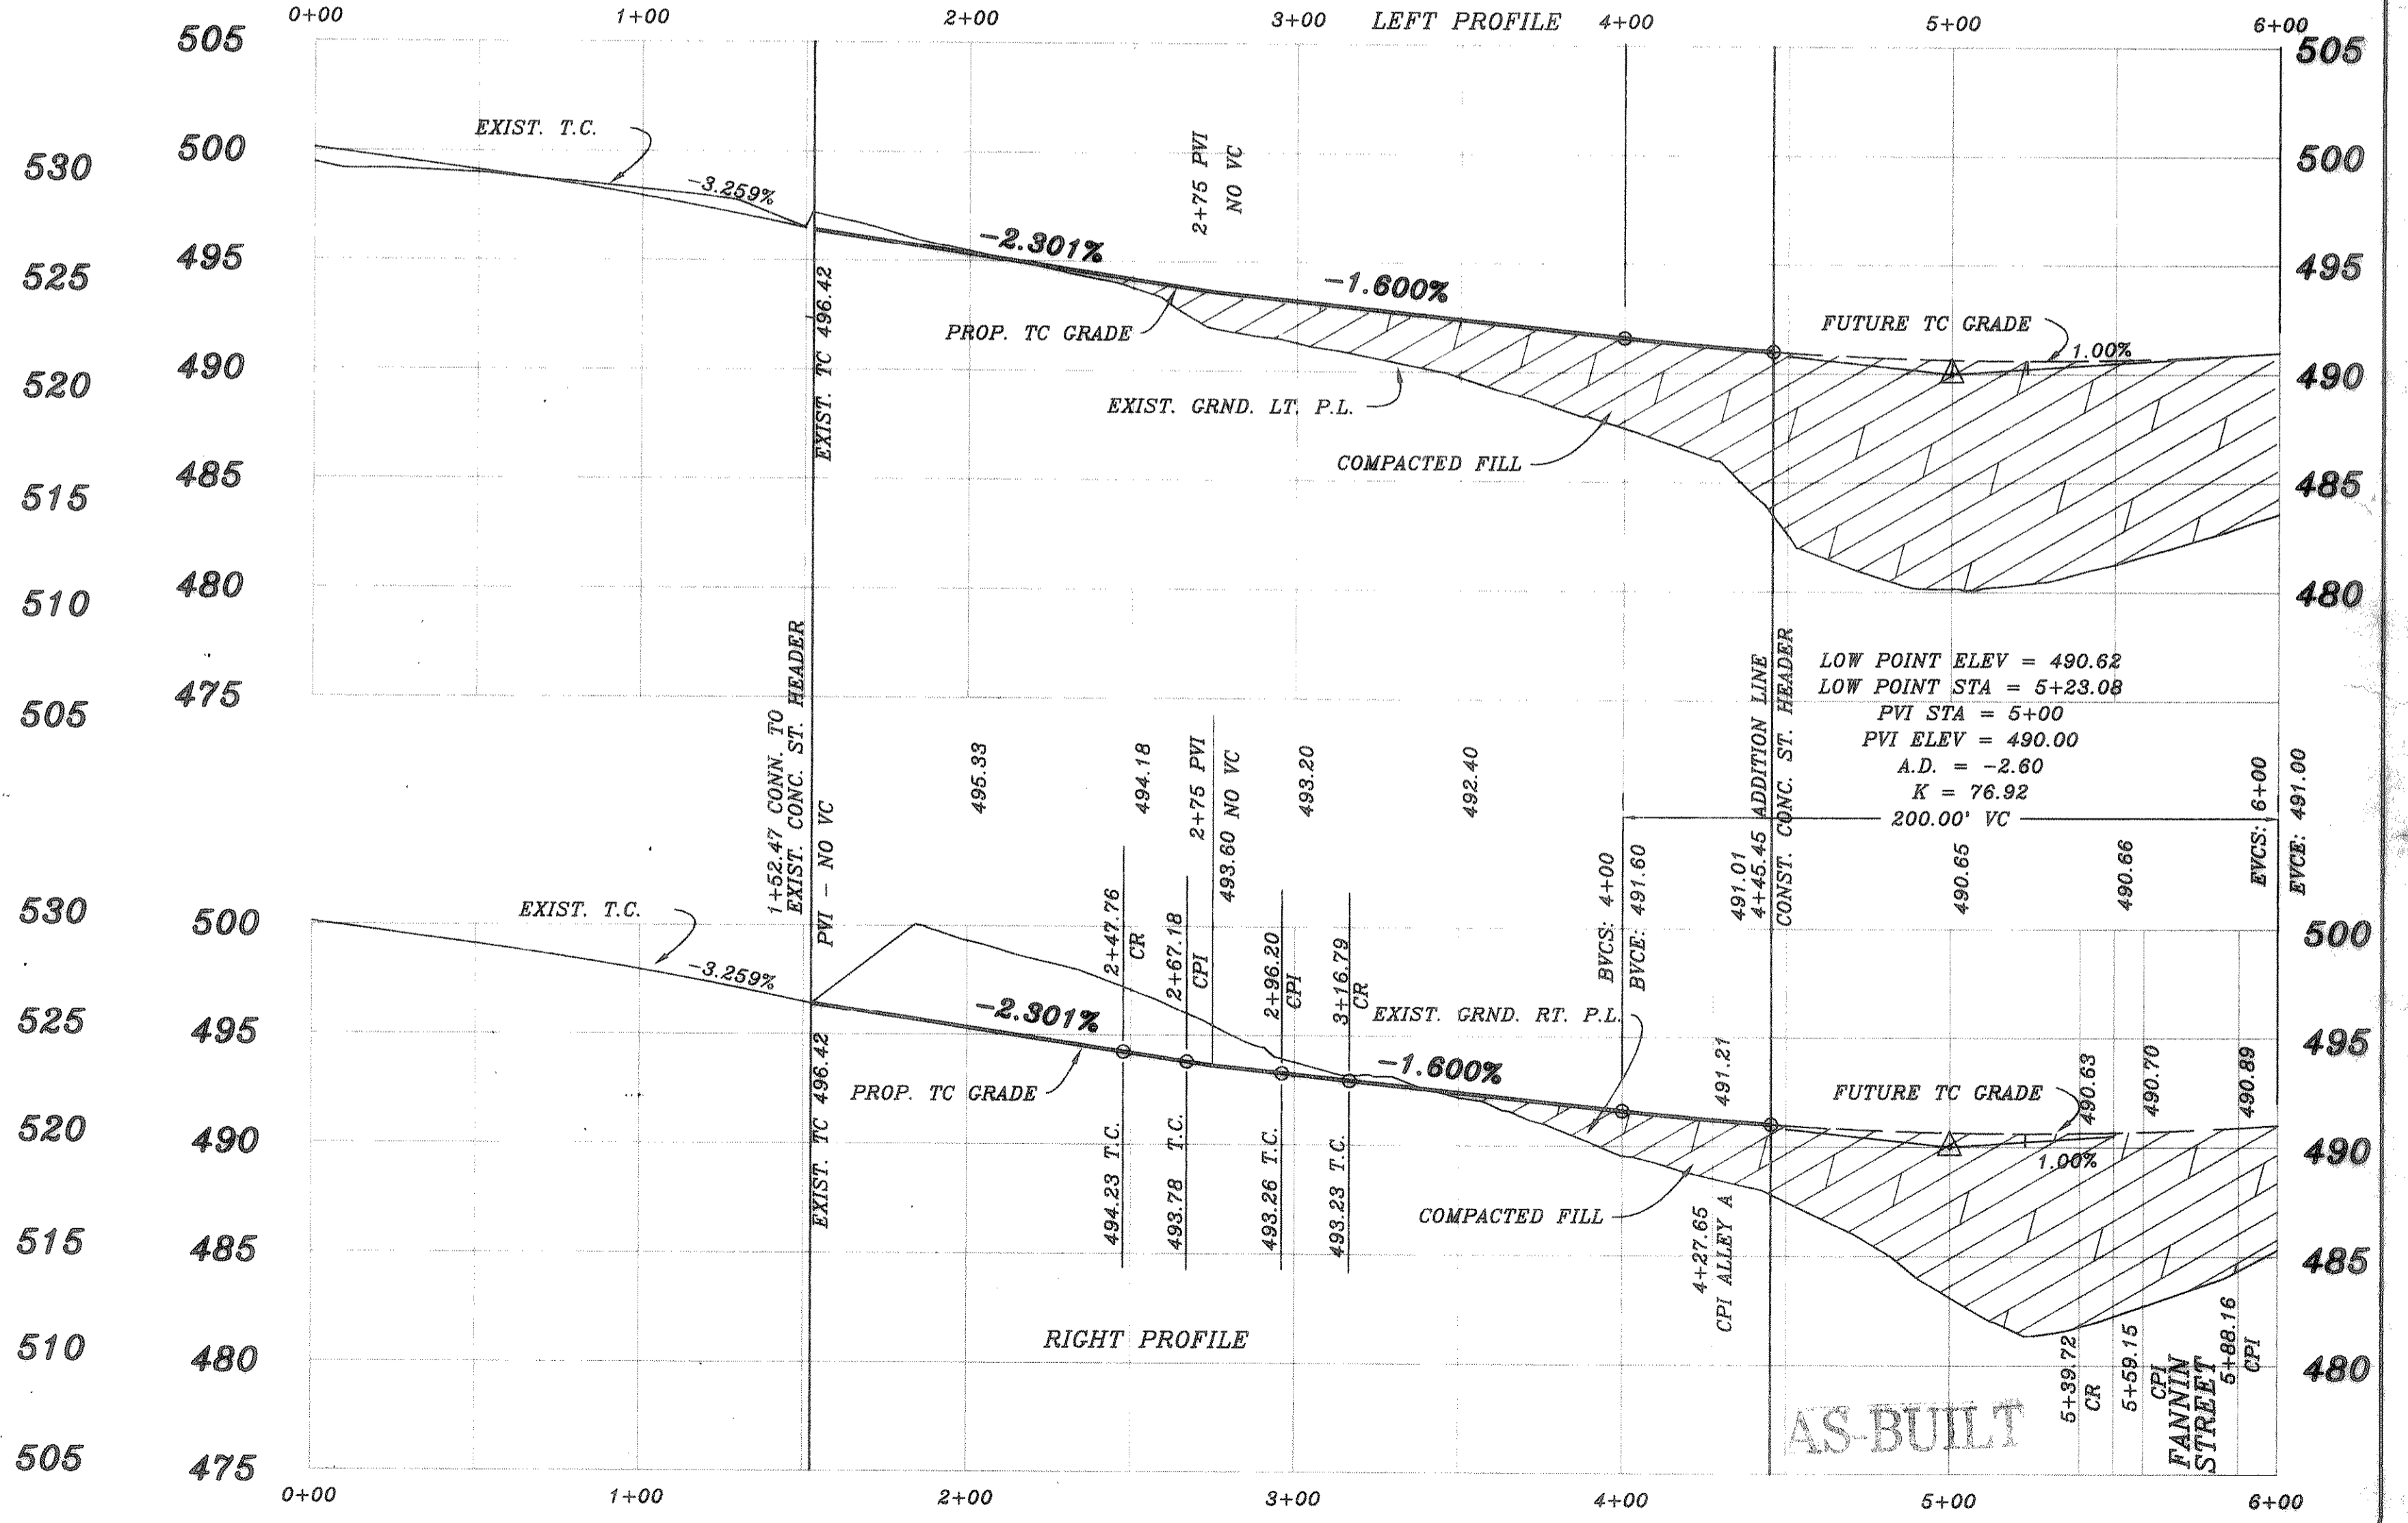
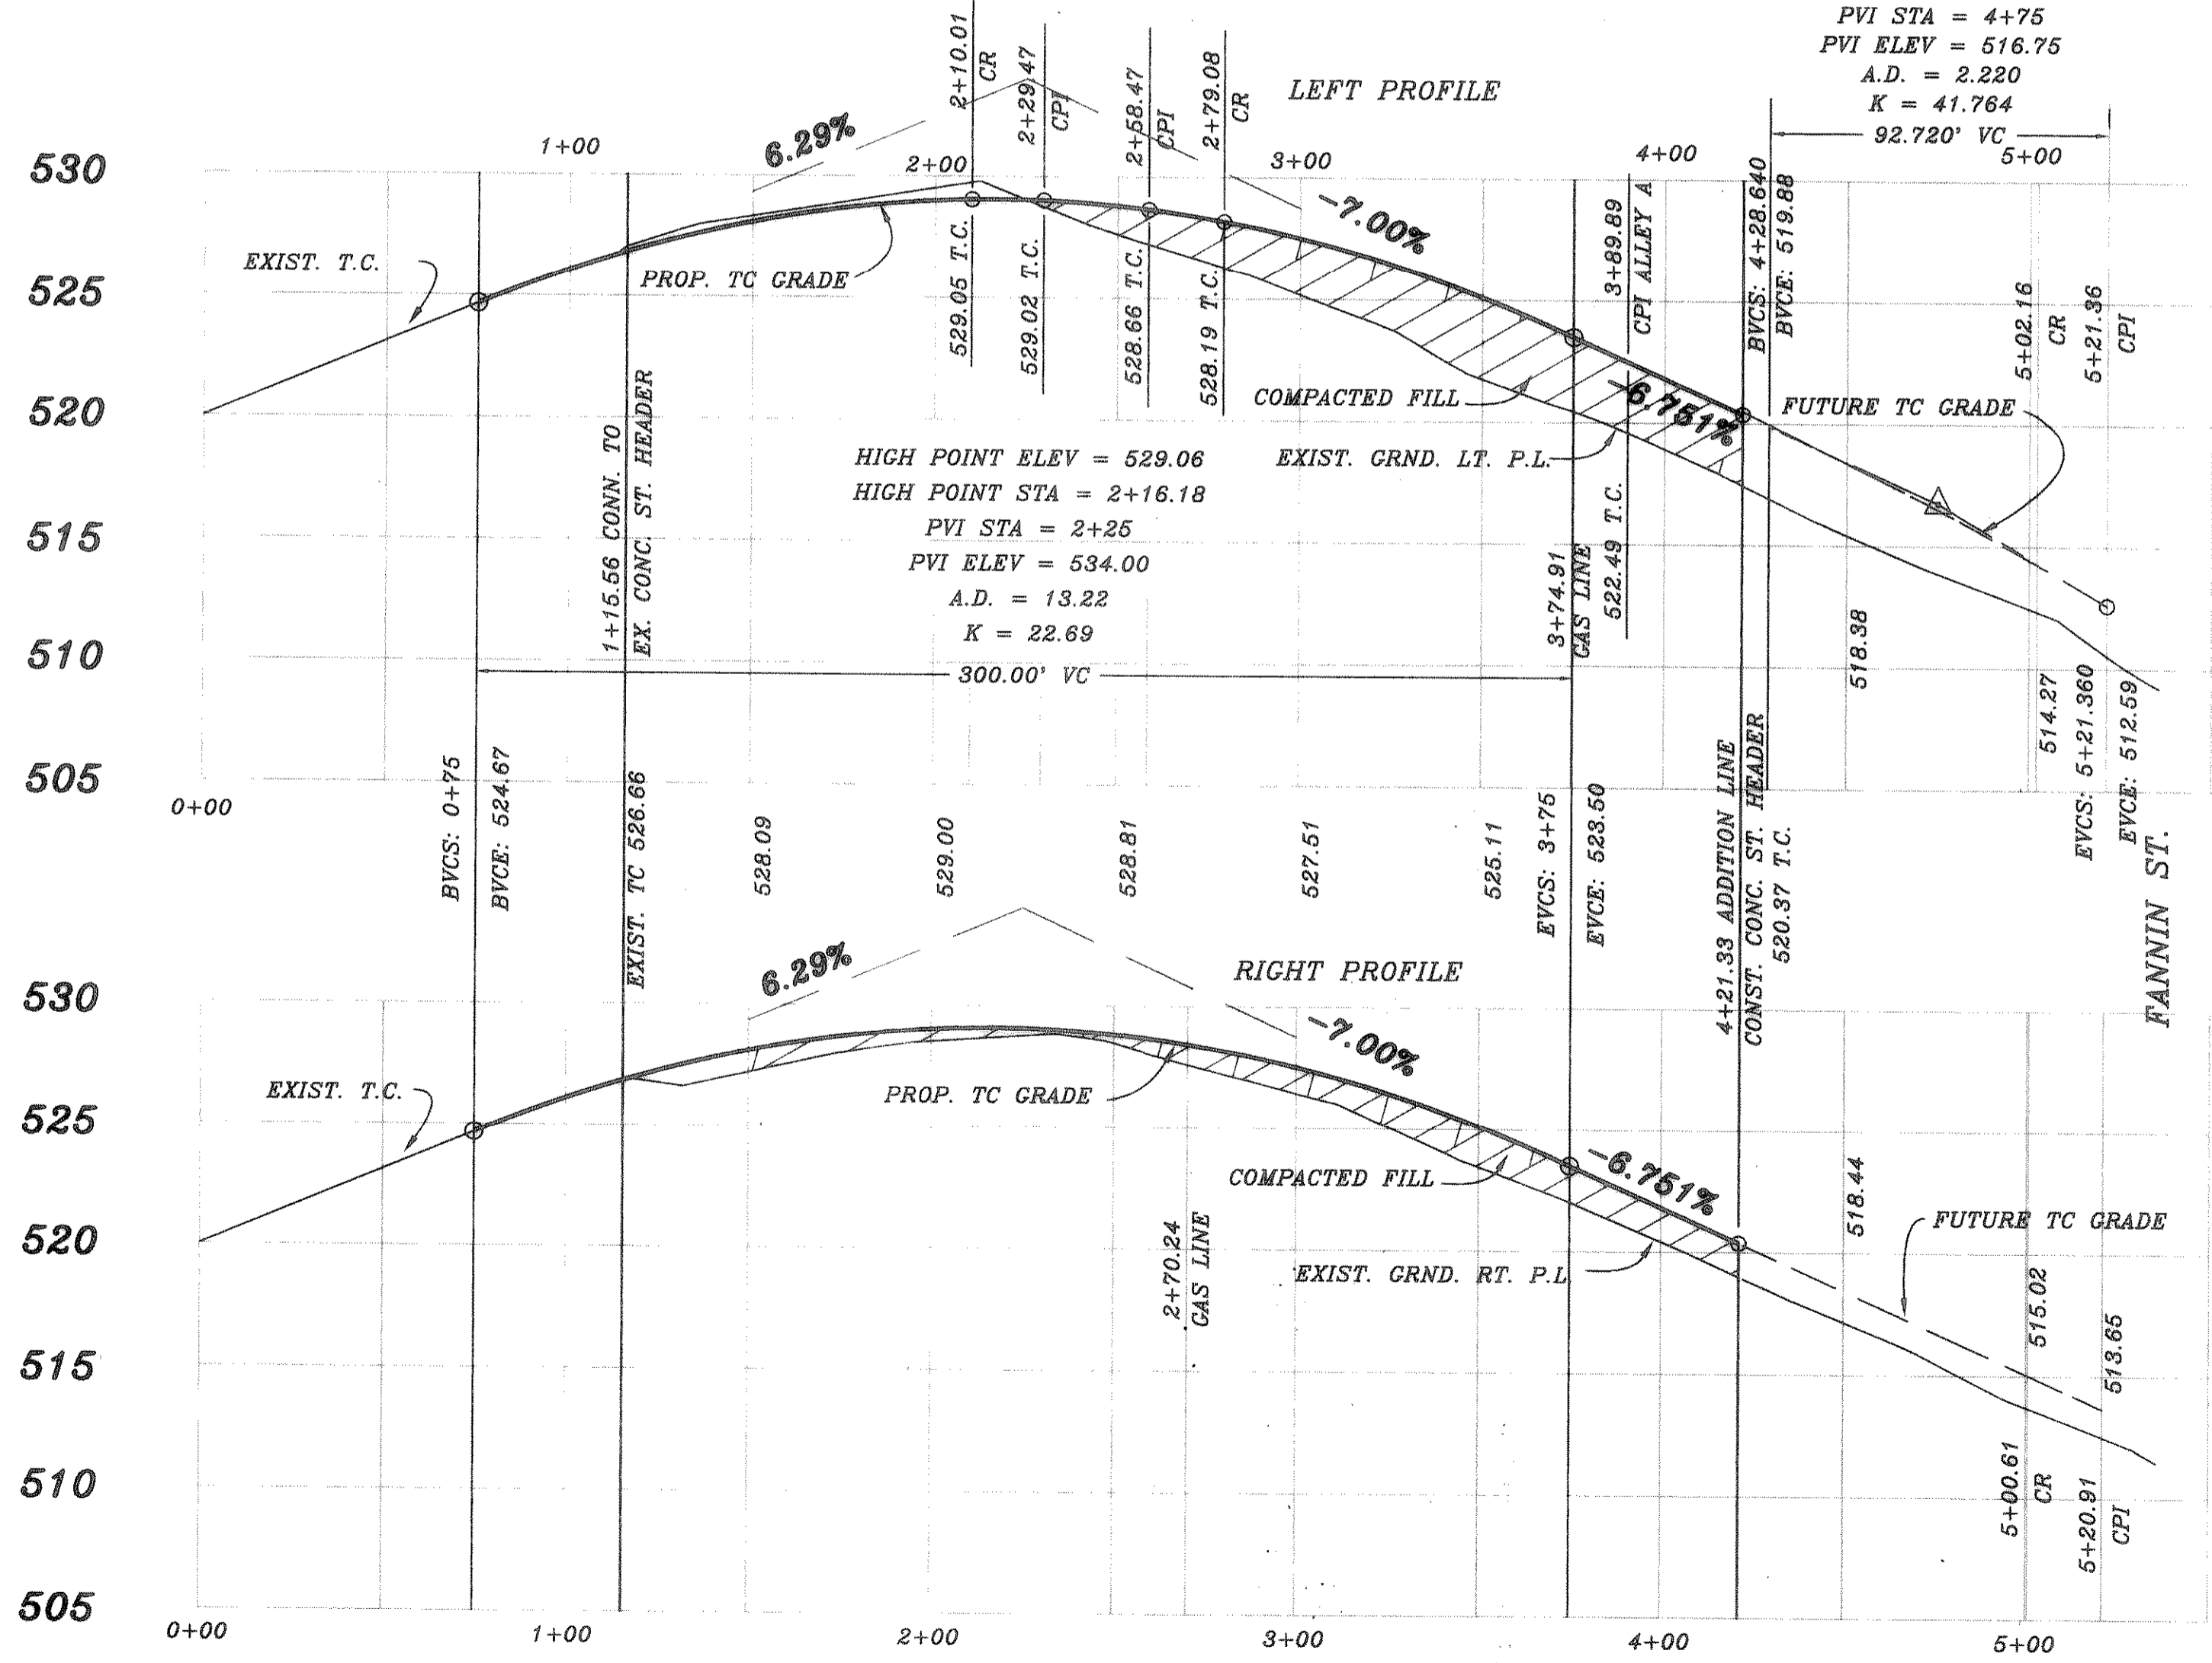


CURVE	RADIUS	LENGTH	TANGENT	CHORD	BEARING	DELTA
C1	1040.00'	31.09'	15.55'	31.09'	N73°35'01" W	07°42'48"

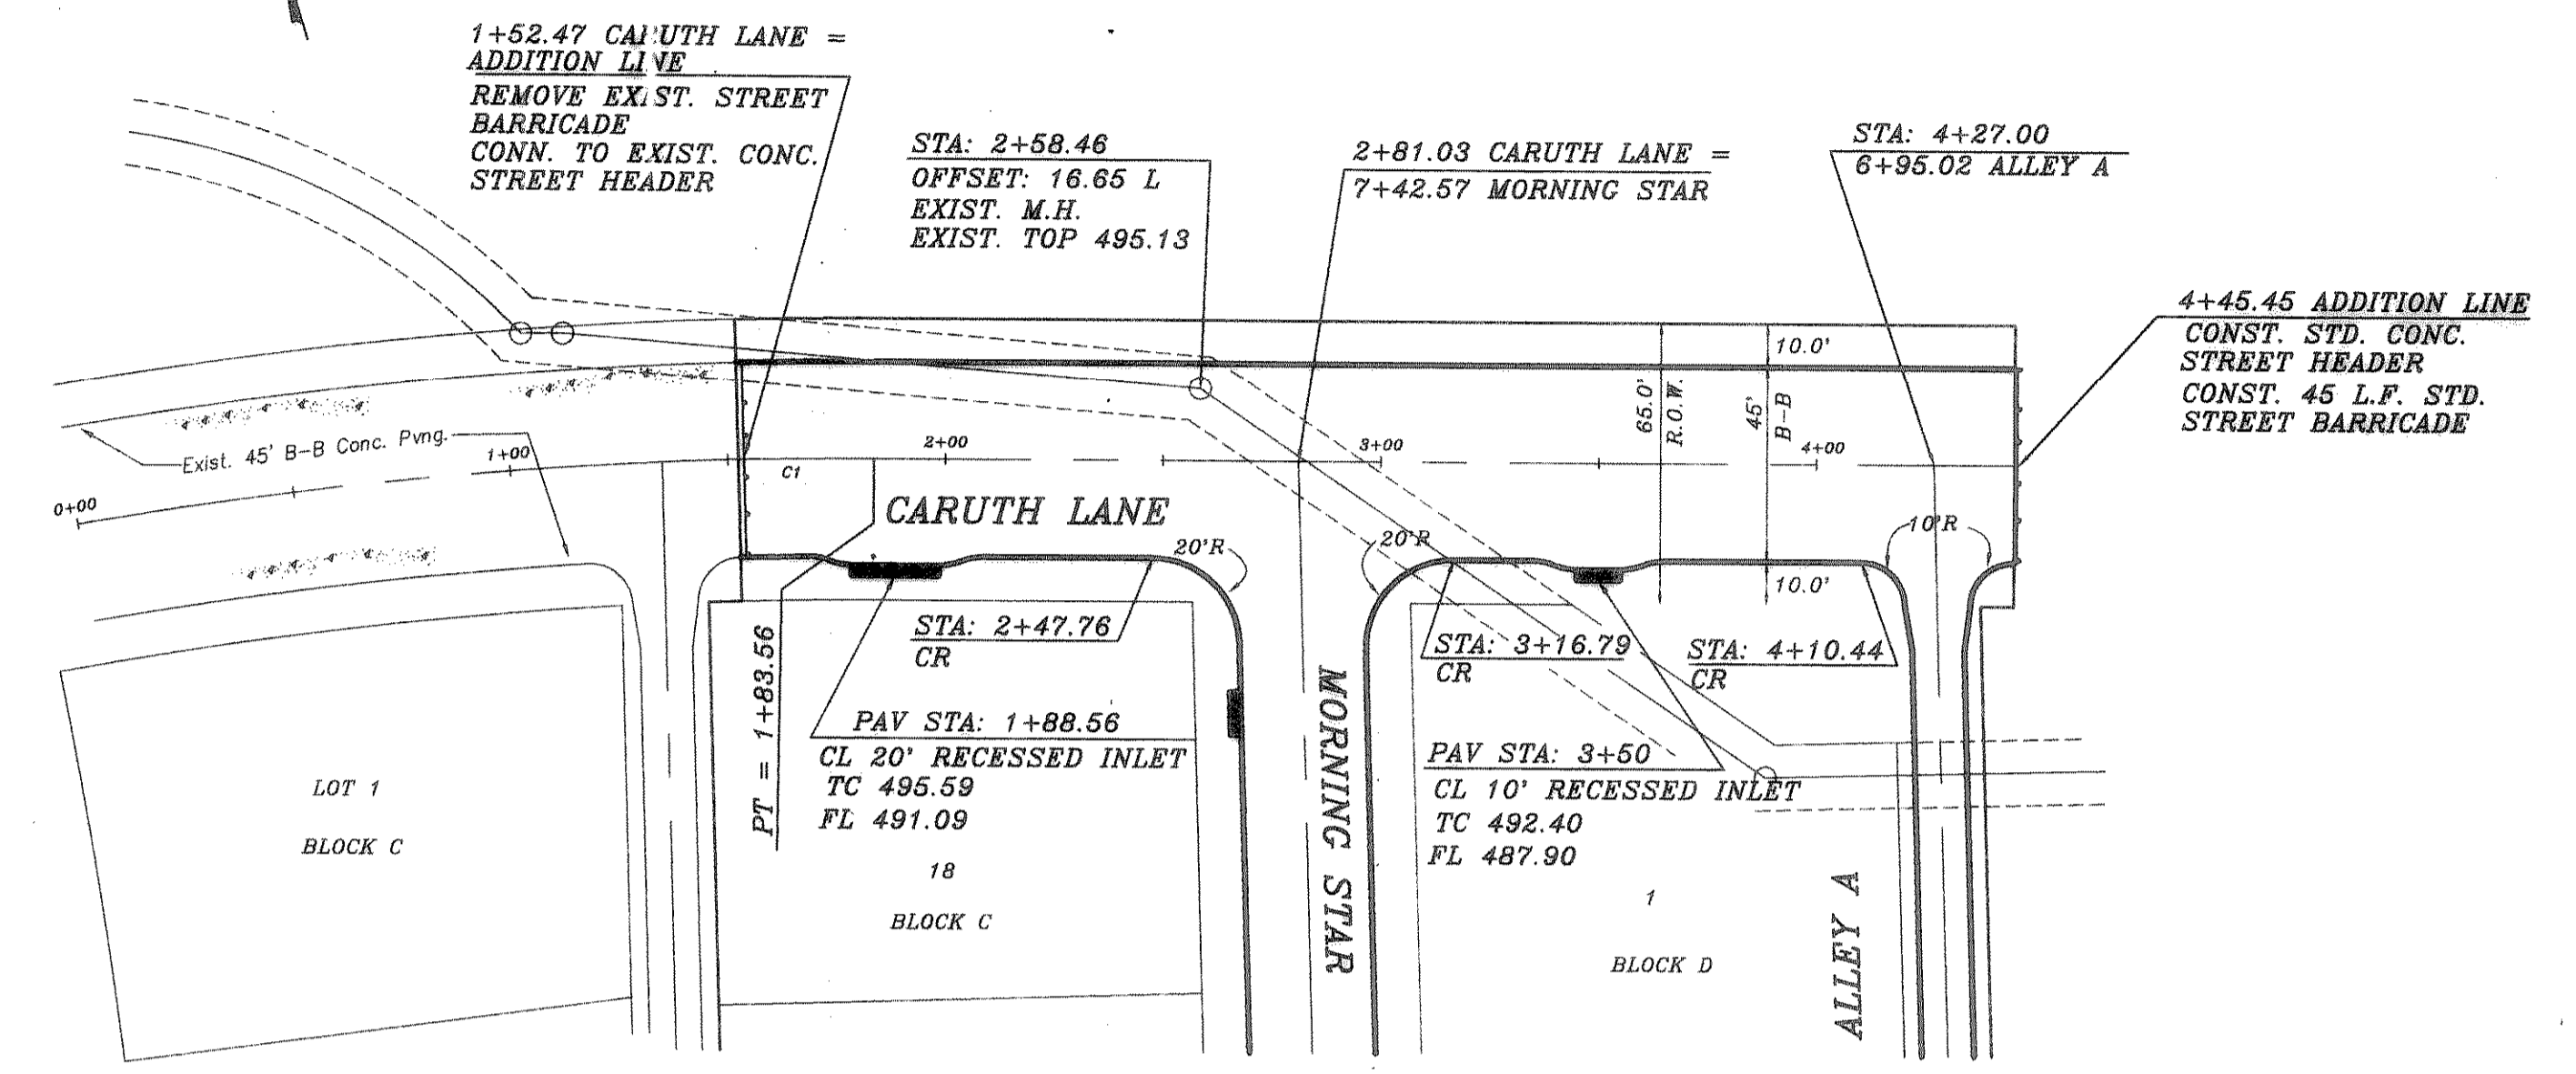

B.M.
SQUARE ON N. END OF HDWL ON EAST SIDE OF ST. HWY. NO. 205, 170' SOUTH OF CENTERLINE OF CARUTH LANE.
ELEVATION = 482.40

B.M.
NORTHEAST TOP OF CURB AT NORTH END OF FANNIN STREET, 125' +/- EAST OF SOUTHEAST ADDITION CORNER.
ELEVATION = 518.18

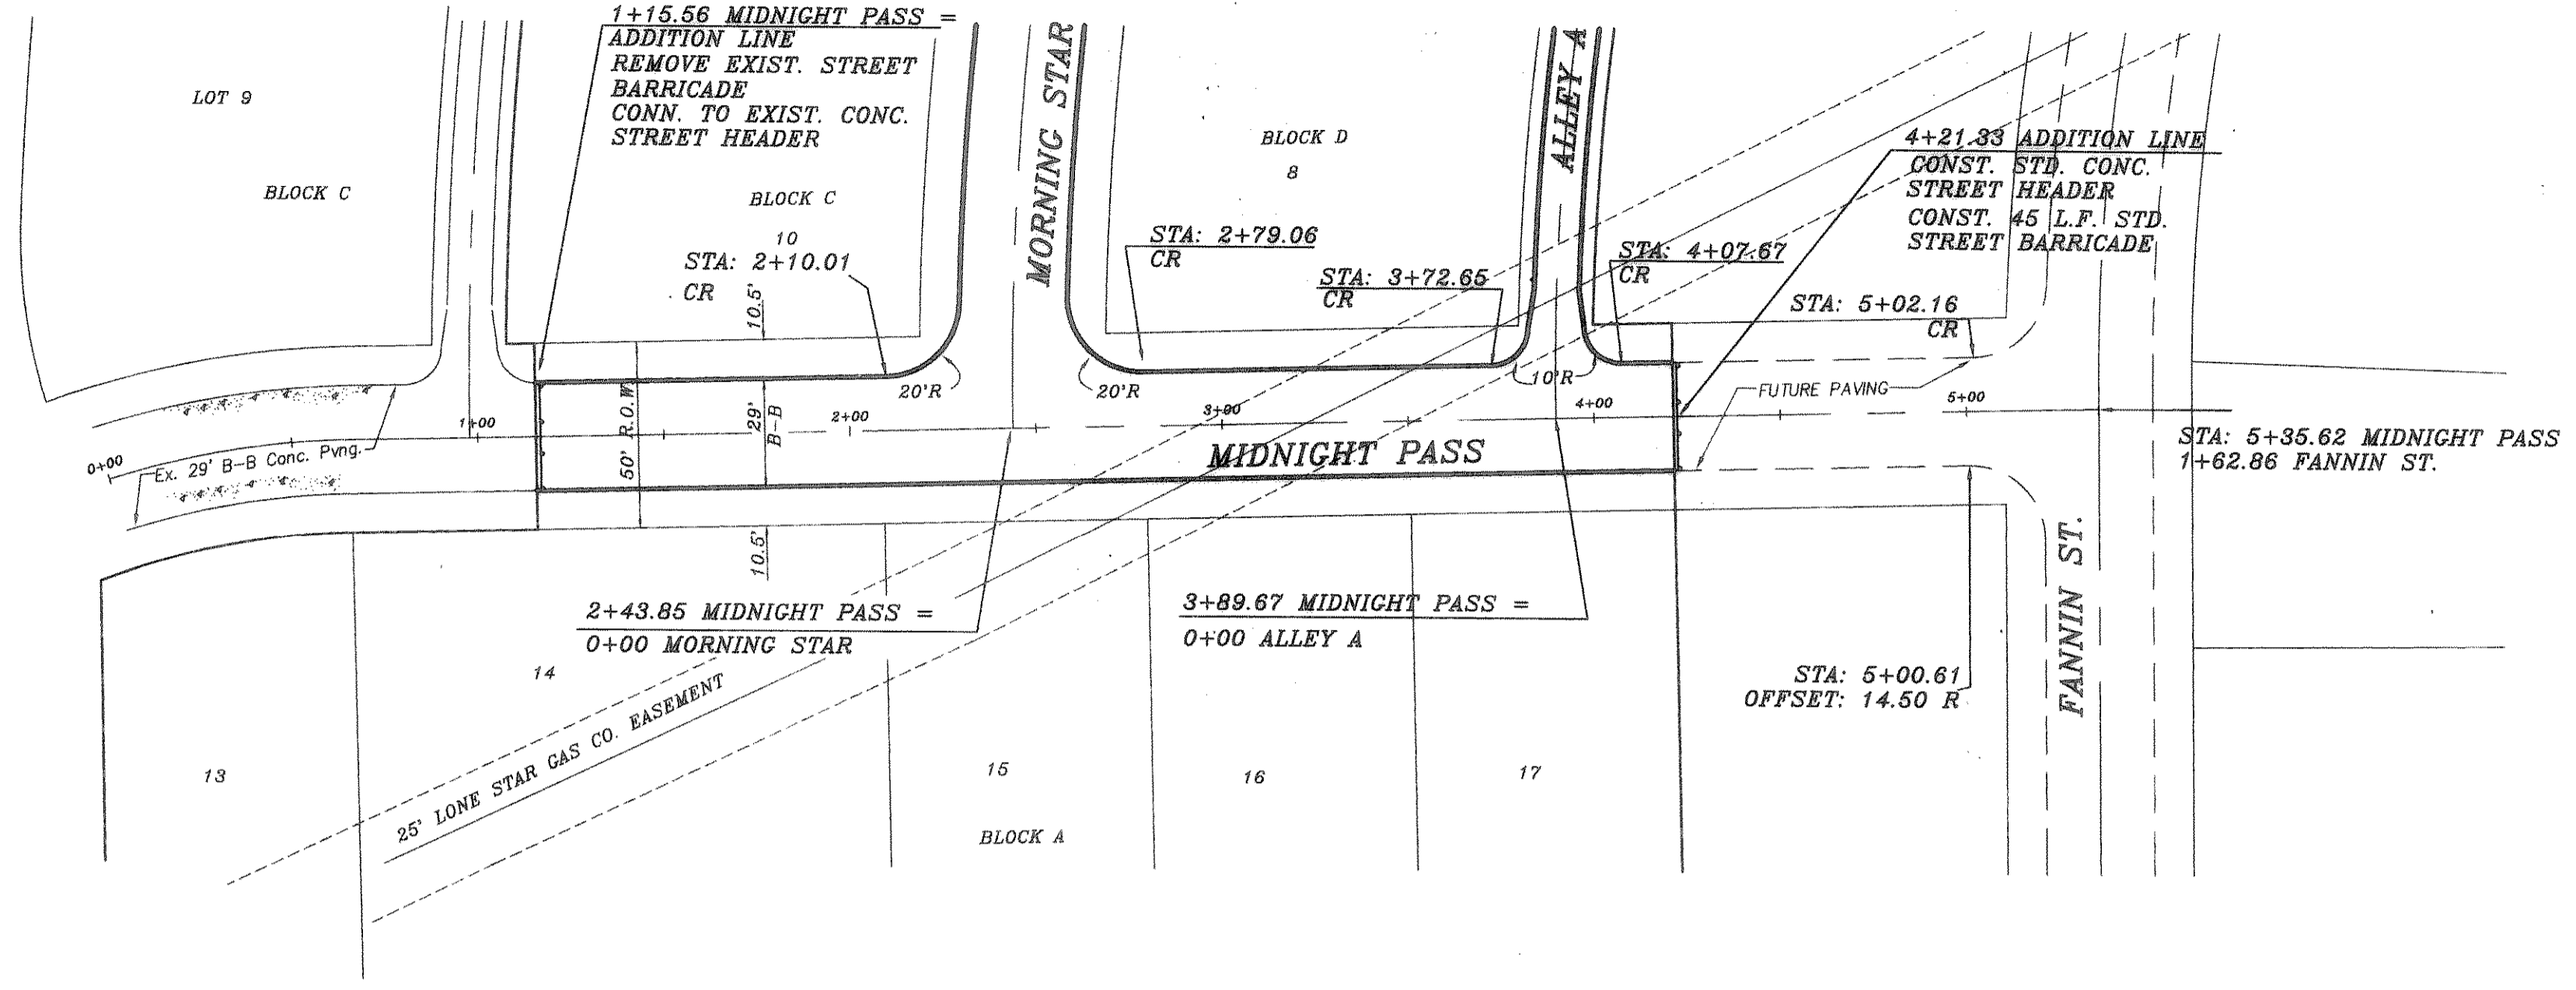

HAROLD L. EVANS CONSULTING ENGINEER P.O. BOX 28355 2331 CUS THOMASSON ROAD, SUITE 102 DALLAS, TEXAS 75226, (214) 328-8133		SHEET NO. 3 9
REVISION DESCRIPTION DATE SCALE DESIGN DRAWN	DATE 5/9/95 SCALE 1" = 40' 1" = 6' DESIGN H.L.E. DRAWN	PROPOSED PAVING MIDNIGHT PASS & CARUTH LANE CARUTH LAKE NO. 3 CITY OF ROCKWALL